

DCR PHOENIX HOMES

STARNDHERD MEADOWS 5

LOT #62

MODEL - 37-7 MADAKET (LEFT)

KITCHEN


MOUNTING HEIGHT = 90" 92"

CUSTOMER APPROVAL



I have reviewed these drawings and understand the details of the layout and the Cartier Kitchens specifications.

Signature _____


Date _____

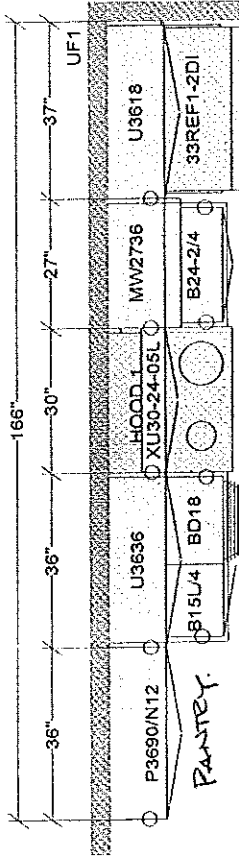

KITCHEN
LINE 3 - MALIBU MAPLE PECAN
HARDWARE - KN51
STANDARD WHITE INTERIOR
METAL DRAWER BOX
3 PCS - KICK
1 PCS - 135 DEG. CORNER MOULD
1 PCS - T-MOULD
4 PCS - WOOD BAR BRACKETS
4 PCS - CROWN

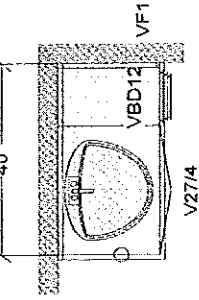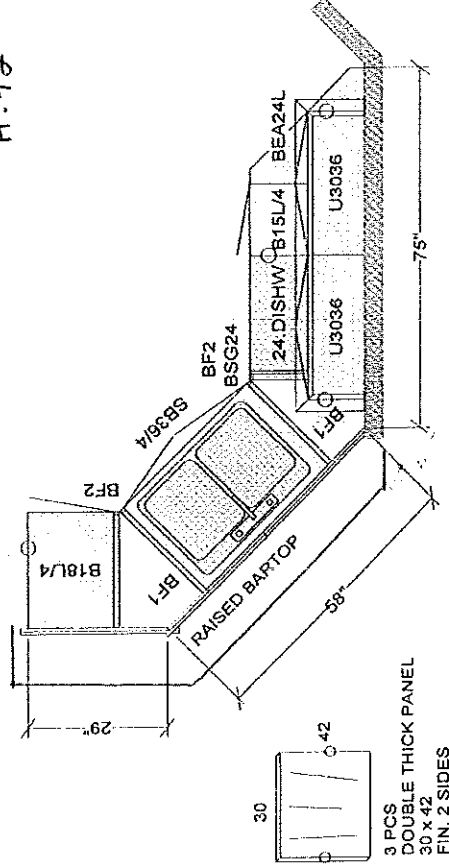

MAIN BATH

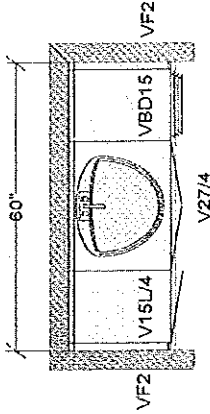

ENSUITE

MAIN / ENSUITE
LINE 2 - SUTTON MAPLE PECAN
HARDWARE - KN43
STANDARD WHITE INTERIOR
METAL DRAWER BOX
1 PCS - KICK

All dimensions, size designations given are subject to verification on job site and adjustment to fit job conditions.

CARTIER KITCHENS OTTAWA



This is an original design and must not be released or copied unless applicable fee has been paid or job order placed.


DRAWN BY: LD
CARTIER KITCHENS OTTAWA

Designed: 5/19/2011
Printed: 6/6/2011

62 Strandherd

All

Drawing #: 1

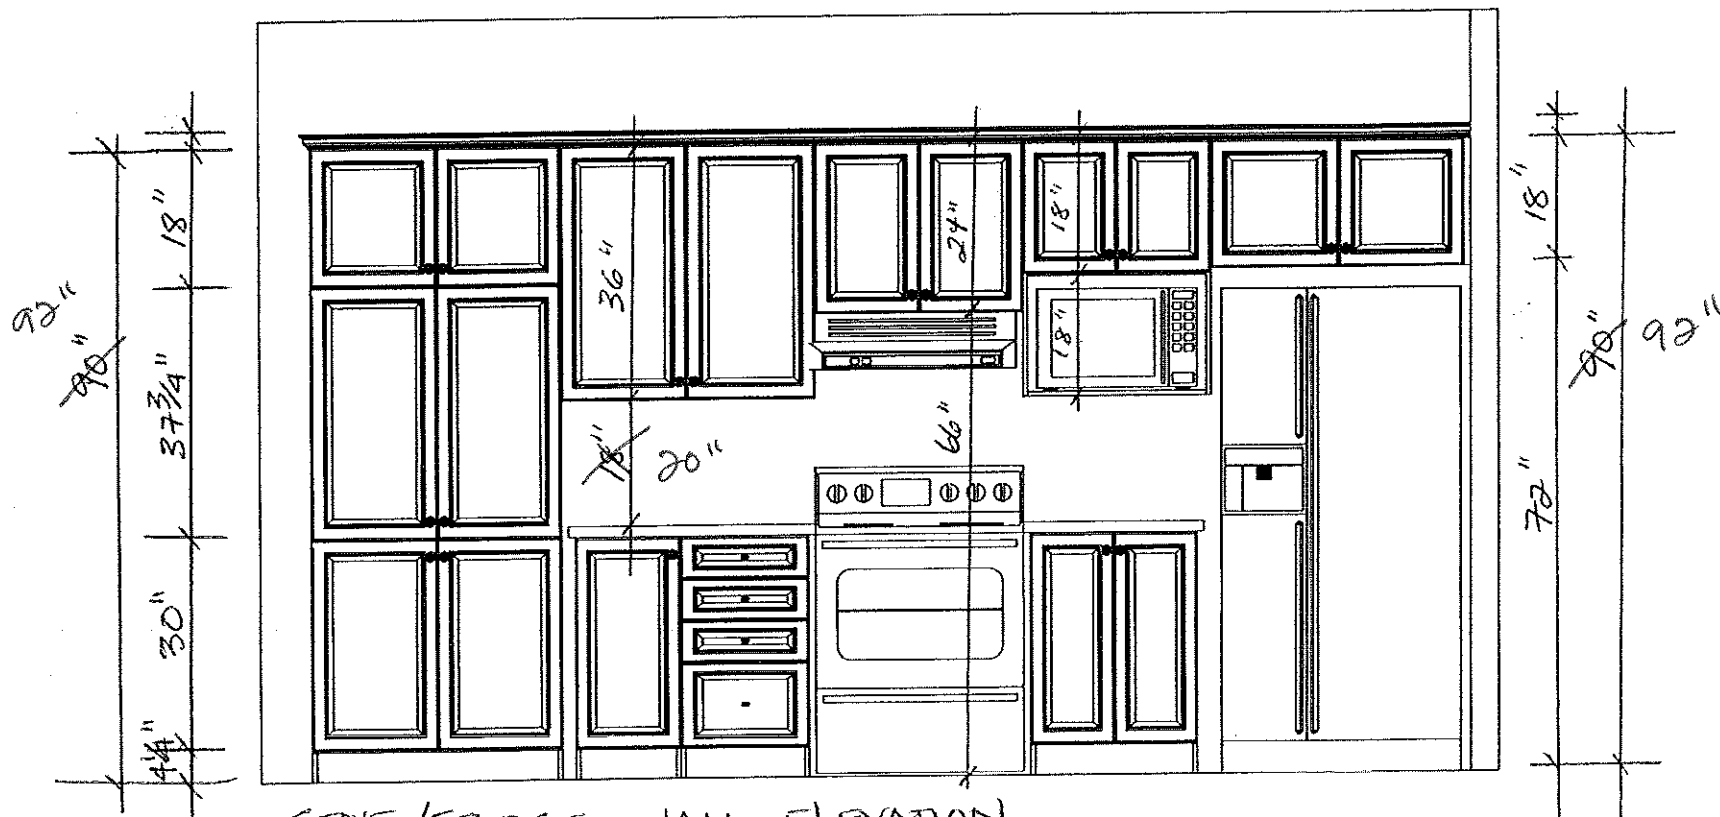

STOVE / FRIDGE WALL ELEVATION
LOT #62 SMS

CUSTOMER APPROVAL


I have reviewed these drawings and understand the details of the layout and the Cartier Kitchens specifications.

Signature _____

Date _____


Note: This drawing is an artistic interpretation of the general appearance of the design. It is not meant to be an exact rendition.

DRAWN BY: Lori Di Saverio, B.I.D.
 CARTIER KITCHENS OTTAWA
 62 Strandherd

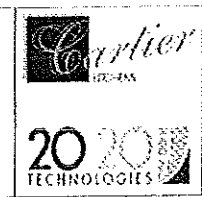

Designed: 5/19/2011
 Printed: 6/6/2011

All _____ Drawing #: 1

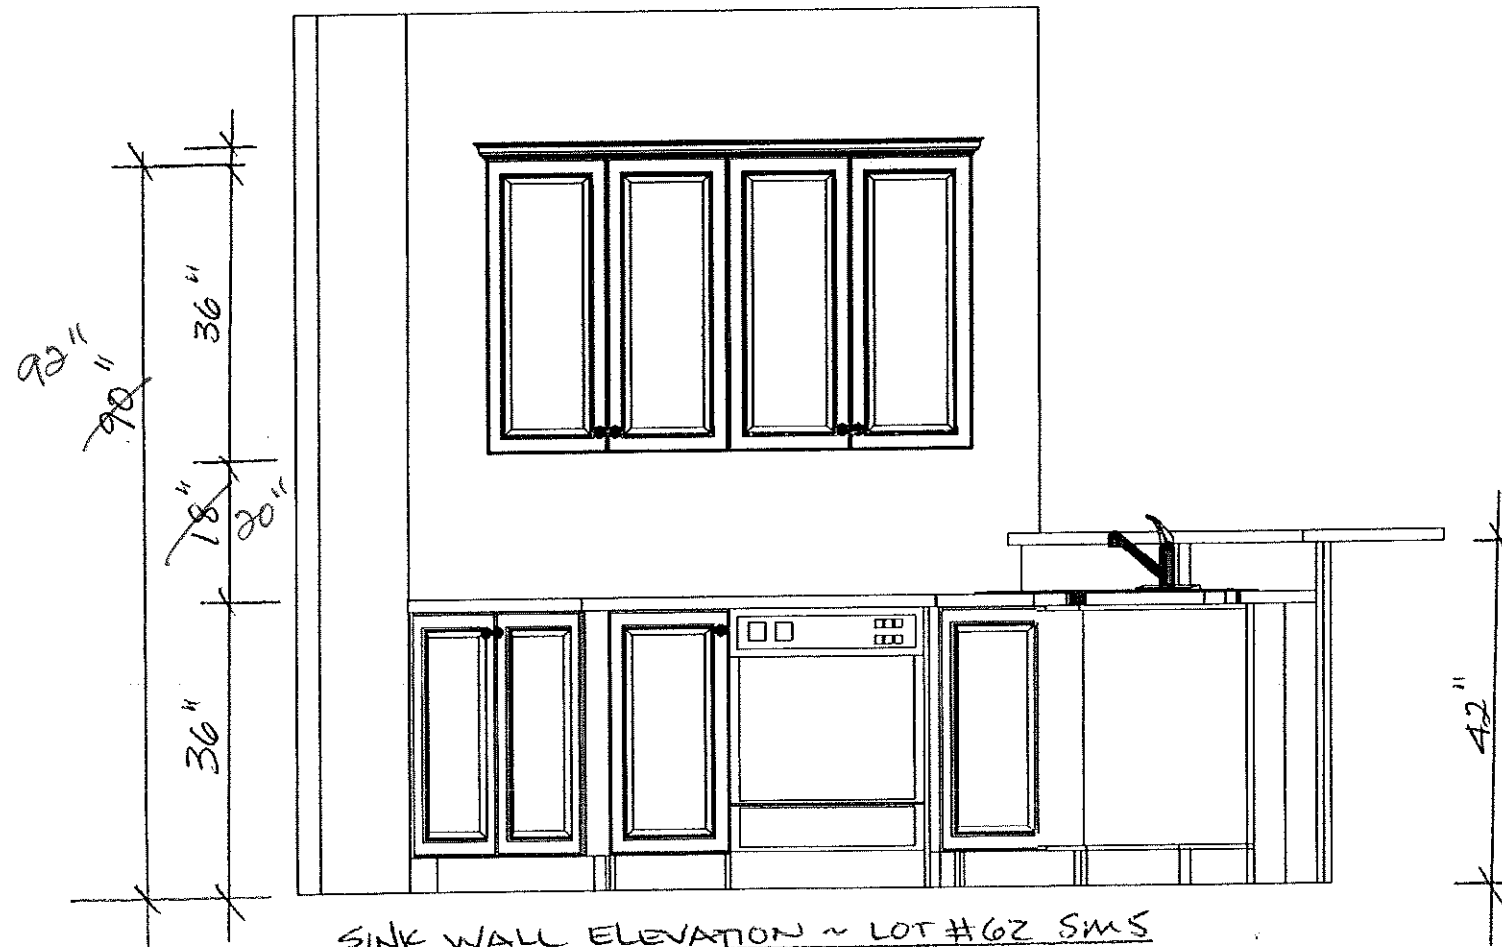

CUSTOMER APPROVAL

I have reviewed these drawings and understand the details of the layout and the Cartier Kitchens specifications.

Signature _____

Date _____

Note: This drawing is an artistic interpretation of the general appearance of the design. It is not meant to be an exact rendition.


DRAWN BY: Lori Di Saverio, B.I.D.
CARTIER KITCHENS OTTAWA
62 Strandherd



Designed: 5/19/2011
Printed: 6/6/2011

All

Drawing #: 1

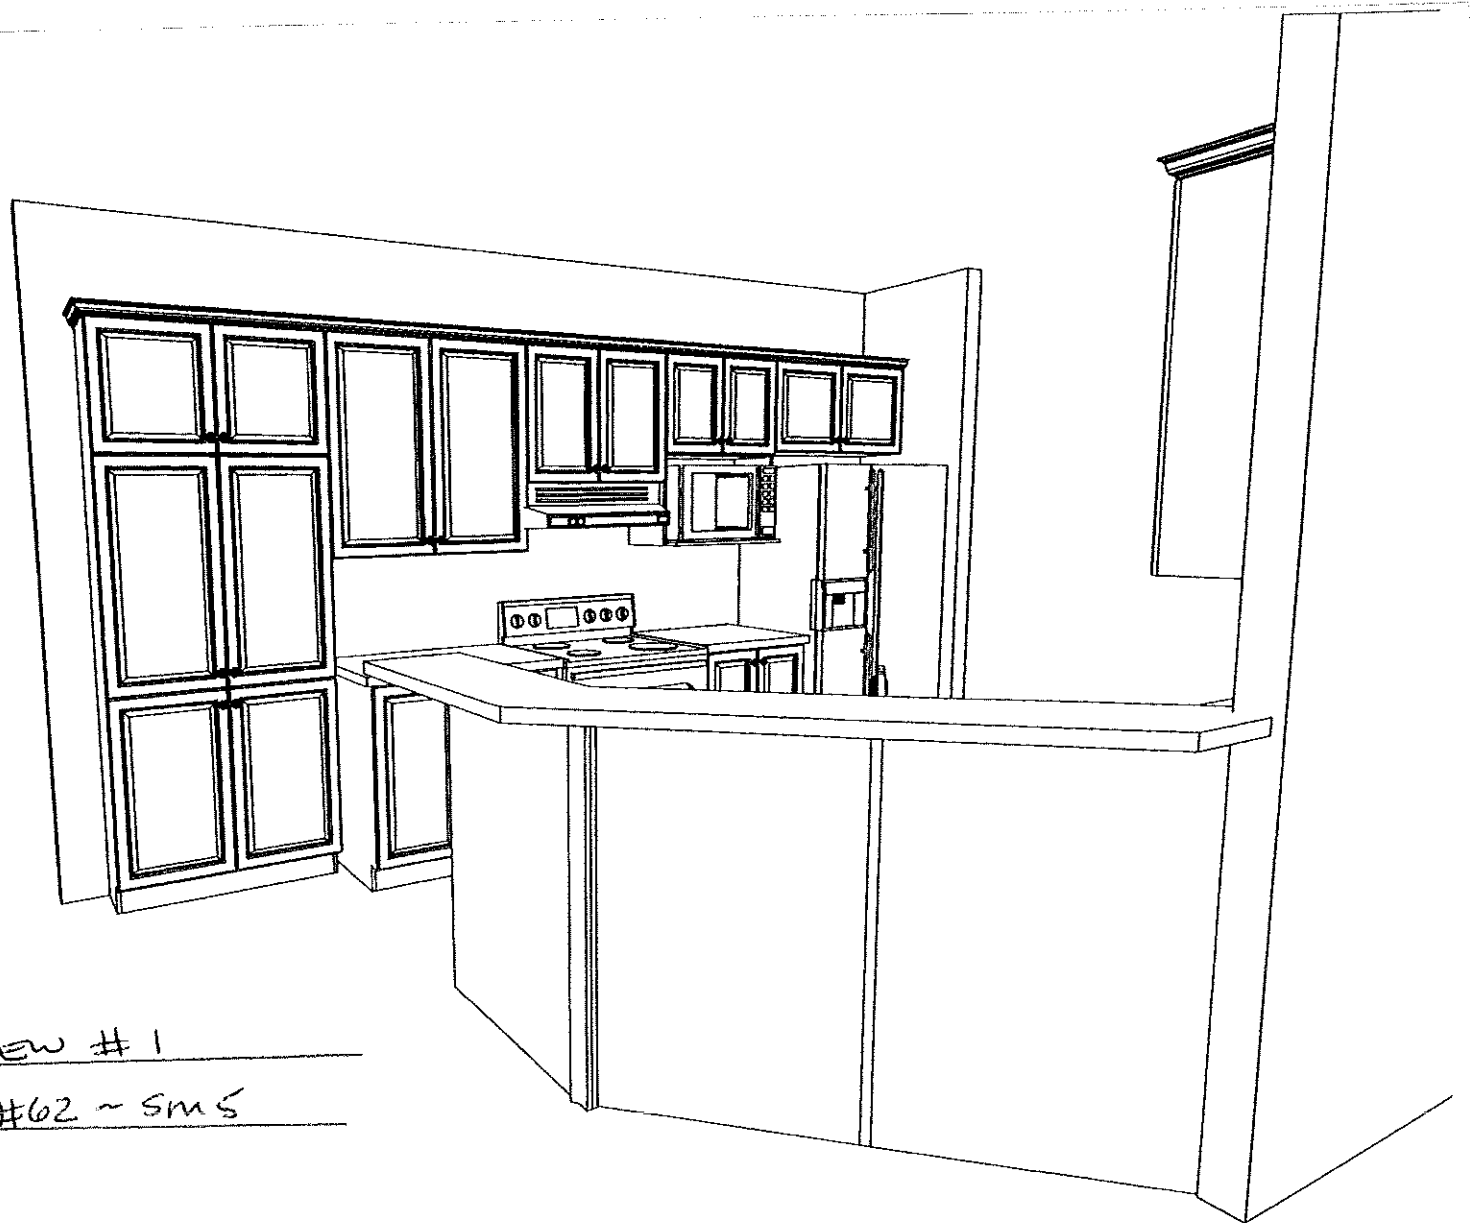

3D View #1

LOT #62 ~ SMS

CUSTOMER APPROVAL

I have reviewed these drawings and understand the details of the layout and the Cartier Kitchens specifications.

Signature [Signature]
Date June 15, 2011

Note: This drawing is an artistic interpretation of the general appearance of the design. It is not meant to be an exact rendition.


DRAWN BY: Lori Di Saverio, B.I.D.
CARTIER KITCHENS OTTAWA
62 Strandherd



Designed: 5/19/2011
Printed: 6/6/2011

All

Drawing #: 1

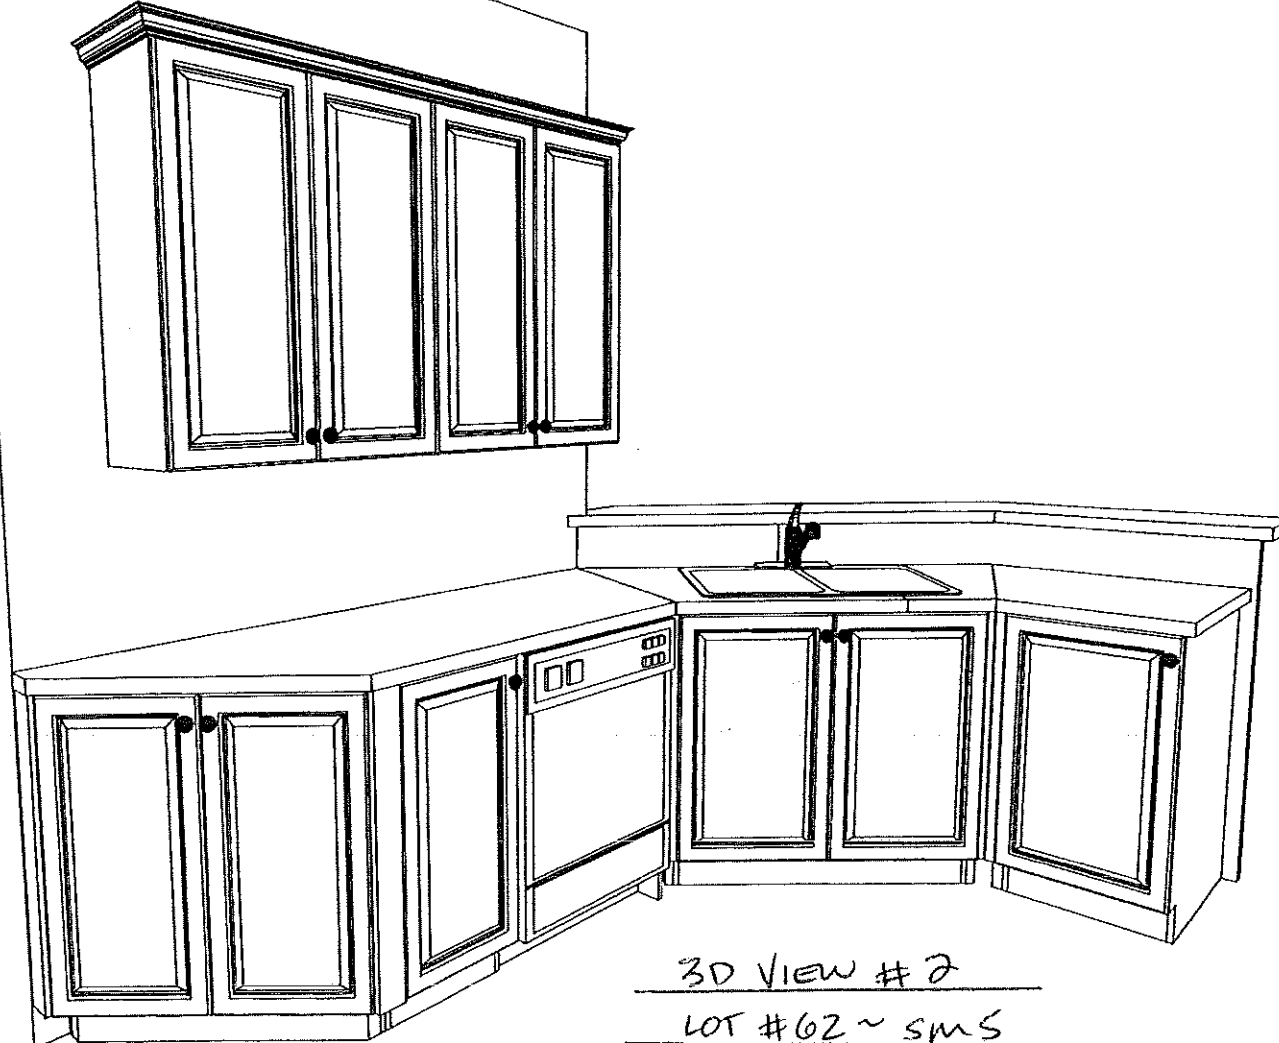

3D VIEW #2
LOT #62 ~ SMS

CUSTOMER APPROVAL

I have reviewed these drawings and understand the details of the layout and the Cartier Kitchens specifications.

Signature [Signature]
Date June 15, 2011

Note: This drawing is an artistic interpretation of the general appearance of the design. It is not meant to be an exact rendition.

DRAWN BY: Lori Di Saverio, B.I.D.
CARTIER KITCHENS OTTAWA
62 Strandherd



Designed: 5/19/2011
Printed: 6/6/2011

All

Drawing #: 1



3D VIEW # 3

LOT #62 ~ SMS

CUSTOMER APPROVAL

I have reviewed these drawings and understand the details of the layout and the Cartier Kitchens specifications.

Signature [Signature]
Date June 15/2011

Note: This drawing is an artistic interpretation of the general appearance of the design. It is not meant to be an exact rendition.


DRAWN BY: Lori Di Saverio, B.I.D.
CARTIER KITCHENS OTTAWA
62 Strandherd



Designed: 5/19/2011
Printed: 6/6/2011

All

Drawing #: 1

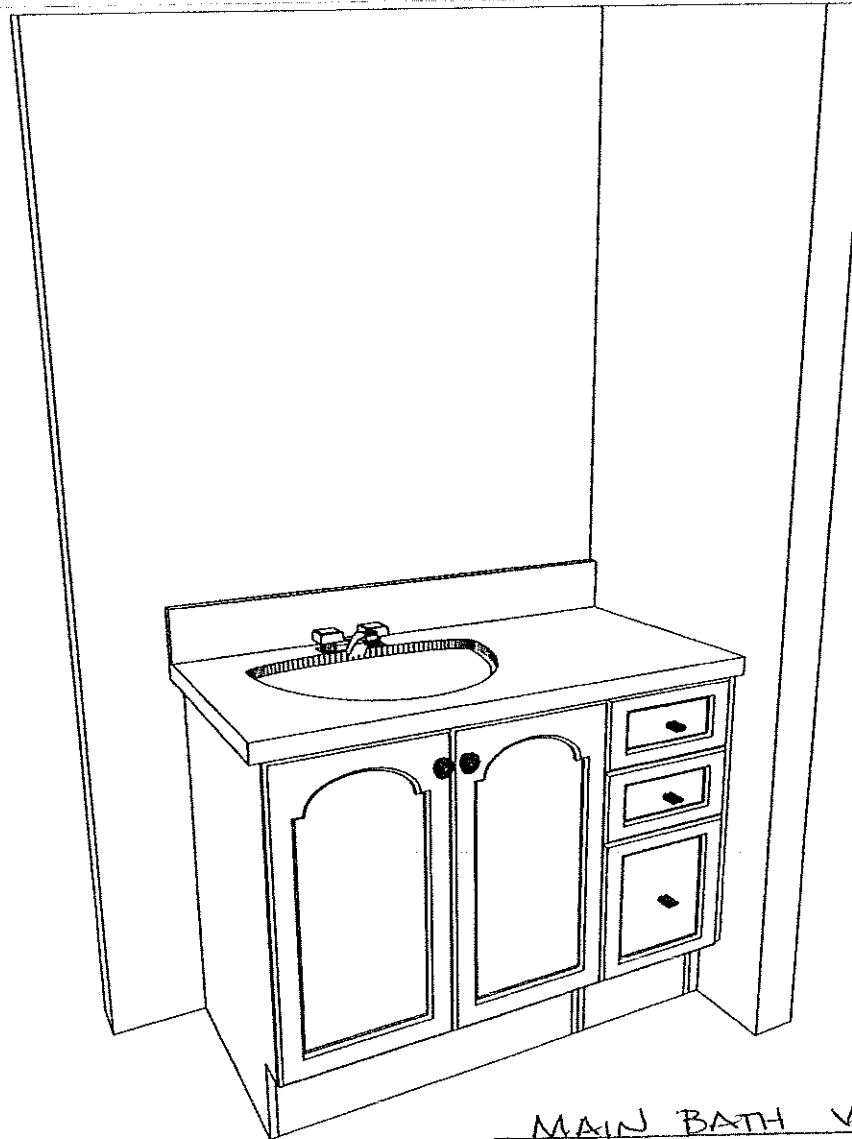

MAIN BATH VANITY.
LOT #62 - S.M.S

CUSTOMER APPROVAL

I have reviewed these drawings and understand the details of the layout and the Cartier Kitchens specifications.

Signature

Date

[Signature]
June 15, 2011

Note: This drawing is an artistic interpretation of the general appearance of the design. It is not meant to be an exact rendition.


DRAWN BY: Lori Di Saverio, B.I.D.
CARTIER KITCHENS OTTAWA
62 Strandherd



Designed: 5/19/2011
Printed: 6/6/2011

All

Drawing #: 1

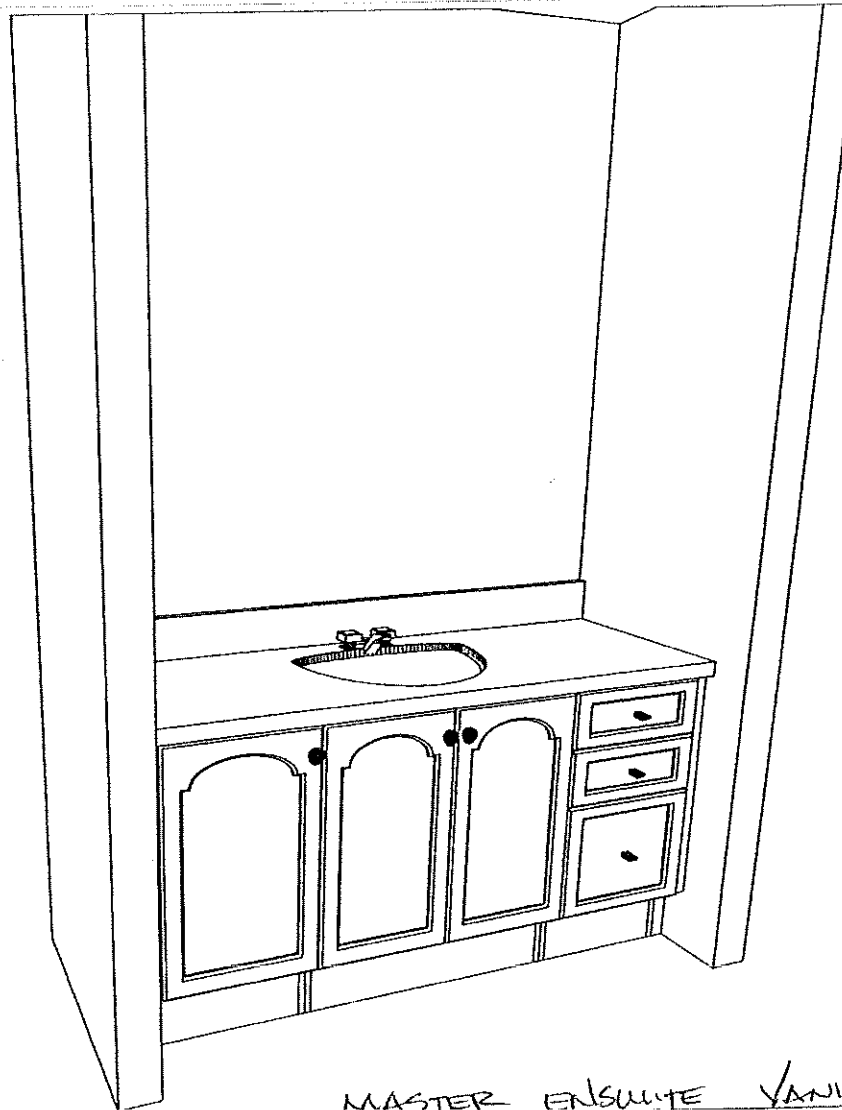

MASTER ENSUITE VANITY
LOT # 62 - S.M.S

CUSTOMER APPROVAL

I have reviewed these drawings and understand the details of the layout and the Cartier Kitchens specifications.

Signature [Signature]
 Date June 15, 2011

Note: This drawing is an artistic interpretation of the general appearance of the design. It is not meant to be an exact rendition.

DRAWN BY: Lori Di Saverio, B.I.D.
 CARTIER KITCHENS OTTAWA
 62 Strandherd



Designed: 5/19/2011
 Printed: 6/6/2011

All

Drawing #: 1