

STRANDHERD MEADOWS 5
LOT #6
MODEL - YARMOUTH (511)

REVISÉD JULY 13, 2011

I have reviewed these drawings and understand the details of the layout and the Carrier Kitchens specifications.

Signature _____ Date _____

CABINET LINE - 3
DOOR STYLE - BELAIR UPPERS
- MALIBU LOWERS
SPECIES - MAPLE
COLOUR - TBC

HARDWARE - TBC

KICK: 4-PCS.


STD WHITE INTERIORS

METAL DRAWER BOXES

2 - PCS. 90 DEG. CORNER MOULD.

RECESSED VALANCE

2" CROWN MOULDING

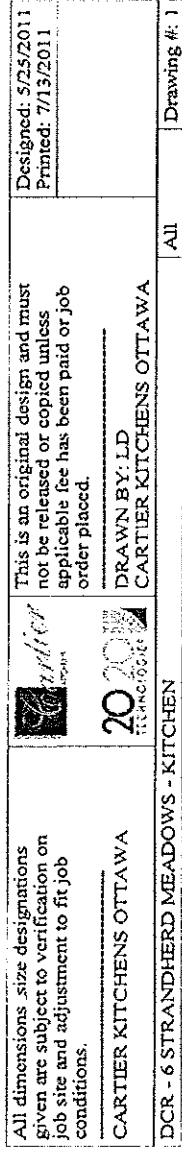



CUSTOMER APPROVAL

I have reviewed these drawings and understand the details of the layout and the Cartier Kitchens specifications.

Signature

[Signature]

Date

Note: This drawing is an artistic interpretation of the general appearance of the design. It is not meant to be an exact rendition.

DRAWN BY: Lori Di Saverio, B.I.D.
CARTIER KITCHENS OTTAWA


DCR - 6 STRANDHERD MEADOWS - KITCHEN All



Designed: 5/25/2011
Printed: 7/13/2011

Drawing #: 1

99"
 87"
 42"
 30"
 12"
 36"
 21"
 21"

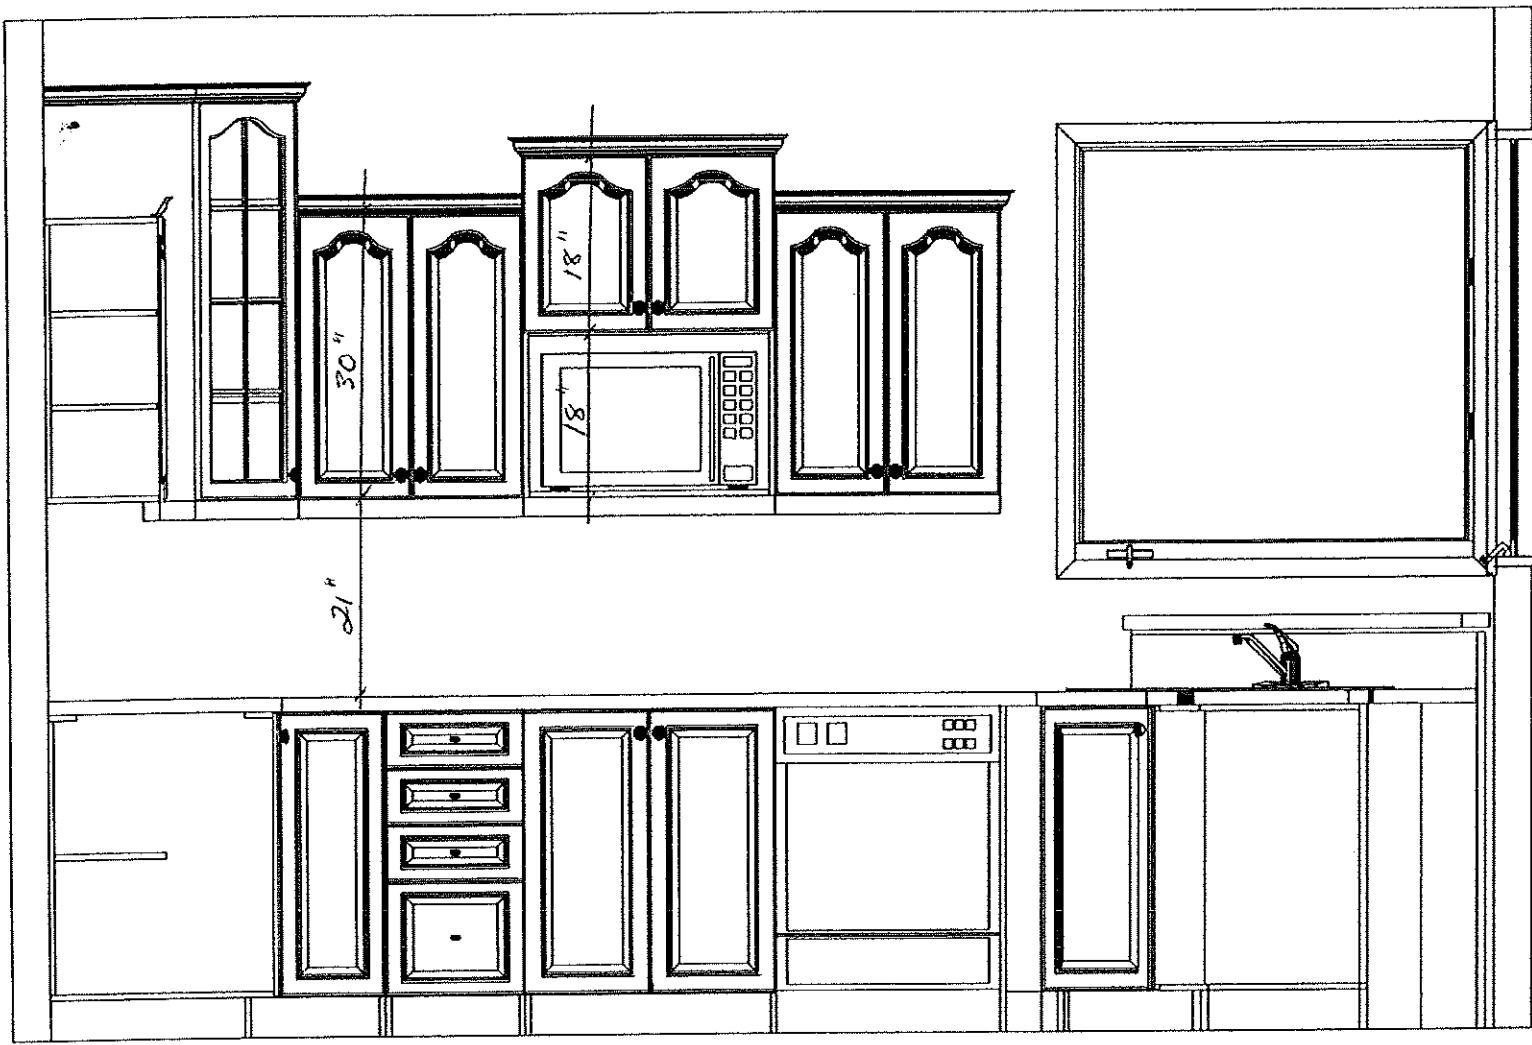

CUSTOMER APPROVAL

I have reviewed these drawings and understand the details of the layout and the Cartier Kitchens specifications.

Signature _____

Date _____


Note: This drawing is an artistic interpretation of the general appearance of the design. It is not meant to be an exact rendition.

DRAWN BY: Lori Di Saverio, B.I.D.
 CARTIER KITCHENS OTTAWA
 DCR - 6 STRANDHERD MEADOWS - KITCHEN



Designed: 5/25/2011
 Printed: 7/13/2011

Drawing #: 1

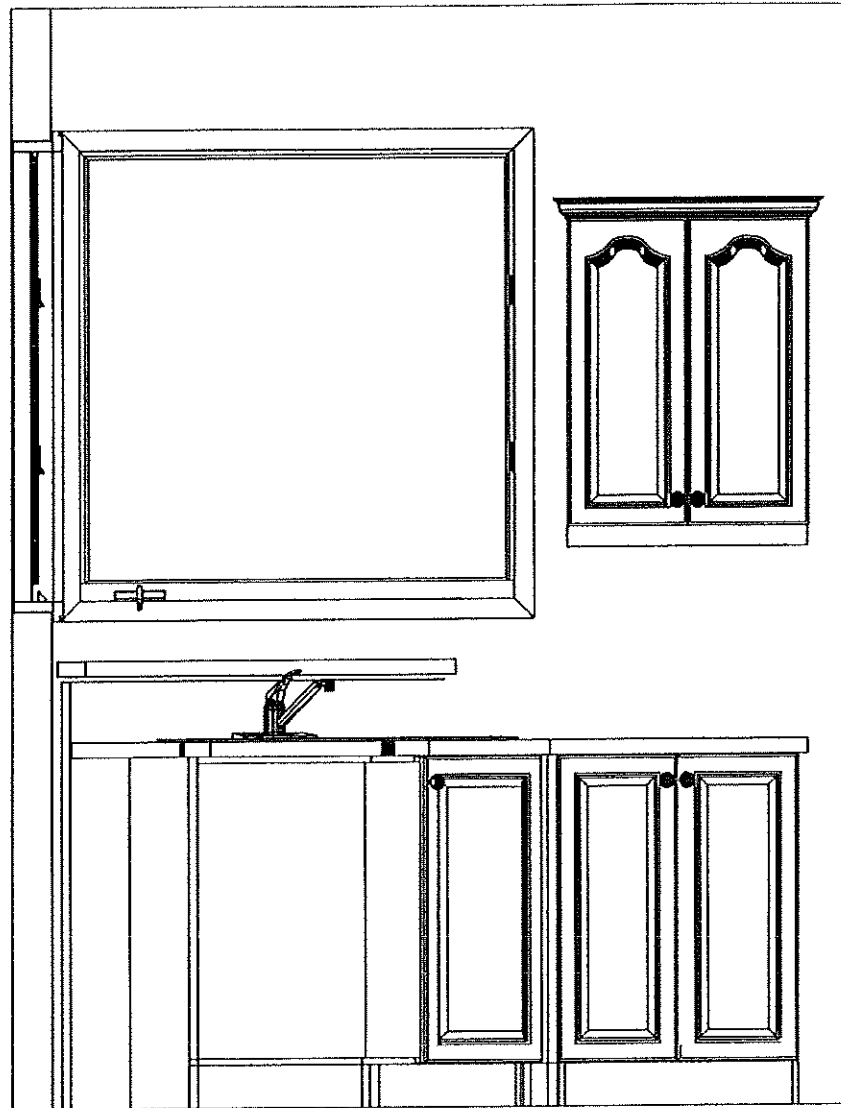

36" 21" 30" 87"

CUSTOMER APPROVAL

I have reviewed these drawings and understand the details of the layout and the Cartier Kitchens specifications.

Signature

(Handwritten signature)

Date

Note: This drawing is an artistic interpretation of the general appearance of the design. It is not meant to be an exact rendition.

DRAWN BY: Lori Di Saverio, B.I.D.
CARTIER KITCHENS OTTAWA

DCR - 6 STRANDHERD MEADOWS - KITCHEN All



Designed: 5/25/2011
Printed: 7/13/2011

Drawing #: 1



CUSTOMER APPROVAL

I have reviewed these drawings and understand the details of the layout and the Cartier Kitchens specifications.

Signature _____

Date _____

Note: This drawing is an artistic interpretation of the general appearance of the design. It is not meant to be an exact rendition.

DRAWN BY: Lori Di Saverio, B.I.D.
CARTIER KITCHENS OTTAWA
DCR - 6 STRANDHERD MEADOWS - KITCHEN | All



Designed: 5/25/2011
Printed: 7/13/2011

Drawing #: 1



CUSTOMER APPROVAL

I have reviewed these drawings and understand the details of the layout and the Cartier Kitchens specifications.

Signature _____

Date _____

[Handwritten Signature]
[Handwritten Date: 7/13/2011]


Note: This drawing is an artistic interpretation of the general appearance of the design. It is not meant to be an exact rendition.

DRAWN BY: Lori Di Saverio, B.I.D.
CARTIER KITCHENS OTTAWA
DCR - 6 STRANDHERD MEADOWS - KITCHEN



Designed: 5/25/2011
Printed: 7/13/2011

Drawing #: 1

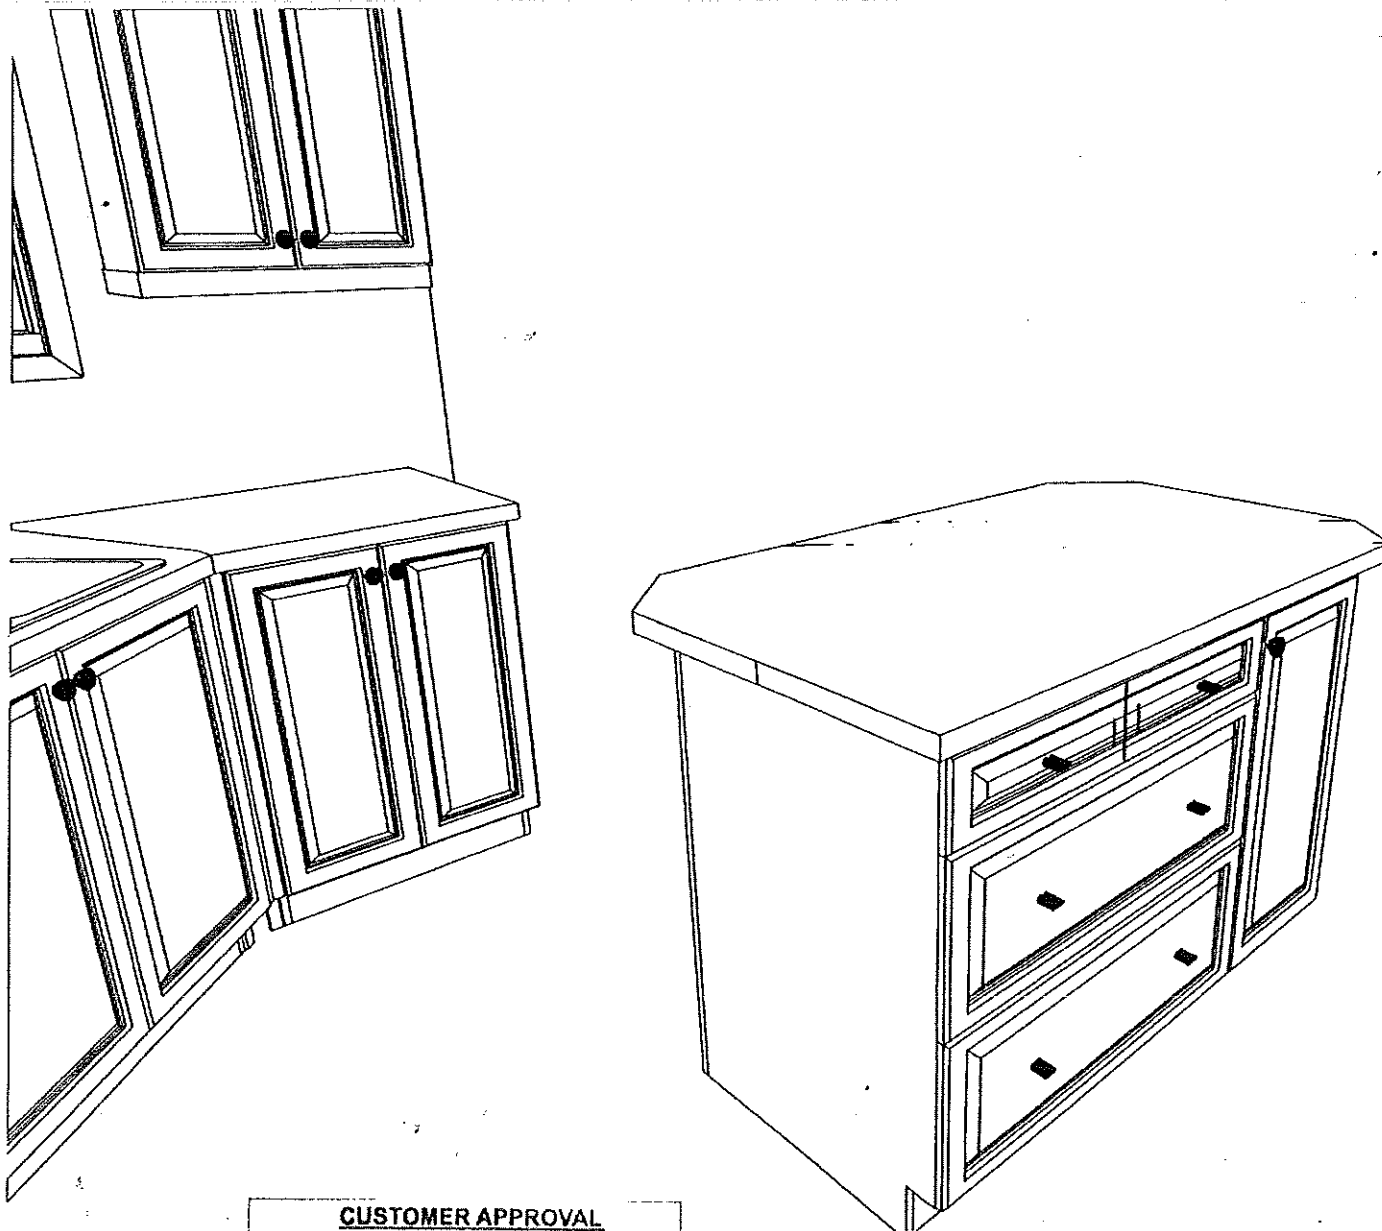

CUSTOMER APPROVAL

I have reviewed these drawings and understand the details of the layout and the Cartier Kitchens specifications.

Signature _____

Date _____

[Handwritten signature]
[Handwritten date]

Note: This drawing is an artistic interpretation of the general appearance of the design. It is not meant to be an exact rendition.

DRAWN BY: Lori Di Saverio, B.I.D.
CARTIER KITCHENS OTTAWA

DCR - 6 STRANDHERD MEADOWS - KITCHEN | All



Designed: 5/25/2011
Printed: 7/13/2011

Drawing #: 1