

DCR PHOENIX HOMES

STRANDHERD MEADOWS 5

LOT #7


PLATINA (512) - LEFT

KITCHEN

REVISED: OCT 9-11

CABINET LINE - 3
DOOR STYLE - MALIBU
SPECIES - MAPLE
COLOUR - TBC
HARDWARE - TBC
KICK: 3-PCS.
STD WHITE INTERIORS
METAL DRAWER BOXES
2 - PCS. 90 DEG. CORNER MOULD.
1 PC - T MOULD

CUSTOMER APPROVAL
I have reviewed these drawings and understand the details of the layout and the Center Kitchens specifications.
Signature: *[Signature]*
Date: Feb. 11/10

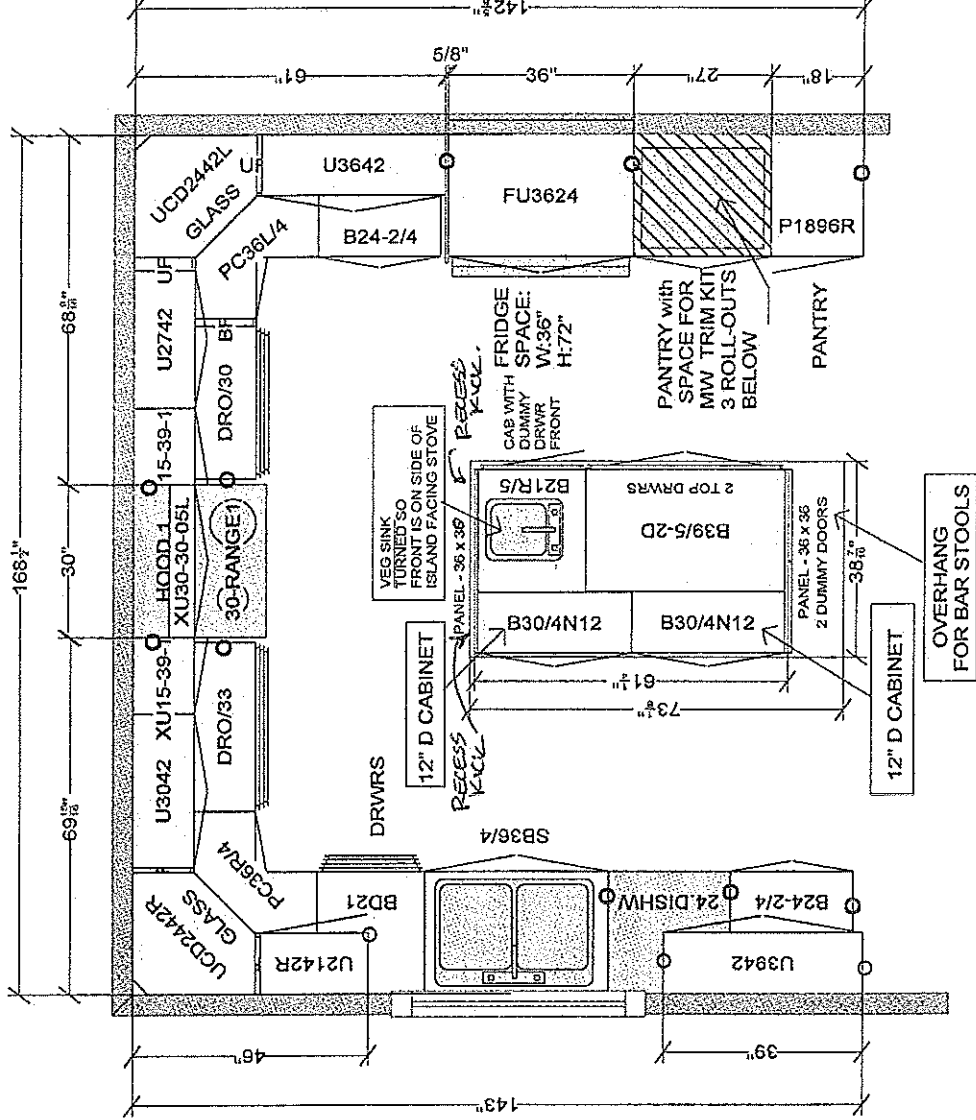

All dimensions size designations given are subject to verification on job site and adjustment to fit job conditions.

CARTIER KITCHENS OTTAWA



2020 TECHNOLOGIES

This is an original design and must not be released or copied unless applicable fee has been paid or job order placed.

DRAWN BY: LD
CARTIER KITCHENS OTTAWA

Designed: 8/27/2011
Printed: 10/9/2011

DCR - LOT #7 SM5 - PLATINA (512) - LEFT - KITCHEN

All

Drawing #: 1

CUSTOMER APPROVAL

I have reviewed these drawings and understand the details of the layout and the Carrier Kitchens specifications.

Signature: *[Signature]*

Date: Feb. 15th / 12

DCR - LOT #7 SMS - PLATINA (512) - LEFT - All

DRAWN BY: Lori Di Saverio, B.I.D.
CARRIER KITCHENS OTTAWA

Note: This drawing is an artistic interpretation of the general appearance of the design. It is not meant to be an exact rendition.

2020 TECHNOLOGIES

Printed: 10/9/2011
Designed: 8/27/2011

Drawing #: 1

3D View #2 - Kitchen
REV. OCT. 9/11



CUSTOMER APPROVAL

I have reviewed these drawings and understand the details of the layout and the Carrier Kitchens specifications.

Signature: *[Signature]*
 Date: Feb. 1st / 12

Note: This drawing is an artistic interpretation of the general appearance of the design. It is not meant to be an exact rendition.

DRAWN BY: Lori Di Saverio, B.I.D.
 CARRIER KITCHENS OTTAWA


DCR - LOT #7 SMS - PLATINA (512) - LEFT - All

Drawing #: 1

2020 TECHNOLOGIES

Printed: 10/3/2011
 Designed: 8/27/2011

3D View #1 - Kitchen - Pl. 049/11

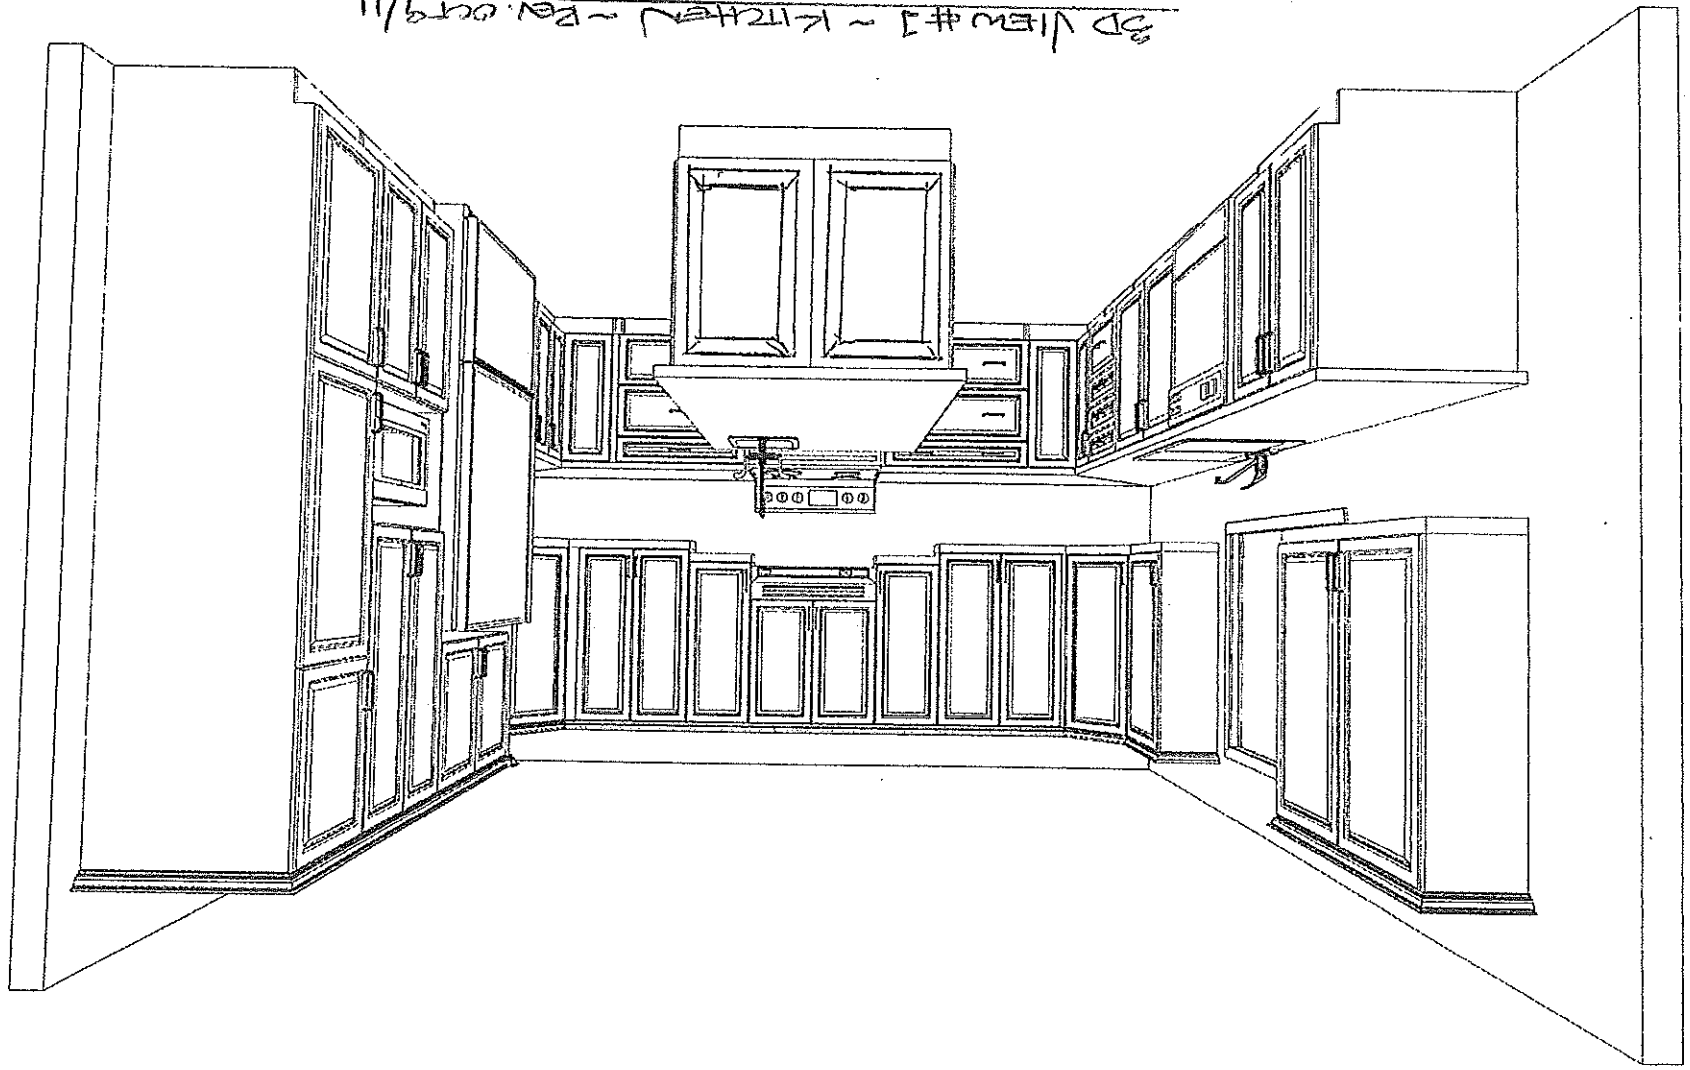

CUSTOMER APPROVAL

I have reviewed these drawings and understand the details of the layout and the Carlor Kitchens specifications.

Signature: *[Signature]*

Date: Feb. 15, 1/2

DCR - LOT #7 SMS - PLATINA (512) - LEFT -
 DRAWN BY: Lori Di Saverio, B.I.D.
 CARTIER KITCHENS OTTAWA


2020
 TECHNOLOGIES

Carlor
 KITCHENS

Designed: 8/27/2011
 Printed: 10/9/2011
 Drawing #: 1


3D #4 - Kitchen
 Rev. 02 9/11

5. RECESS KICK

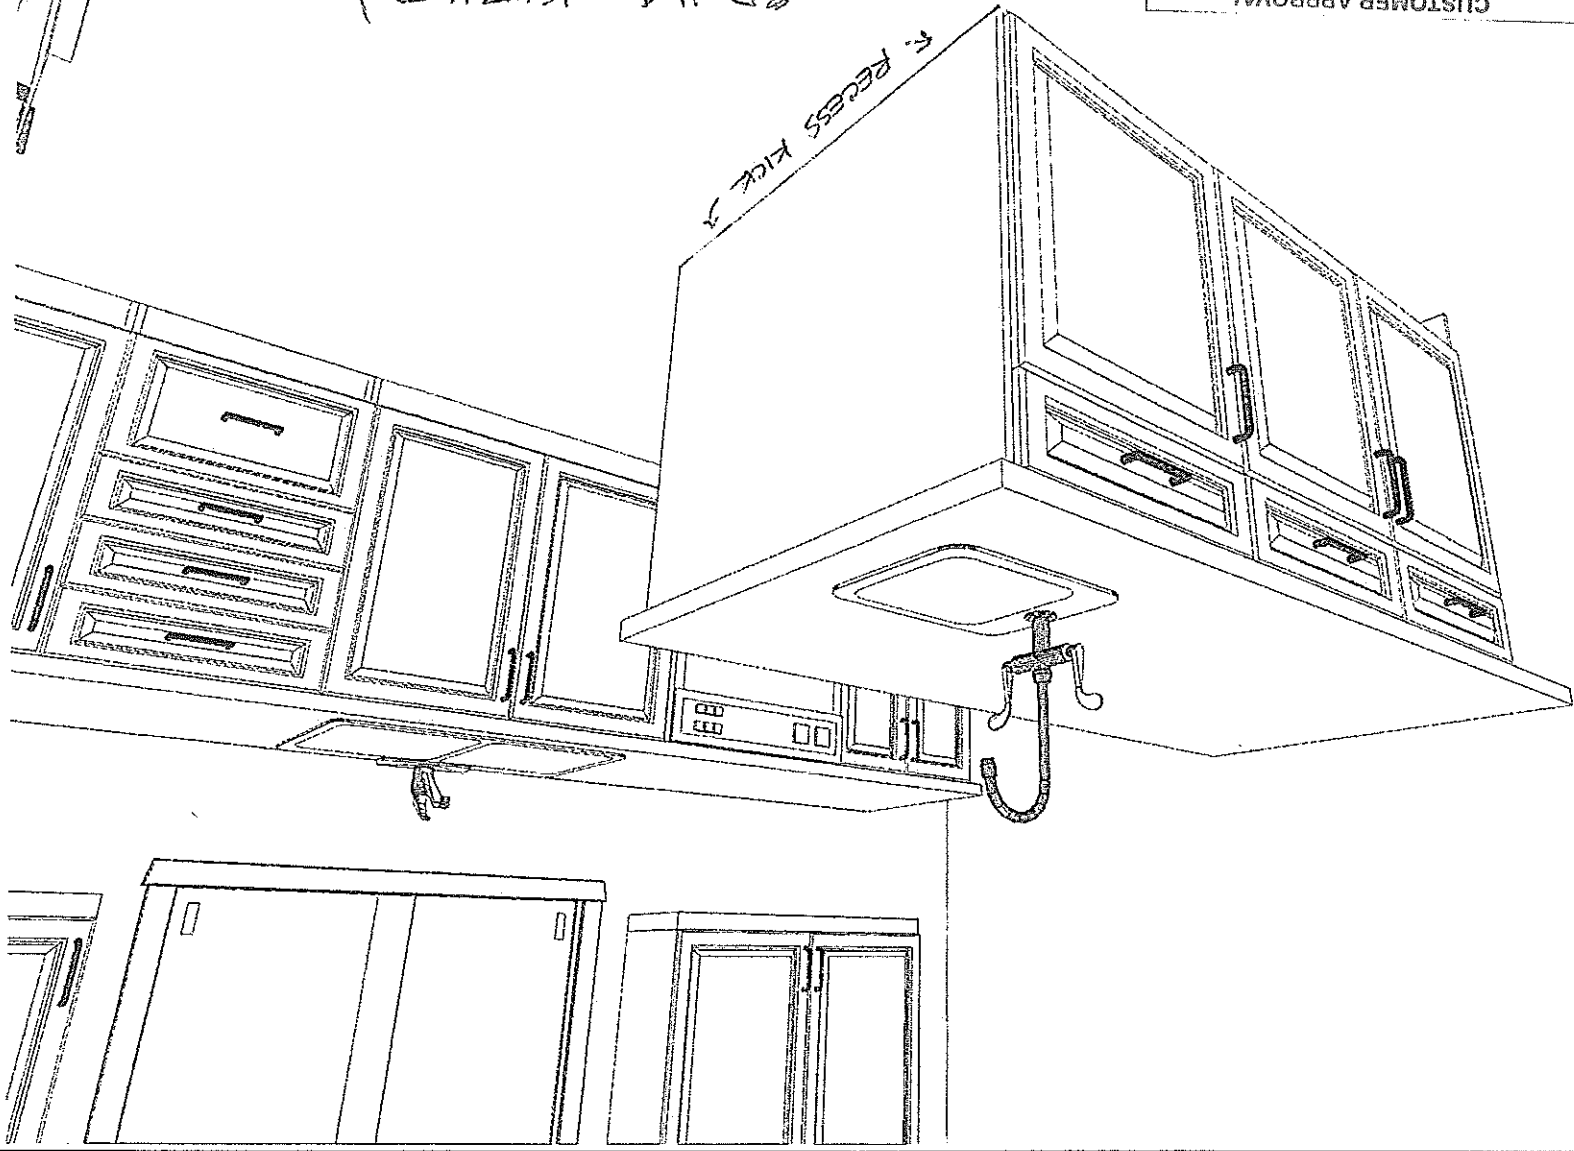

CUSTOMER APPROVAL
 I have reviewed these drawings and understand the details of the layout and the Carter Kitchens specifications.
 Signature: *[Signature]*
 Date: Feb. 15th / 12

3D #3 - Kitchen
 Rev. Oct. 9/11

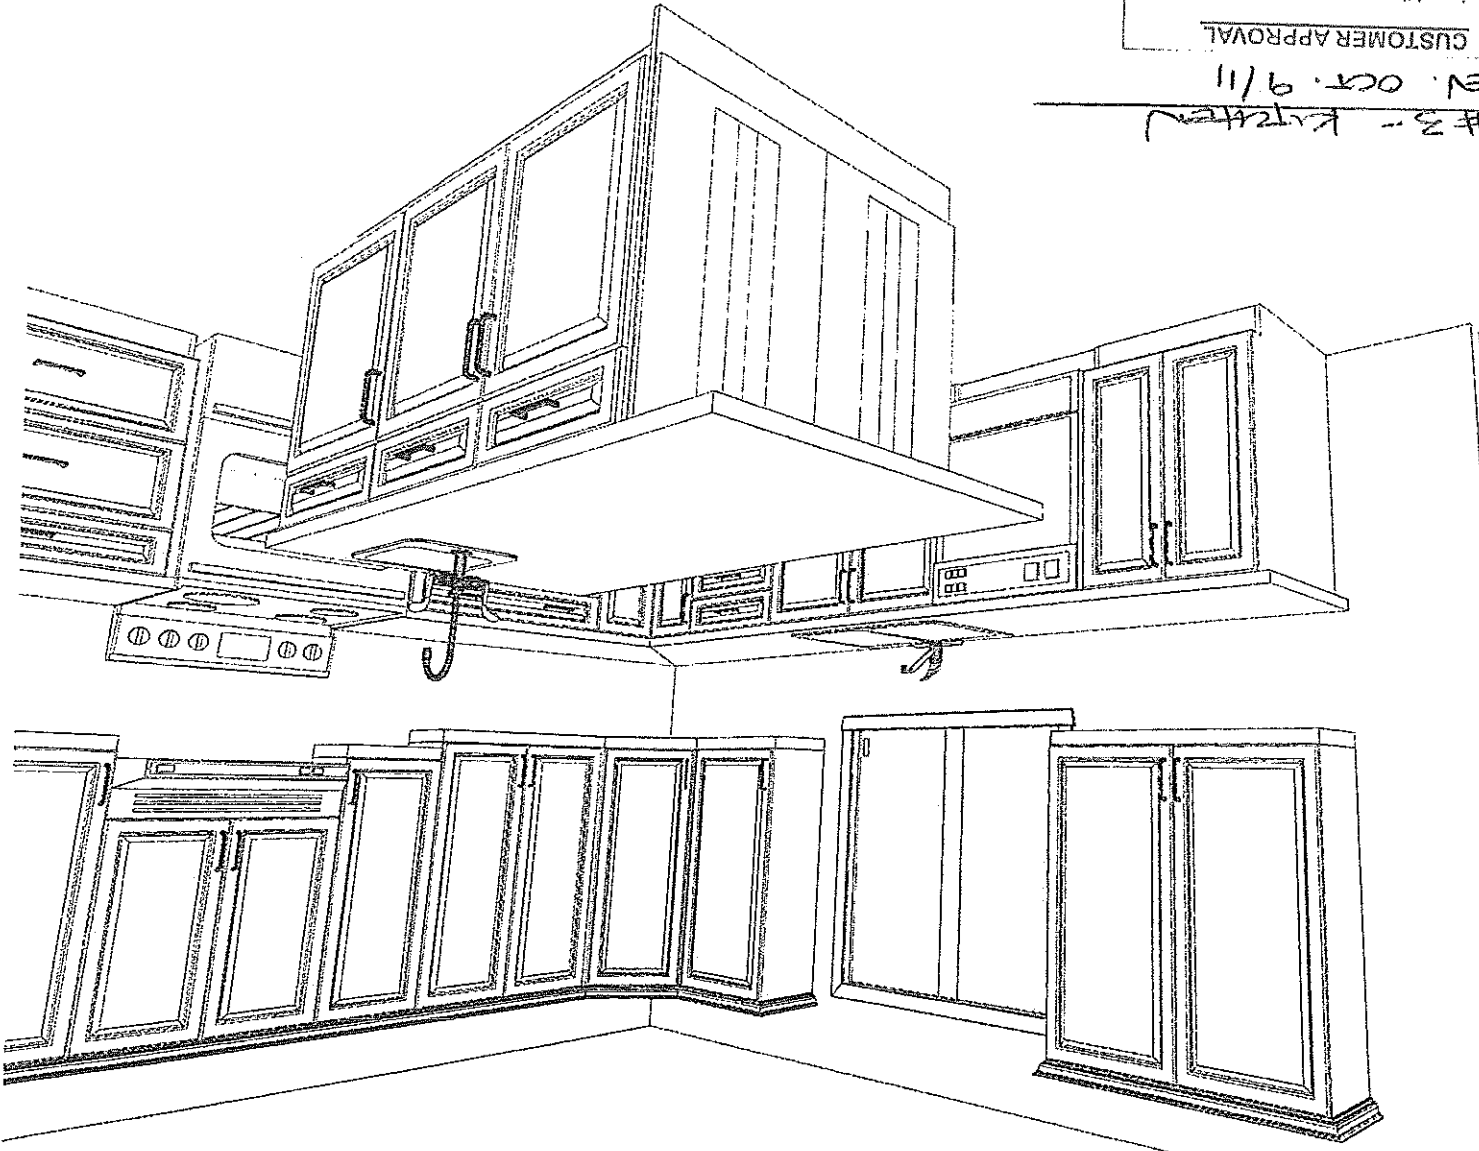

Note: This drawing is an artistic interpretation of the general appearance of the design. It is not meant to be an exact rendition.
 DRAWN BY: Lori Di Saverio, B.I.D.
 CARTER KITCHENS OTTAWA
 DCR - LOT #7 SMS - PLATINA (S12) - LEFT - All
 Drawing #: 1
 Designed: 8/27/2011
 Printed: 10/9/2011
 2020 TECHNOLOGIES

CUSTOMER APPROVAL

I have reviewed these drawings and understand the details of the layout and the Carter Kitchens specifications.

Signature: *[Signature]*
 Date: Feb. 15th / 12

DCR - LOT #7 SMS - PLATINA (512) - LEFT -
 DRAWN BY: Lori Di Saverio, B.I.D.
 CARTIER KITCHENS OTTAWA

2020
 TECHNOLOGIES

2020
 KITCHENS

Note: This drawing is an artistic interpretation of the general appearance of the design. It is not meant to be an exact rendition.

Designed: 8/27/2011
 Printed: 10/9/2011

Drawing #: 1

3D View #5 - Kitchen
 Rev. Oct 9/11

