


LOT 139 SMTOWNS.

NOTE: THIS DRAWINGS DOES NOT
REPRESENT THE ACTUAL UNIT TYPE.
IT IS USE ONLY TO SHOW POSSIBLE
LOCATIONS OF RAILING UPGRADES
FROM STANDARD HALF WALL.

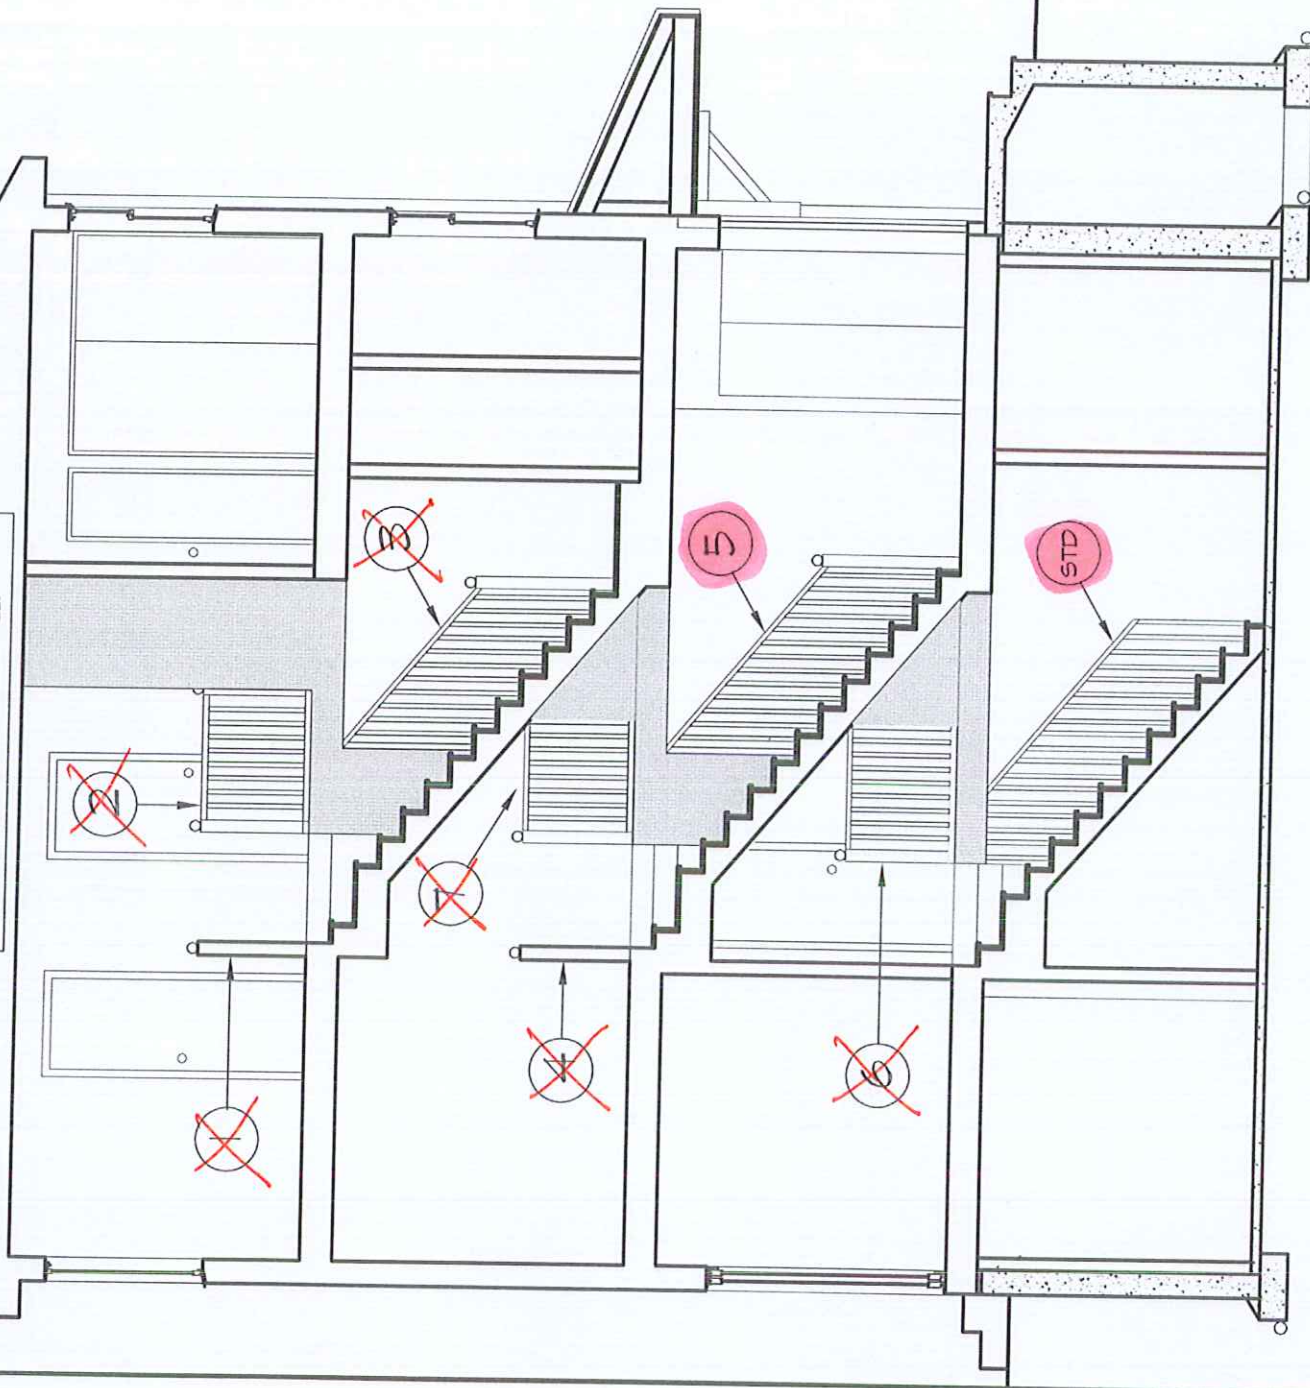

1 SECTION - TYPE 'A'
A15