


13L SR SEMI'S
LISTELLO IN ENSUITE

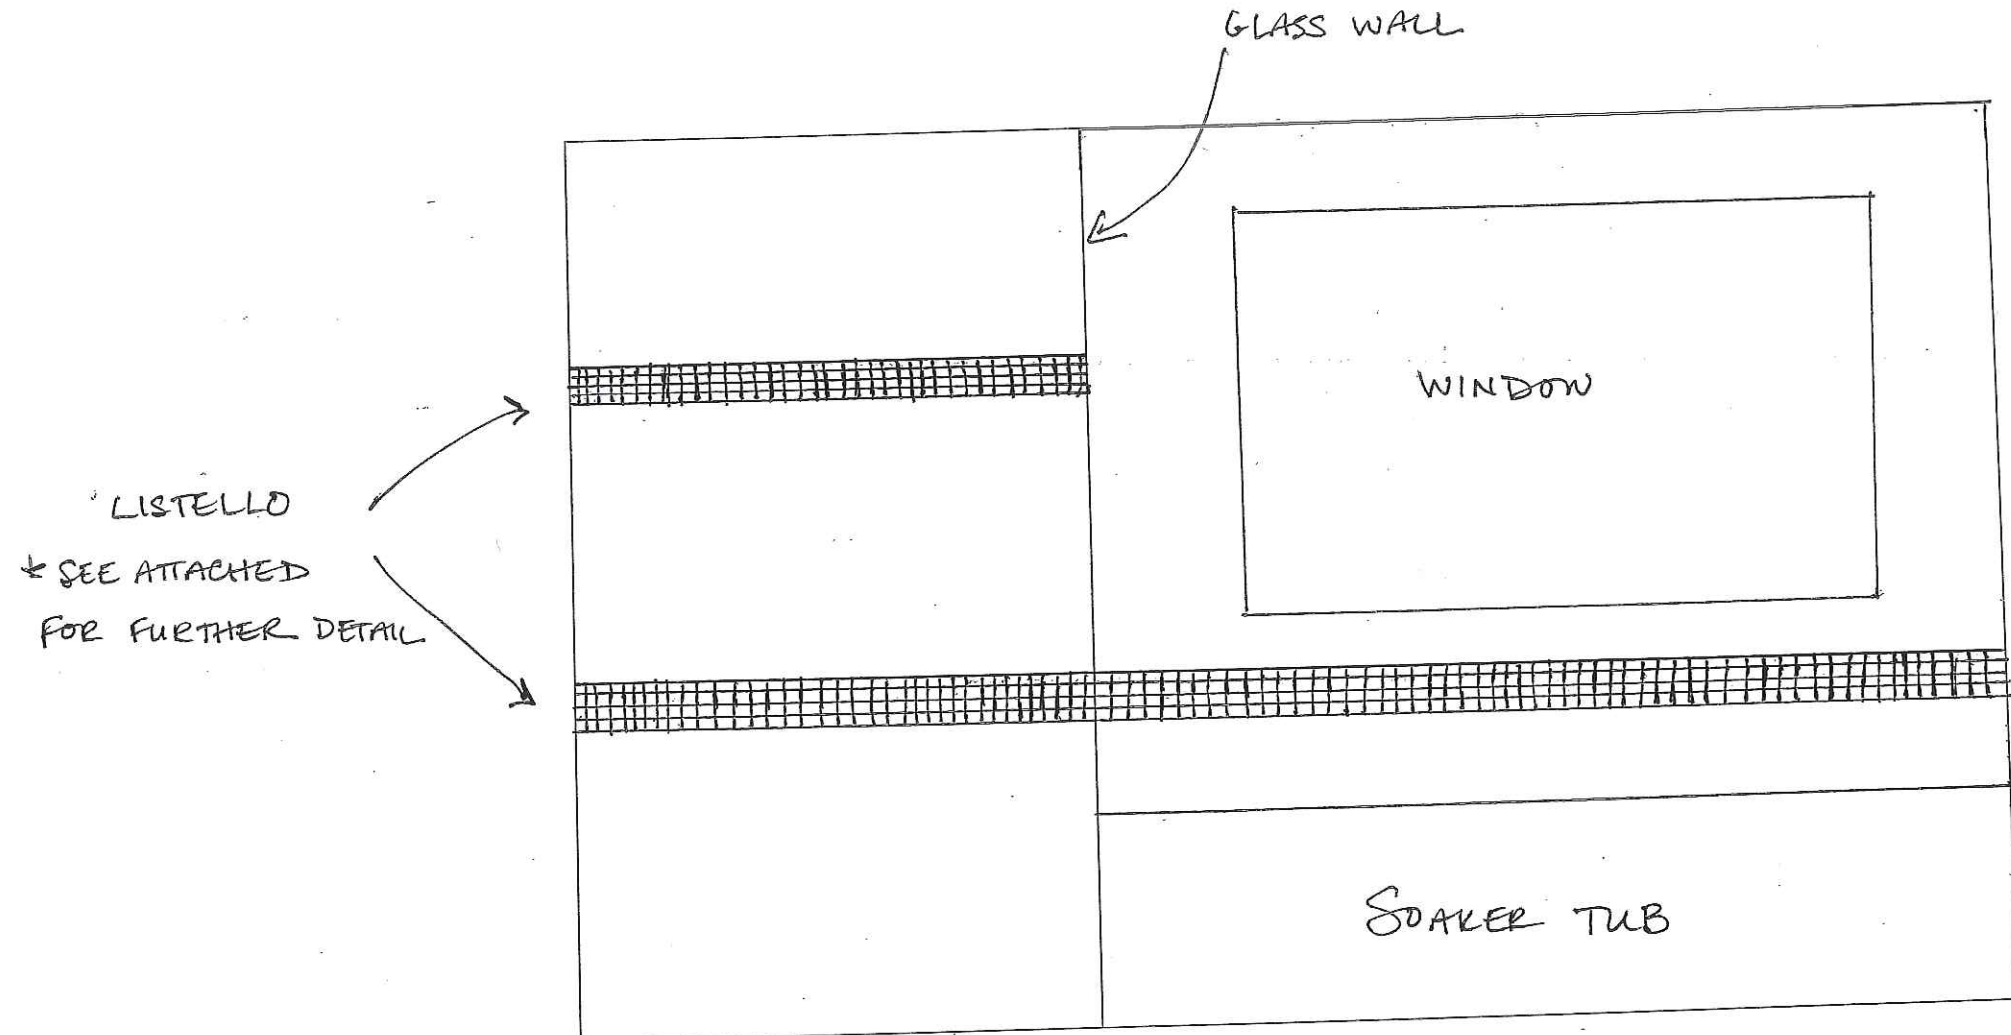

NOTE: SEE CONSTRUCTION
SUMMARY AND SHOP DRAWINGS
FOR UPDATES NOT SHOWN ON
THIS PLAN


FROSTED GLASS
WINDOW

SEE SUMMARY FOR
SHOWER UPGRADE

UPGRADE
ON (3) WALLS


PROPERTY LINE

CENTER LINE

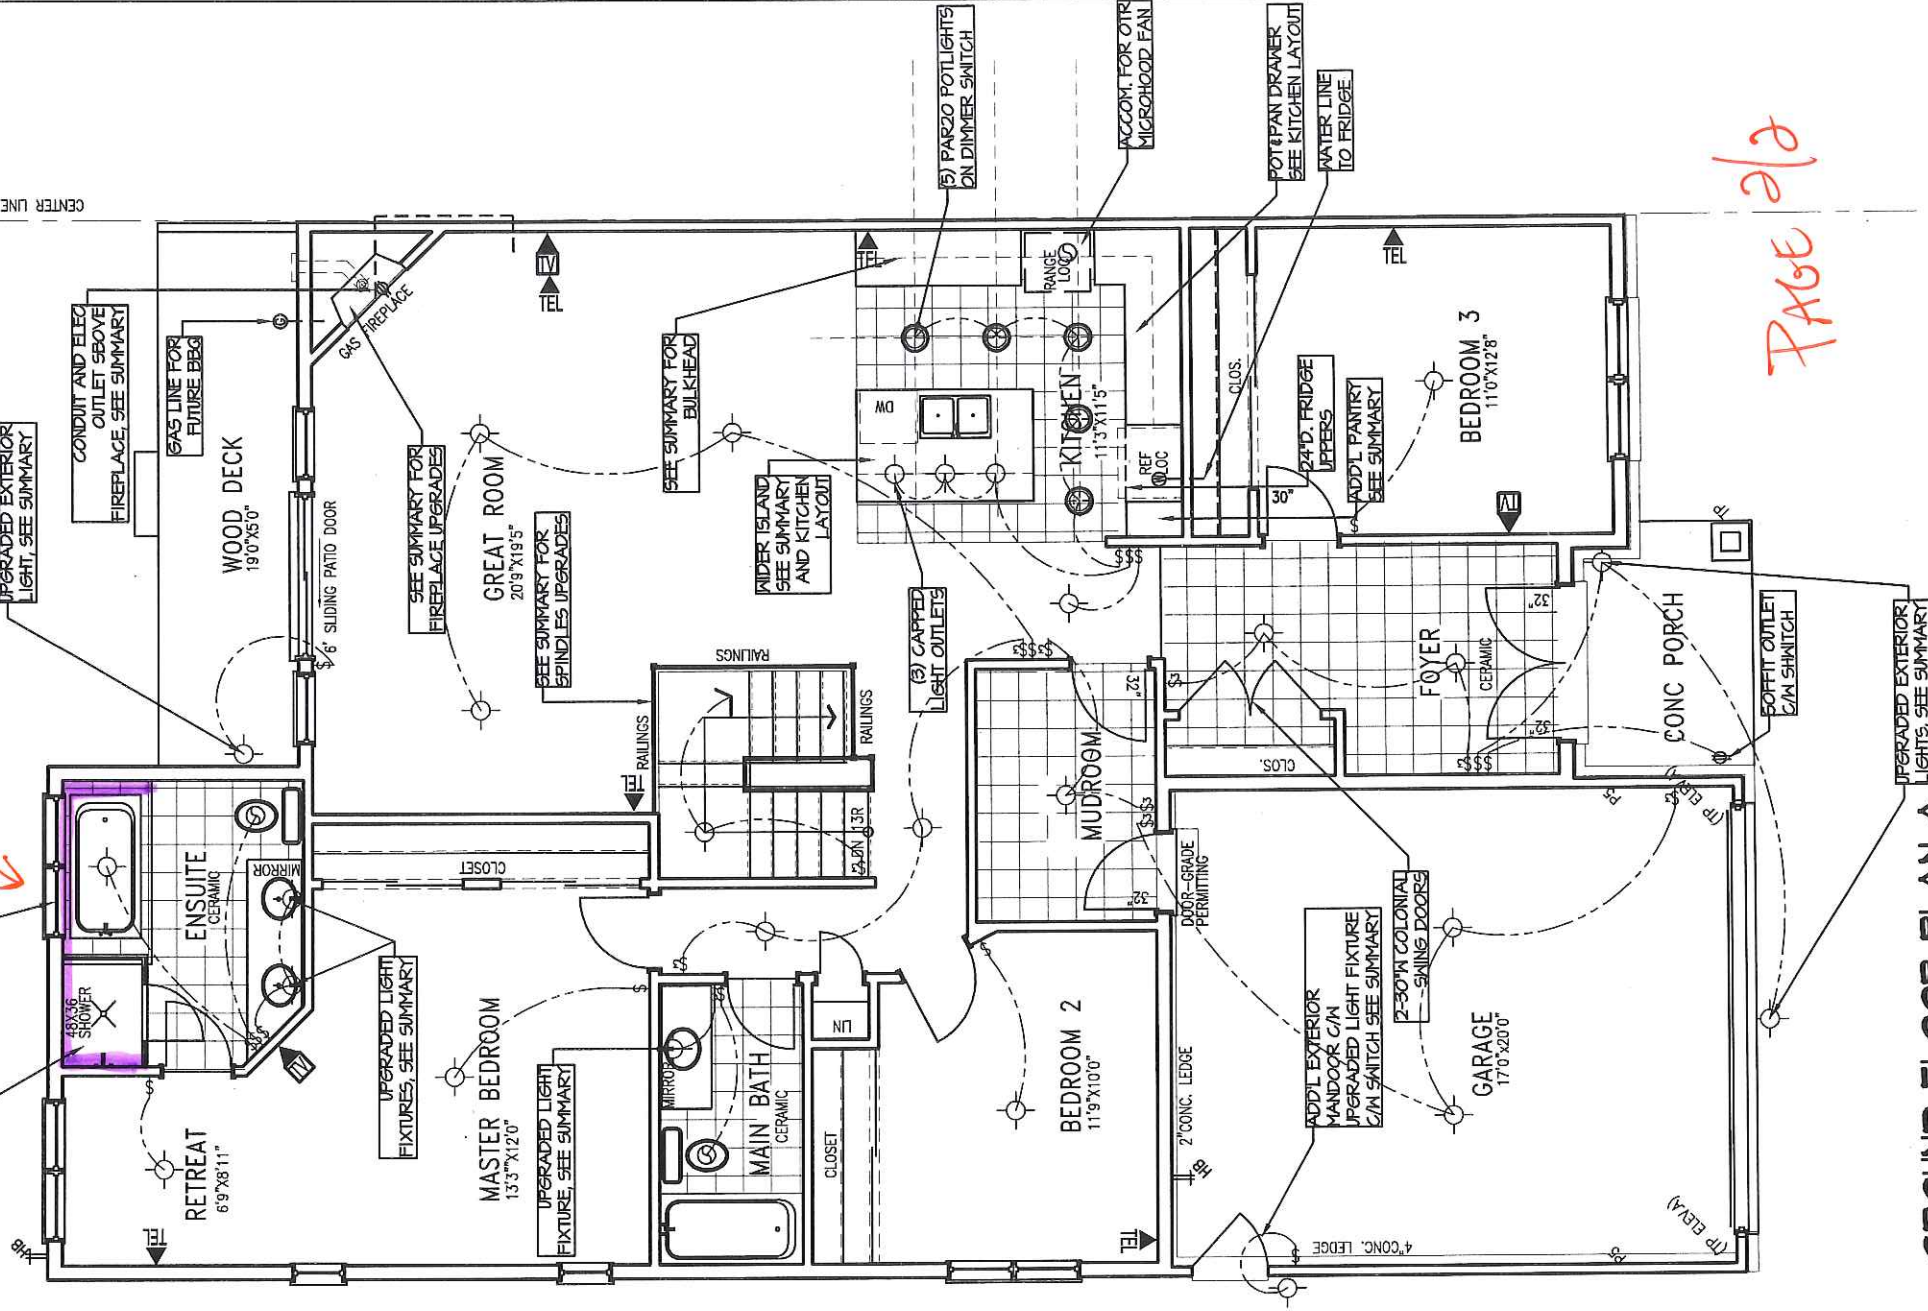

PAGE 2/2

GROUND FLOOR PLAN A 1654 SQ FT

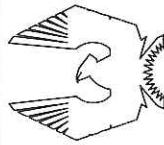

PHOENIX HOMES

SB-6 ORION 2012

SITE: SHADOW RIDGE 2

LOT NUMBER:

CIVIC ADDRESS:
6624 CALWOOD AVE.

36L

footprint: SB6

drawn by: TL

date: NOV/11

scale: 3/16"=1'-0"

sheet no:

3
7

1 REV. AS PER CONST. SUMMARY

JUL 22-19

Date

By

50

REVISIONS