


NOTE:
ALL SBs ARE SB2 U/ NOTED

NOTE:
ROOF TRUSS INFORMATION REFER TO ROOF
TRUSS SHOP DRAWINGS FOR ALL ROOF FRAMING
INFORMATION UNLESS OTHERWISE NOTED.

NOTE: ROOF FRAMING INFORMATION
ALL LAMINATED VENEER LUMBER (LVL) BEAMS, BUILT-UP BEAMS,
GIRDER TRUSSES AND METAL HANGER CONNECTIONS SUPPORTING
ROOF FRAMING TO BE DESIGNED AND CERTIFIED BY ROOF TRUSS
MANUFACTURER. REFER TO ROOF TRUSS SHOP DRAWINGS FOR
ALL ROOF FRAMING INFORMATION UNLESS OTHERWISE NOTED ON
ARCHITECTURAL DRAWINGS.

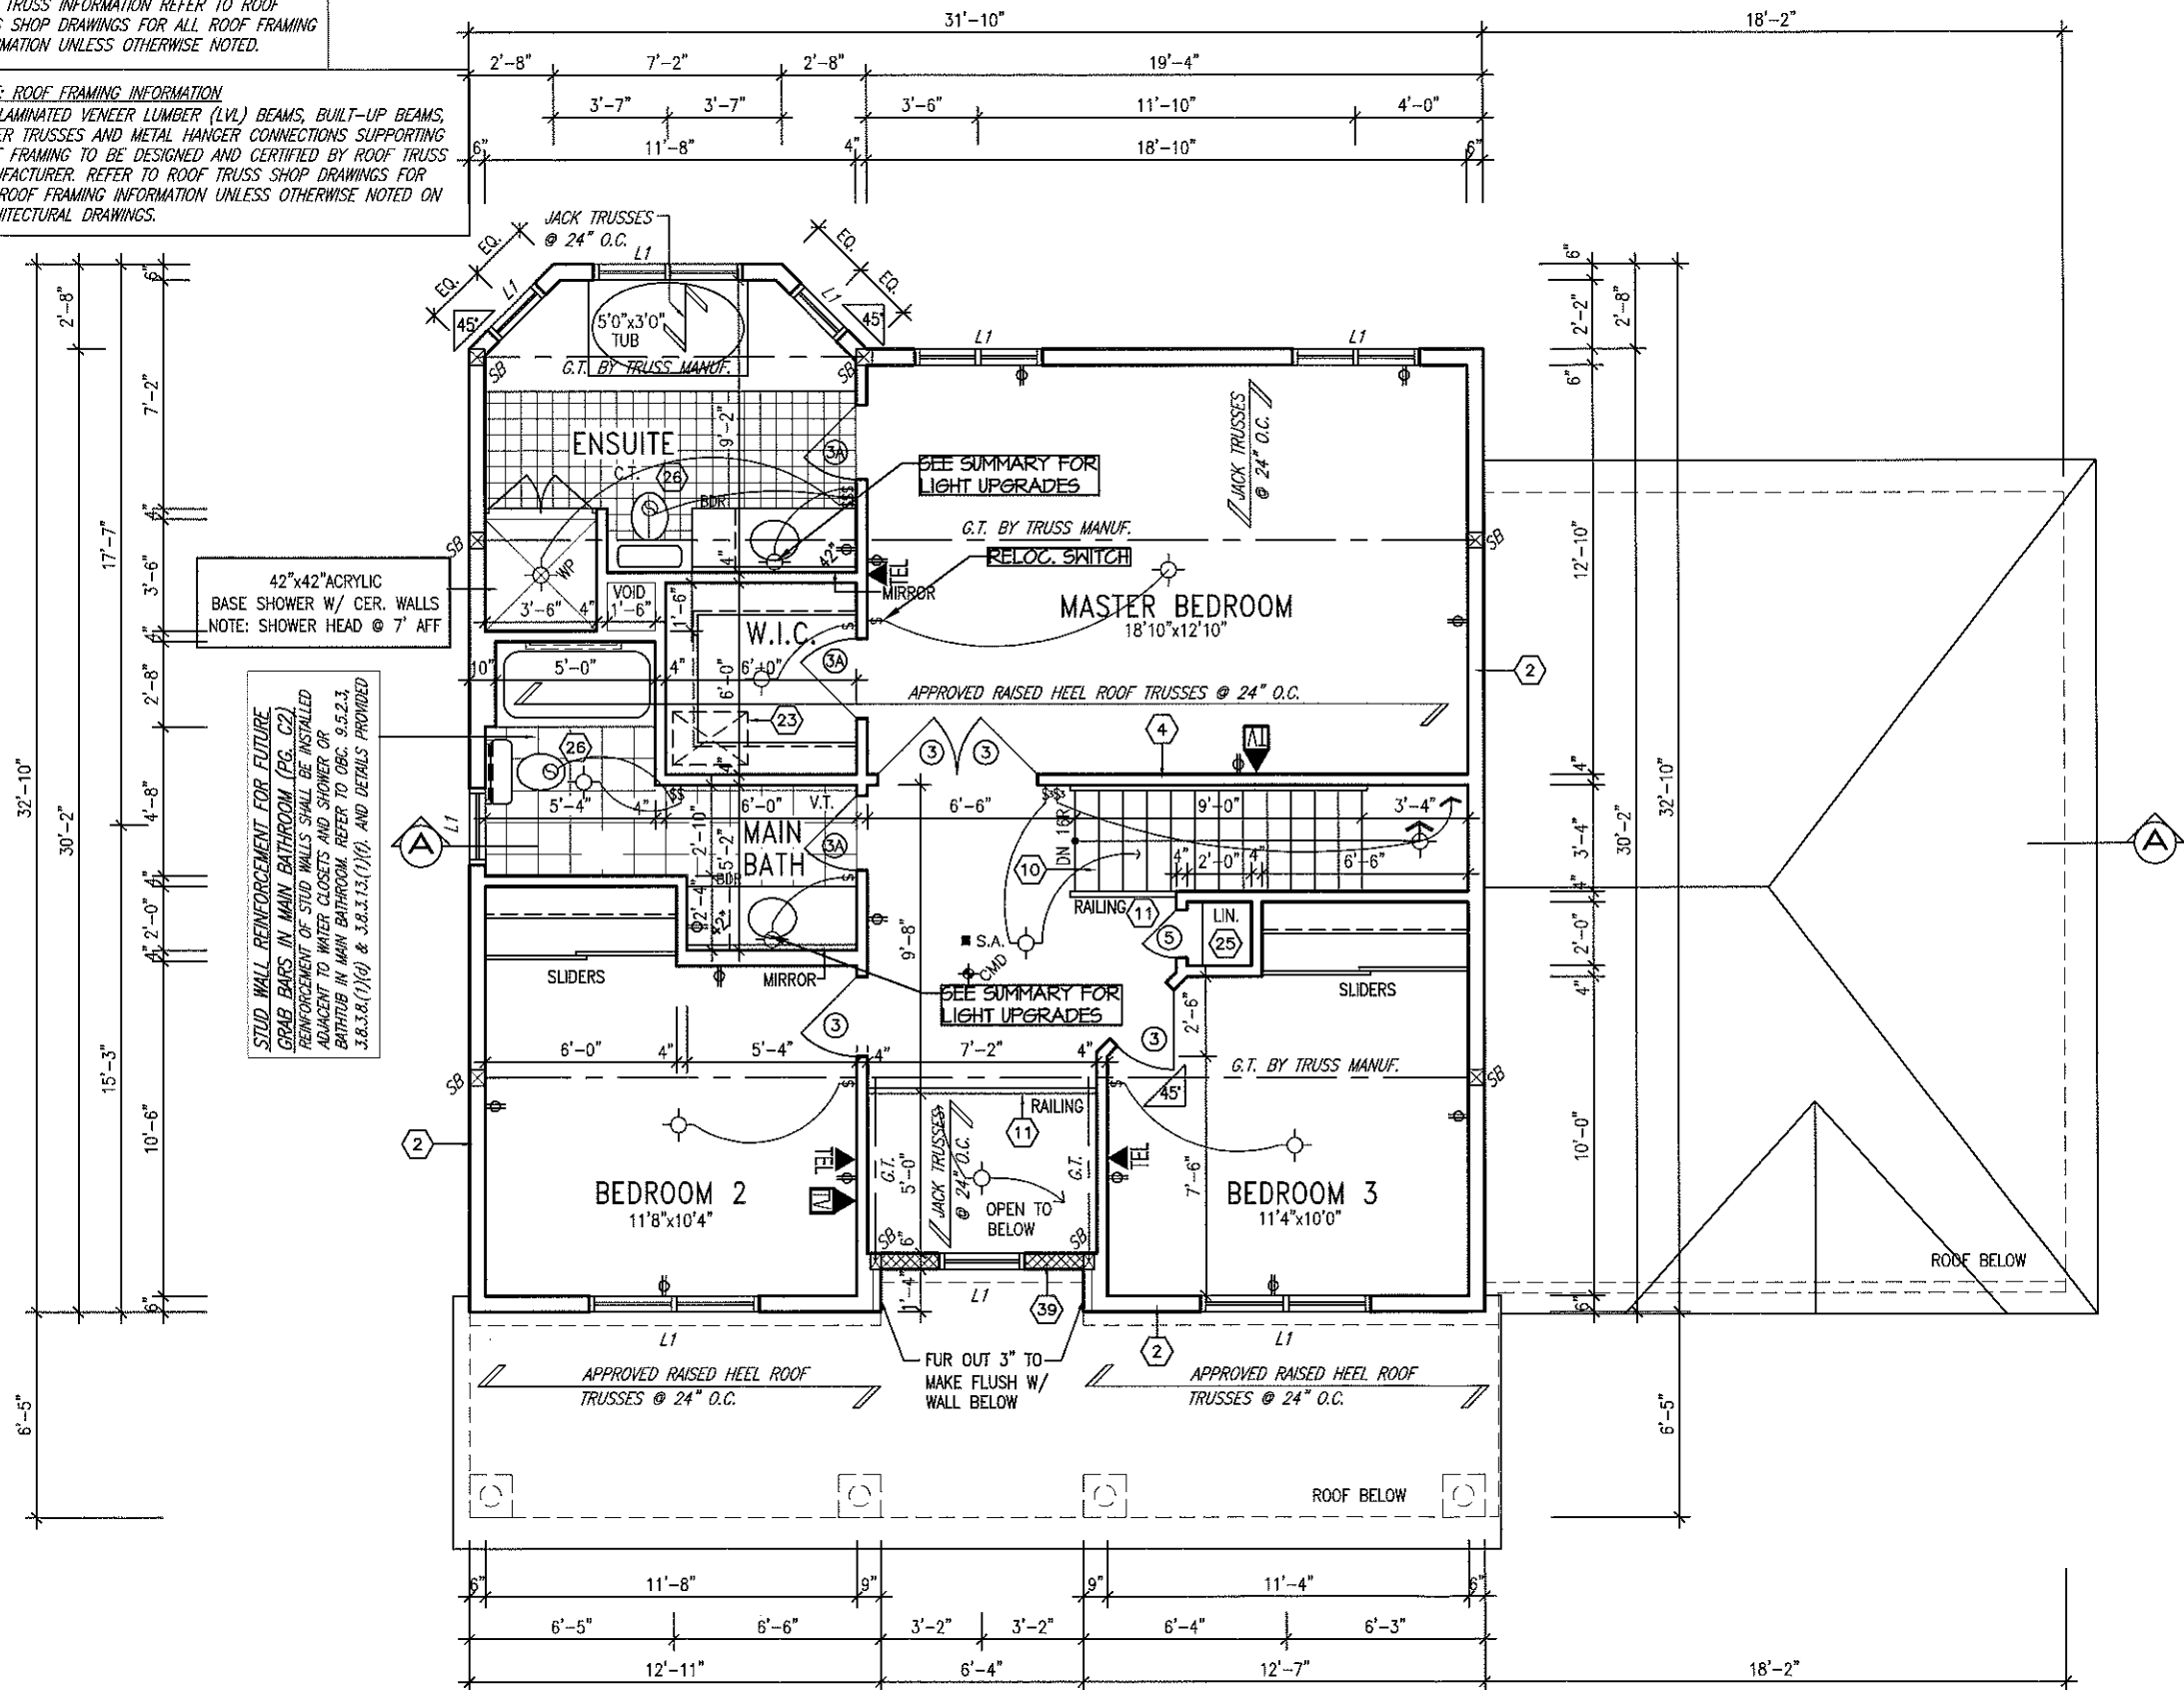

SECOND FLOOR PLAN 'A'


Footprint:	51-A
Sheet:	SECOND FLOOR-A
Drawn By:	CL
Checked By:	OF
Date:	FEB. 2007
Scale:	3/16"=1'
Sheet No.:	3A 6


REV.	AS PER CONST. SUMMARY	DATE	BY
5	REV. AS PER CONST. SUMMARY	MAY13-13	SD
4	REDUCED GARAGE WIDTH TO FIT INCREASED GARAGE LENGTH	APR30-13	SD
3	REV. AS PER CONST. SUMMARY	JUL31-12	SD
2	REV. AS PER CONST. SUMMARY	JUL25-12	SD
1	ISSUED FOR FOUNDATION ONLY	JUNE14-12	SD

GREGORIAN-2007-A
SITE: SHADOW RIDGE2
LOT NUMBER: 4
CIVIC ADDRESS: 6900 MARY ANNE DR.

Viljoen Architect Inc.


300 A. Wilson Avenue
North York, Ontario
M3H 1S8
TEL: (416) 630-2255
FAX: (416) 630-4782

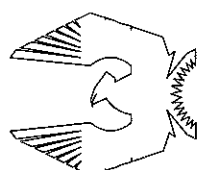 **PHOENIX HOMES**

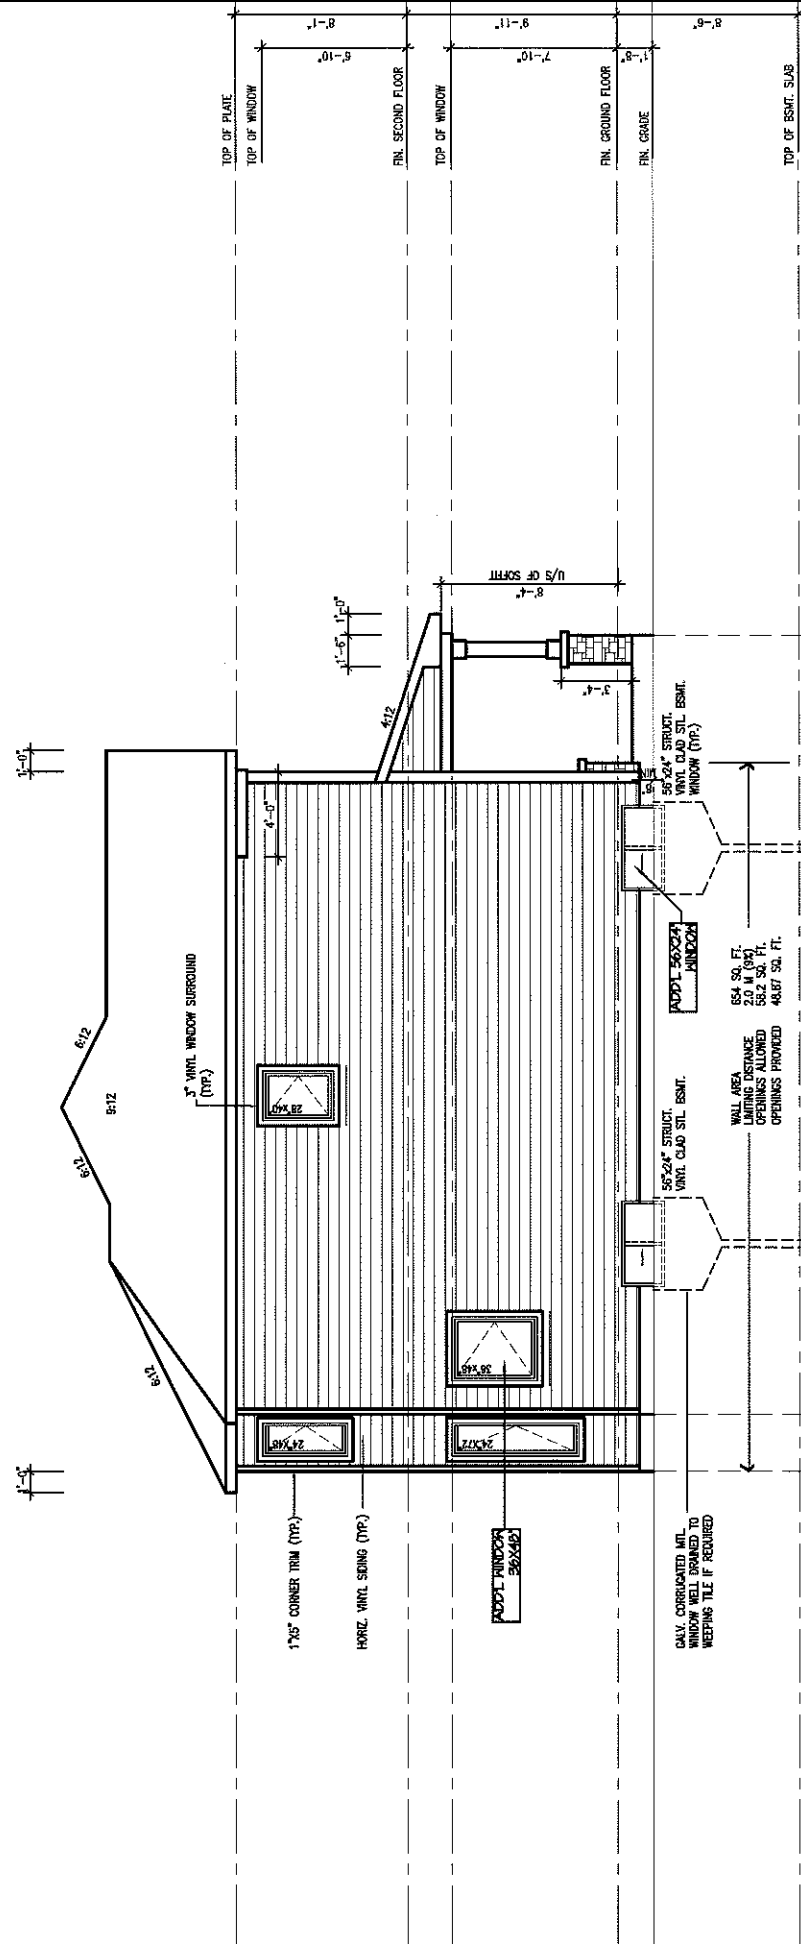


LEFT ELEVATION 'A'

NOTE:
REFER TO FRONT ELEVATION FOR TYPICAL
NOTES & INFORMATION

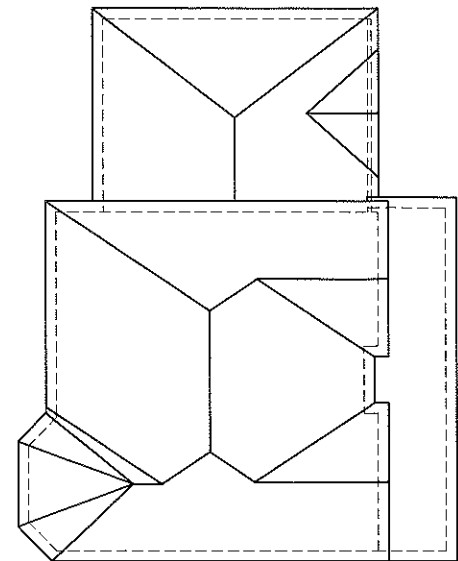

ROOF PLAN 'A'
N.T.S.

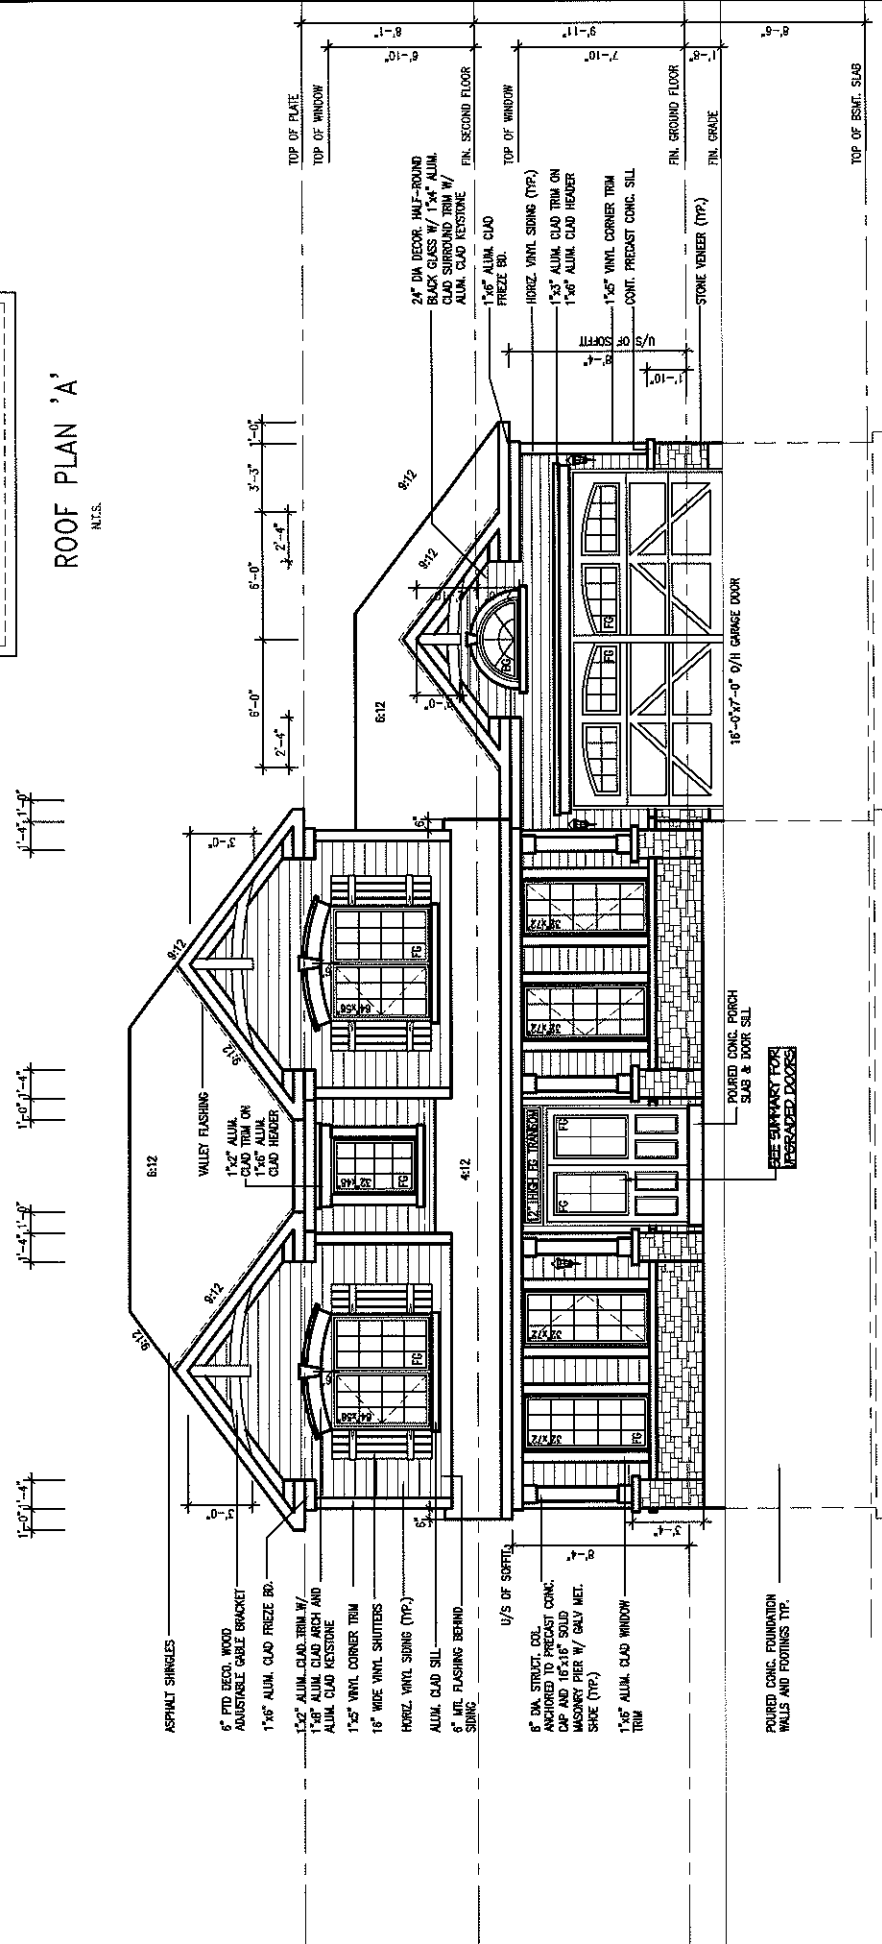

FRONT ELEVATION 'A' (SIDING W/ STONE BASE)

PHOENIX HOMES

Viljoen Architect Inc.

300 A Wilson Avenue
North York, Ontario
M3H 1S8
TEL: (416) 630-2255
FAX: (416) 630-4782

GREGORIAN-2007-A

SITE: SHADOW RIDGE2

LOT NUMBER:
CIVIC ADDRESS:
6900 MARY ANNE DR.

4

REVISIONS		No.	Description	Date	By
5	REV. AS PER CONST. SUMMARY	MAY3-B	SD		
4	REDUCED GARAGE WIDTH TO FIT INCREASED GARAGE LENGTH	APR30-B	SD		
3	REV. AS PER CONST. SUMMARY	JUL31-2	SD		
2	REV. AS PER CONST. SUMMARY	JUL25-12	SD		
1	ISSUED FOR FOUNDATION ONLY	JUNE19-12	SD		

Footprint: S1-A

sh. title: ELEVATIONS-A

drawn by: CL

checked by: OF

date: FEB. 2007

scale: 1/8"=1'

sheet no:

4A
6




RIGHT ELEVATION 'A'

NOTE:
REFER TO FRONT ELEVATION FOR TYPICAL
NOTES & INFORMATION



REAR ELEVATION 'A'

NOTE:
REFER TO FRONT ELEVATION FOR TYPICAL
NOTES & INFORMATION

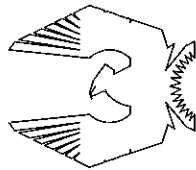

PHOENIX HOMES

Viljoen
Architect
Inc.

300 A. Wilson Avenue
North York, Ontario
M3H 1S8
TEL: (416) 630-2255
FAX: (416) 630-4782

GREGORIAN-2007-A

SITE: SHADOW RIDGE2


LOT NUMBER:

CIVIC ADDRESS:
6900 MARY ANNE DR.

4

REVISIONS		No.	Description	Date	By
5	REV. AS PER CONST. SUMMARY	MAY13-13	SD		
4	REDUCED GARAGE WIDTH TO FIT INCREASED GARAGE LENGTH	APR30-13	SD		
3	REV. AS PER CONST. SUMMARY	JUL31-12	SD		
2	REV. AS PER CONST. SUMMARY	JUL25-12	SD		
1	ISSUED FOR FOUNDATION ONLY	JUNE14-12	SD		

Footprint:	S1-A
Shl. Title:	ELEVATIONS-A
Drawn by:	CL
Checked by:	OF
Date:	FEB. 2007
Scale:	1/8"=1'
Sheet no:	5A/6

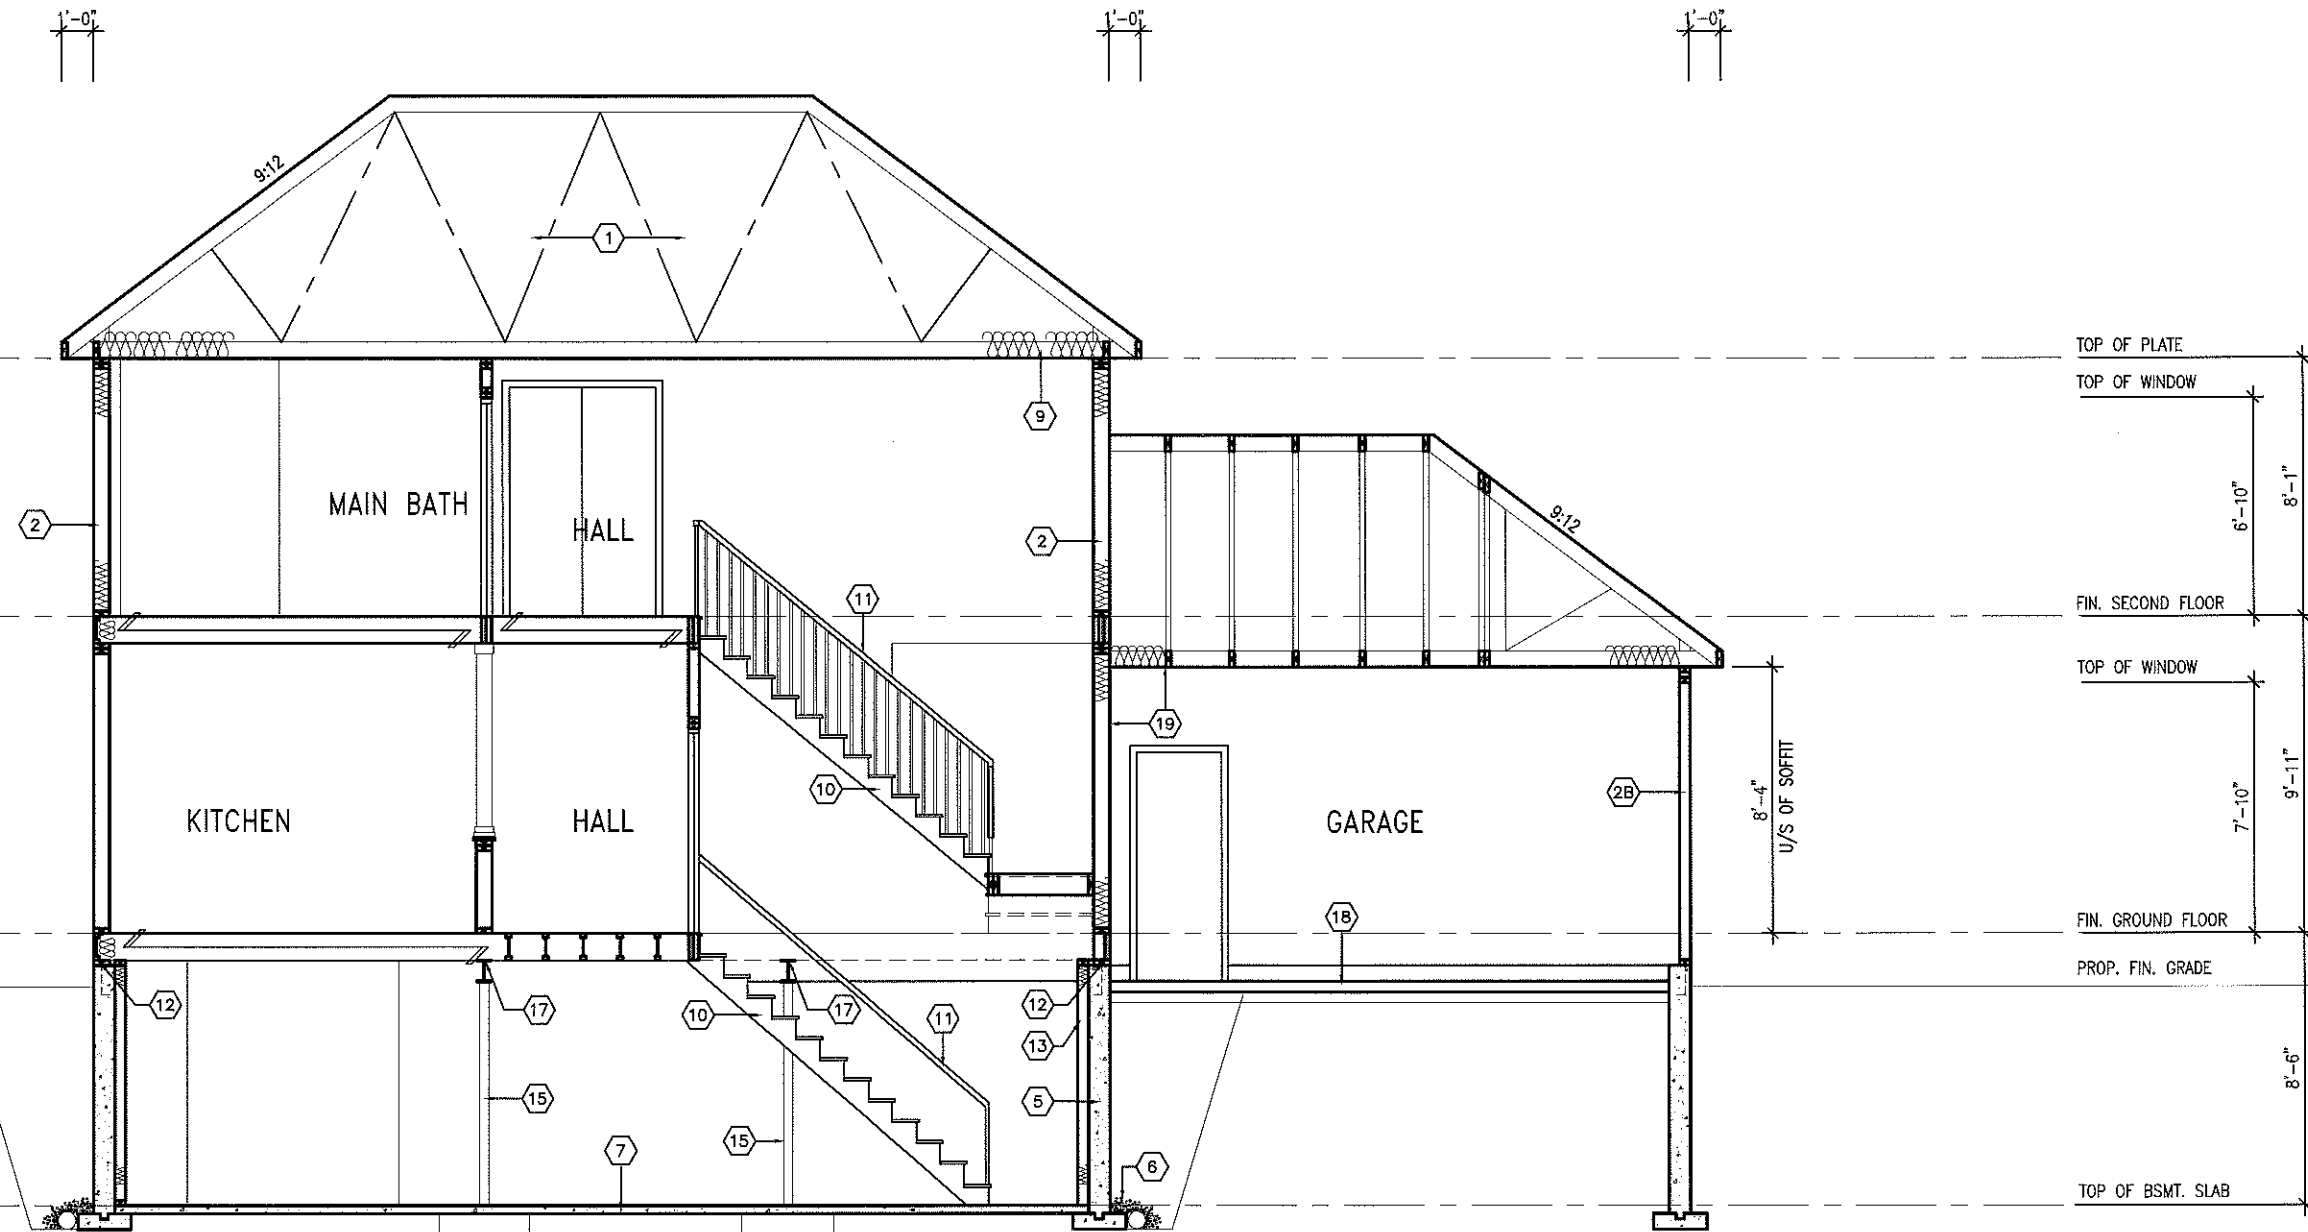

SECTION A-A



Viljoen Architect Inc.

300 A. Wilson Avenue
North York, Ontario
M3H 1S8
TEL: (416) 630-2255
FAX: (416) 630-4782

GREGORIAN-2007-A

SITE: **SHADOW RIDGE2**

LOT NUMBER:

4

CIVIC ADDRESS:
6900 MARY ANNE DR.

5	REV. AS PER CONST. SUMMARY	MAY13-13	SD
4	REDUCED GARAGE WIDTH TO FIT INCREASED GARAGE LENGTH	APR30-13	SD
3	REV. AS PER CONST. SUMMARY	JUL31-12	SD
2	REV. AS PER CONST. SUMMARY	JUL25-12	SD
1	ISSUED FOR FOUNDATION ONLY	JUNE19-12	SD
No.	Description	Date	By
REVISIONS			

Footprint: **S1-A**

sht. title: SECTION

drawn by: CL

checked by: OF

date: FEB, 2007

scale: 3/16"=1'

sheet no:

6

6