

DCFR PHOENIX HOMES

SHADOW RIDGE 2

LOT #53

MODEL - GREGORIAN (S1)

KITCHEN

MOUNTING HT: 96"

2" CROWN MOULDING

RECESSED LIGHT VALANCE


CUSTOMER APPROVAL

I have reviewed these drawings and understand the details of the layout and the Cartier Kitchens specifications.

Signature

Date

EB JV
July 24/13

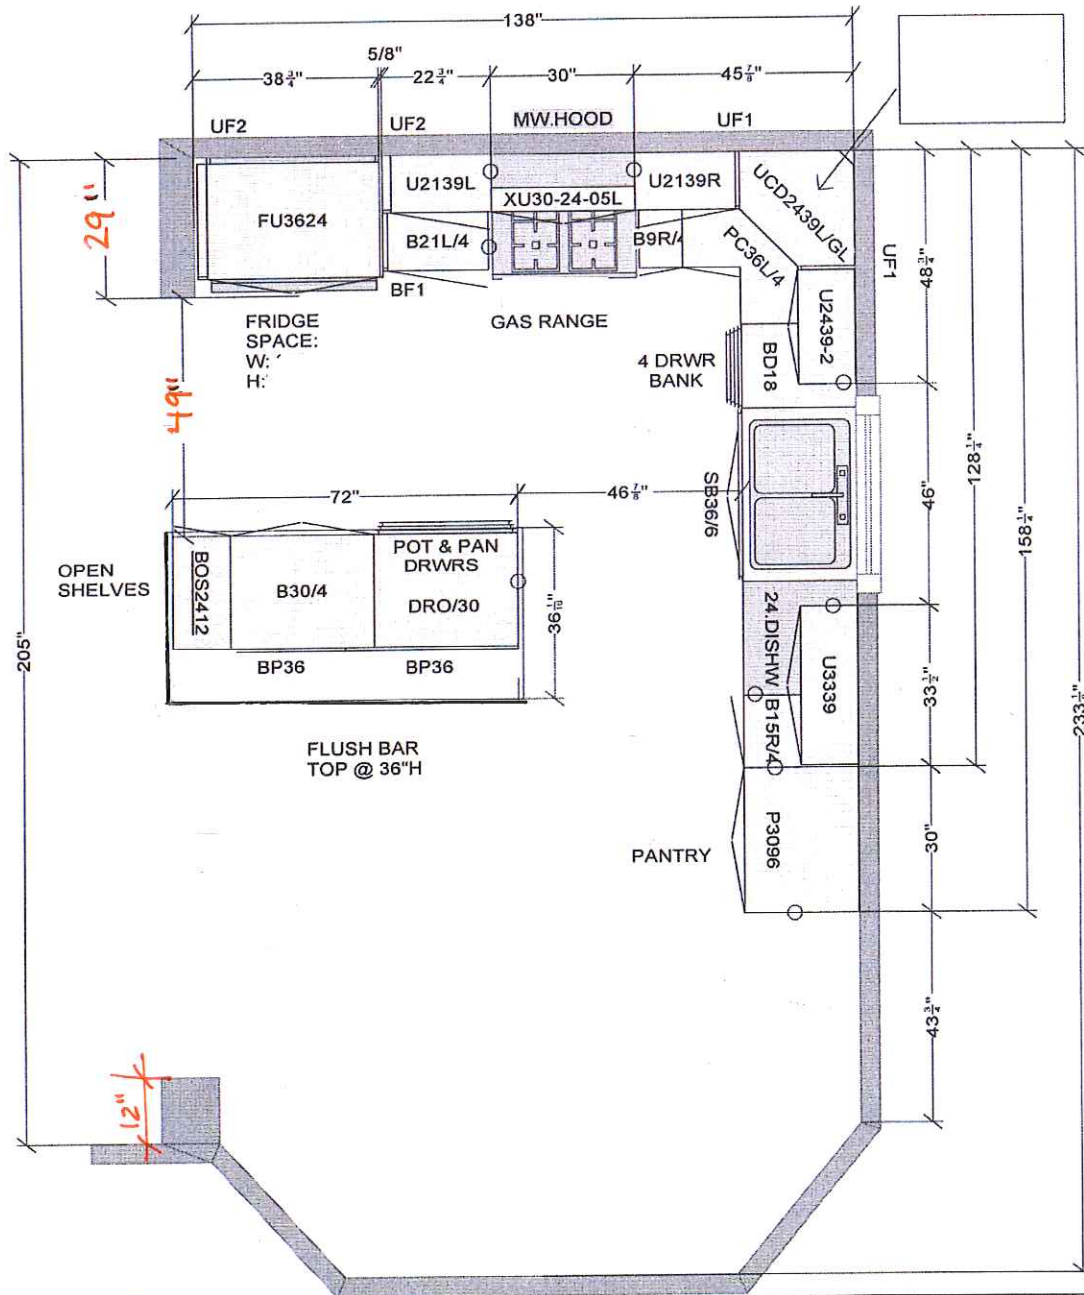

All dimensions size designations given are subject to verification on job site and adjustment to fit job conditions.

CARTIER KITCHENS OTTAWA

DCR - #53 SR2 - Kitchen



This is an original design and must not be released or copied unless applicable fee has been paid or job order placed.

DRAWN BY: LD
CARTIER KITCHENS OTTAWA

Designed: 2/13/2013
Printed: 2/13/2013

All

Drawing #: 1 No Scale.


CUSTOMER APPROVAL

I have reviewed these drawings and understand the details of the layout and the Cartier Kitchens specifications.

Signature X BB JV

Date July 24/13

3D View #3

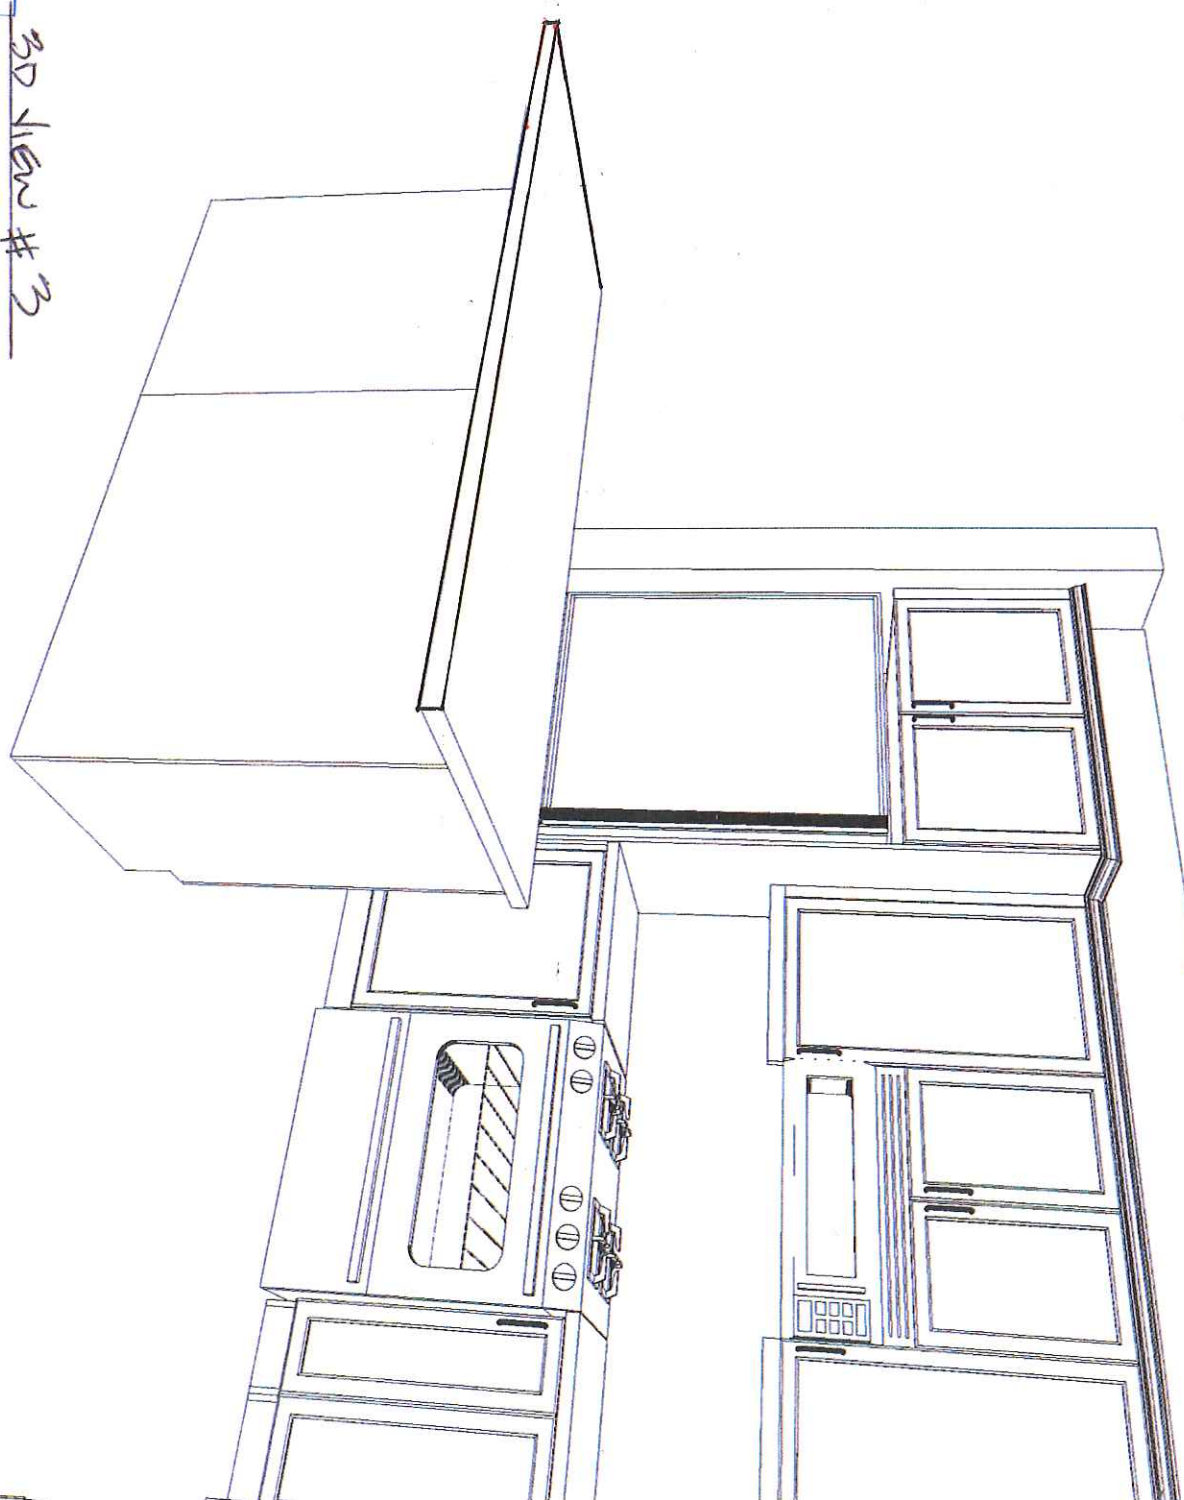

Note: This drawing is an artistic interpretation of the general appearance of the design. It is not meant to be an exact rendition.

DESIGNED BY: LORI DISAVERIO.

DCR - #53 SR2 - Kitchen




2020
TECHNOLOGIES

Designed: 2/13/2013
Printed: 2/13/2013

All

Drawing #: 1

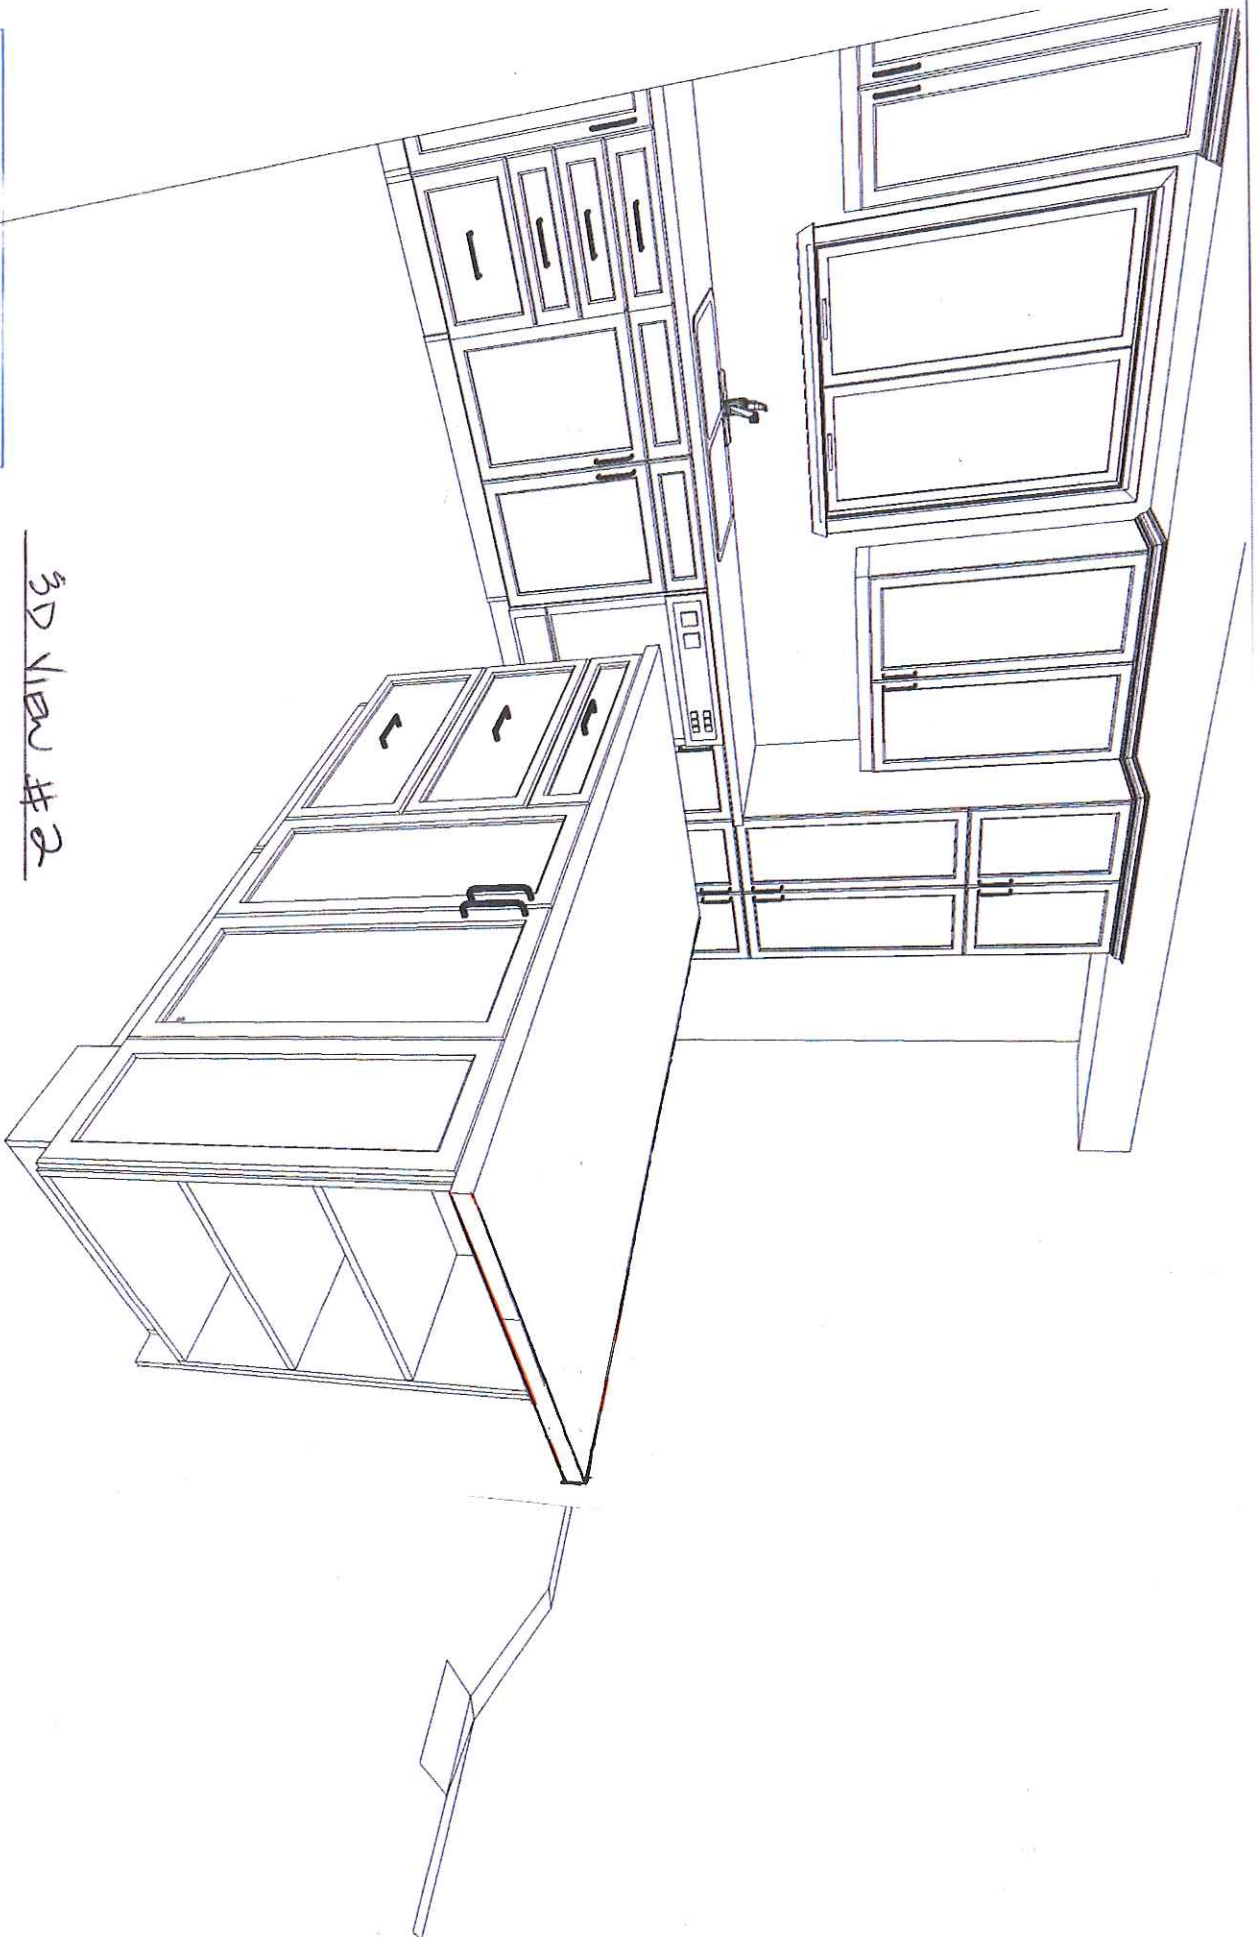

3D View #2

CUSTOMER APPROVAL

I have reviewed these drawings and understand the details of the layout and the Carter Kitchens specifications.

Signature [Signature]

Date July 24/13

Note: This drawing is an artistic interpretation of the general appearance of the design. It is not meant to be an exact rendition.

DESIGNED BY: LORI DISAVERIO.

DCR - #53 SR2 - Kitchen




2020
TECHNOLOGIES

Designed: 2/13/2013
Printed: 2/13/2013

All

Drawing #: 1

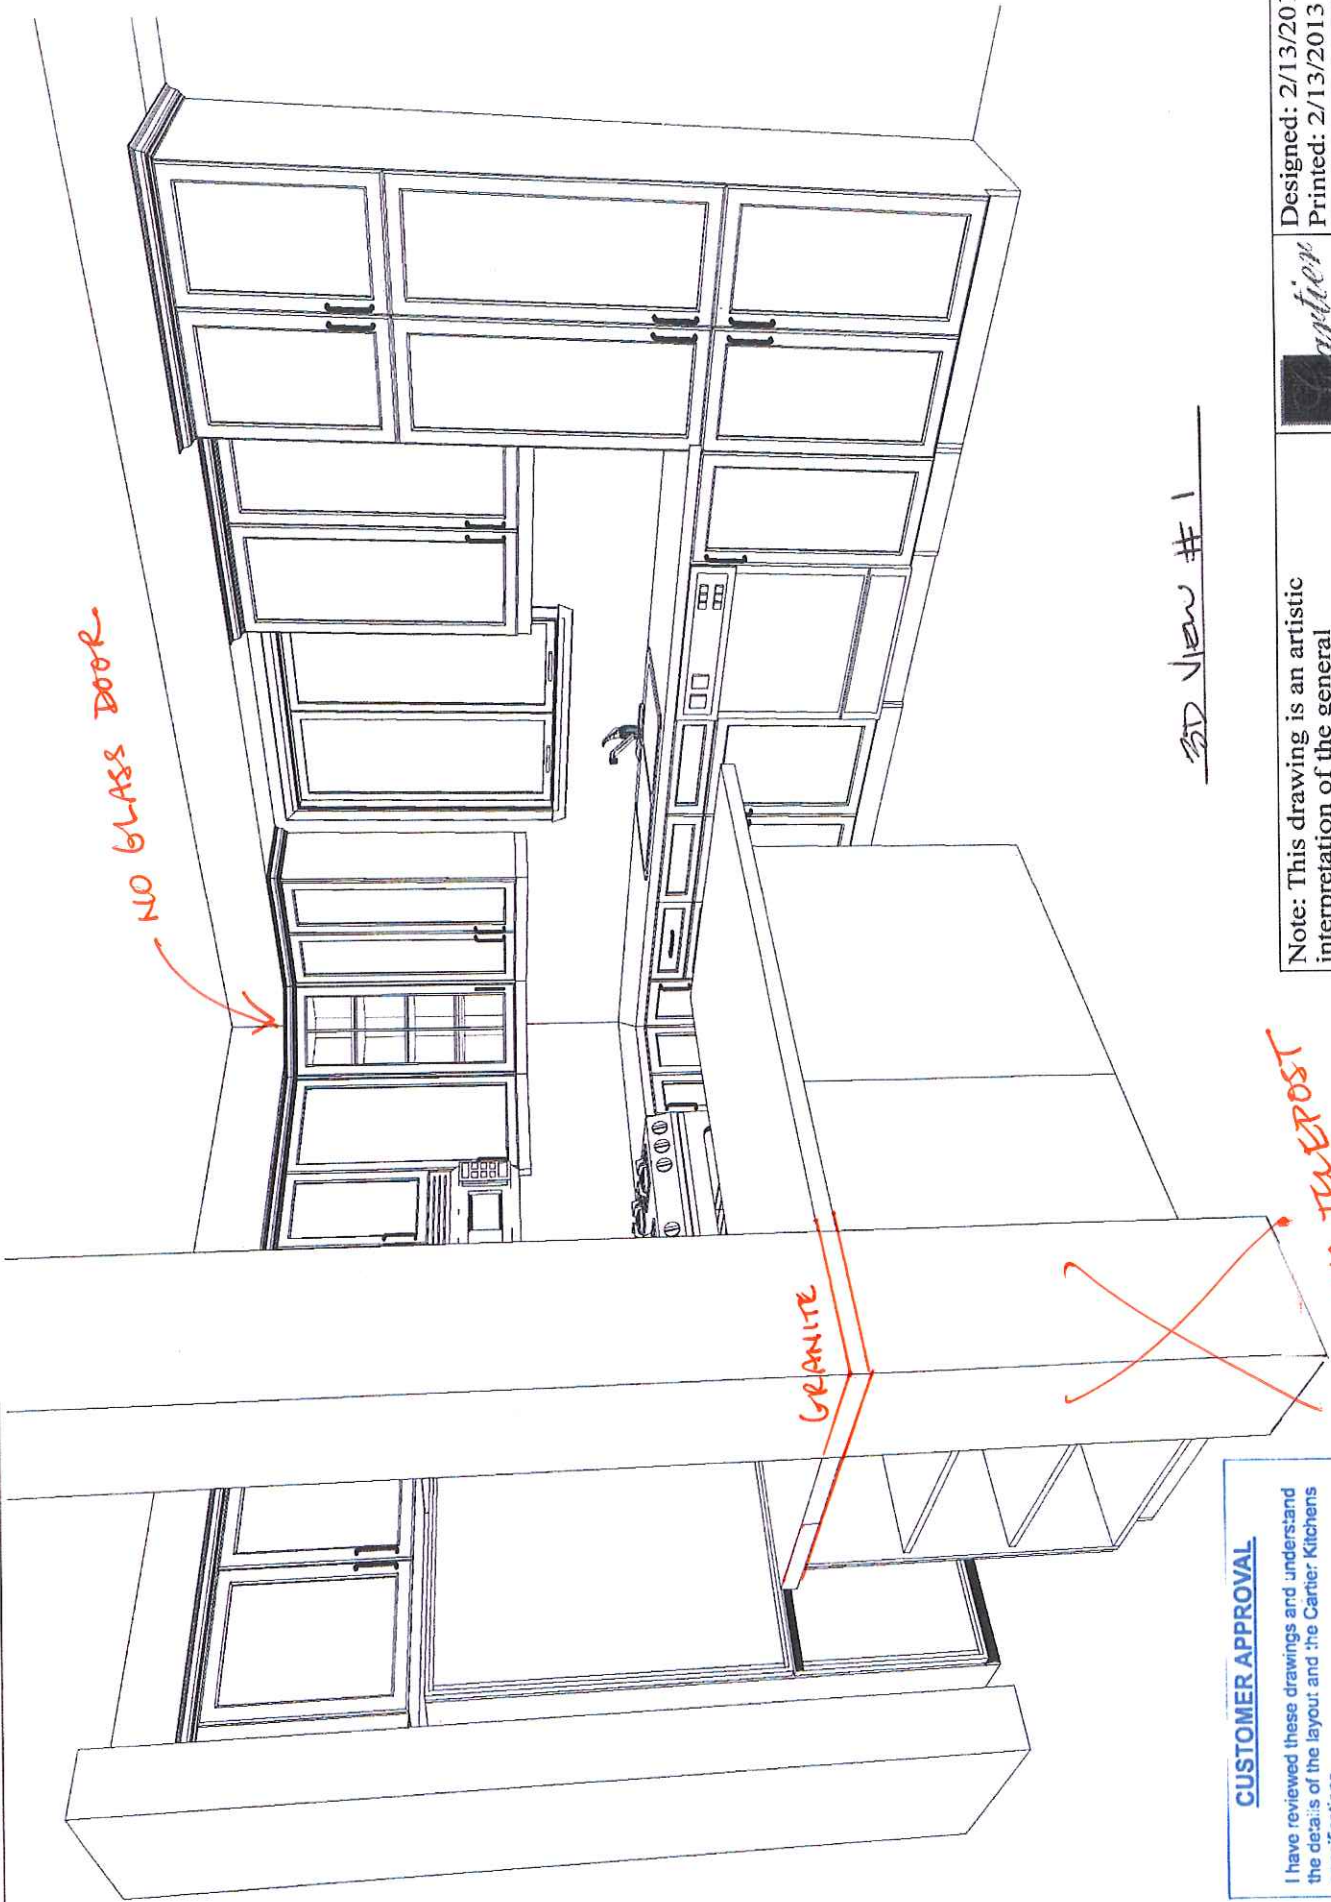

3D View #1

CUSTOMER APPROVAL

I have reviewed these drawings and understand the details of the layout and the Carter Kitchens specifications.

Signature EB JV

Date July 24/13

Note: This drawing is an artistic interpretation of the general appearance of the design. It is not meant to be an exact rendition.


DESIGNED BY: LORI DISAVERIO.
DCR - #53 SR2 - Kitchen



Designed: 2/13/2013
Printed: 2/13/2013

All Drawing #: 1

98" 96" 39" 21" 30" 2" 2"

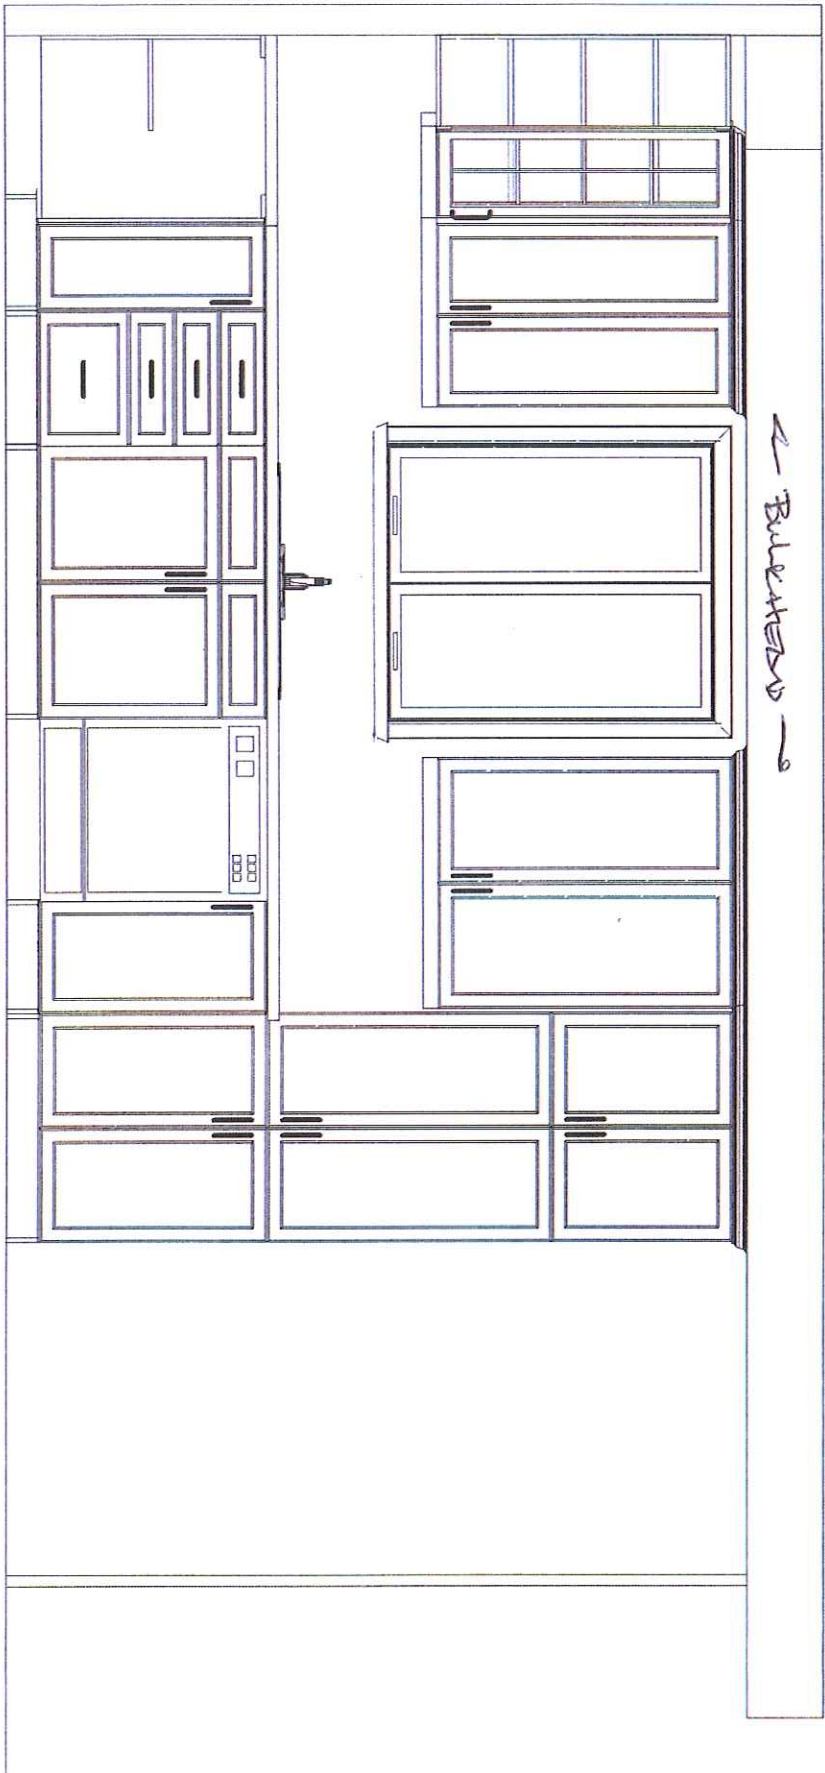

← Bulwark →

side view elevation

CUSTOMER APPROVAL

I have reviewed these drawings and understand the details of the layout and the Carter Kitchens specifications.

Signature

[Signature]

Date

July 21/13

Note: This drawing is an artistic interpretation of the general appearance of the design. It is not meant to be an exact rendition.

DESIGNED BY: LORI DISAVERIO.

DCR - #53 SR2 - Kitchen




Designed: 2/13/2013
Printed: 2/13/2013

2020
TECHNOLOGIES

All

Drawing #: 1

98"
96"
72" 24" 2" 2"

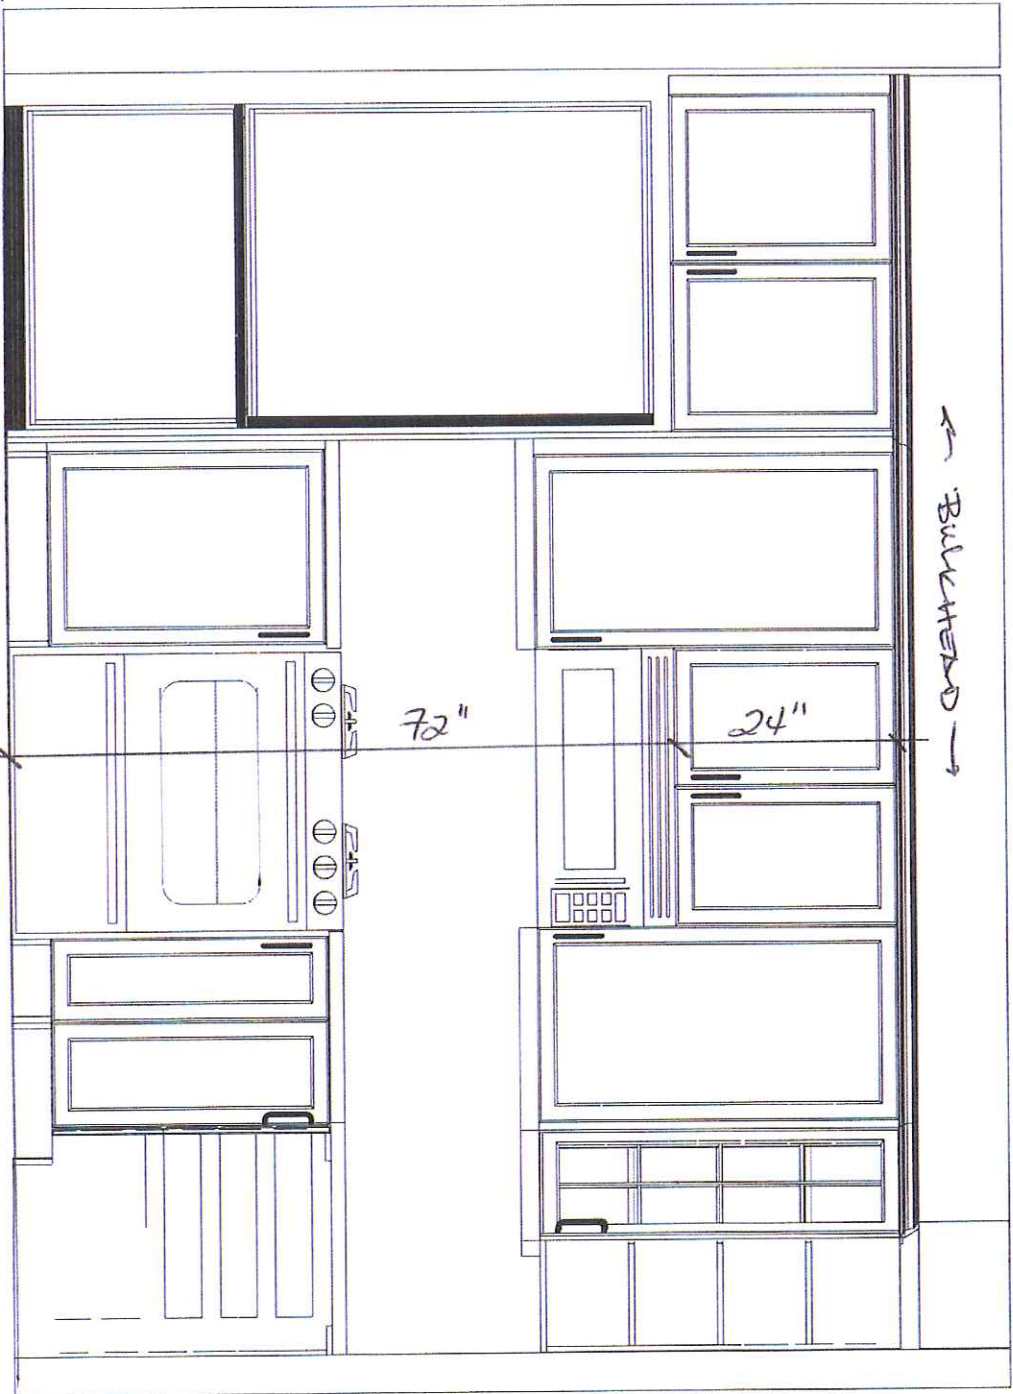

← Bulb Head →

BRIDGE/STONE WALL ELEVATION

36" 21" 39" 2" 2"
96" 98"

CUSTOMER APPROVAL

I have reviewed these drawings and understand the details of the layout and the Carrier Kitchens specifications.

Signature

[Signature]

Date

July 24/13

Note: This drawing is an artistic interpretation of the general appearance of the design. It is not meant to be an exact rendition.

DESIGNED BY: LORI DISAVERIO.

DCR - #53 SR2 - Kitchen



2020
TECHNOLOGIES

Designed: 2/13/2013
Printed: 2/13/2013

All

Drawing #: 1