


Basement Plan 'A' is a long, narrow rectangular layout. The overall dimensions are 19'-3" in width and 19'-1" in height. The layout is divided into three main sections by two vertical lines. The leftmost section is 8'-1" wide. The middle section is 19'-1" wide. The rightmost section is 30'-1" wide. The total width is 19'-3". The total height is 19'-1".

NOTE:
ALL LVL'S SUPPORTING FLOOR LOADS ARE TO BE SPECIFIED BY THE FLOOR TRUSS MANUFACTURER.

NOTE:
FLOOR FRAMING INFO REFER TO KOTT SHOP DRAWINGS FOR ALL TRUSS-JOIST INFORMATION AND DETAILS. UNLESS OTHERWISE NOTED.

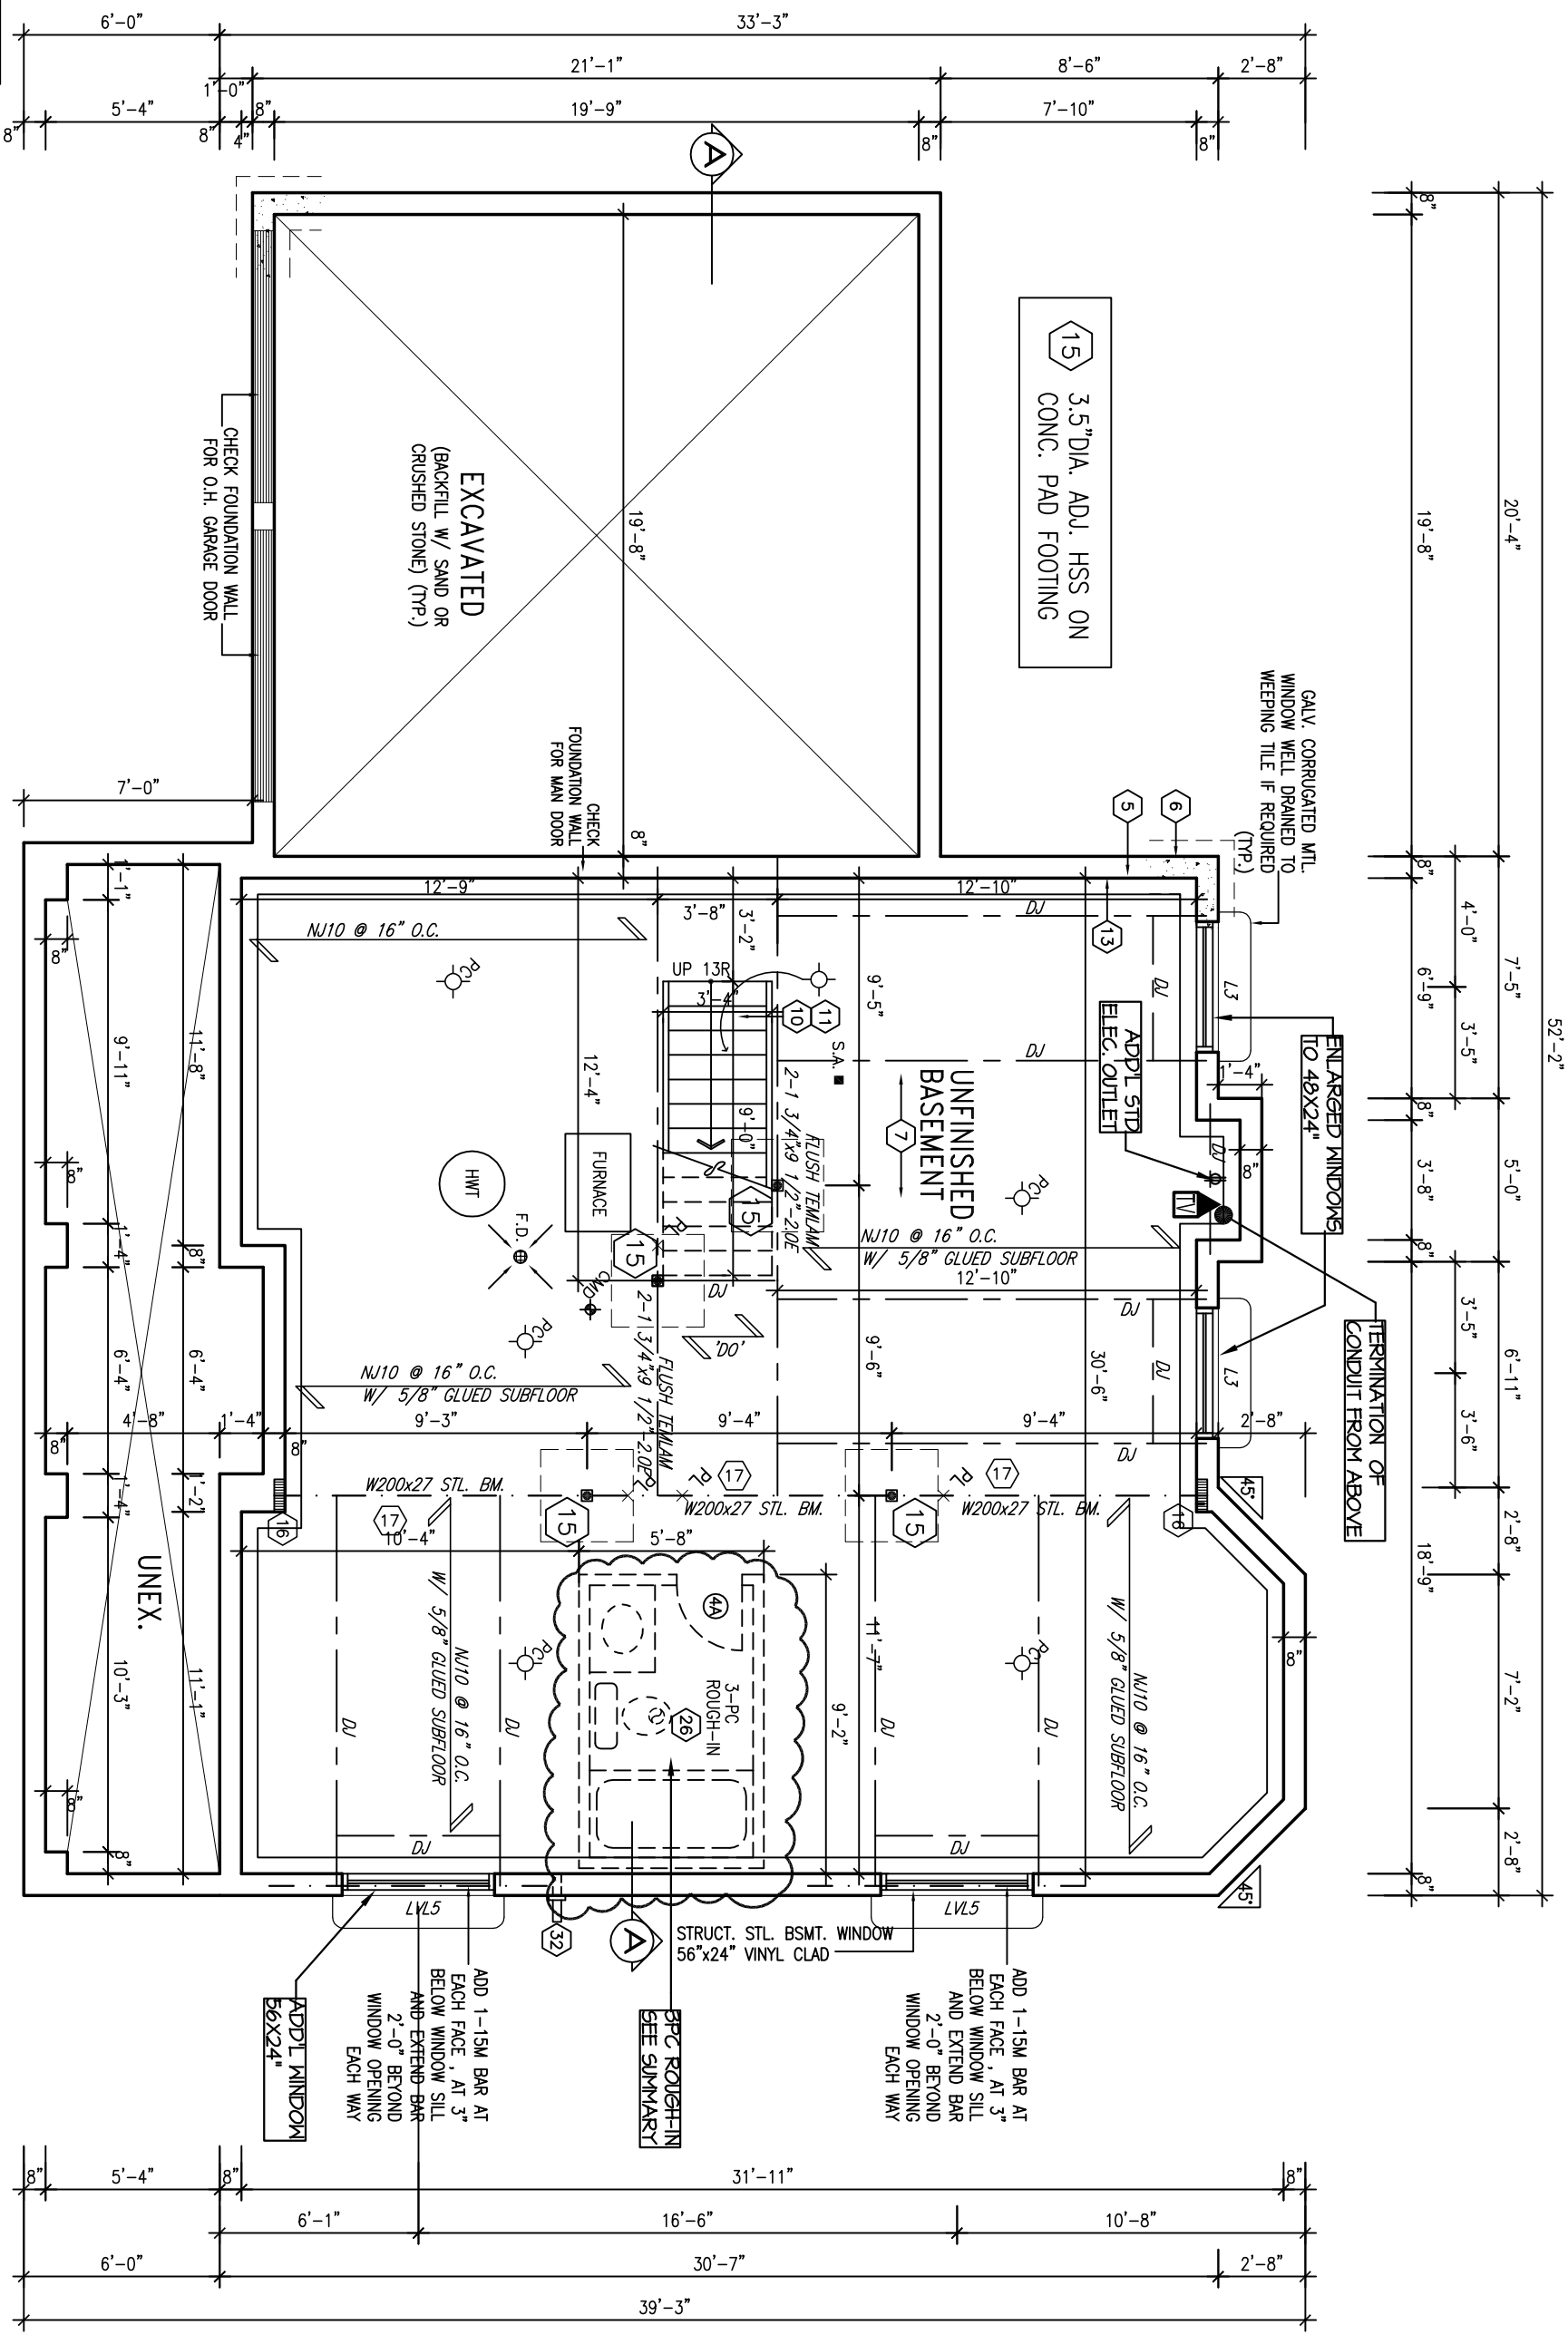

**Viljoen
Architect
Inc.**

300 A Wilson Avenue
North York, Ontario
M3H 1S8
TEL: (416) 630-2255
FAX: (416) 630-4782

GREGORIAN-2007-A	
SITE: SHADOW RIDGE2	
LOT NUMBER:	53
CIVIC ADDRESS: 6513 WATERDOWN ST.	


2	REV. AS PER CONST. SUMMARY	JUL30-13	SD
1	REV. AS PER CONST. SUMMARY	JUL22-13	SD
No.	Description	Date	By
REVISIONS			

footprint:	S1-A
sht. title:	BASEMENT PLAN-A
drawn by:	CL
checked by:	OF
date:	FEB. 2007
scale:	3/16"=1'
sheet no:	

NOTE: LOCATIONS SHOWN FOR POTLIGHTS ARE APPROXIMATE AND MAY BE ADJUSTED PER SITE CONDITIONS.

NOTE: SEE KITCHEN LAYOUT FOR UPGRADES NOT SHOWN ON THIS PLAN.

NOTE: SEE CONSTRUCTION SUMMARY FOR FLOOR FIN. NOTES

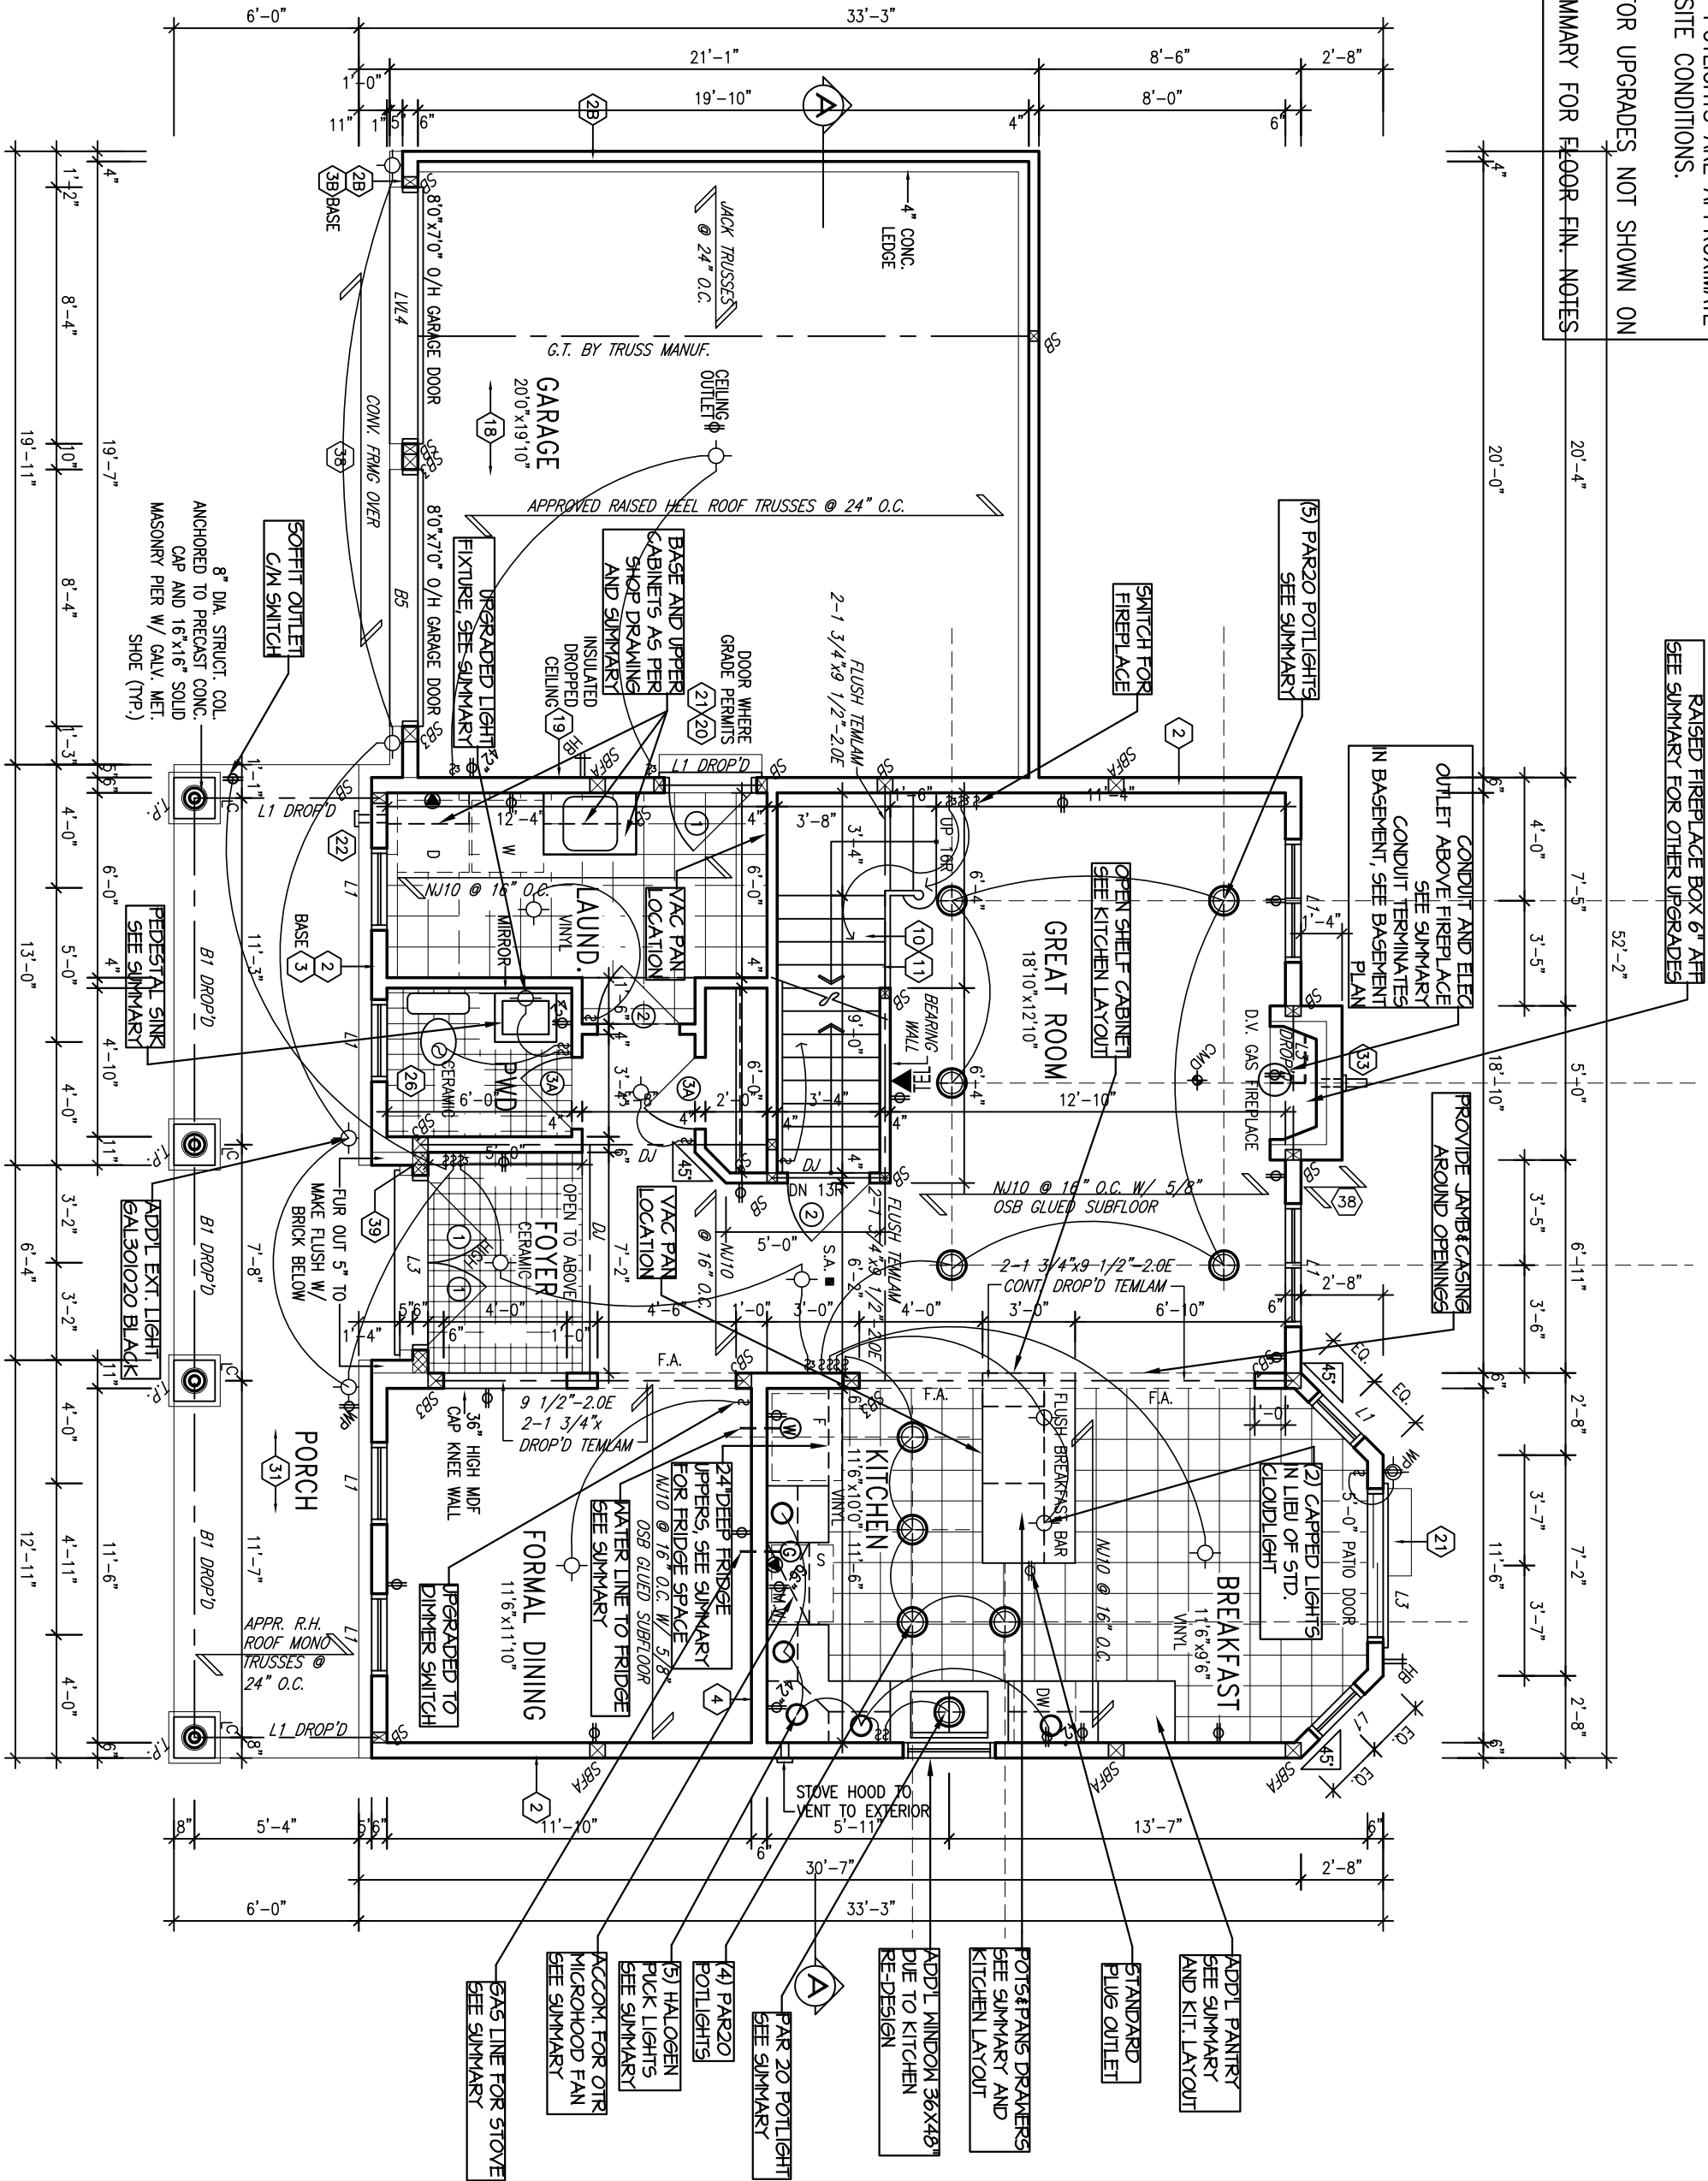

GROUND FLOOR PLAN 'A'

NOTE: ALL LVL'S SUPPORTING FLOOR LOADS ARE TO BE SPECIFIED BY THE FLOOR TRUSS MANUFACTURER.

NOTE: FLOOR FRAMING INFO REFER TO KOTT SHOP DRAWINGS FOR ALL TRUSS-JOIST INFORMATION AND DETAILS. UNLESS OTHERWISE NOTED.



Viljoen Architect Inc.

300 A Wilson Avenue
North York, Ontario
M3H 1S8
TEL: (416) 630-2255
FAX: (416) 630-4782

GREGORIAN-2007-A

SITE: SHADOW RIDGE2


LOT NUMBER:

53

CIVIC ADDRESS:
6513 WATERDOWN ST.

No.	Description	Date	By
2	REV. AS PER CONST. SUMMARY	JUL30-13	SD
1	REV. AS PER CONST. SUMMARY	JUL22-13	SD
REVISIONS			

Footprint:	SI-A
sht. title:	GROUND FLOOR-A
drawn by:	CL
checked by:	OF
date:	FEB. 2007
scale:	3/16"=1'
sheet no:	2A 6

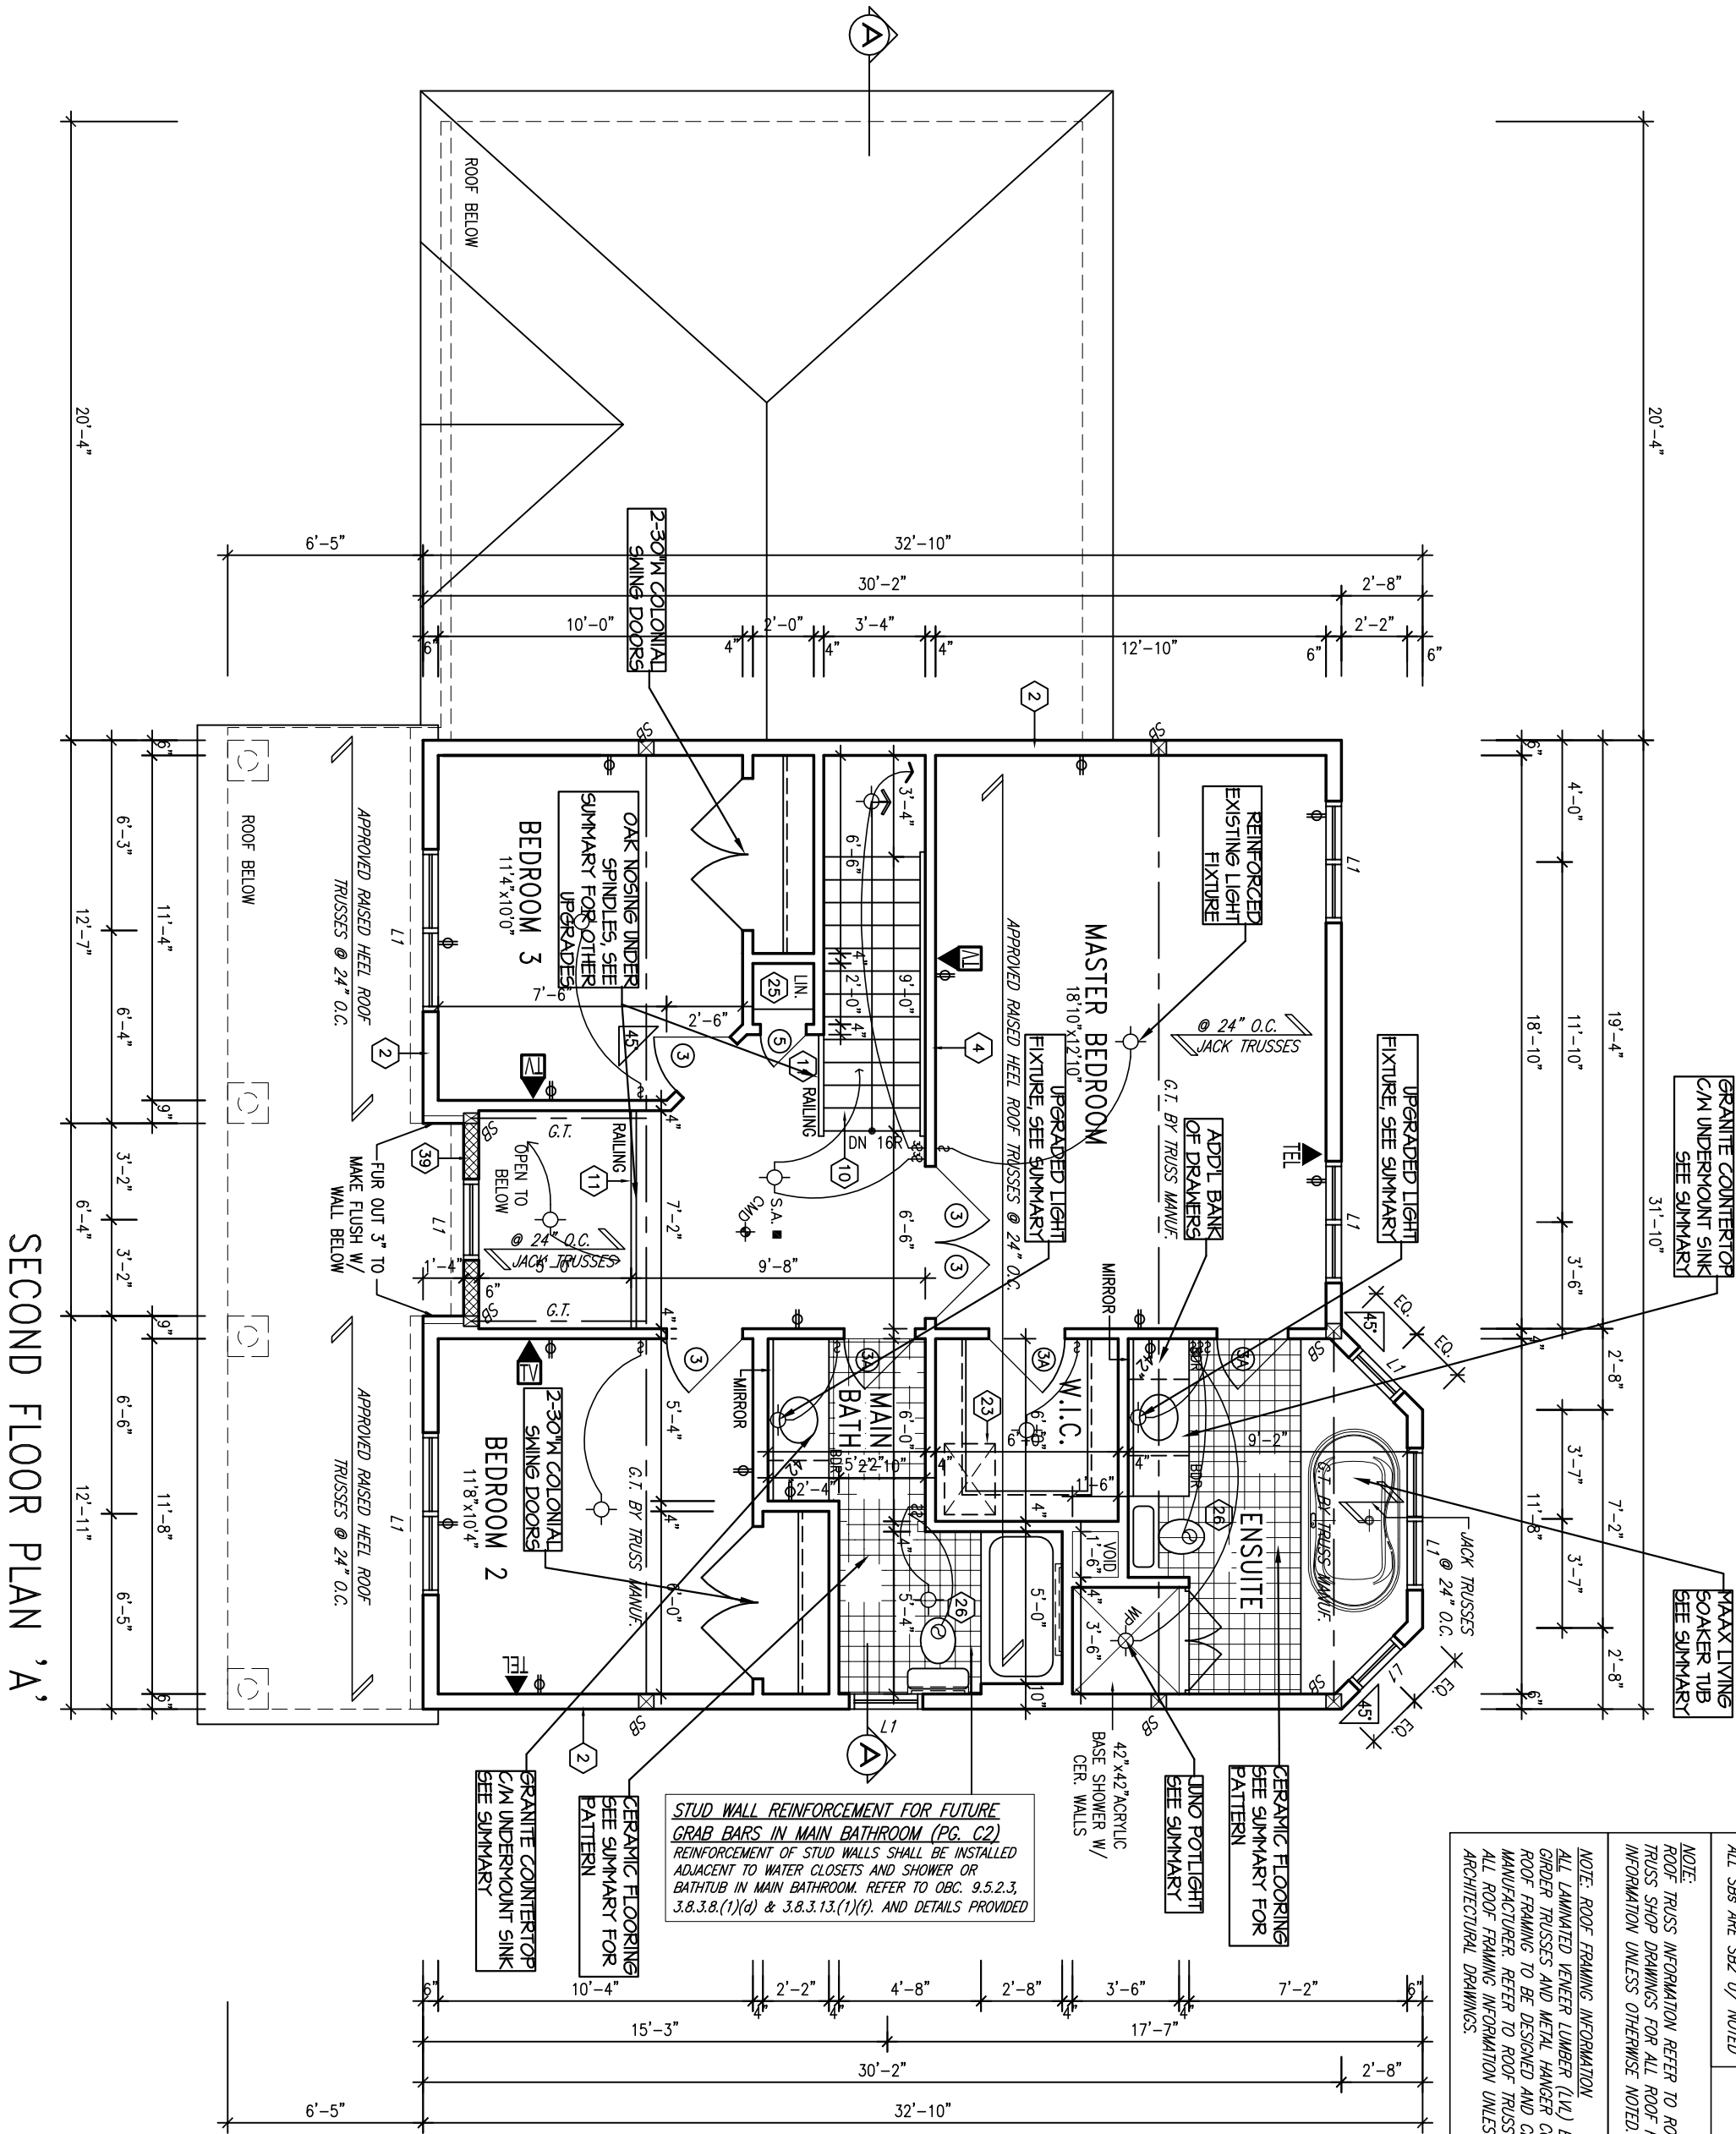

SECOND FLOOR PLAN 'A'

NOTE: ALL SBS ARE S22 U/ NOTED

NOTE: ROOF TRUSS INFORMATION REFER TO ROOF TRUSS SHOP DRAWINGS FOR ALL ROOF FRAMING INFORMATION UNLESS OTHERWISE NOTED.

NOTE: ROOF FRAMING INFORMATION ALL LAMINATED VENEER LUMBER (LVL) BEAMS, BUILT-UP BEAMS, GIRDER TRUSSES AND METAL HANGER CONNECTIONS SUPPORTING ROOF FRAMING TO BE DESIGNED AND CERTIFIED BY ROOF TRUSS MANUFACTURER. REFER TO ROOF TRUSS SHOP DRAWINGS FOR ALL ROOF FRAMING INFORMATION UNLESS OTHERWISE NOTED ON ARCHITECTURAL DRAWINGS.

Viljoen Architect Inc.

300 A Wilson Avenue
North York, Ontario
M3H 1S8
TEL: (416) 630-2255
FAX: (416) 630-4782

GREGORIAN-2007-A

SITE: SHADOW RIDGE2


LOT NUMBER:

53


CIVIC ADDRESS:
6513 WATERDOWN ST.

No.	Description	Date	By
2	REV. AS PER CONST. SUMMARY	JUL30-13	SD
1	REV. AS PER CONST. SUMMARY	JUL22-13	SD
REVISIONS			

Footprint: SI-A	
sht. title: SECOND FLOOR-A	
drawn by: CL	
checked by: OF	
date: FEB. 2007	
scale: 3/16"=1'	
sheet no:	3A 6

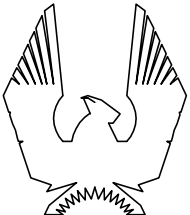

PHOENIX HOMES

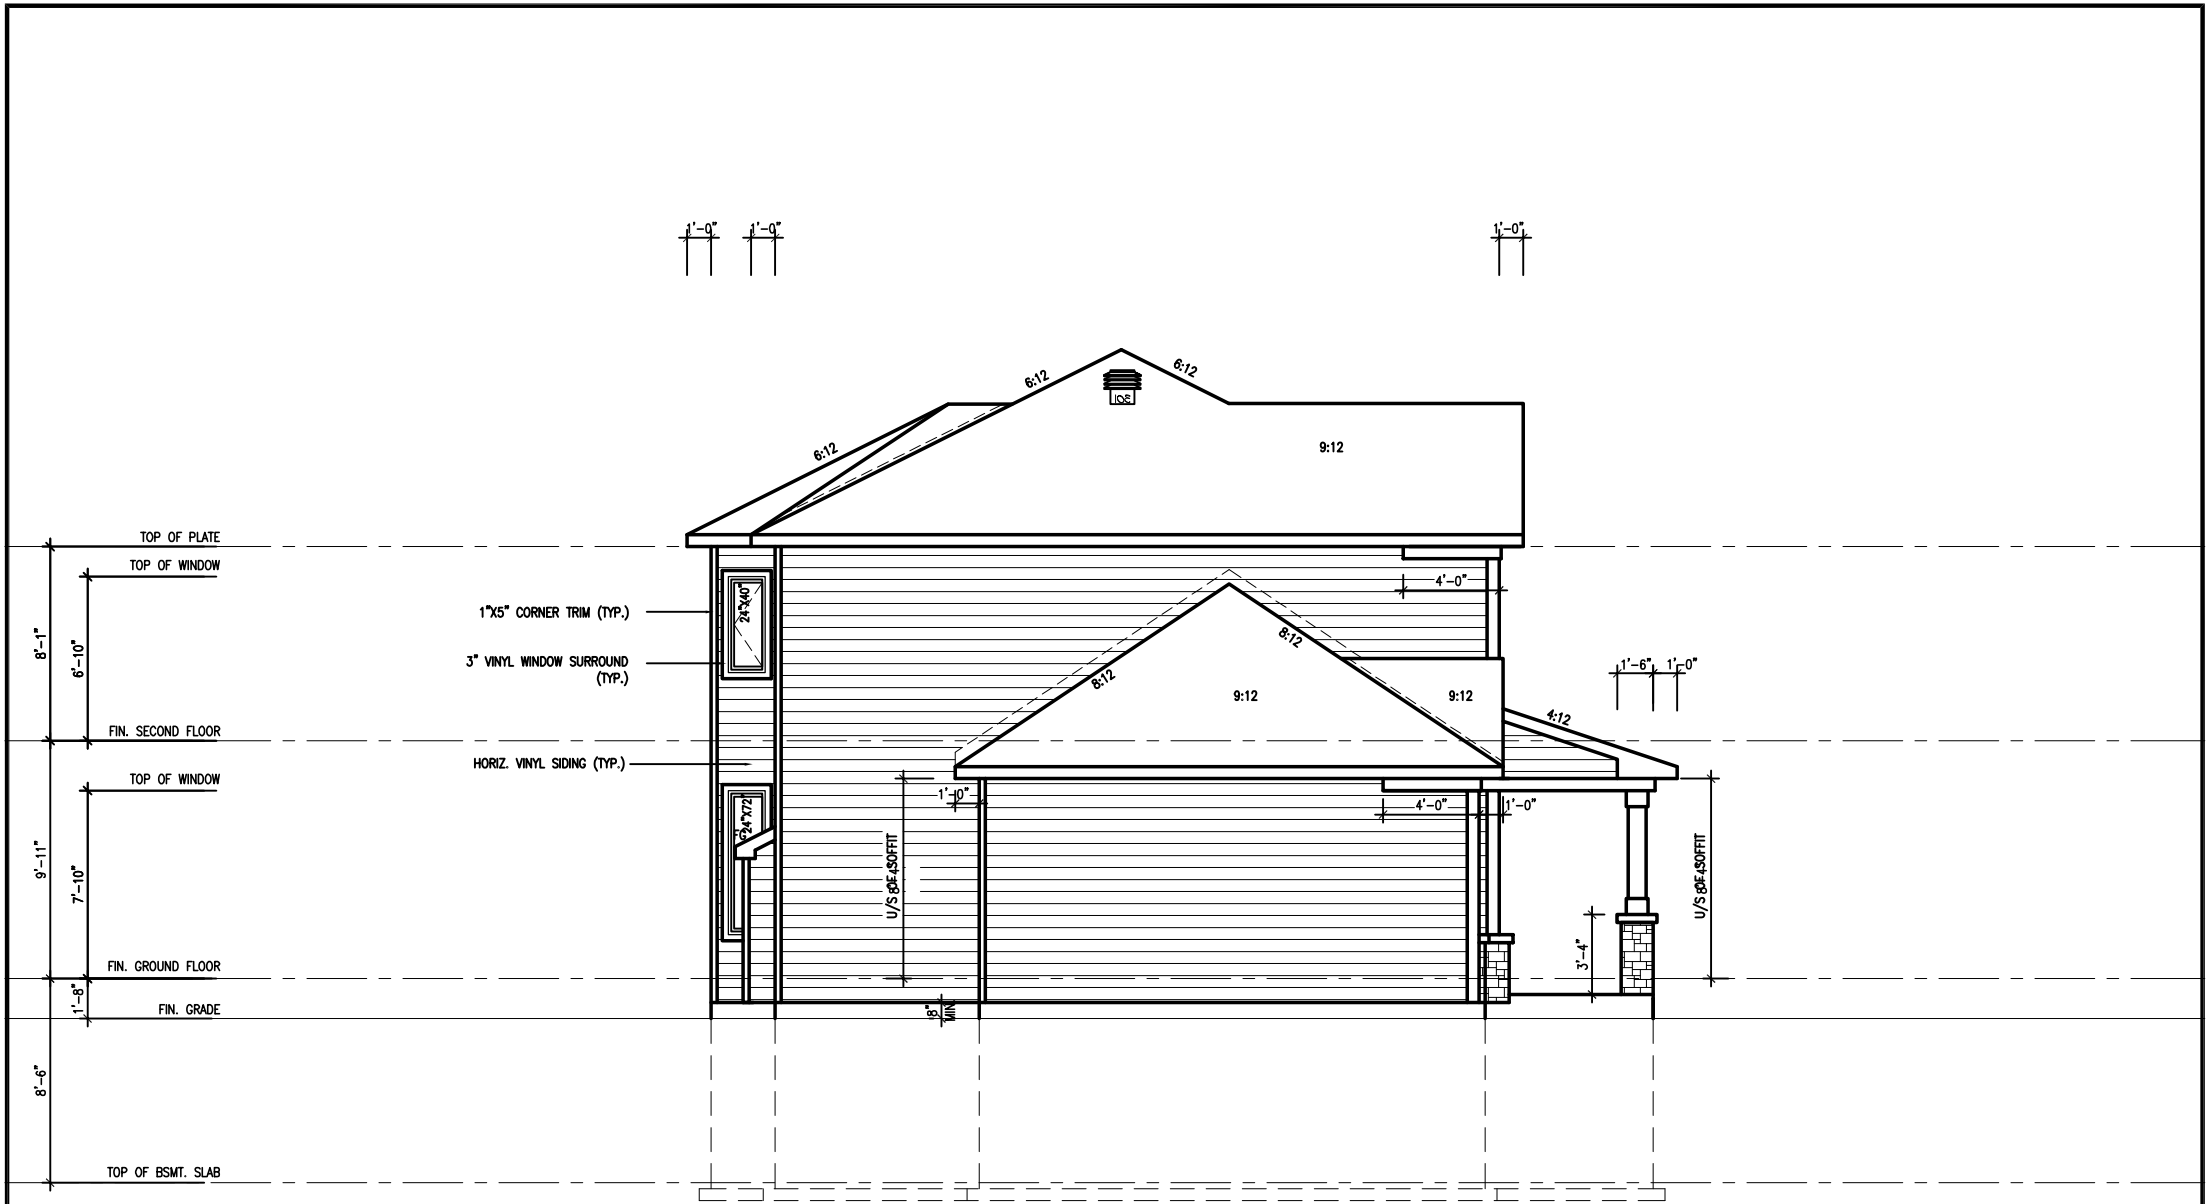

LEFT ELEVATION 'A'

NOTE:
REFER TO FRONT ELEVATION FOR TYPICAL
NOTES & INFORMATION



REAR ELEVATION 'A'

NOTE:
REFER TO FRONT ELEVATION FOR TYPICAL
NOTES & INFORMATION



**Viljoen
Architect
Inc.**

300 A Wilson Avenue
North York, Ontario
M3H 1S8
TEL: (416) 630-2255
FAX: (416) 630-4782

GREGORIAN-2007-A

SITE: SHADOW RIDGE2


LOT NUMBER:

53


CIVIC ADDRESS:
6513 WATERDOWN ST.

No.	Description	Date	By
2	REV. AS PER CONST. SUMMARY	JUL30-13	SD
1	REV. AS PER CONST. SUMMARY	JUL22-13	SD
REVISIONS			

Footprint:	51-A
sht. title:	ELEVATIONS-A
drawn by:	CL
checked by:	OF
date:	FEB. 2007
scale:	1/8"=1'
sheet no:	5A 6

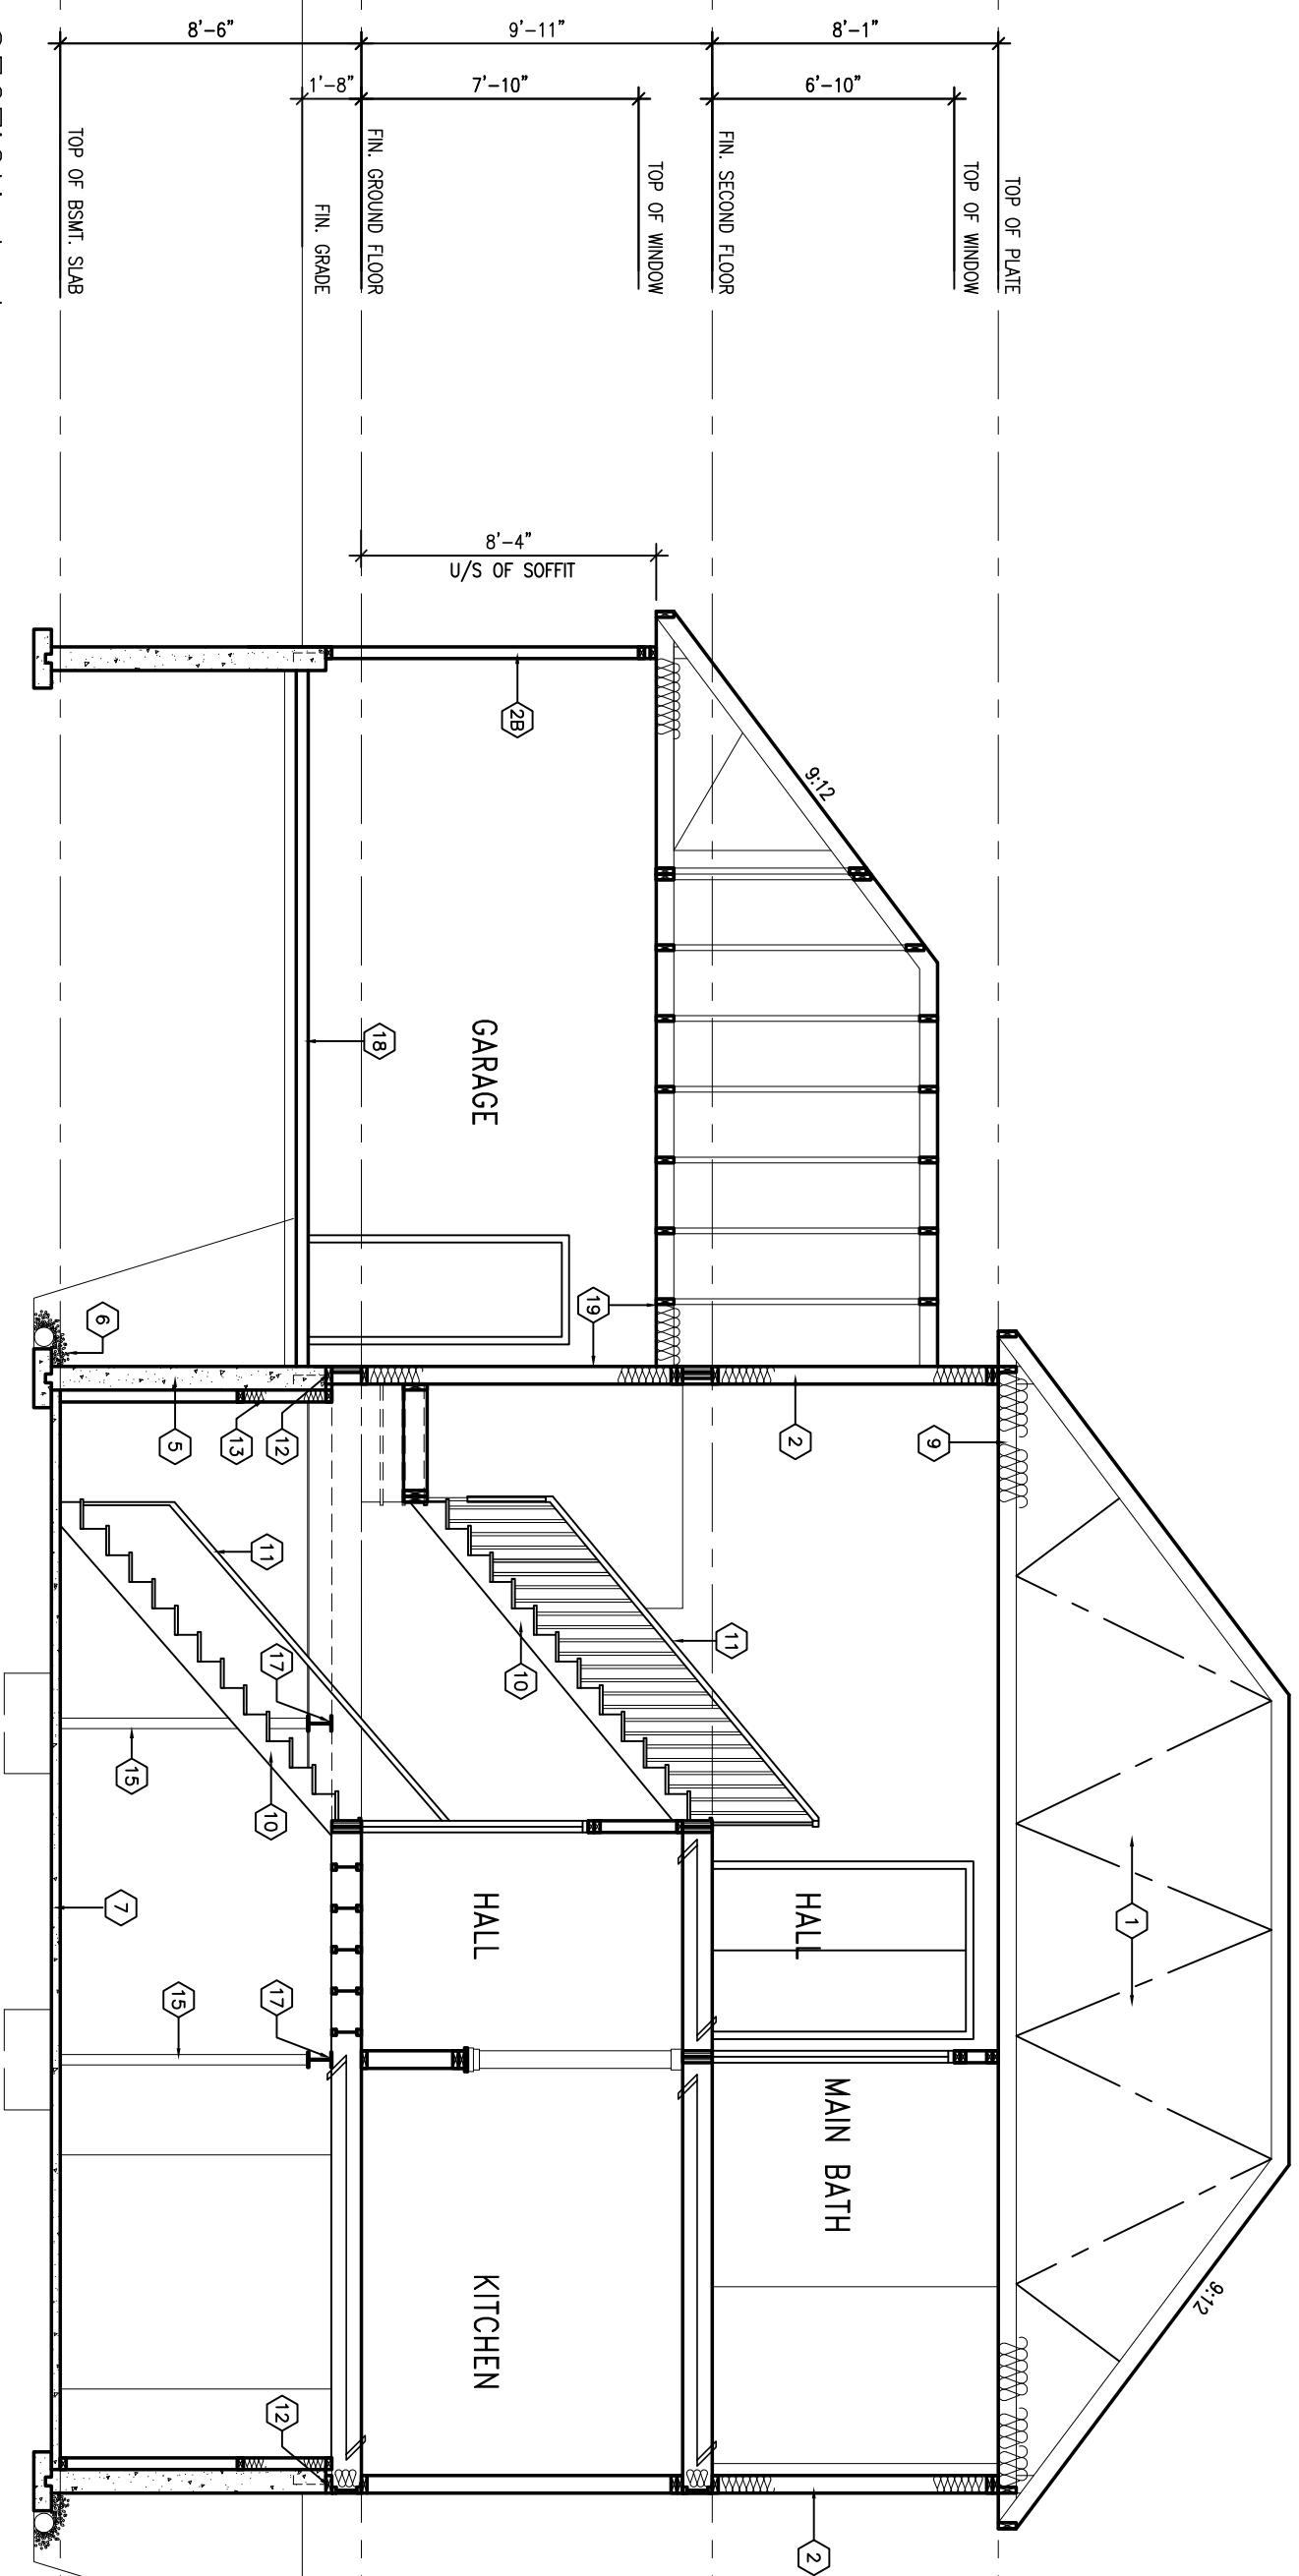

SECTION A-A

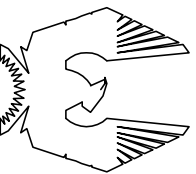

PHOENIX HOMES

**Viljoen
Architect
Inc.**

300 A Wilson Avenue
North York, Ontario
M3H 1S8
TEL: (416) 630-2255
FAX: (416) 630-4782

GREGORIAN-2007-A

SITE: SHADON RIDGE2

LOT NUMBER:

CIVIC ADDRESS:

66

No.	Description	Date	By
2	REV. AS PER CONST. SUMMARY	JUL-30-13	SD
1	REV. AS PER CONST. SUMMARY	JUL-22-13	SD

footprint:	S -A	
sh. title:	SECTION	
drawn by:	CL	OF
checked by:		
date:	FEB. 2007	
scales:	3/16"=1"	
sheet no:		

