


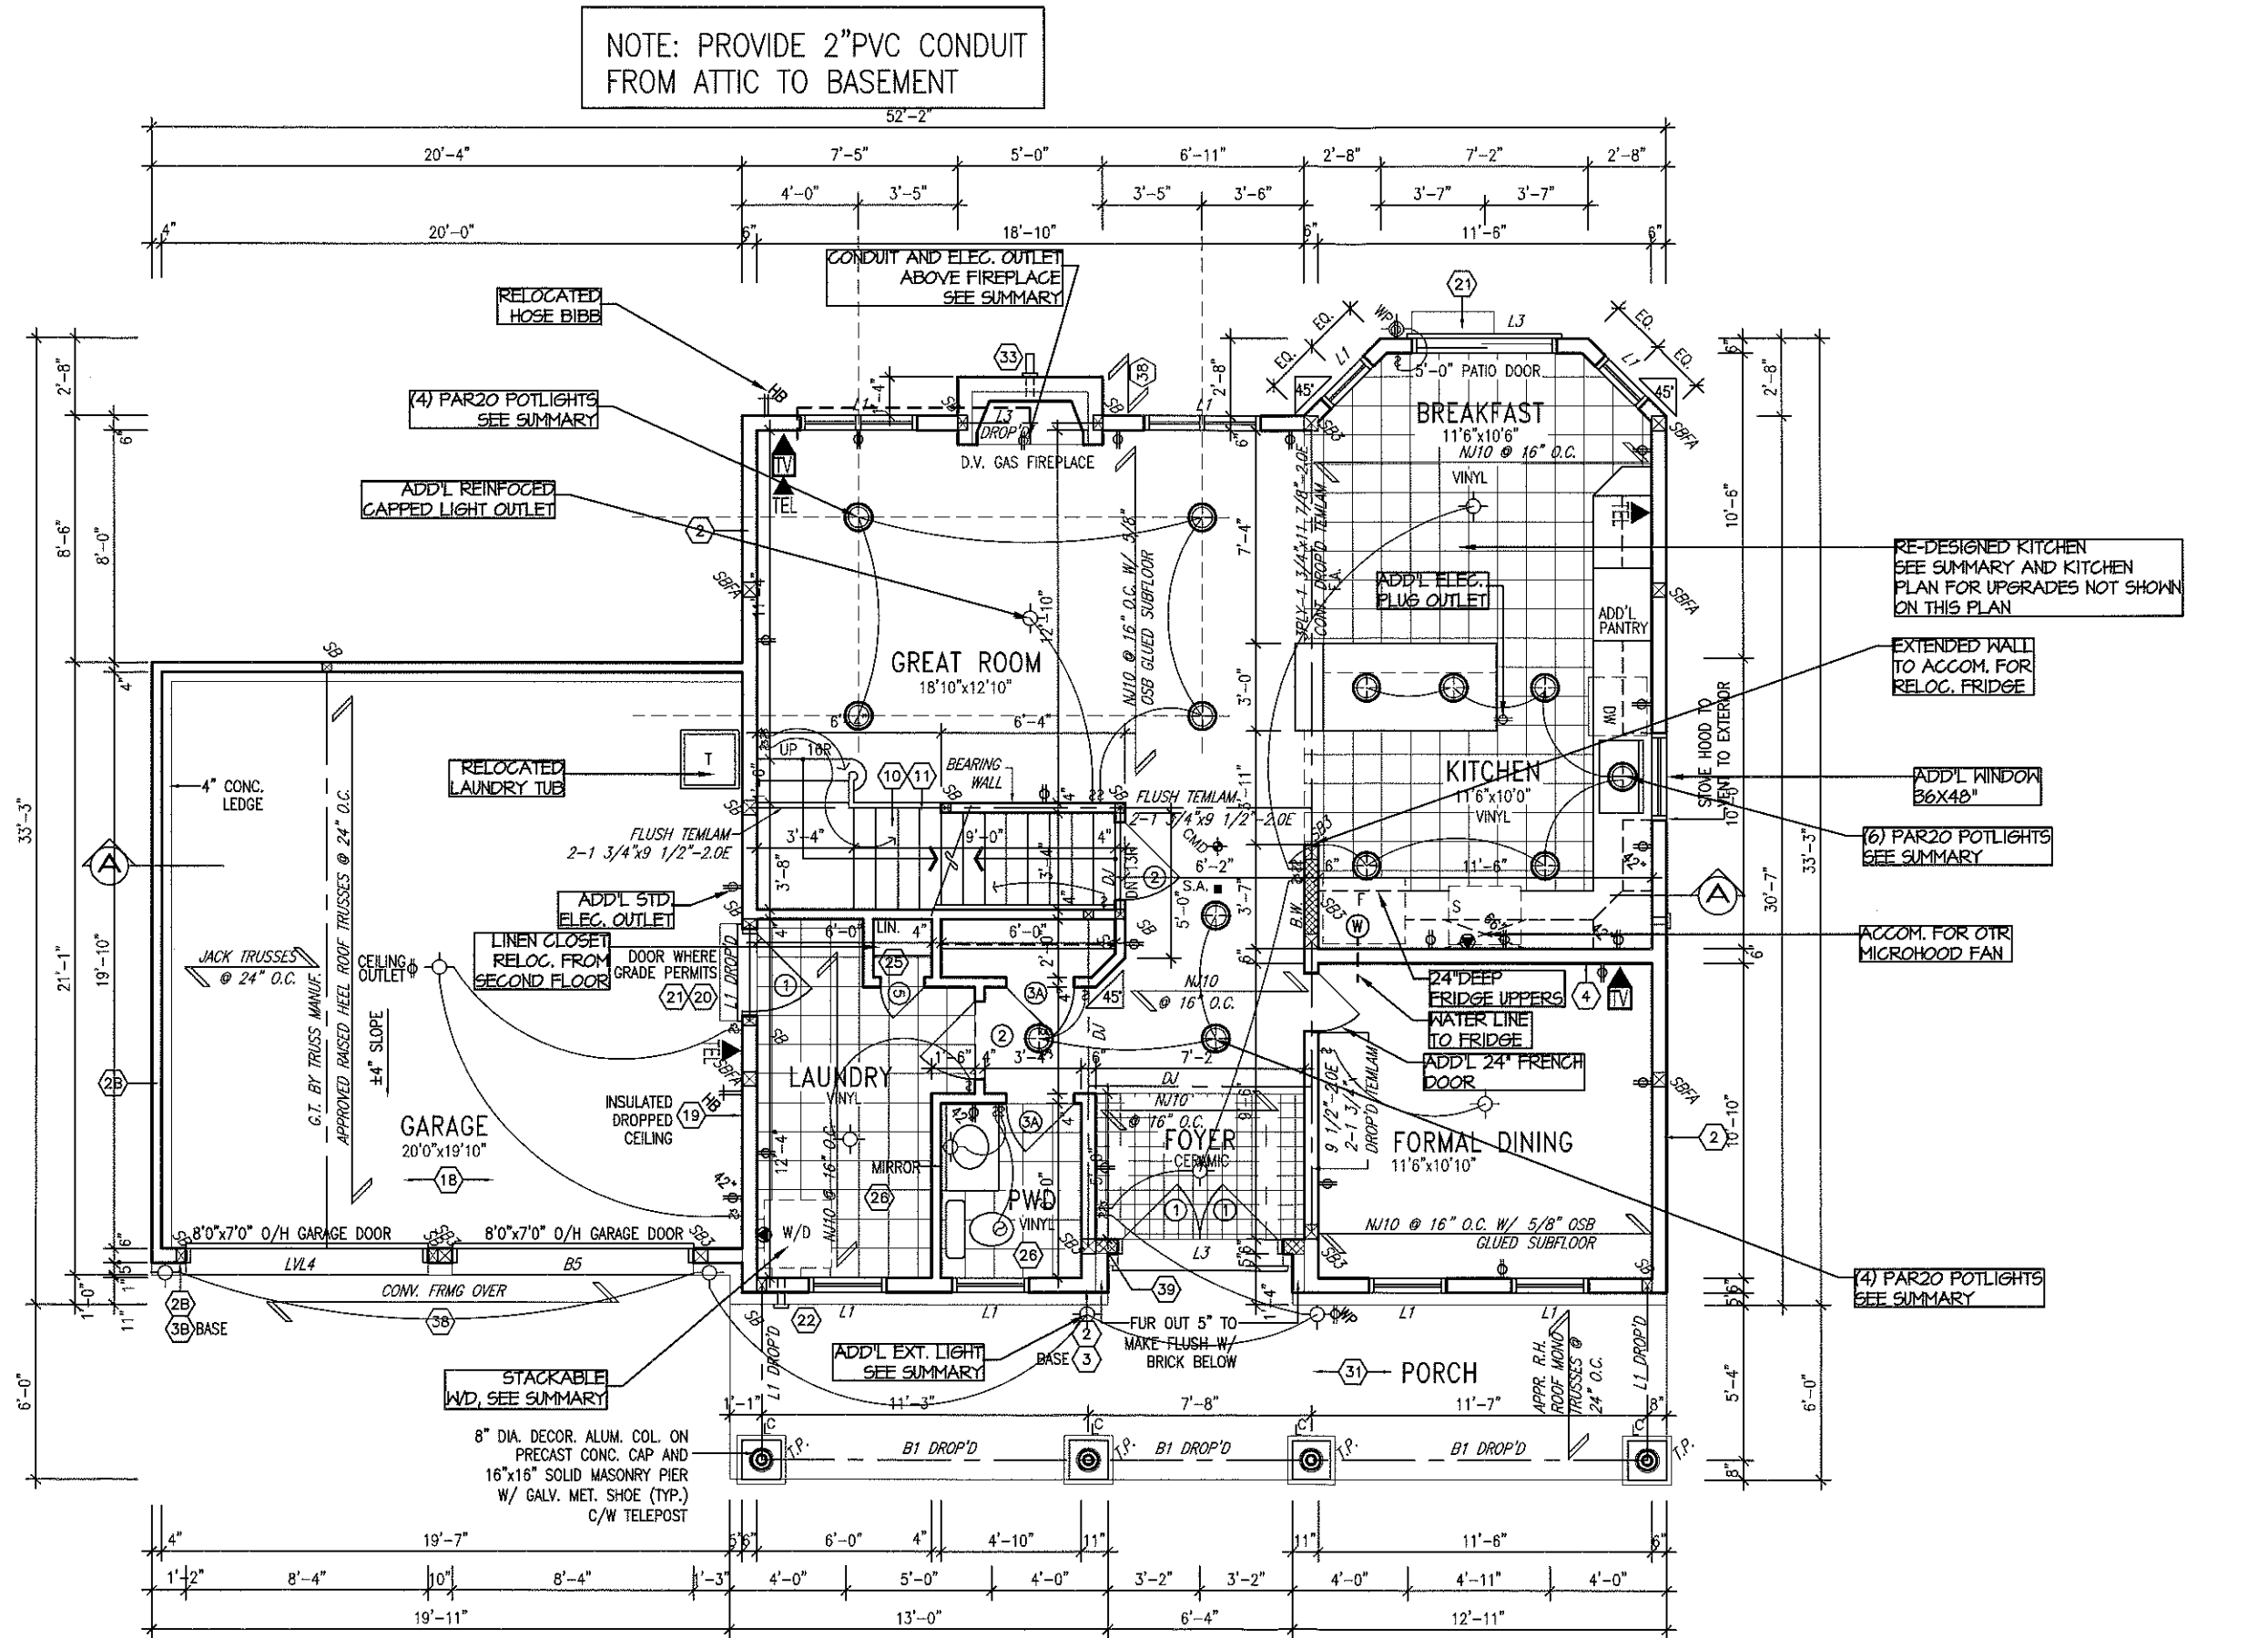

GROUND FLOOR PLAN 'A'

Footprint:	SI-A
sh. title:	GROUND FLOOR-A
drawn by:	CL
checked by:	OF
date:	FEB. 2007
scale:	3/16"=1'
sheet no:	2A 6

No.	Description	By	Date
2	REV. AS PER CONST. SUMMARY	SD	JUL30-13
1	REV. AS PER CONST. SUMMARY	SD	APR24-13

GREGORIAN-2007-A
SITE: SHADOW RIDGE 2
LOT NUMBER: 59
CIVIC ADDRESS: 6525 WATERDOWN ST.

Viljoen Architect Inc.

300 A Wilson Avenue
North York, Ontario
M3H 1S8
TEL: (416) 630-2255
FAX: (416) 630-4782

PHOENIX HOMES

NOTE: PROVIDE 2" PVC CONDUIT FROM ATTIC TO BASEMENT

NOTE:
ALL SBs ARE SB2 U/ NOTED

NOTE:
ROOF TRUSS INFORMATION REFER TO ROOF TRUSS SHOP DRAWINGS FOR ALL ROOF FRAMING INFORMATION UNLESS OTHERWISE NOTED.



NOTE: ROOF FRAMING INFORMATION
ALL LAMINATED VENEER LUMBER (LVL) BEAMS, BUILT-UP BEAMS, GIRDER TRUSSES AND METAL HANGER CONNECTIONS SUPPORTING ROOF FRAMING TO BE DESIGNED AND CERTIFIED BY ROOF TRUSS MANUFACTURER. REFER TO ROOF TRUSS SHOP DRAWINGS FOR ALL ROOF FRAMING INFORMATION UNLESS OTHERWISE NOTED ON ARCHITECTURAL DRAWINGS.

footprint:	S1-A
sh. title:	SECOND FLOOR-A
drawn by:	CL
checked by:	OF
date:	FEB. 2007
scale:	3/16"=1'
sheet no.:	3A/6


No.	Description	By
2	REV. AS PER CONST. SUMMARY	SD
1	REV. AS PER CONST. SUMMARY	SD

GREGORIAN-2007-A
SITE: SHADOW RIDGE2
LOT NUMBER: 59
CIVIC ADDRESS: 6525 WATERDOWN ST.


Viljoen Architect Inc.
300 A Wilson Avenue
North York, Ontario
M3H 1S8
TEL: (416) 630-2255
FAX: (416) 630-4782

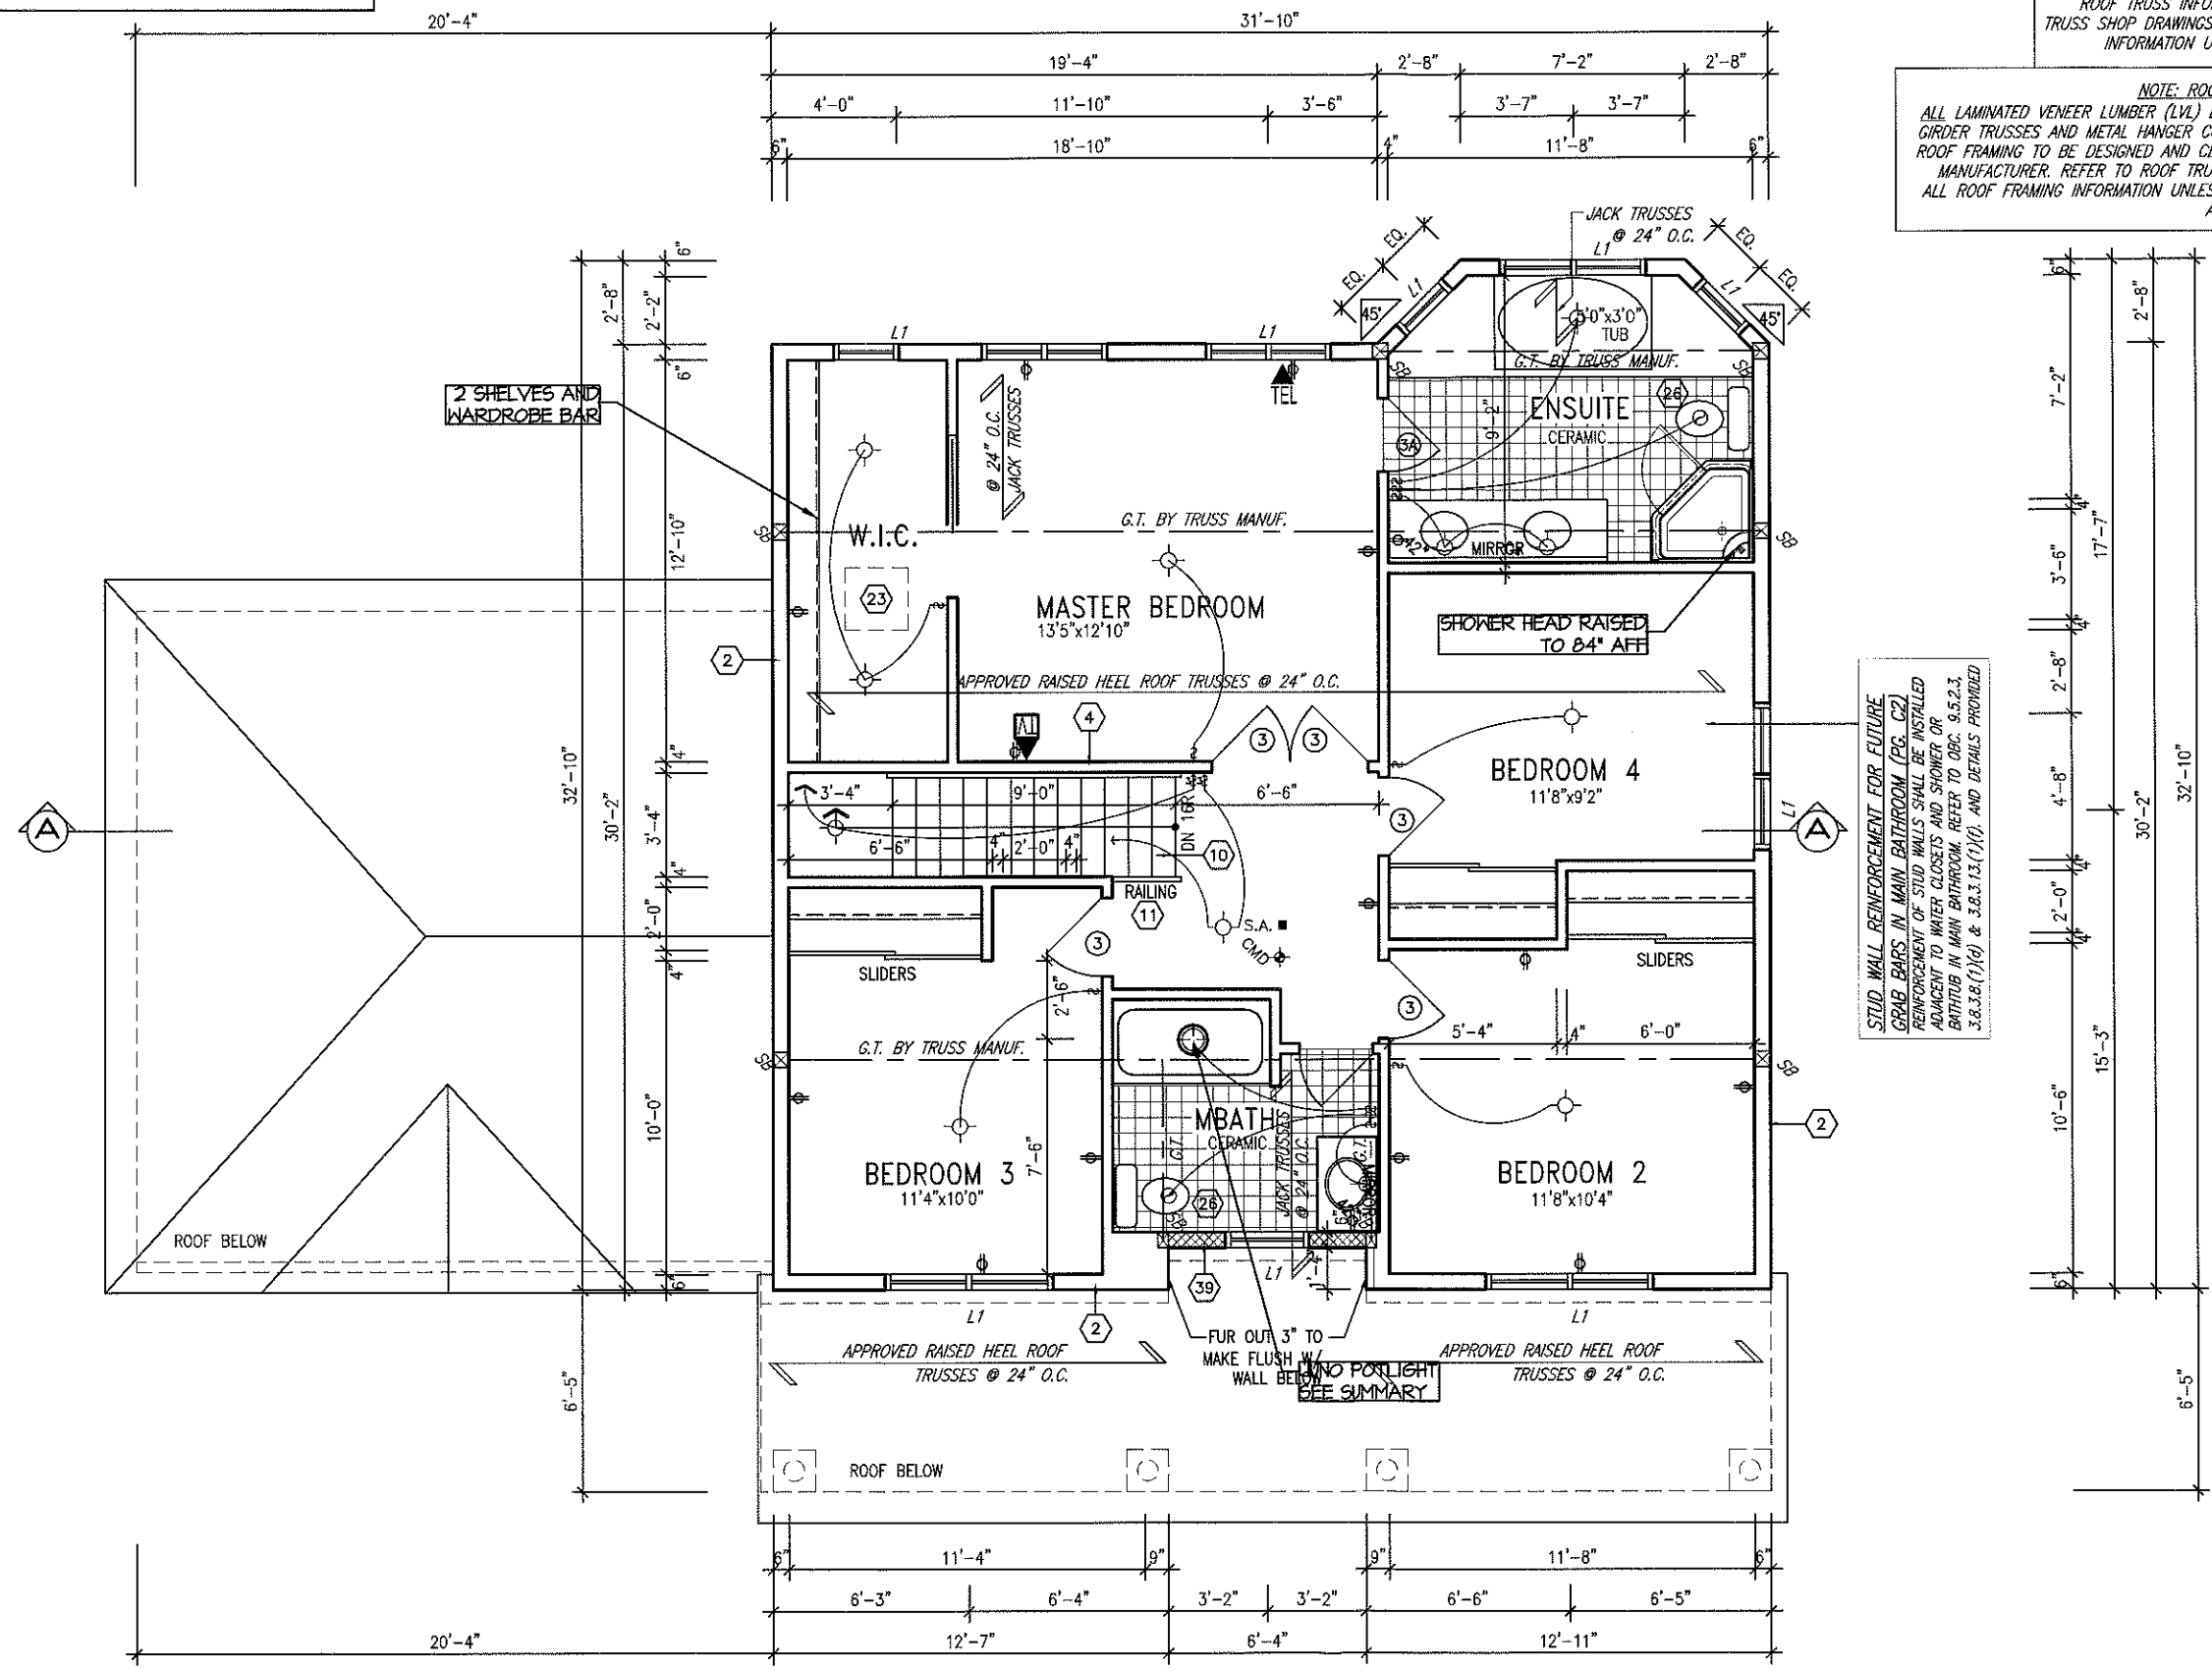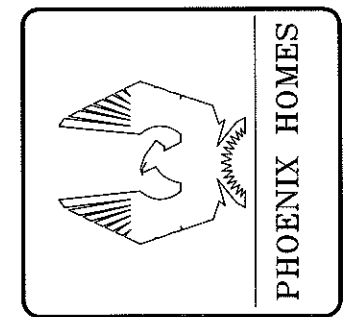


SECOND FLOOR PLAN 'A'
(MODIFIED-ADDED 4TH BEDRM)

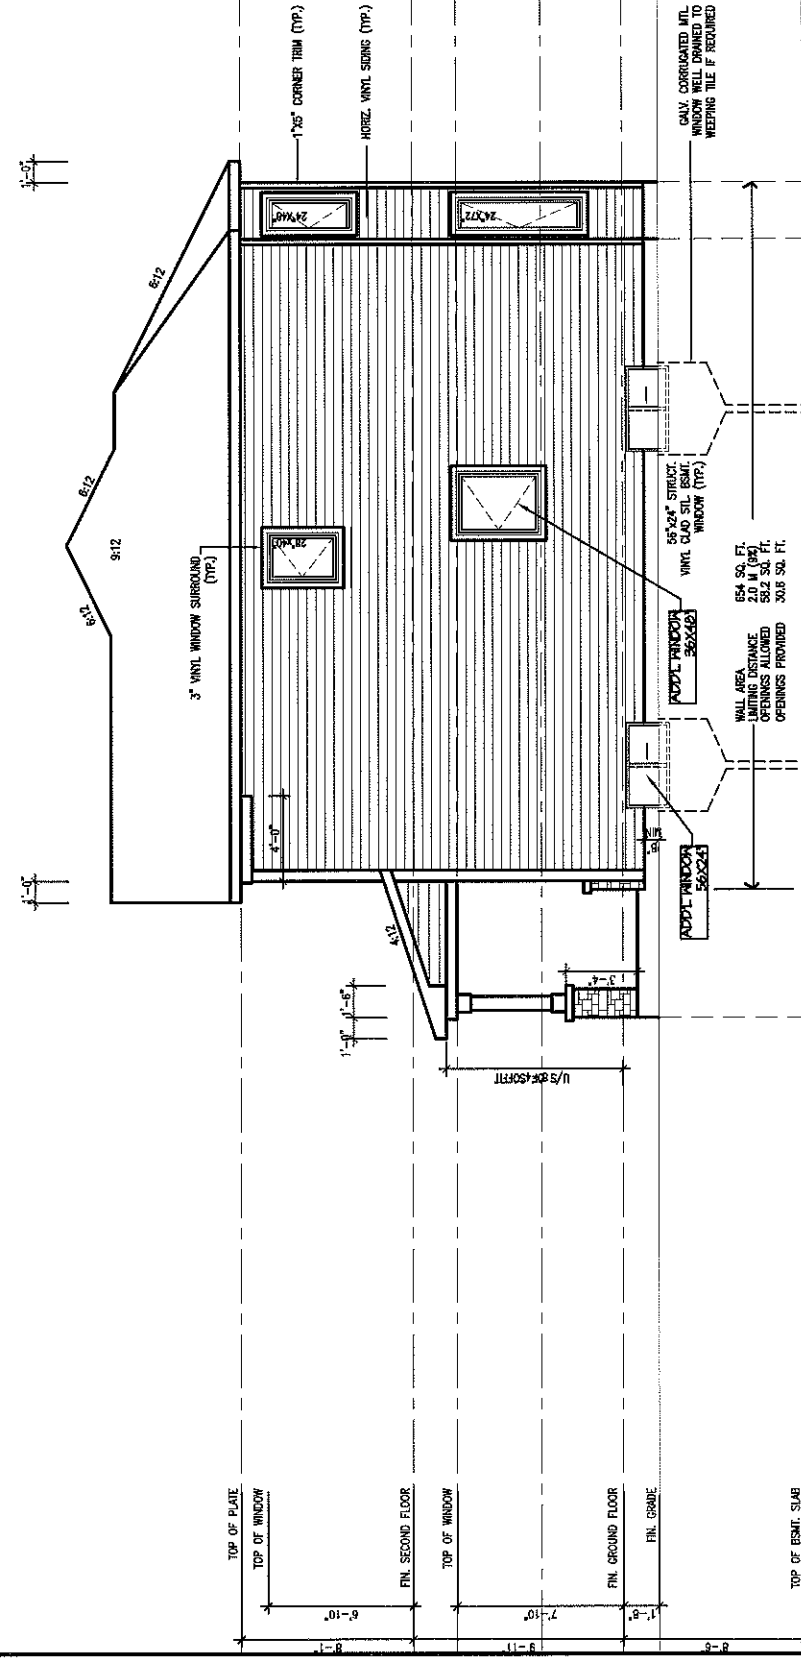


RIGHT ELEVATION 'A'

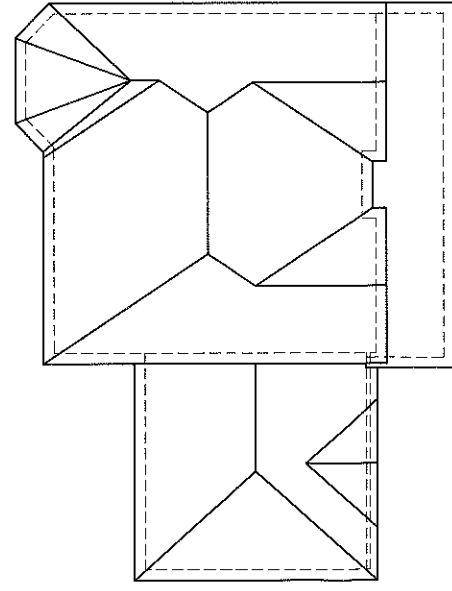

ROOF PLAN 'A'

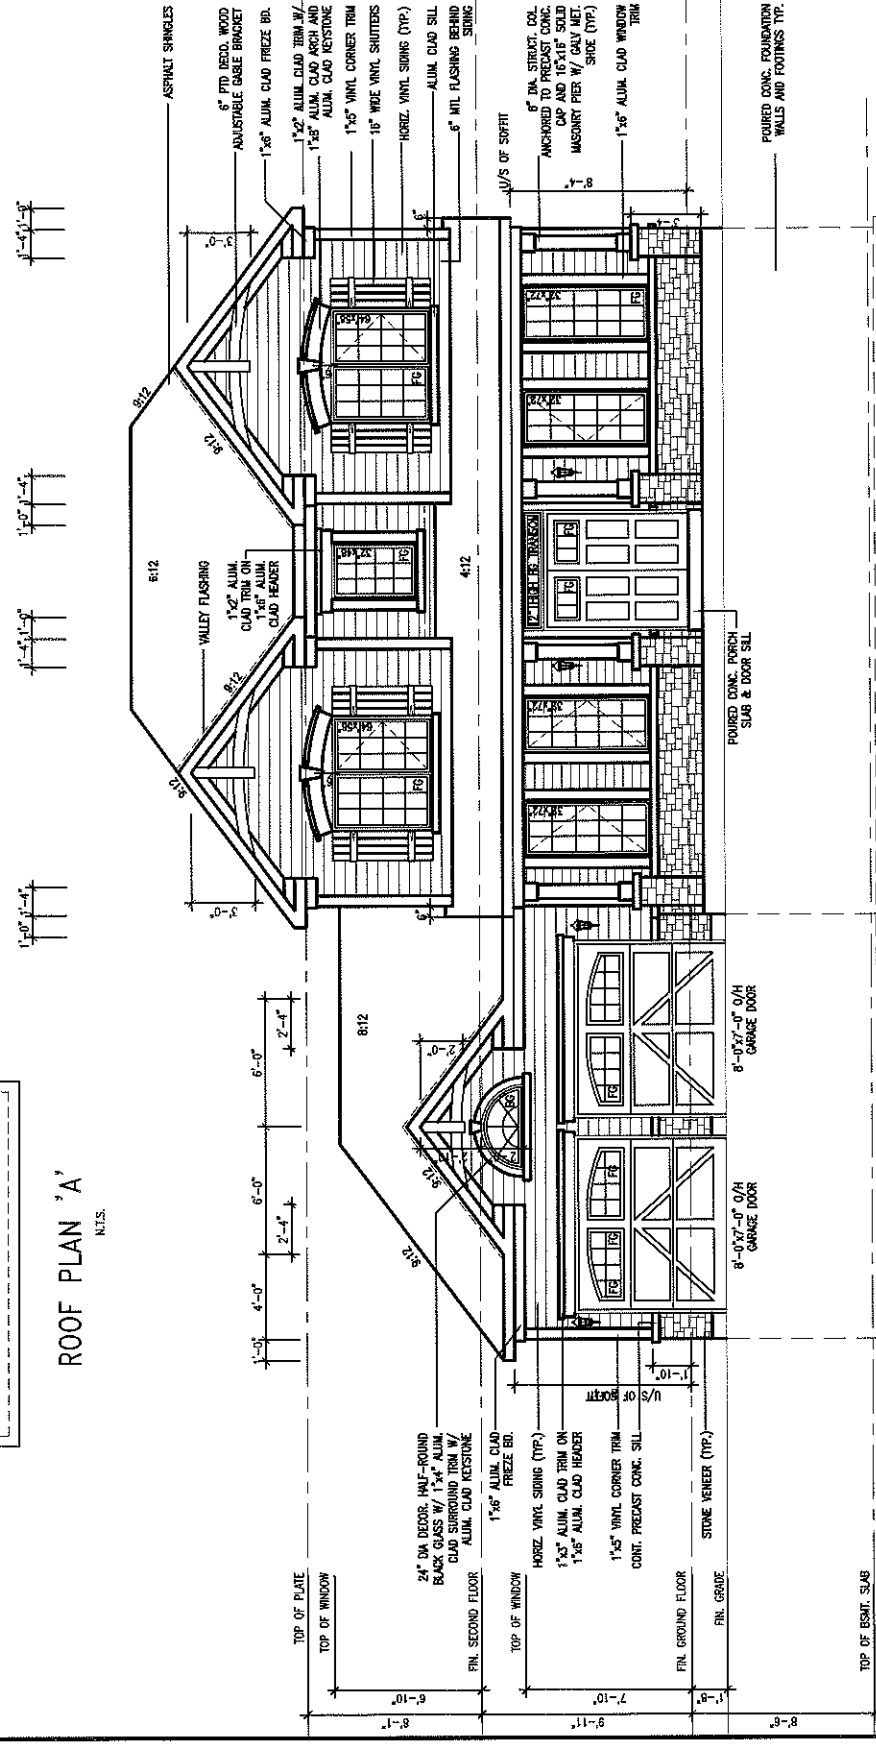

FRONT ELEVATION 'A' (SIDING W/ STONE BASE)

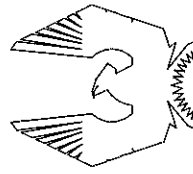

PHOENIX HOMES

Viljoen
Architect
Inc.

300 A Wilson Avenue
North York, Ontario
M3H 1S8
TEL: (416) 630-2255
FAX: (416) 630-4782

GREGORIAN-2007-A


SITE: SHADOW RIDGE 2

LOT NUMBER:

၈၆


CIVIC ADDRESS:
6525 WATERDOWN ST.

[illegible]

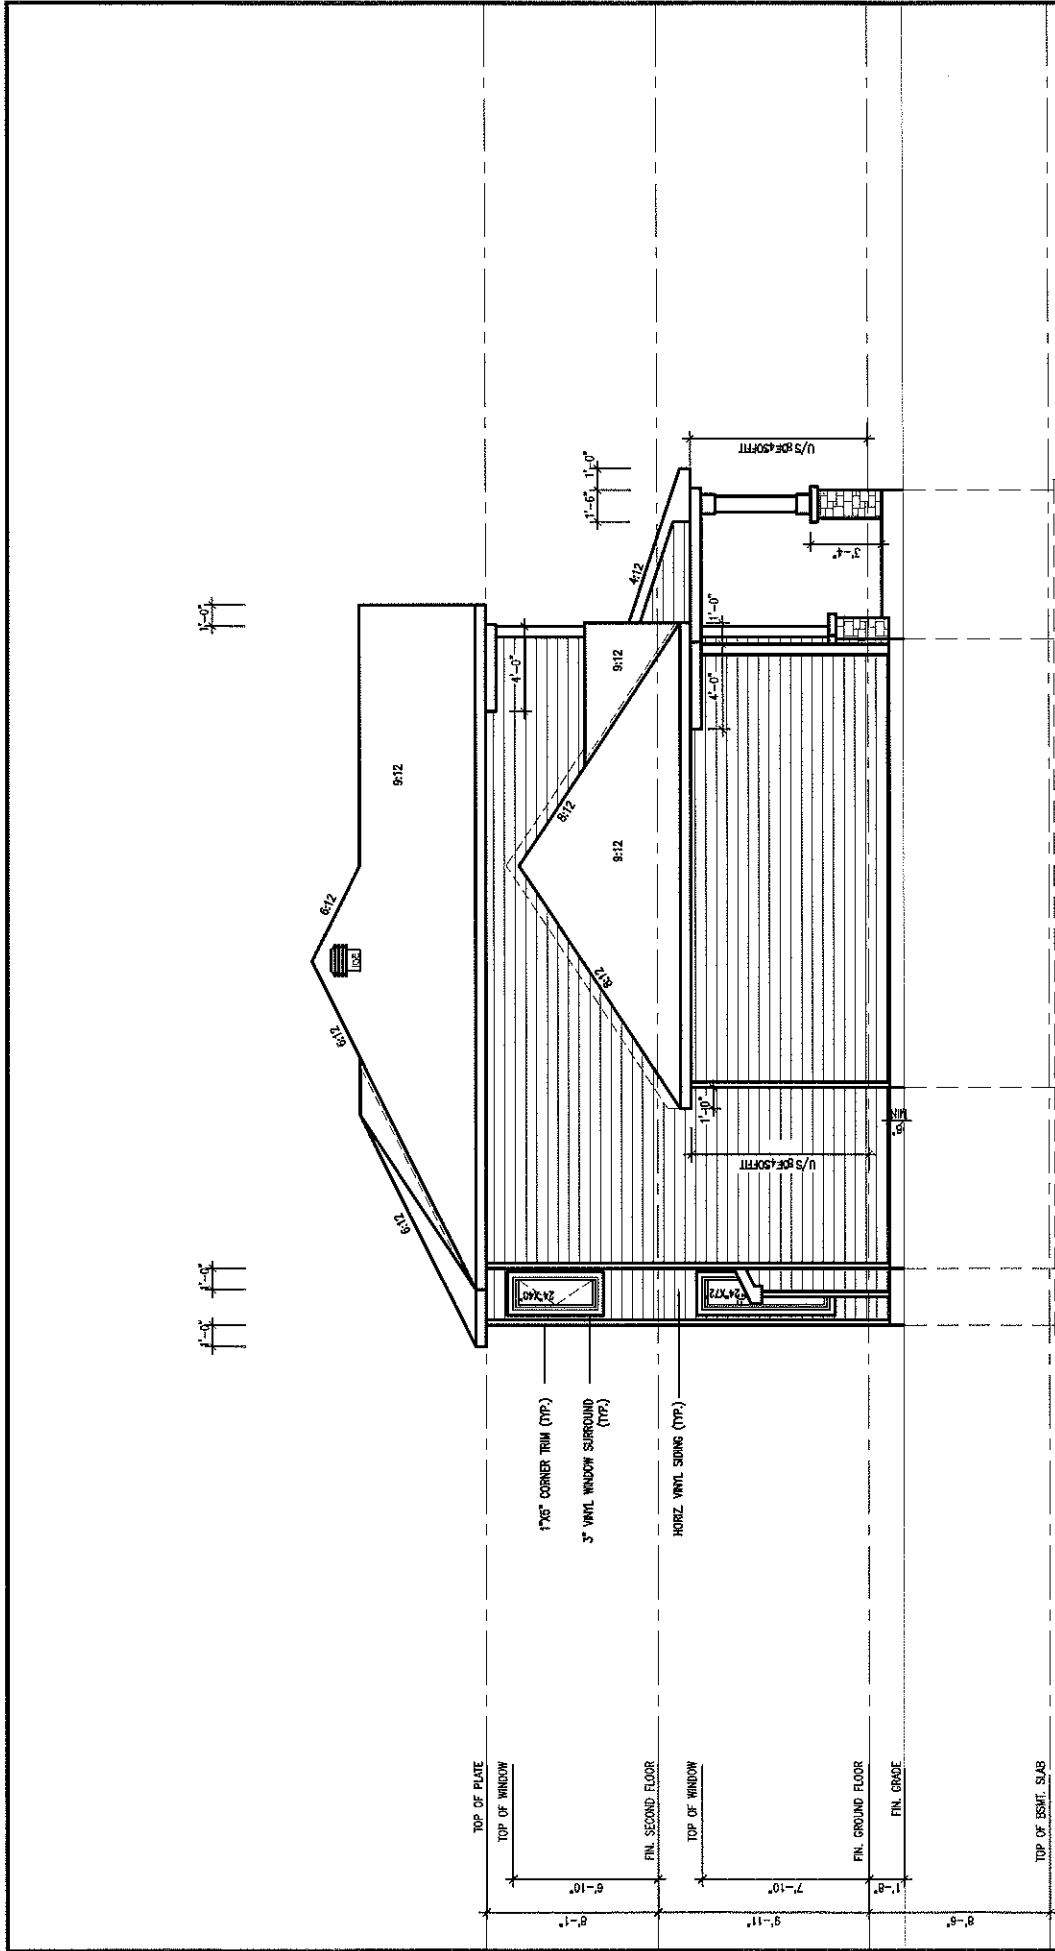


LEFT ELEVATION 'A'

REFER TO FRONT ELEVATION FOR TYPICAL NOTES & INFORMATION

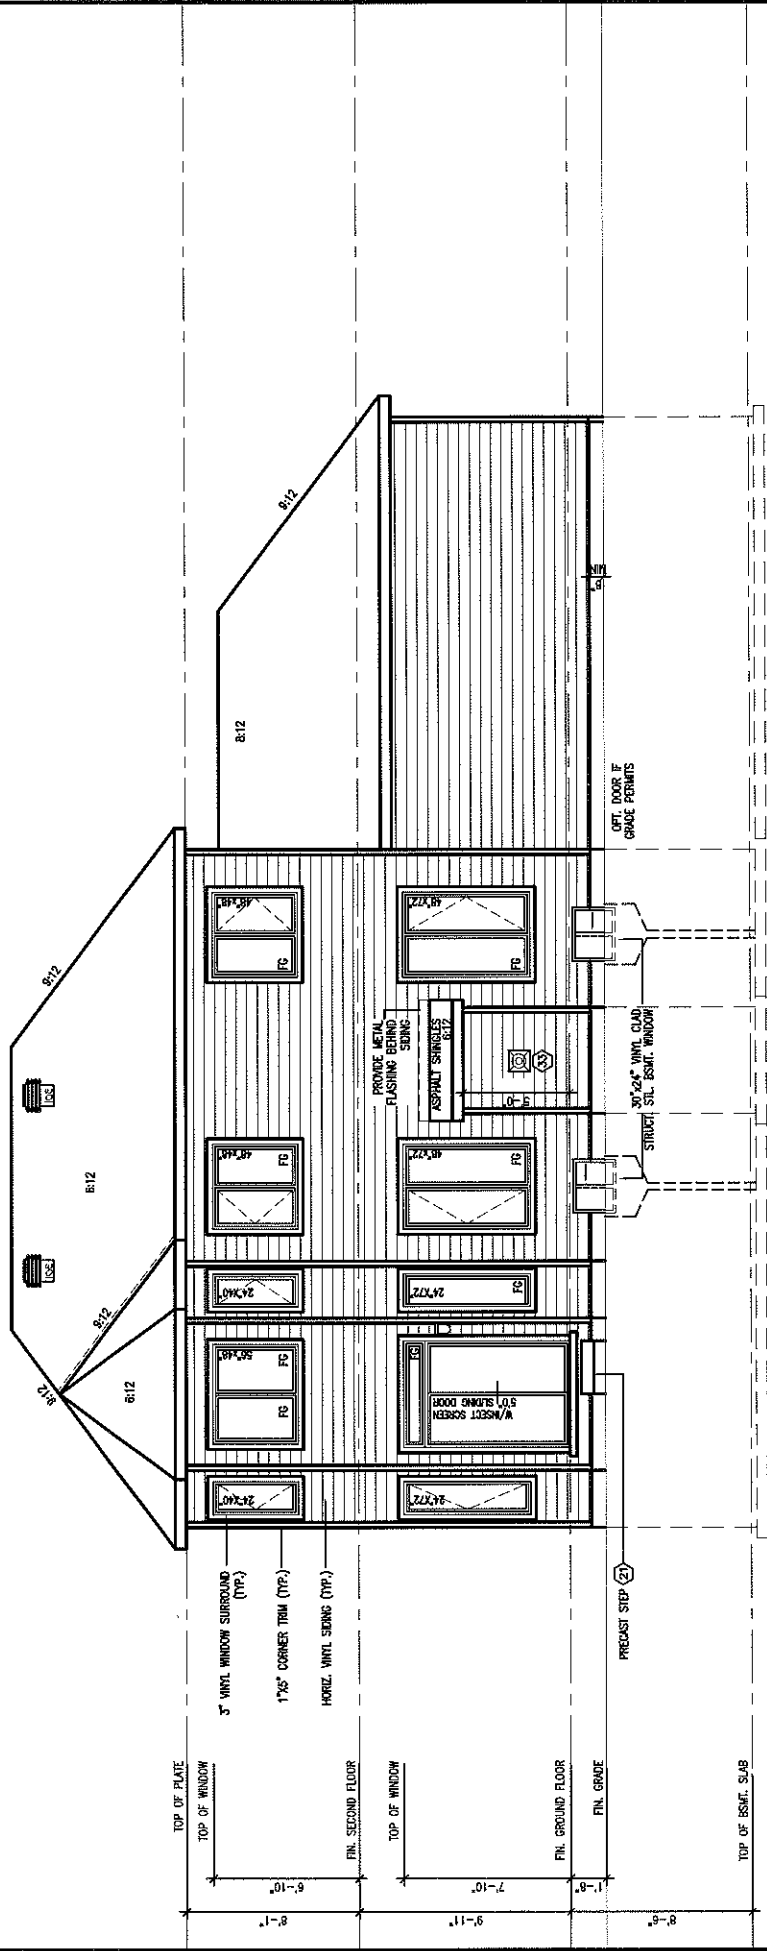

REAR ELEVATION 'A'

NOTE: REFER TO FRONT ELEVATION FOR TYPICAL NOTES & INFORMATION

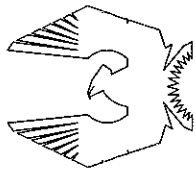

PHOENIX HOMES

Viljoen Architect Inc.

300 A Wilson Avenue
North York, Ontario
M3H 1S8
TEL: (416) 630-2255
FAX: (416) 630-4782

GREGORIAN-2007-A

SITE: SHADOW RIDGE2

LOT NUMBER: 59

CIVIC ADDRESS: 6525 WATERDOWN ST.

No.	Description	Date	By
2	REV. AS PER CONST. SUMMARY	JUL30-13	SD
1	REV. AS PER CONST. SUMMARY	APR24-13	SD

REVISIONS

Footprint: S1-A

Sht. title: ELEVATIONS-A


drawn by: CL

checked by: OF

date: FEB. 2007

scale: 1/8"=1'

sheet no: 5A / 6

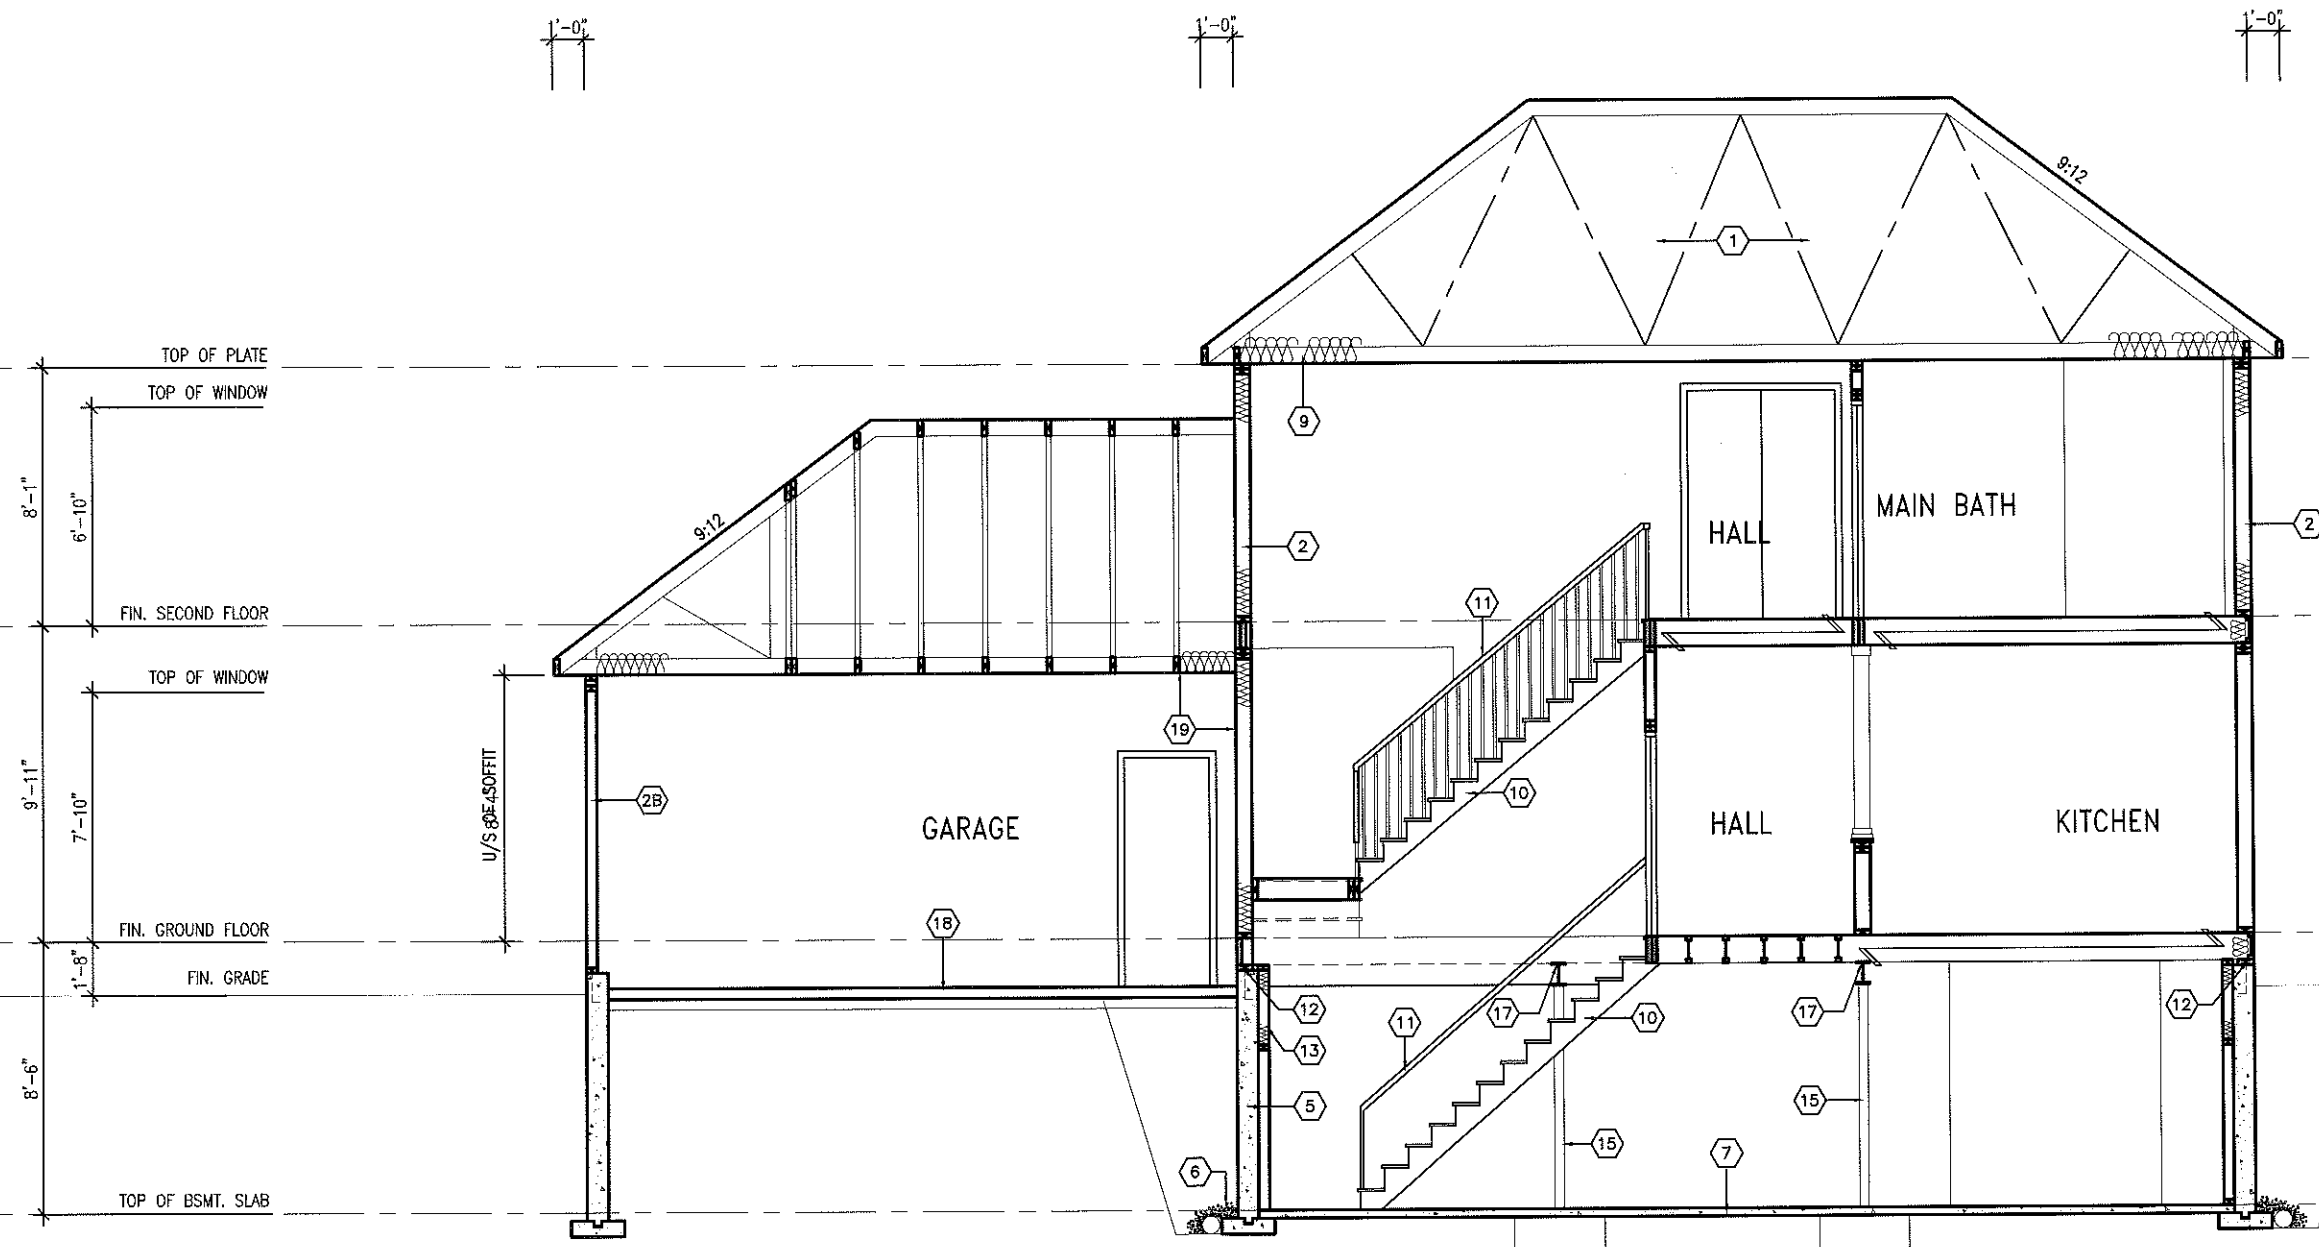

SECTION A-A



Viljoen Architect Inc.
 300 A Wilson Avenue
 North York, Ontario
 M3H 1S8
 TEL: (416) 630-2255
 FAX: (416) 630-4782

GREGORIAN-2007-A

SITE: **SHADOW RIDGE2**

LOT NUMBER: **59**

CIVIC ADDRESS:
 6525 WATERDOWN ST.

No.	Description	Date	By
2	REV. AS PER CONST. SUMMARY	JUL30-13	SD
1	REV. AS PER CONST. SUMMARY	APR24-13	SD
REVISIONS			

Footprint: **S1-A**

sht. title: **SECTION**

drawn by: **CL**

checked by: **OF**

date: **FEB. 2001**

scale: **3/16"=1'**

sheet no: **6/6**