



NOTE: PROVIDE 2" CONDUIT FROM BASEMENT TO ATTIC

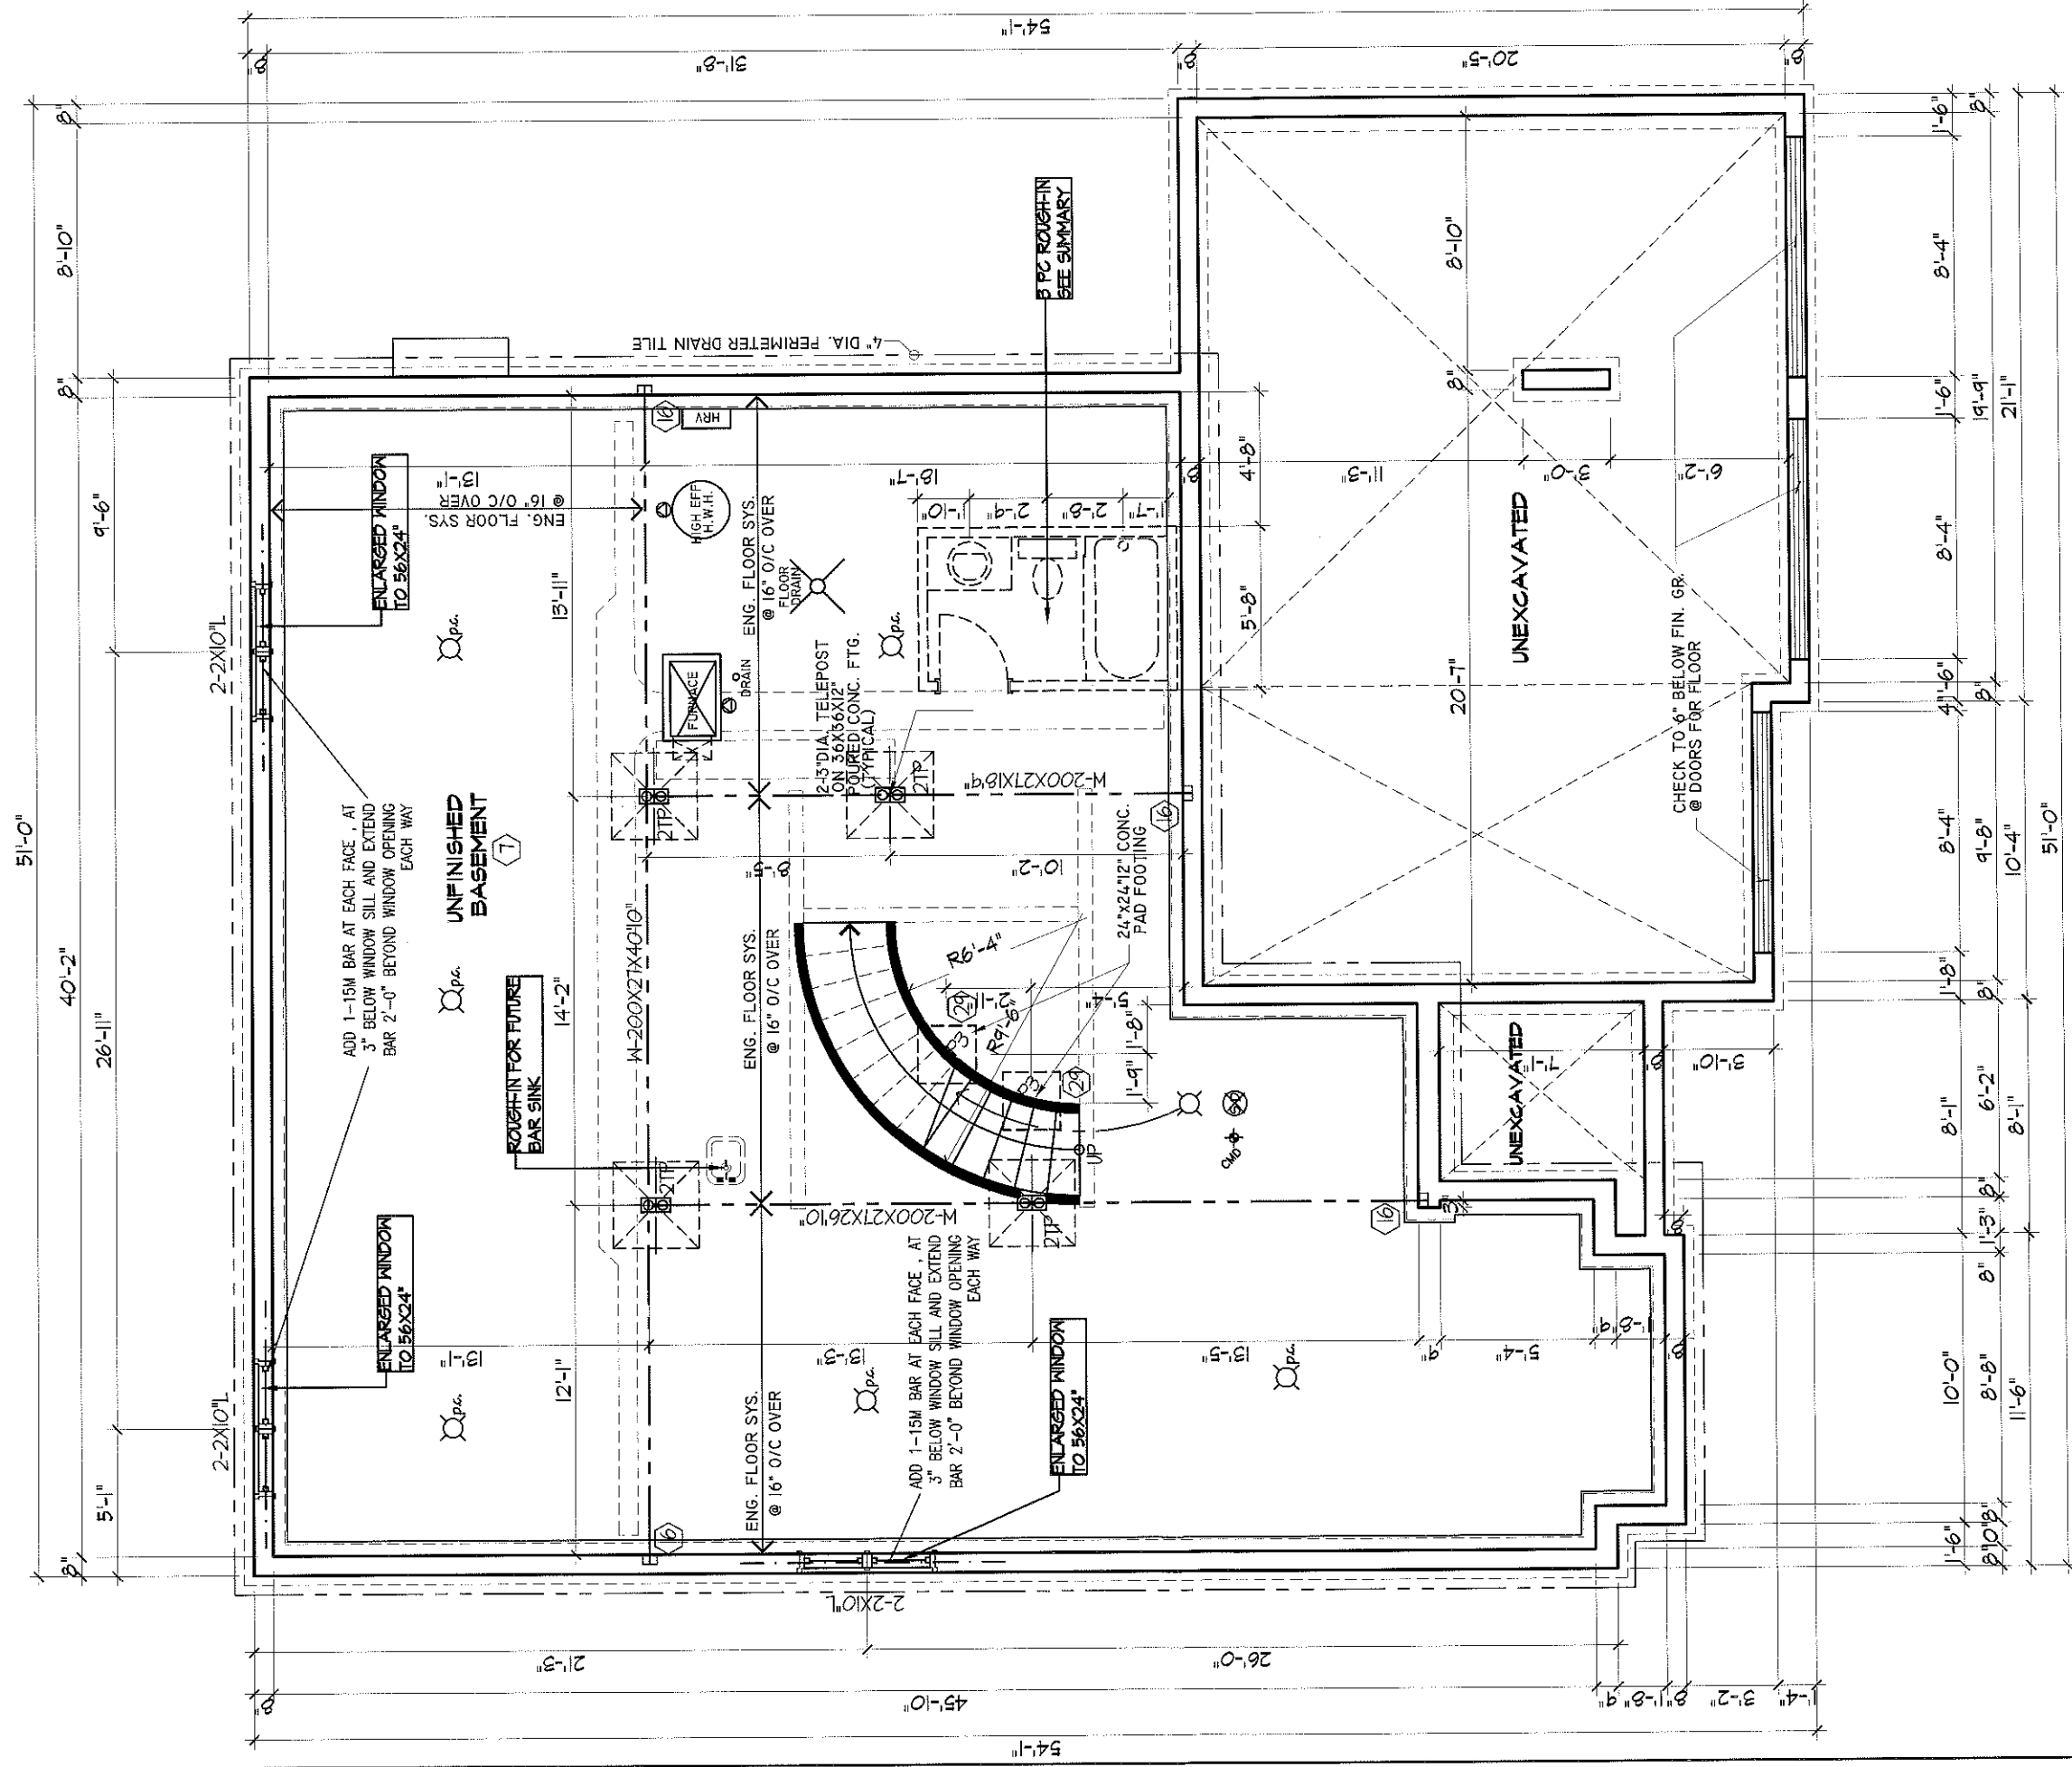

BASEMENT FLOOR PLAN ELEV. B
(3 CAR GARAGE)

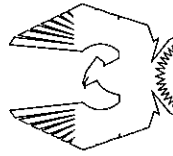

PHOENIX HOMES

CHEASPEAKE-2007-B

SITE: SHADON RIDGE 2

LOT NUMBER:

CIVIC ADDRESS:
6527 WATERDOWN ST.

00

No.	Description
REVISIONS	

REV. AS PER CONST. SUMMARY

REV. AS PER CONST. SUMMARY

Date	By
------	----

Date	By
------	----

Date	By
------	----

file number: 508

drawn by: T.L.

date: JAN.2011

scale: 3/6"=1'


sheet no:

(5)


508

3CAR

NOTE: PROVIDE 2" CONDUIT FROM BASEMENT TO ATTIC

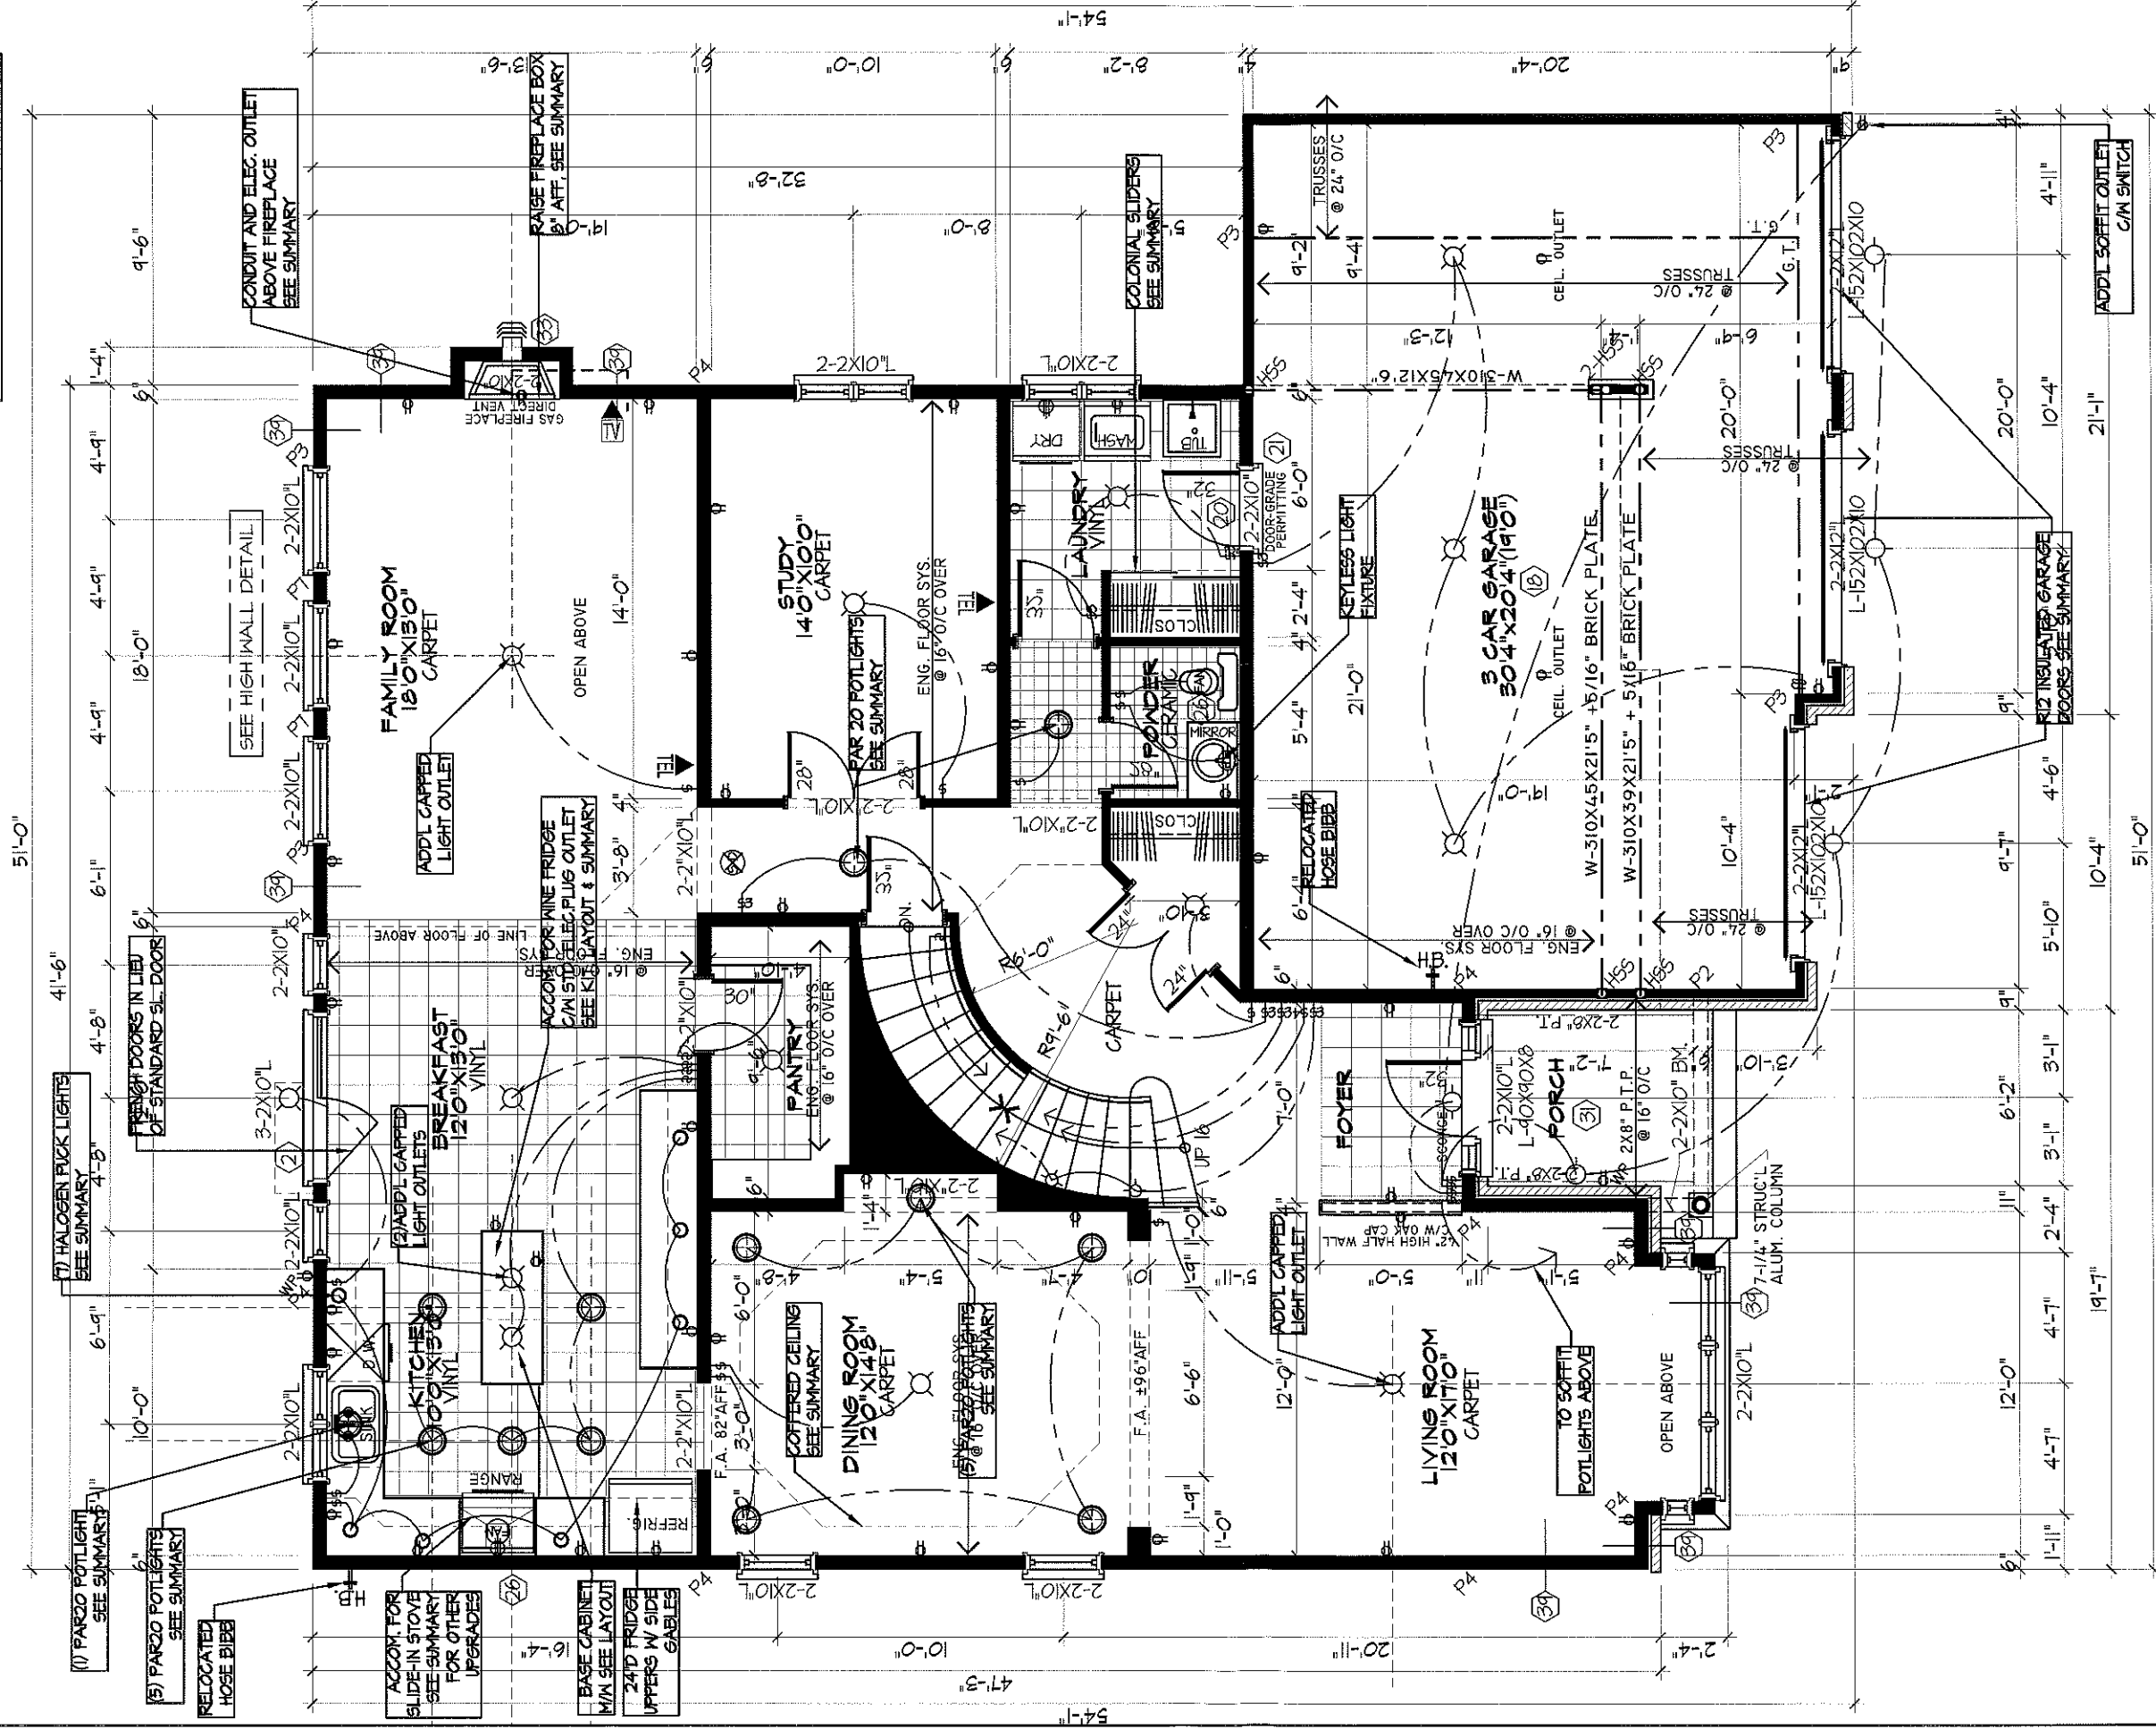

MAIN FLOOR PLAN ELEV. B - 1635 SF
(3 CAR GARAGE)

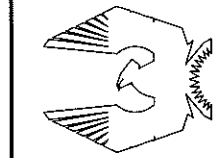

PHOENIX HOMES

CHEASAPEAKE-2007-B-3CAR

SITE: SHADOW RIDGE2

LOT NUMBER:

CIVIC ADDRESS:
6521 WATERDOWN ST.

60

No.	Description	Date	By
2	REV. AS PER CONST. SUMMARY	JUL24-13	SD
1	REV. AS PER CONST. SUMMARY	JULIO-13	SD

File number: 508

drawn by: T.L.

date: JAN2011

scale: 3/16"=1'


sheet no:

3B


9

508
3CAR

NOTE: PROVIDE 2" CONDUIT FROM BASEMENT TO ATTIC

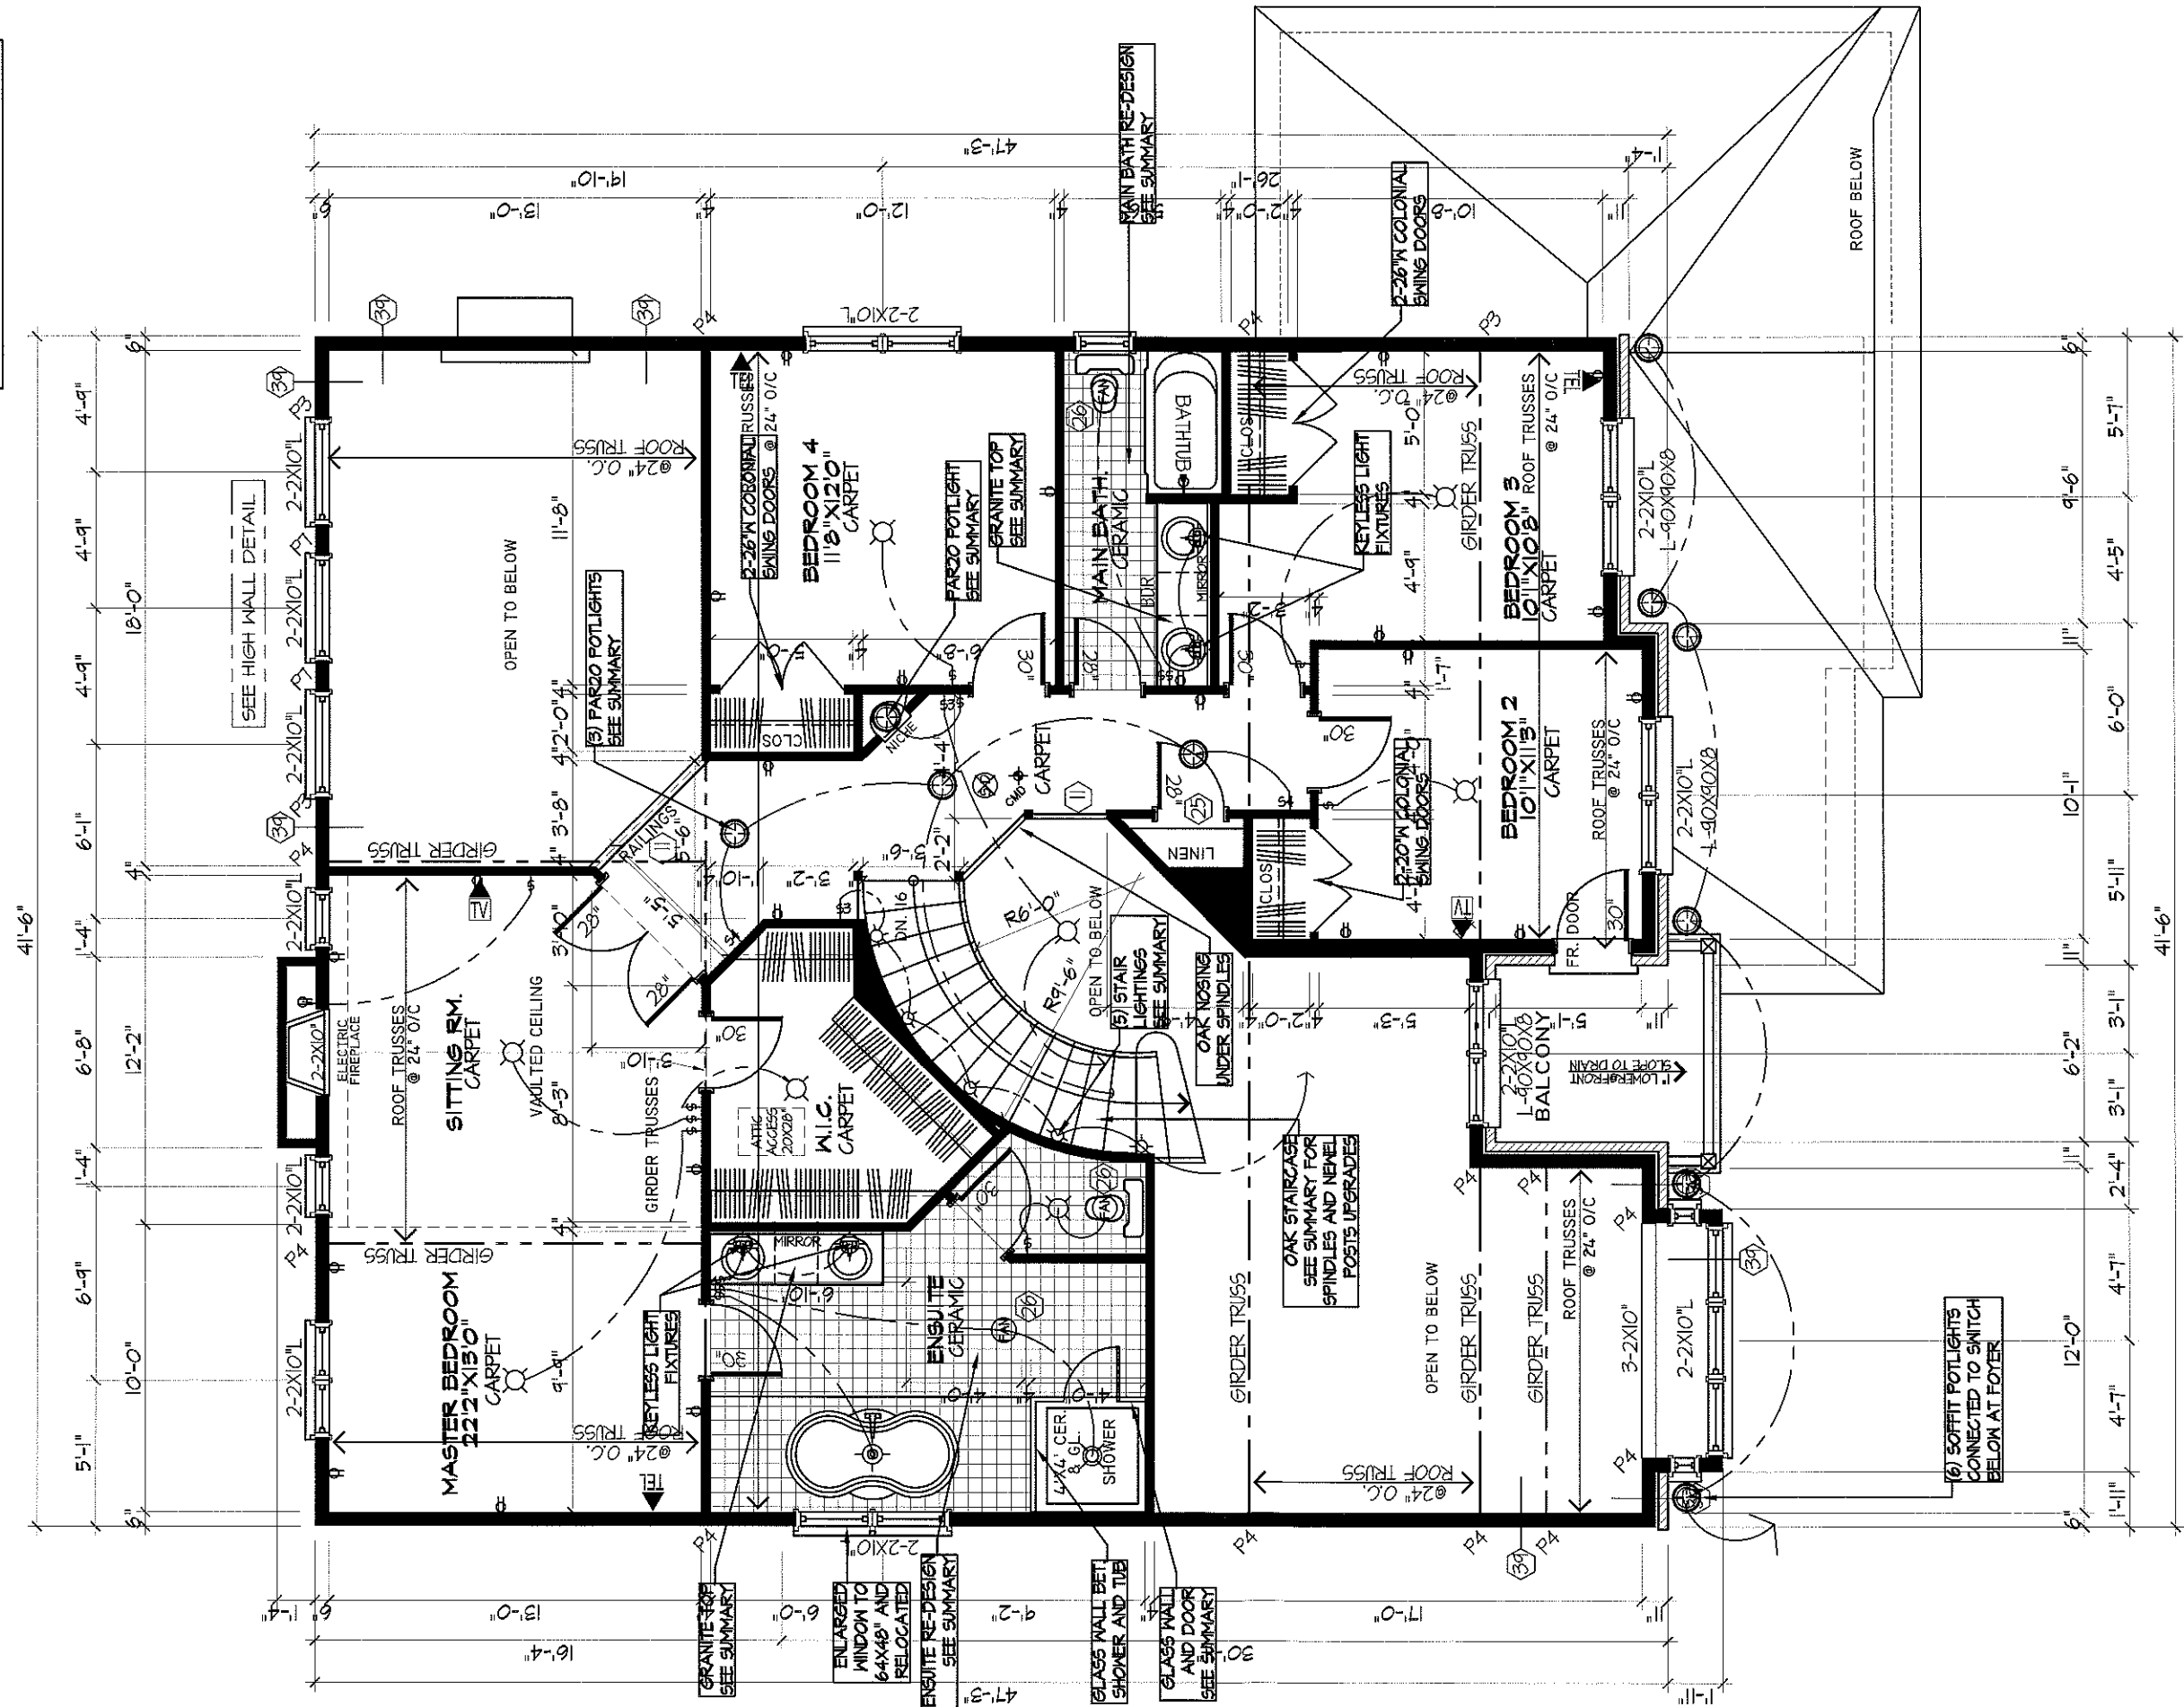

SECOND FLOOR PLAN ELEV. B - 1354 SF
(3 CAR GARAGE)

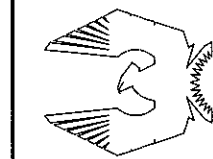

PHOENIX HOMES

CHEASAPEAKE-2007-B-3CAR

SITE: SHADOW RIDGE2

LOT NUMBER:

CIVIC ADDRESS:
6527 WATERDOWN ST.

60

File number: 508

drawn by: T.L.

date: JAN 2011

scale: 3/16"=1'


sheet no:

4B


9

REVISIONS		No.	Description	Date	By
2	REV. AS PER CONST. SUMMARY	JUL 24-13	SD		
1	REV. AS PER CONST. SUMMARY	JUL 10-13	SD		

508
3CAR

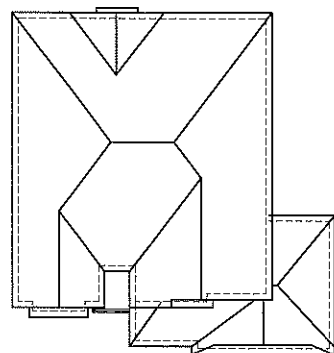

ROOF PLAN-B

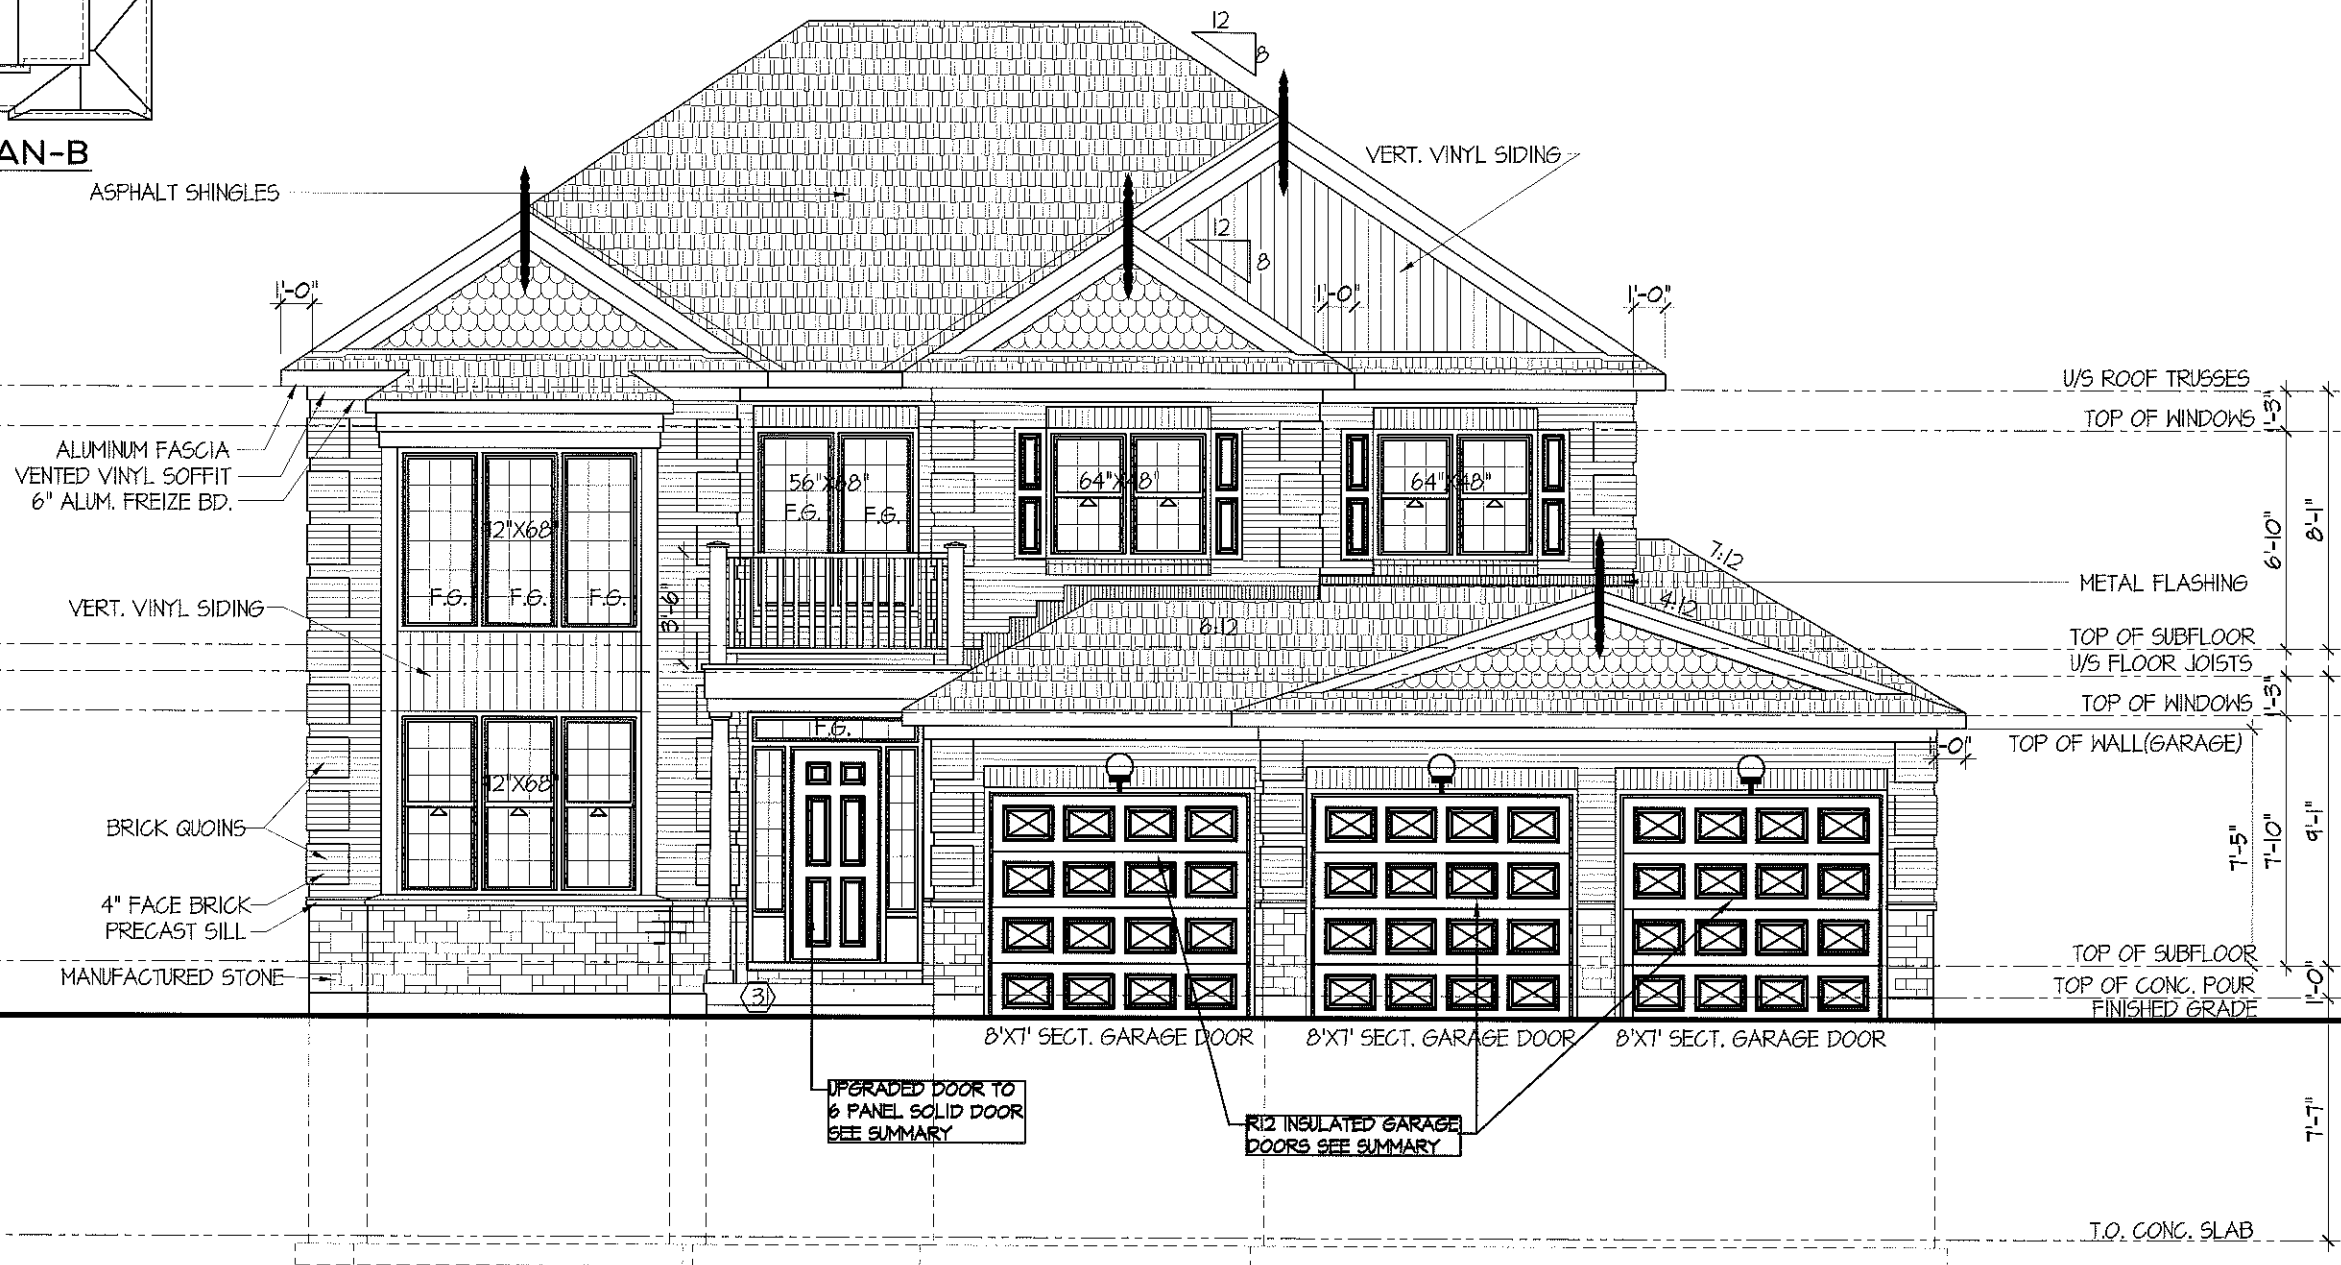

FRONT ELEVATION 'B'
(3 CAR GARAGE)

508
3CAR

File number: 508
drawn by: T.L.
date: JAN 2011
scale: 3/16"=1'
sheet no: 5B
9

2	REV. AS PER CONST. SUMMARY	JUL 24-13	SD
1	REV. AS PER CONST. SUMMARY	JUL 10-13	SD
No.	Description	Date	By
REVISIONS			

CHEASAPEAKE-2007-B-3CAR

SITE: SHADOW RIDGE 2
LOT NUMBER: 60
CIVIC ADDRESS: 6521 WATERDOWN ST.

PHOENIX HOMES