


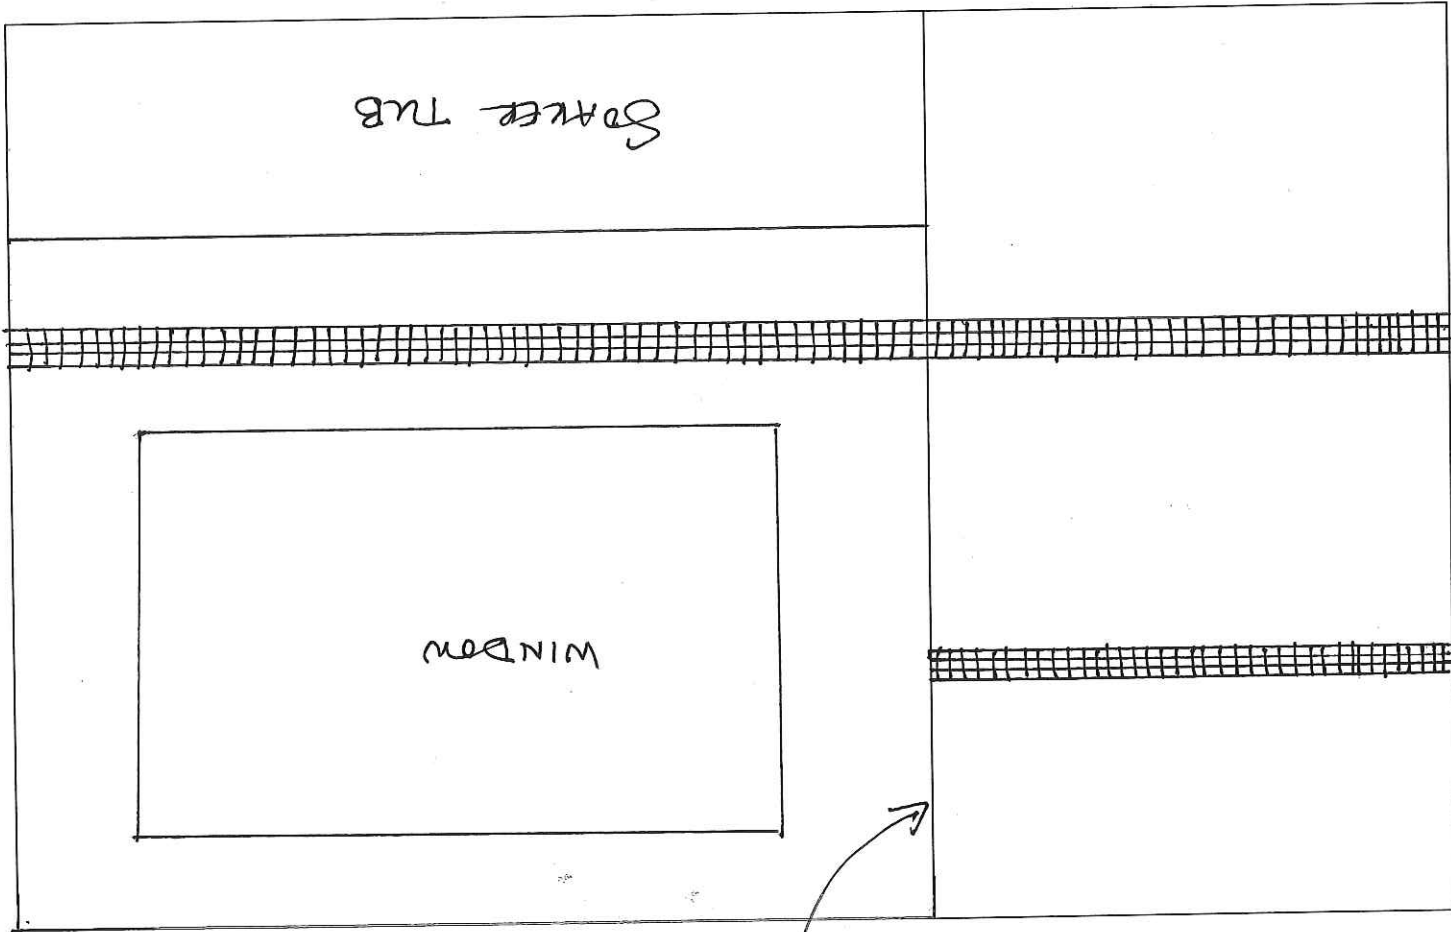


GLASS WALL

LISTED
* SEE ATTACHED
FOR FURTHER DETAIL


LOT 60 S&2
LISTED IN EASEMENT

NOTE: PROVIDE 2" CONDUIT FROM BASEMENT TO ATTIC

LISTED TO BE INSTALLED
ON ALL (3) WALLS.

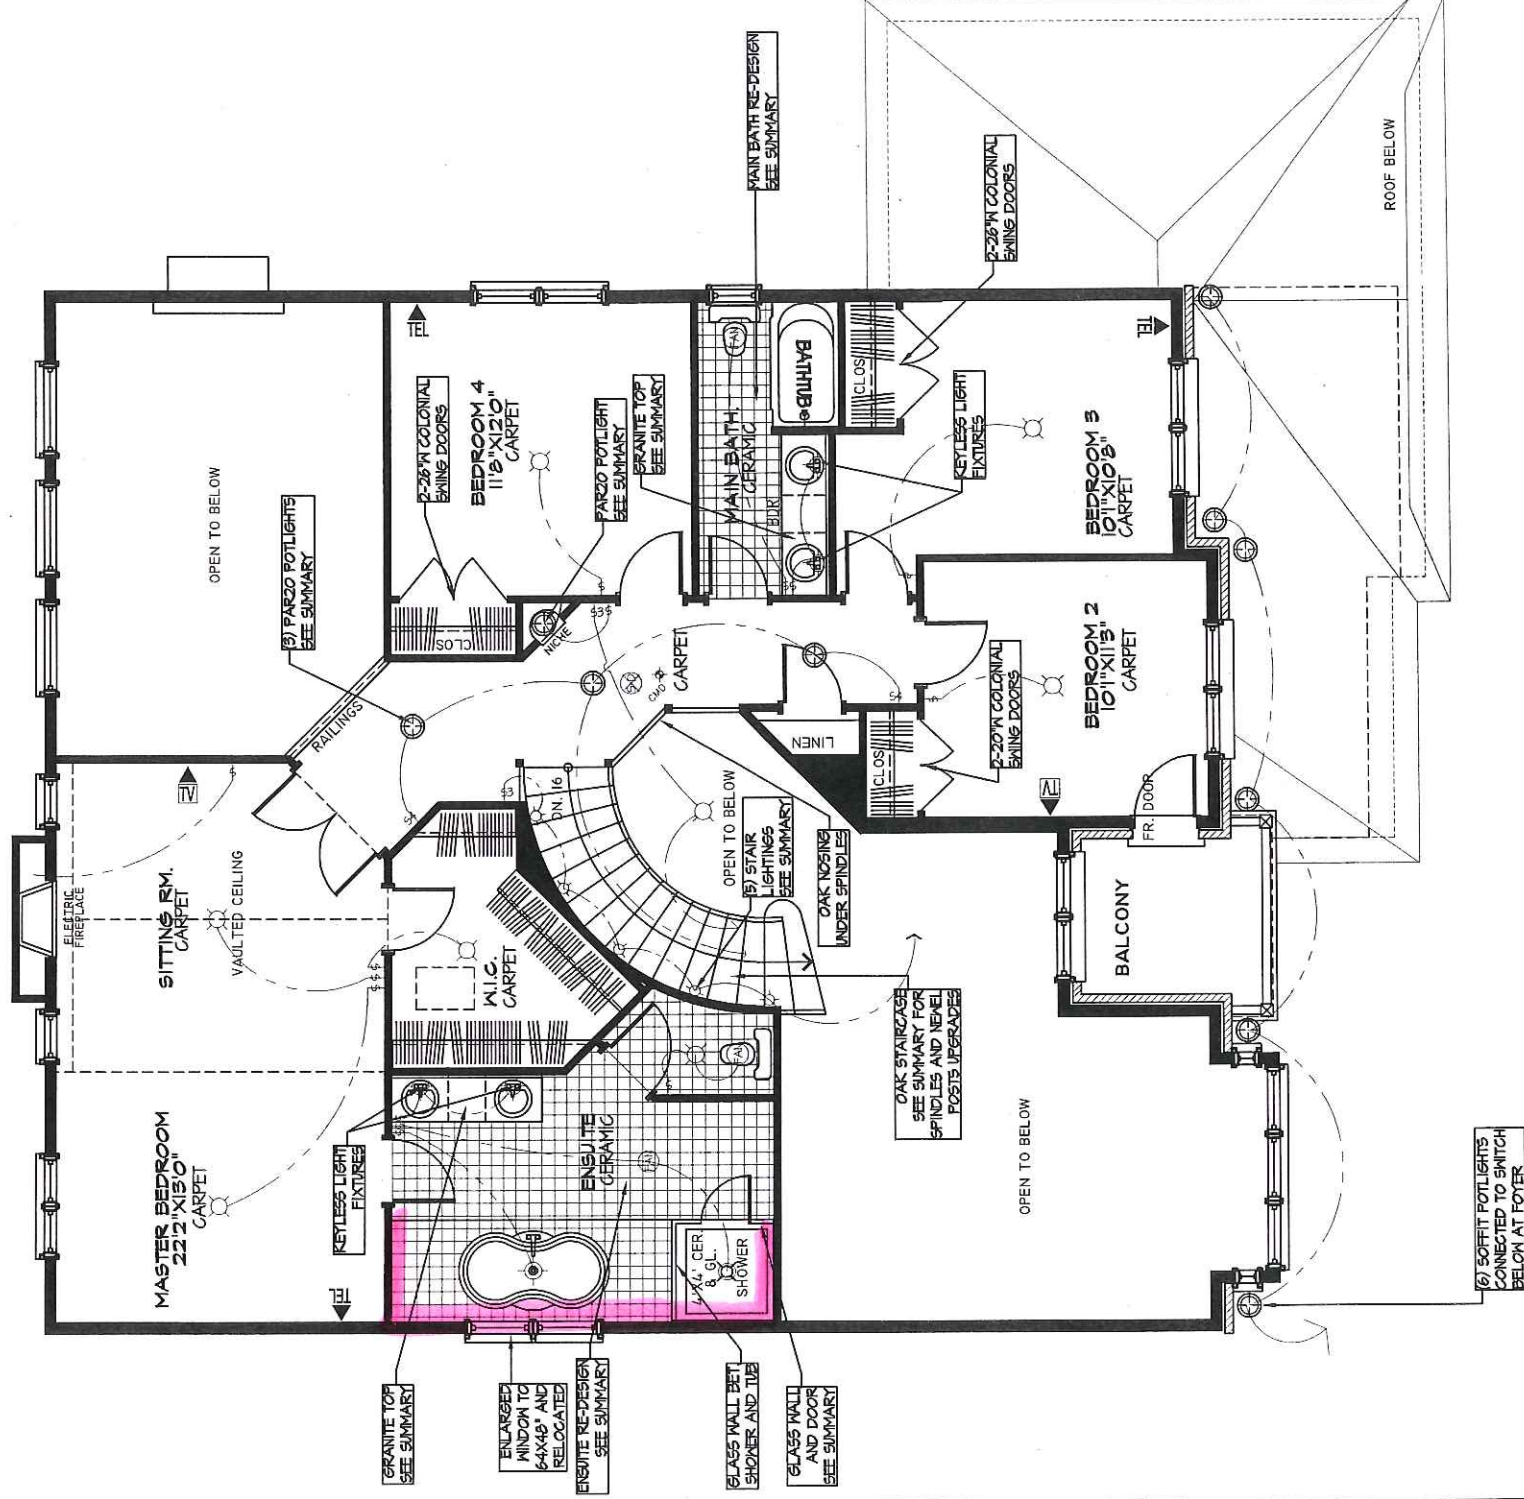

SECOND FLOOR PLAN ELEV. B - 1354 SF
(3 CAR GARAGE)

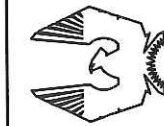

PHOENIX HOMES

CHEASAPEAKE-2007-B-3CAR

SITE: SHADOW RIDGE2

LOT NUMBER:

60

CIVIC ADDRESS:
6521 WATERDOWN ST.

File number: 508

drawn by: T.L.

date: JAN 2011

scale: 3/16"=1'

sheet no:

4B

9

508

3CAR