

SHADOW RIDGE 2

LOT# 62

GREGORIAN (S1)

S/T DEAN
KITCHEN

MOUNTING HT - 93"

~~2" CROWN MOULDING~~

~~RECESSED VALANCE~~

LINE-3
DOOR STYLE - SOHO
SPECIES - MAPLE
COLOUR - WENGE

HARDWARE-TBC-HU80 OR HU70

KICK: 3-PCS.

STANDARD WHITE INTERIOR

METAL DRAWER BOX

1 - PC, 90 DEG. CORNER MOULD.

2 PCS - FILLER - 6" x 96'


**GRANITE COUNTER TOPS
BY BUILDER**

CUSTOMER APPROVAL

I have reviewed these drawings and understand the details of the layout and the Cartier Kitchens specifications.

Signature _____

Date _____

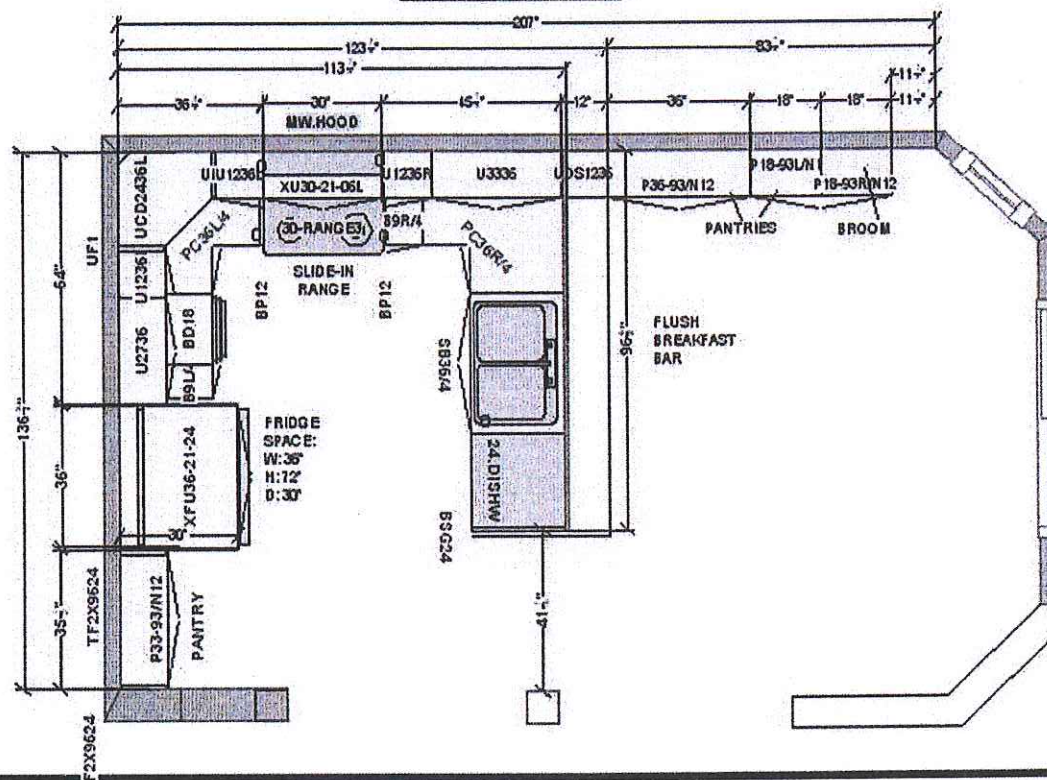


DRAWN BY:

LORI DISAVETRIO, B.I.D.

CARTIER KITCHENS

JUNE 3, 2012.

* NO CROWN
NO VALANCE

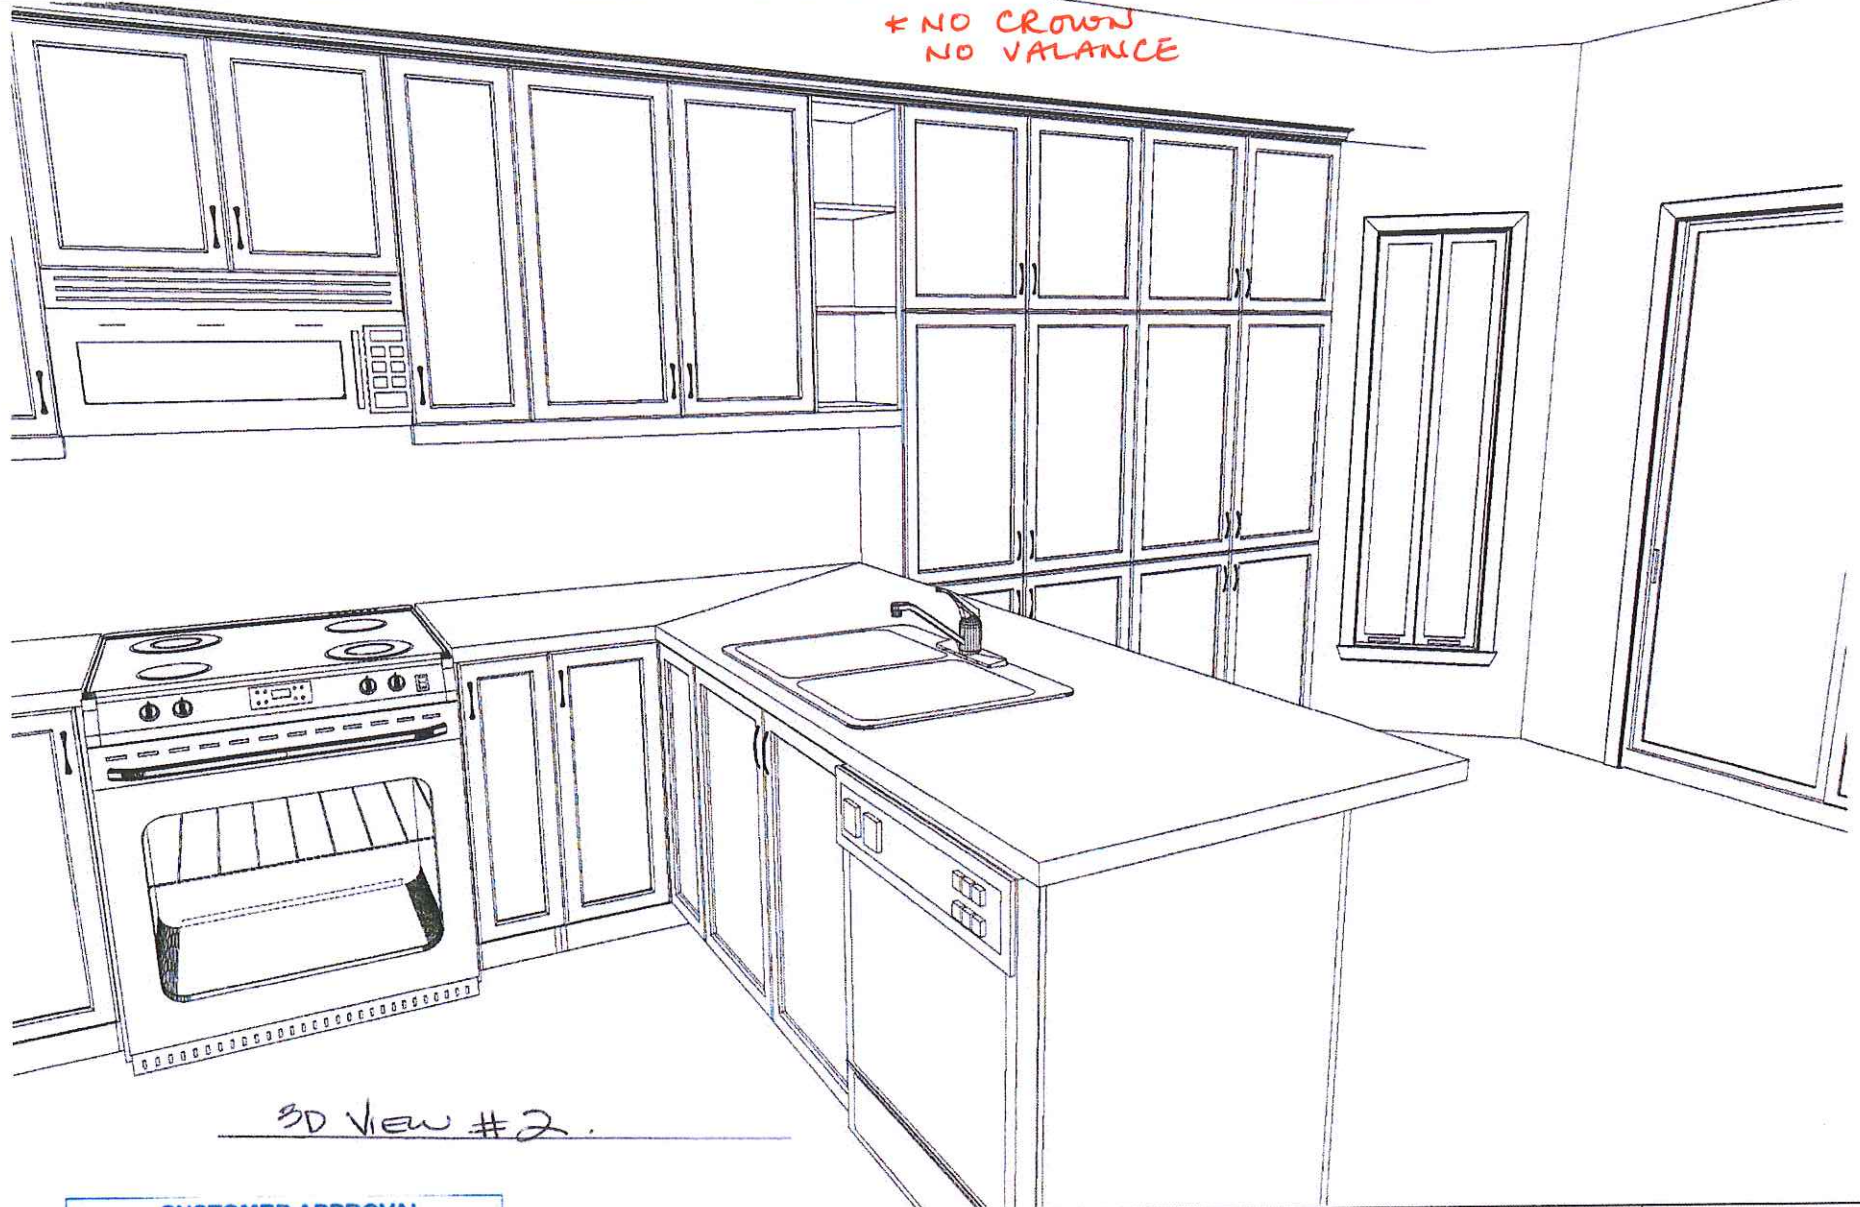

3D View #2.

CUSTOMER APPROVAL

I have reviewed these drawings and understand the details of the layout and the Cartier Kitchens specifications.

Signature

Date

[Signature]
July 27/12

Note: This drawing is an artistic interpretation of the general appearance of the design. It is not meant to be an exact rendition.

DESIGNED BY: LORI DISAVERIO.

DCR - #62 SR2 - GREGORIAN (S1) - KITCHEN




Designed: 6/3/2012
Printed: 6/3/2012

All

Drawing #: 1

S1+ DEAN

* NO CROWN
NO VALLANCE

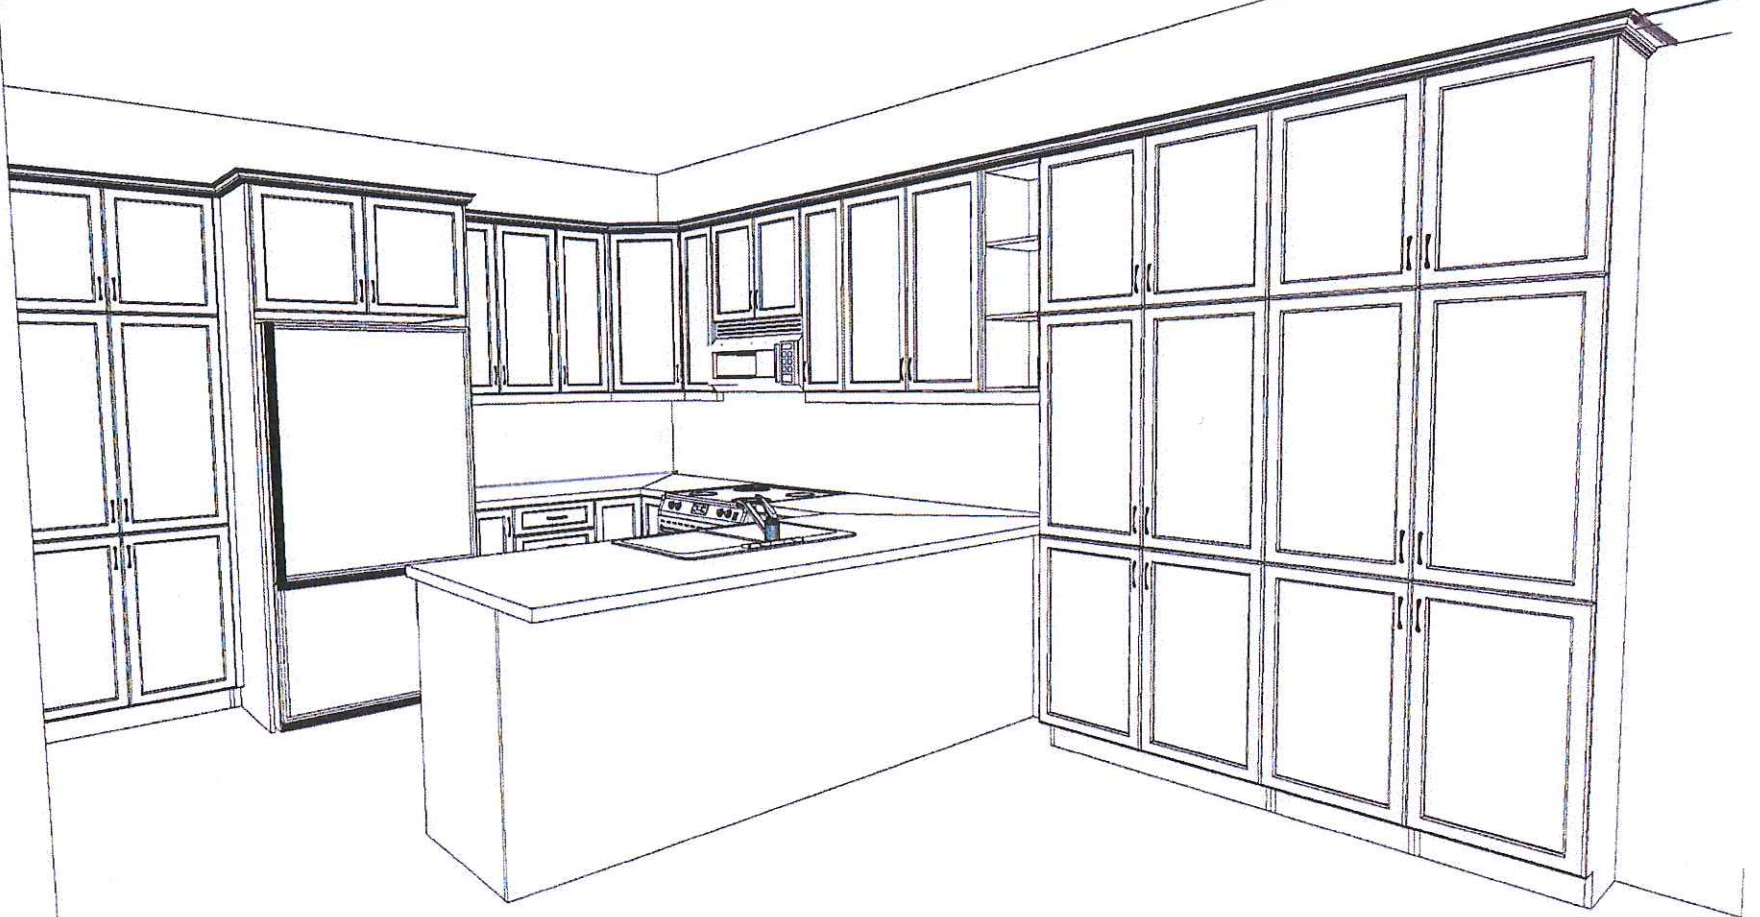

CUSTOMER APPROVAL

I have reviewed these drawings and understand the details of the layout and the Cartier Kitchens specifications.

Signature

Date

[Signature]
July 27/12

3D VIEW #1.

Note: This drawing is an artistic interpretation of the general appearance of the design. It is not meant to be an exact rendition.



Designed: 6/3/2012
Printed: 6/3/2012

DESIGNED BY: LORI DISAVERIO.

DCR #62 SR2 - GREGORIAN (S1) - KITCHEN

All

Drawing #: 1

S/t DEAN

* NO CROWN
NO VALANCE



FRIDGE WALL ELEVATION

CUSTOMER APPROVAL

I have reviewed these drawings and understand the details of the layout and the Cartier Kitchens specifications.

Signature [Signature]
Date July 27/12

Note: This drawing is an artistic interpretation of the general appearance of the design. It is not meant to be an exact rendition.



Designed: 6/3/2012
Printed: 6/3/2012




DESIGNED BY: LORI DISAVERIO.

DCR - #62 SR2 - GREGORIAN (S1) - KITCHEN All

Drawing #: 1

S/T DEAN

* NO CROWN
NO VALANCE

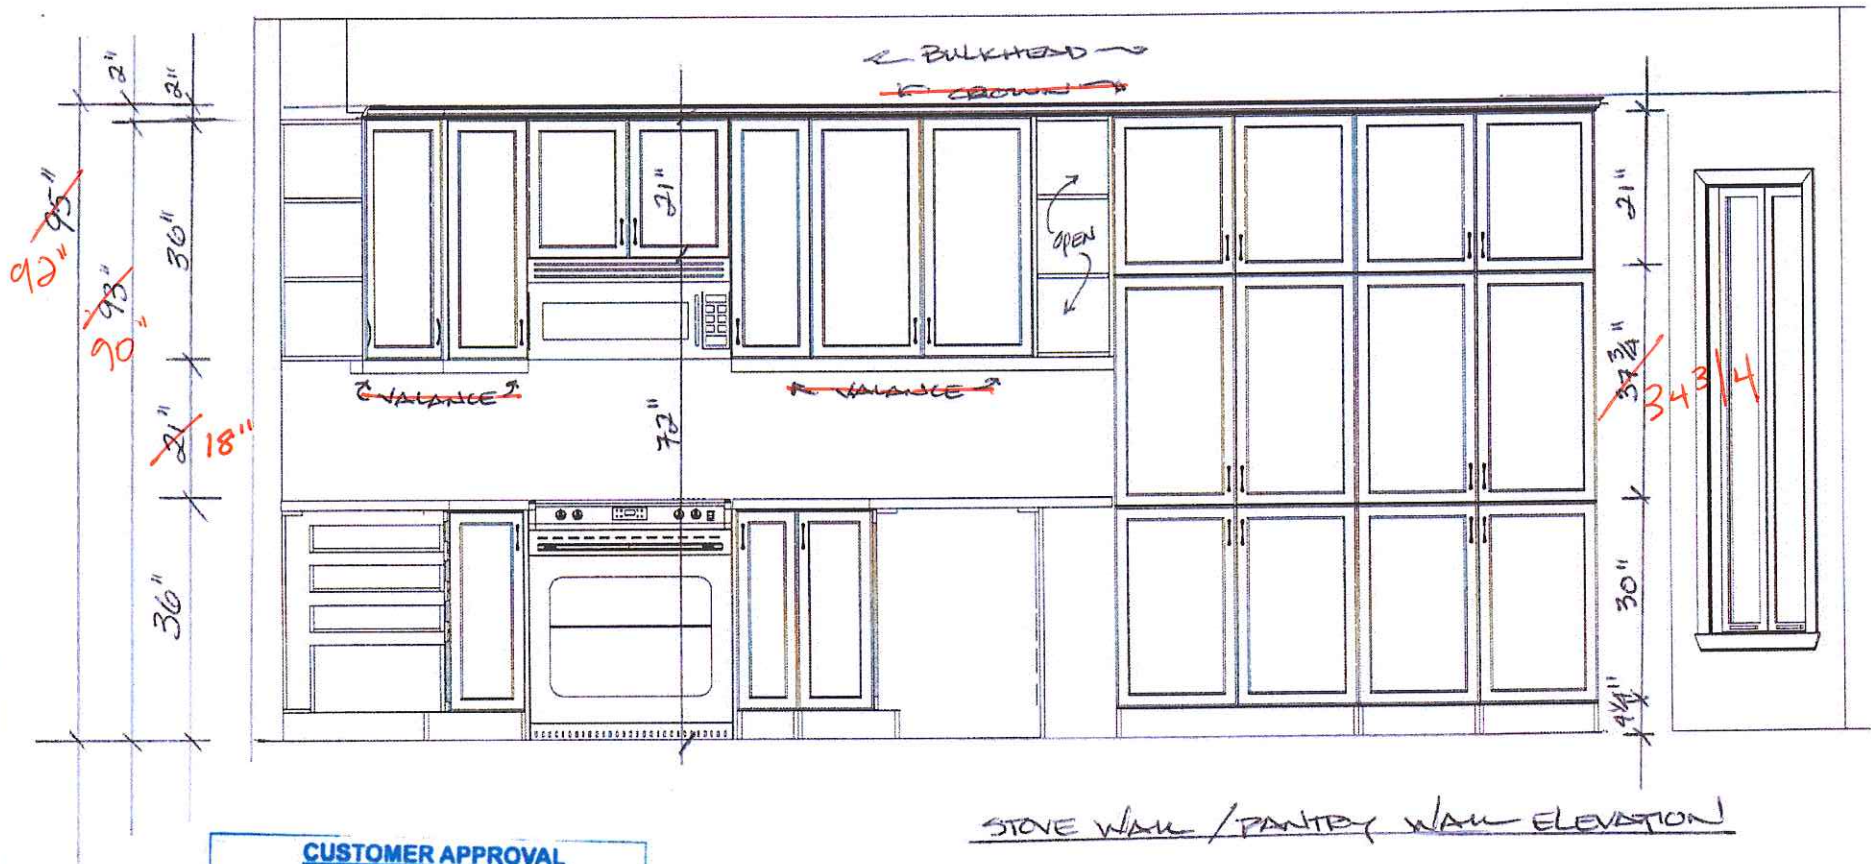

CUSTOMER APPROVAL

I have reviewed these drawings and understand the details of the layout and the Cartier Kitchens specifications.

Signature: *[Signature]*
Date: July 27/12

STONE WALL / PANTRY WALL ELEVATION

Note: This drawing is an artistic interpretation of the general appearance of the design. It is not meant to be an exact rendition.



Designed: 6/3/2012
Printed: 6/3/2012

DESIGNED BY: LORI DISAVERIO,
DCR #62 SR2 - GREGORIAN (S1) - KITCHEN

All

Drawing #: 1

S/T DEAN