


AREA CHART ON PAGE 9

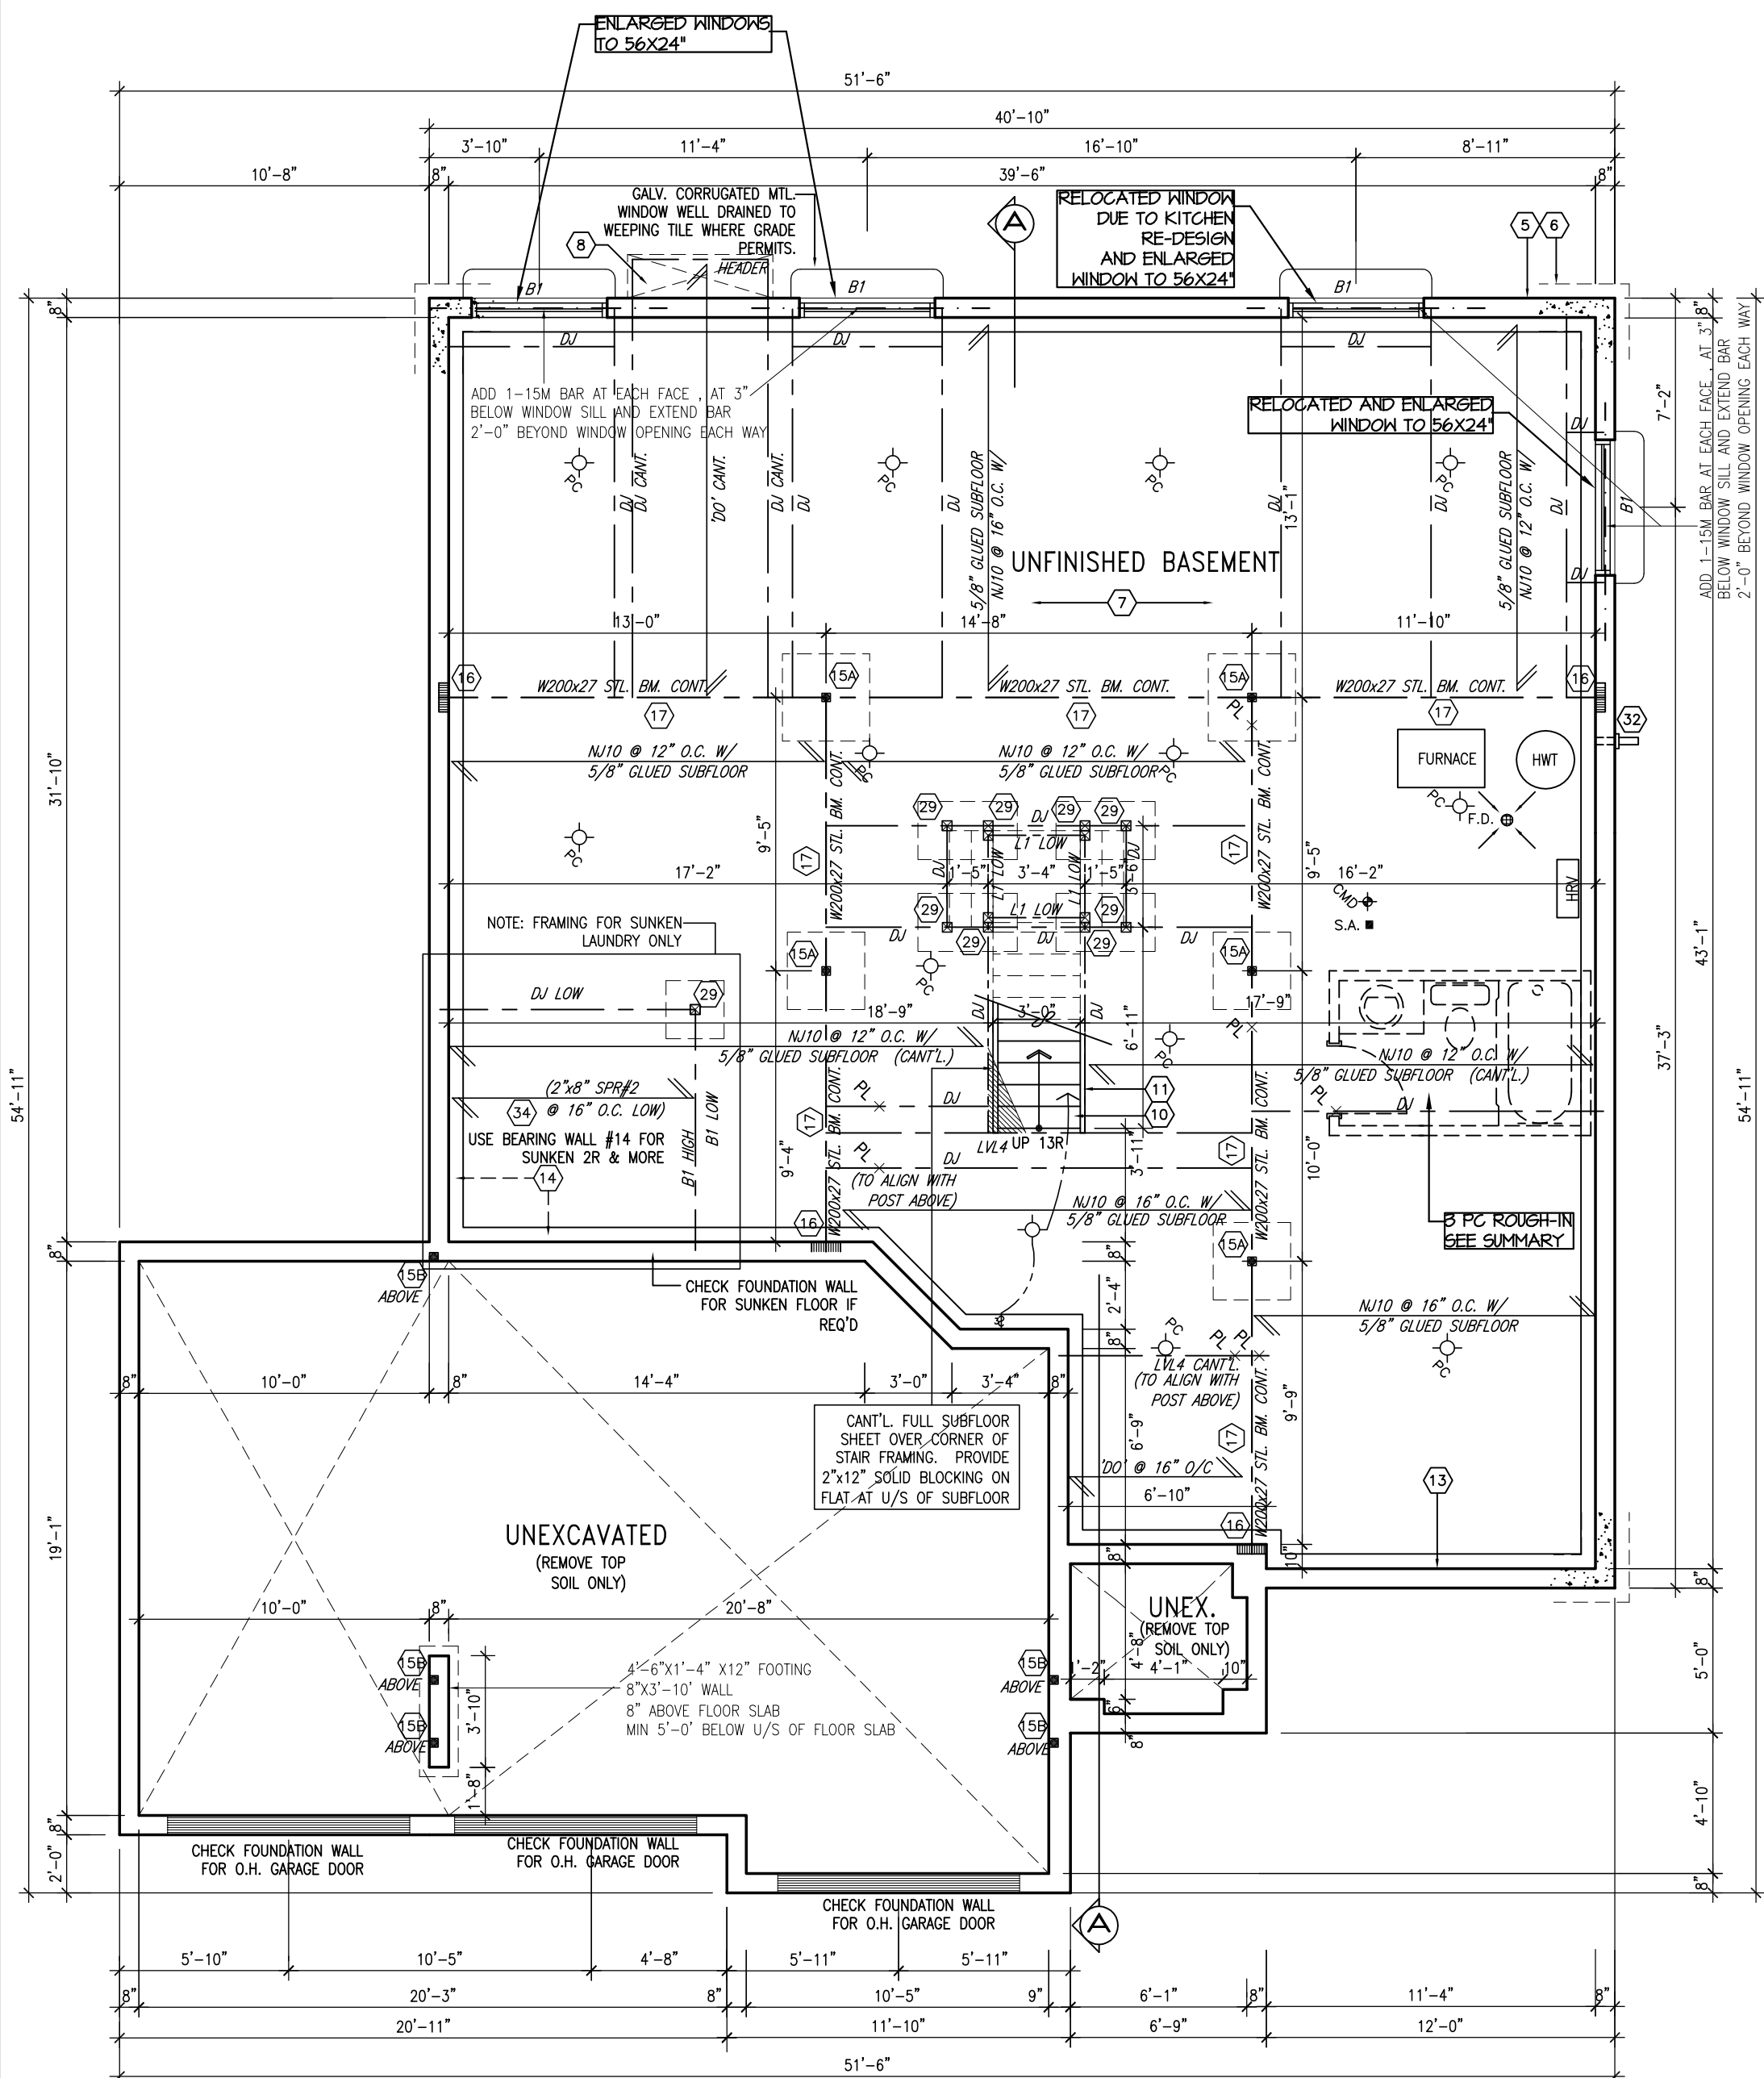


BASEMENT PLAN "B"
(3 CAR GARAGE)

NOTE:
ALL LVL'S SUPPORTING FLOOR
LOADS ARE TO BE SPECIFIED BY
THE FLOOR TRUSS MANUFACTURER.

NOTE:
FLOOR FRAMING INFO REFER TO NASCOR SHOP
DRAWINGS FOR ALL TRUSS-JOIST INFORMATION
AND DETAILS. UNLESS OTHERWISE NOTED.

NOTE:
PROVIDE FULL DEPTH BLOCKING AT 24" O.C.
WHERE JOISTS ARE PARALLEL TO FOUNDATION
WALL SUBJECT TO EARTH PRESSURE.

NOTE:
FLOOR JOIST LAY OUT WAS
REVISED TO MATCH NASCOR'S
LAYOUT FOR UNIT 511,
NASCOR JOB N#. Q06-00762
/ 63 DATED 02-03-06.

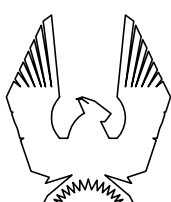

PHOENIX HOMES

YARMOUTH-2007-B

SITE: SHADOW RIDGE 2

LOT NUMBER:

CIVIC ADDRESS:
6533 WATERDOWN ST.

63

4	RELOC. KIT WINDOW PER LATEST KIT. PLAN	NOV13-13	SD
3	REV. AS PER CONST. SUMMARY	SEP4-13	SD
2	REV. AS PER CONST. SUMMARY	JUL26-13	SD
1	ISSUED FOR FOUNDATION ONLY	JUL22-13	SD
No.	Description	Date	By
REVISIONS			

footprint: 511-3CAR

sh. title:

drawn by: SD

checked by:	TL
-------------	----


date:	JAN.2011
	3'6" H

scale: $3/16" = 1'$

sheet no:	(2B)
-----------	------

511
3CAR

AREA CHART ON PAGE 9

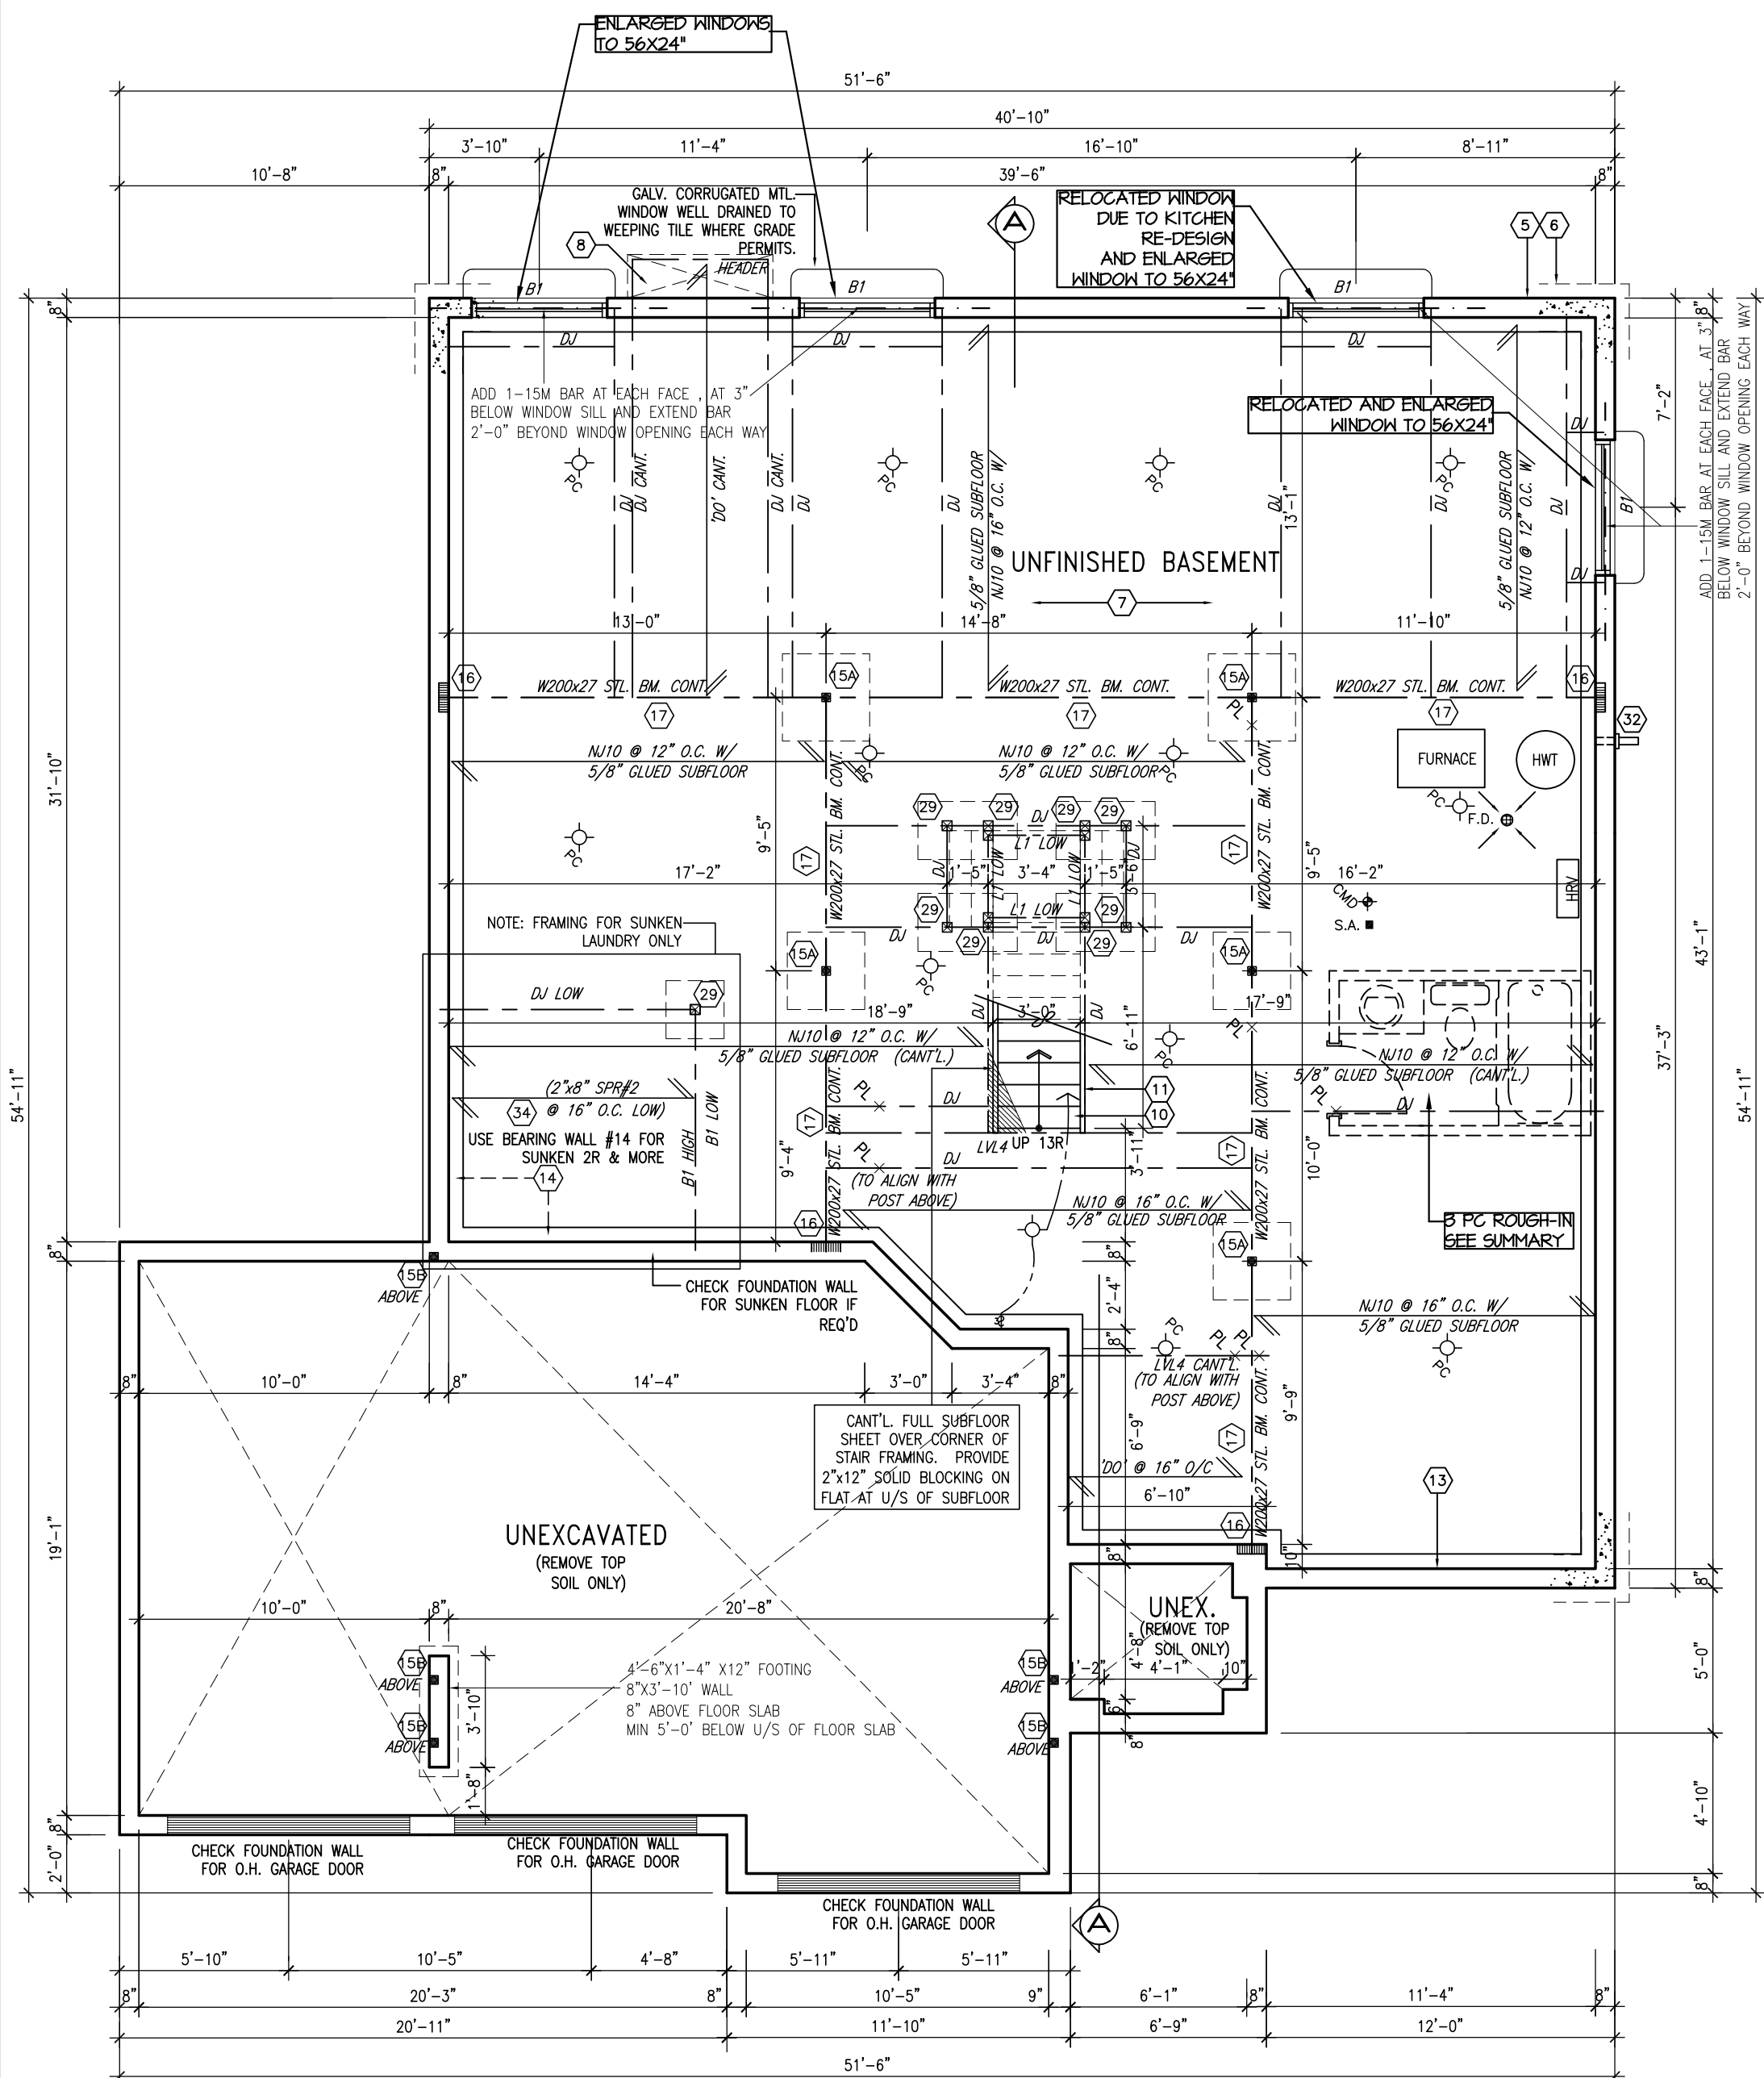


BASEMENT PLAN "B"
(3 CAR GARAGE)

NOTE:
ALL LVL'S SUPPORTING FLOOR
LOADS ARE TO BE SPECIFIED BY
THE FLOOR TRUSS MANUFACTURER.

NOTE:
FLOOR FRAMING INFO REFER TO NASCOR SHOP
DRAWINGS FOR ALL TRUSS-JOIST INFORMATION
AND DETAILS. UNLESS OTHERWISE NOTED.

NOTE:
PROVIDE FULL DEPTH BLOCKING AT 24" O.C.
WHERE JOISTS ARE PARALLEL TO FOUNDATION
WALL SUBJECT TO EARTH PRESSURE.

NOTE:
FLOOR JOIST LAY OUT WAS
REVISED TO MATCH NASCOR'S
LAYOUT FOR UNIT 511,
NASCOR JOB N#. Q06-00762
/ 63 DATED 02-03-06.

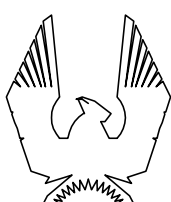

PHOENIX HOMES

YARMOUTH-2007-B

SITE: SHADOW RIDGE 2

LOT NUMBER:

CIVIC ADDRESS:
6533 WATERDOWN ST.

63

4	RELOC. KIT WINDOW PER LATEST KIT. PLAN	NOV13-13	SD
3	REV. AS PER CONST. SUMMARY	SEP4-13	SD
2	REV. AS PER CONST. SUMMARY	JUL26-13	SD
1	ISSUED FOR FOUNDATION ONLY	JUL22-13	SD
No.	Description	Date	By
REVISIONS			

footprint: 511-3CAR

sh. title:

drawn by: SD

checked by:	TL
-------------	----

date:	JAN.2011
	3'6" H

scale: $3/16" = 1'$

sheet no:	(2B)
-----------	------

511
3CAR

This architectural section drawing illustrates the structural layout of a roof. The drawing includes the following dimensions and features:

- Overall Length:** 40'-10"
- Top Chord Dimensions (from left to right):**
 - 9'-4"
 - 16'-6"
 - 10'-0"
 - 5'-0"
- Bottom Chord Dimensions (from left to right):**
 - 11'-10"
 - 4"
 - 2'-0"
 - 4"
 - 6'-0"
 - 4"
 - 19'-0"
 - 6"
- Structural Elements:**
 - Two vertical lines on the left indicate a wall or support structure, with a 6" dimension shown between them.
 - Two vertical lines in the middle indicate a support structure, with a 4" dimension shown between them.
 - Two vertical lines on the right indicate a support structure, with a 6" dimension shown between them.

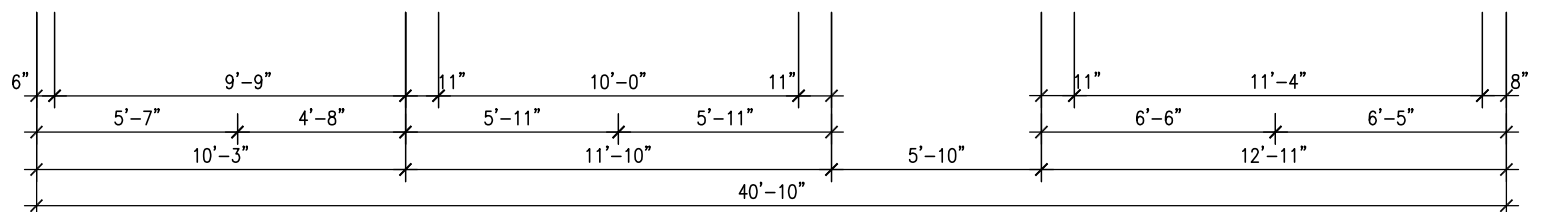


Figure 1 is a plan view of the bridge deck. It shows the layout of the deck, including the main span and approach spans, and the location of the bridge piers. The diagram includes dimensions for the spans and the width of the deck at various points. The main span is 10'-0" long. The approach spans are 5'-7" and 4'-8" long. The width of the deck at the piers is 11'-0" and 11'-4". The width of the deck at the ends is 6'-6" and 6'-5". The width of the deck at the center of the main span is 12'-11". The width of the deck at the center of the approach spans is 10'-3" and 11'-10". The width of the deck at the center of the main span is 40'-10". The width of the deck at the center of the approach spans is 5'-10".



SITE: SHADOW RIDGE 2

63

4	RELOC. KIT WINDOW PER LATEST KIT. PLAN	NOV13-13	SD
3	REV. AS PER CONST. SUMMARY	SEP4-13	SD
2	REV. AS PER CONST. SUMMARY	JUL26-13	SD
1	ISSUED FOR FOUNDATION ONLY	JUL22-13	SD
No.	Description	Date	By
REVISIONS			

sheet no:	4B.1
	9

511
3CAR



-VALLEY FLASHING (TYP.)

9

511
3CAR



CIVIC ADDRESS:
6533 WATERDOWN ST.

63

4	RELOC. KIT WINDOW PER LATEST KIT. PLAN	NOV13-13	SD
3	REV. AS PER CONST. SUMMARY	SEP4-13	SD
2	REV. AS PER CONST. SUMMARY	JUL26-13	SD
1	ISSUED FOR FOUNDATION ONLY	JUL22-13	SD
No.	Description	Date	By
REVISIONS			

MA



SITE: SHADOW RIDGE 2

CIVIC ADDRESS:
6533 WATERDOWN ST.

63

No.	Description
REVISIONS	



footprint: 511-3CAR

sheet no:

$$\frac{8.1}{9}$$

511
3CAR

INTERIOR ELEVATION A

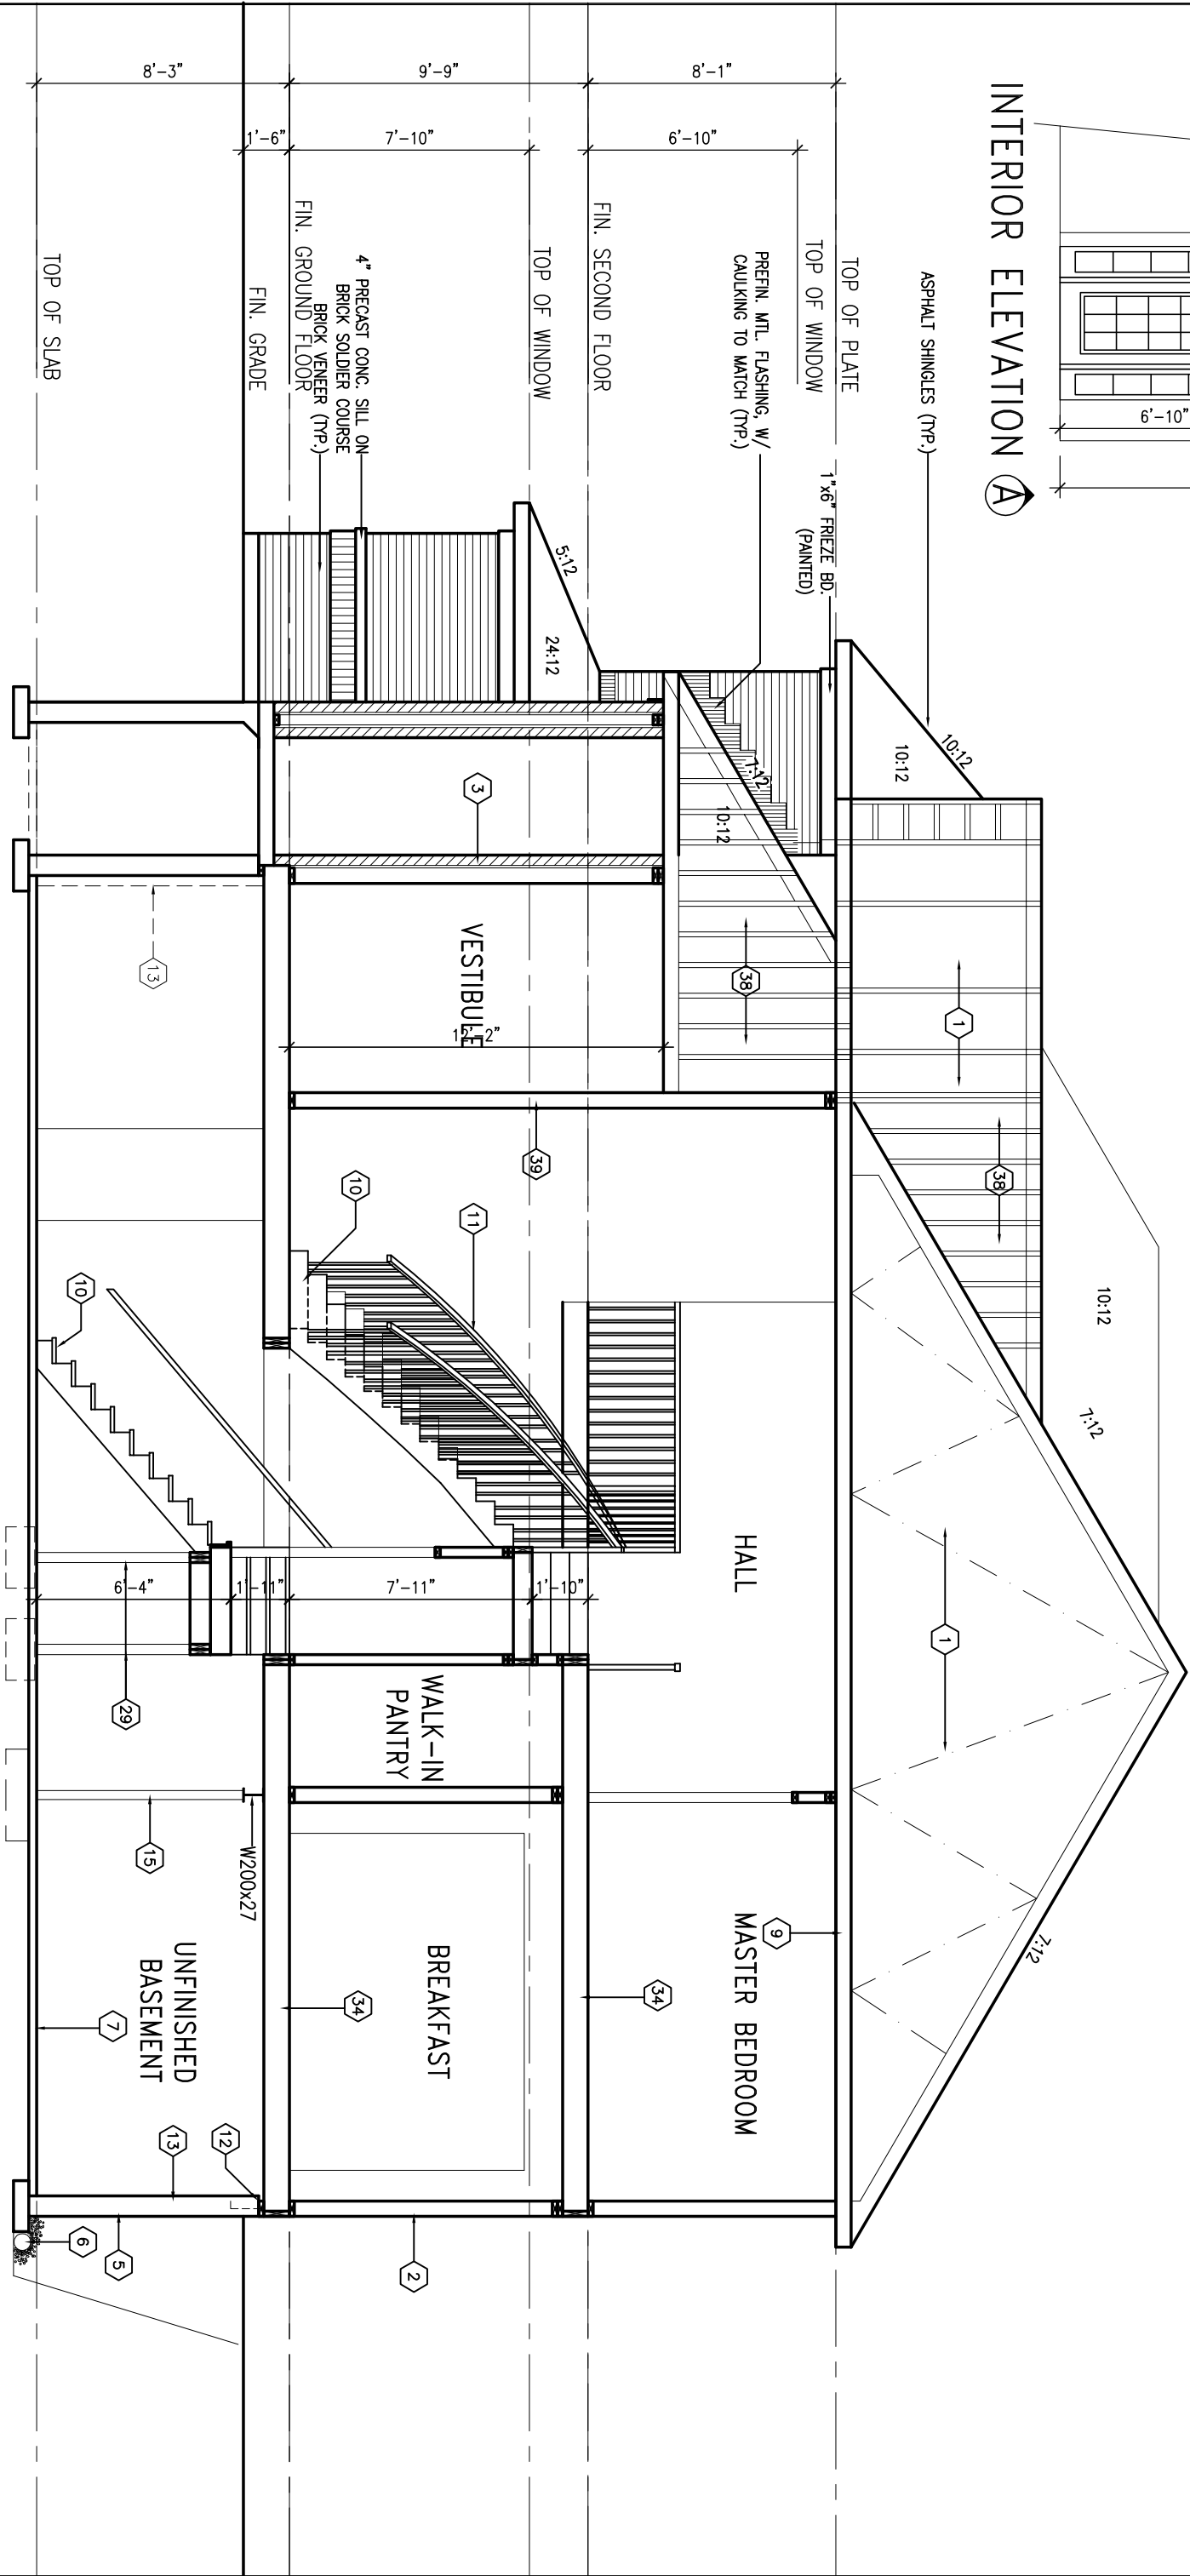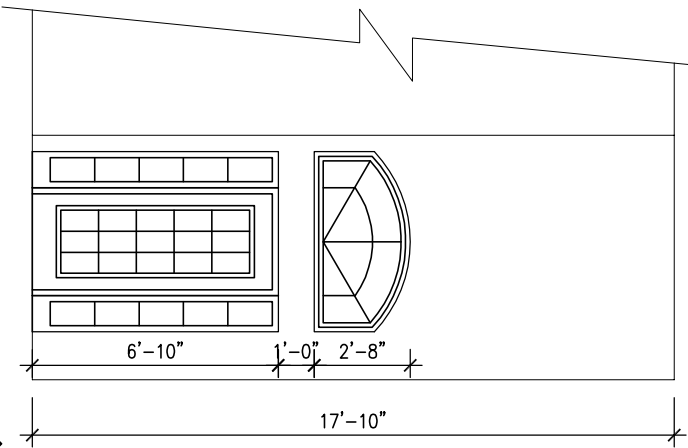

SECTION A-A

AREA CALCULATIONS		ELEV. B
GROUND FLOOR AREA	1591 SF	
SECOND FLOOR AREA	1862 SF	
SUBTOTAL	3453 SF	
DEDUCT ALL OPEN AREAS	540 SF	
TOTAL NET AREA	2913 SF	
	(270.62 m ²)	
FINISHED BSMT AREA	XX SF	
COVERAGE	2029 SF	
W/OUT PORCH	(188.49 m ²)	
COVERAGE	2066 SF	
W/ PORCH	(191.93 m ²)	



YARMOUTH-2007-B

SITE: SHADOW RIDGE 2

LOT NUMBER:

CIVIC ADDRESS:
6533 WATERDOWN ST.

63

No.	Description	Date	By
4	RELOC. KIT WINDOW PER LATEST KIT. PLAN	NOV13-13	SD
3	REV. AS PER CONST. SUMMARY	SEP4-13	SD
2	REV. AS PER CONST. SUMMARY	JUL26-13	SD
1	ISSUED FOR FOUNDATION ONLY	JUL22-13	SD
REVISIONS			

Footprint: 511-3CAR

sht. title:
drawn by: SD
checked by: TL
date: JAN2011
scale: 3/16"=1"

sheet no:

9B
9

511
3CAR