


CUSTOMER APPROVAL

I have reviewed these drawings and understand the details of the layout and the Cartier Kitchens specifications.

Signature:  Date: Mar. 2/13

Writer's note
Per May 6/12

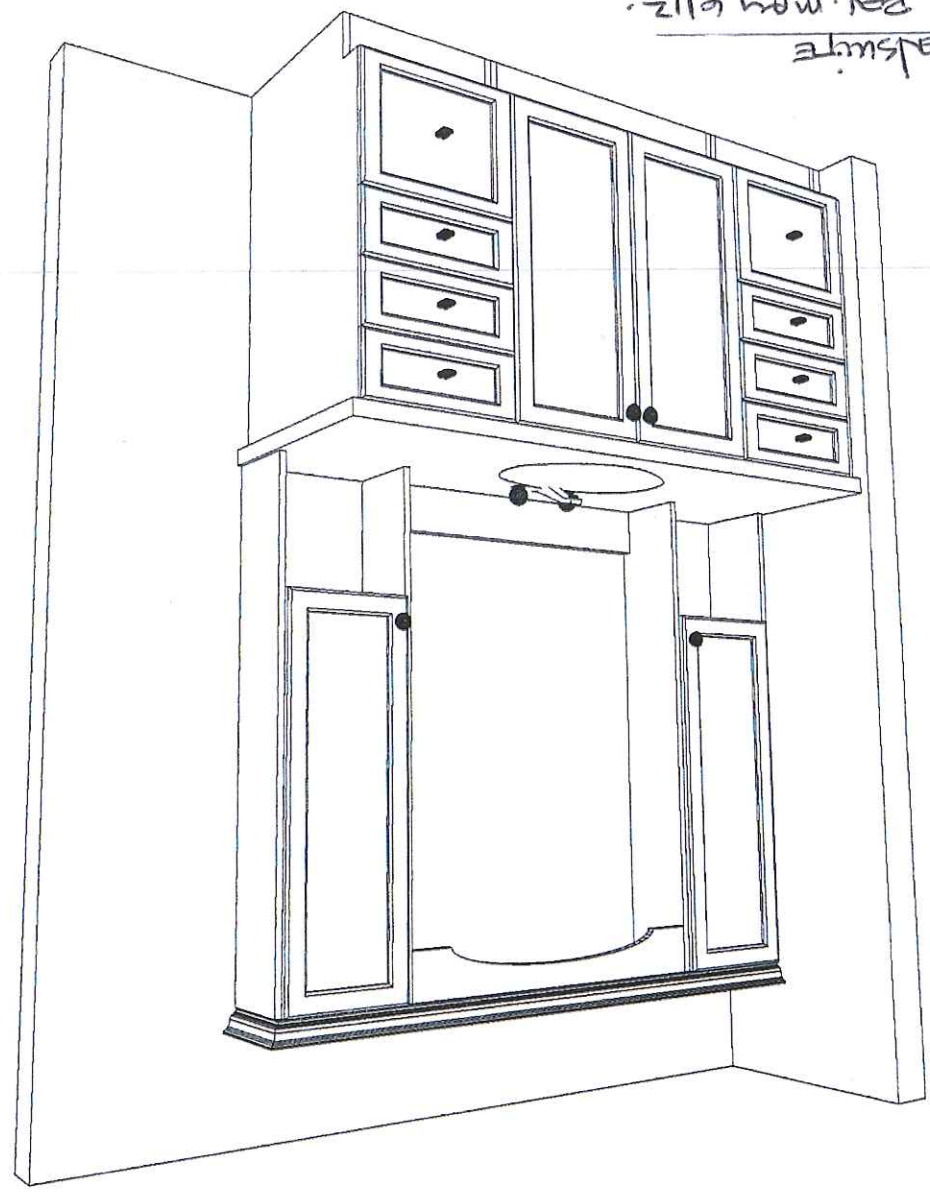

Note: This drawing is an artistic interpretation of the general appearance of the design. It is not meant to be an exact rendition.

DESIGNED BY: LORI DISAVERIO,
 DCR - #64 SR 2 - VANITIES



Designed: 3/12/2012
 Printed: 5/6/2012

All
 Drawing #: 1

CUSTOMER APPROVAL

Mar. 2/13

Ben


DESIGNED BY: LORI DISAVRIO.
DCR - #64 SR 2 - VANITIES

Kitchen

Drawing #: 1

Designed: 3/12/2012
Printed: 5/6/2012

Master Edsmit - elevation - Rev. May 6/12.

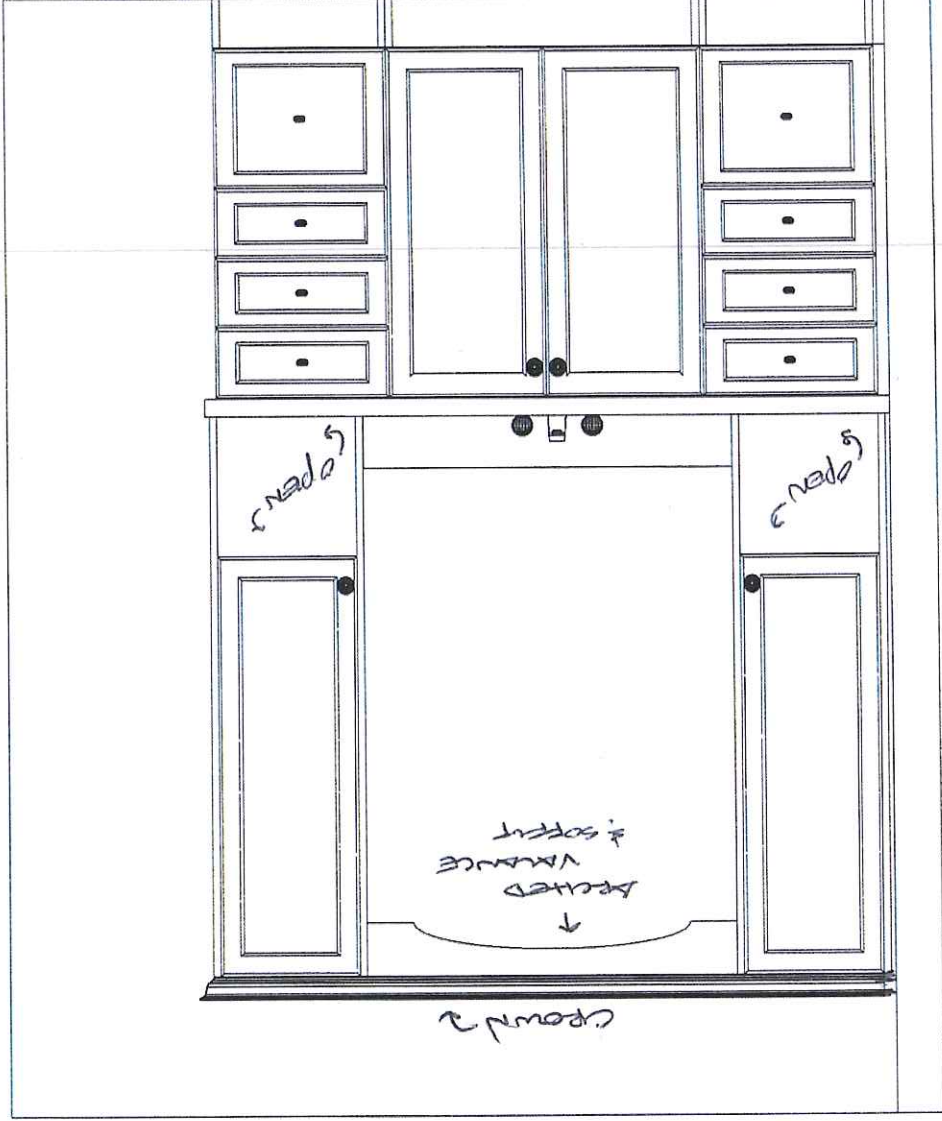

36"