

Signature: *[Signature]*
 Date: *Mar-2/13*
 I have reviewed these drawings and undersand the details of the layout and the Carter Kitchens specifications.

CUSTOMER APPROVAL

Note: This drawing is an artistic interpretation of the general appearance of the design. It is not meant to be an exact rendition.

DESIGNED BY: LORI DISAVERIO.


DCR #64 - SR2 - Kitchen (Custom S1)

2020
 TECHNOLOGIES

[Logo]
 KITCHENS

Designed: 3/11/2012
 Printed: 5/6/2012

Drawing #: 1

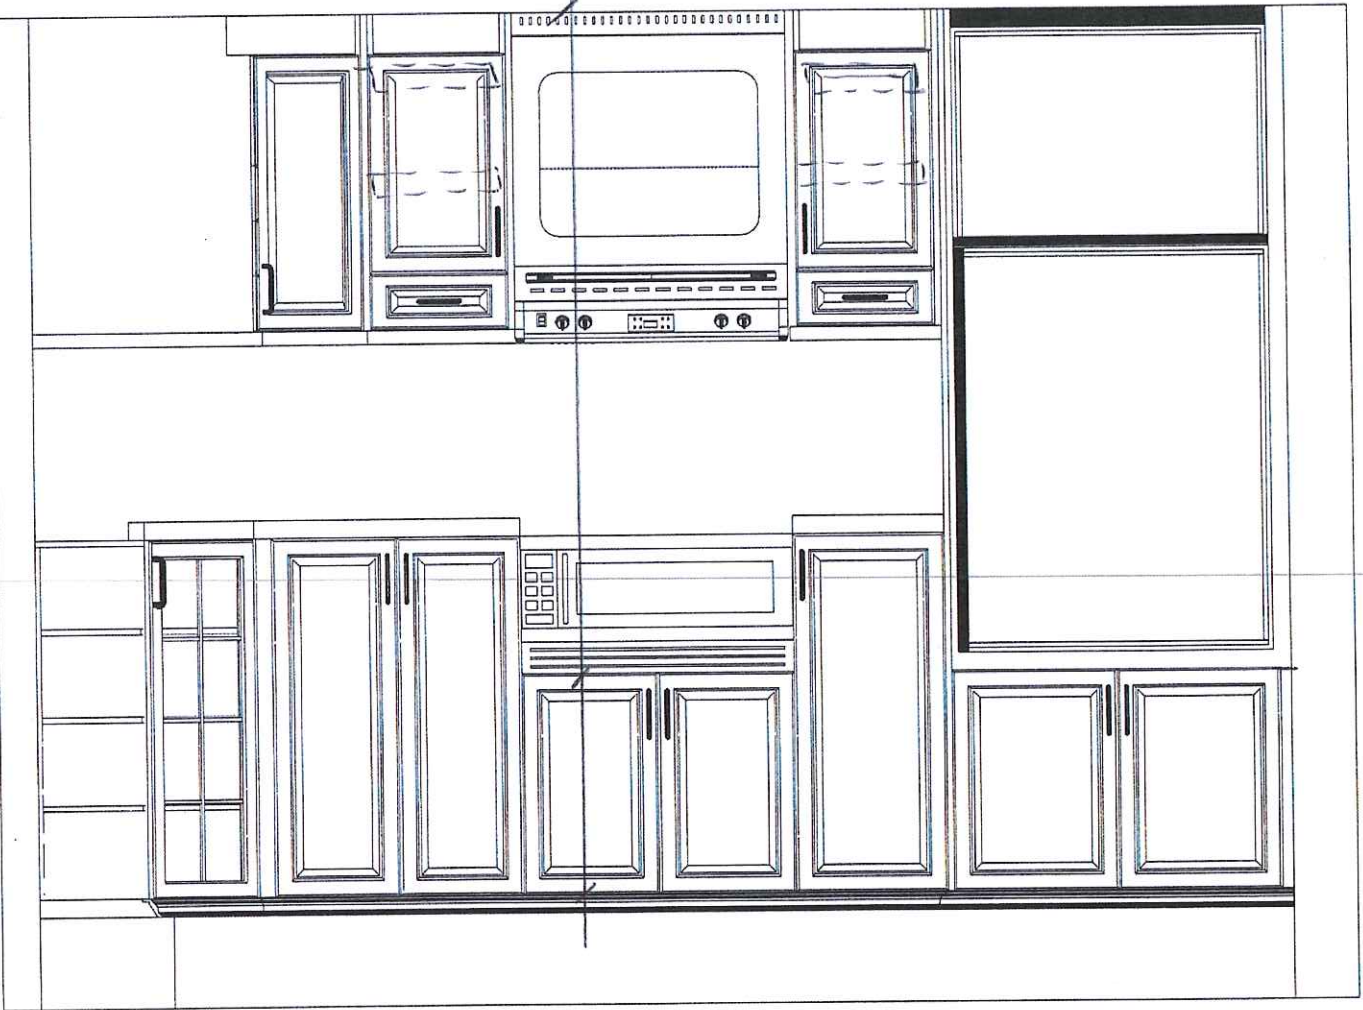

ridge/stove wall elevation

72"

96"

24"

24"

36"

21"

39"

96"

98"

24"

24"

CUSTOMER APPROVAL

I have reviewed these drawings and understand the details of the layout and the Carter Kitchens specifications.

Signature: *[Signature]*

Date: *Mar. 2/13*

DCR #64 - SR2 - Kitchen (Custom S1)

DESIGNED BY: LORI DISAVERIO.

2020 TECHNOLOGIES

all


Printed: 5/6/2012

Designed: 3/11/2012

Drawing #: 1

Note: This drawing is an artistic interpretation of the general appearance of the design. It is not meant to be an exact rendition.

Sink with elevation

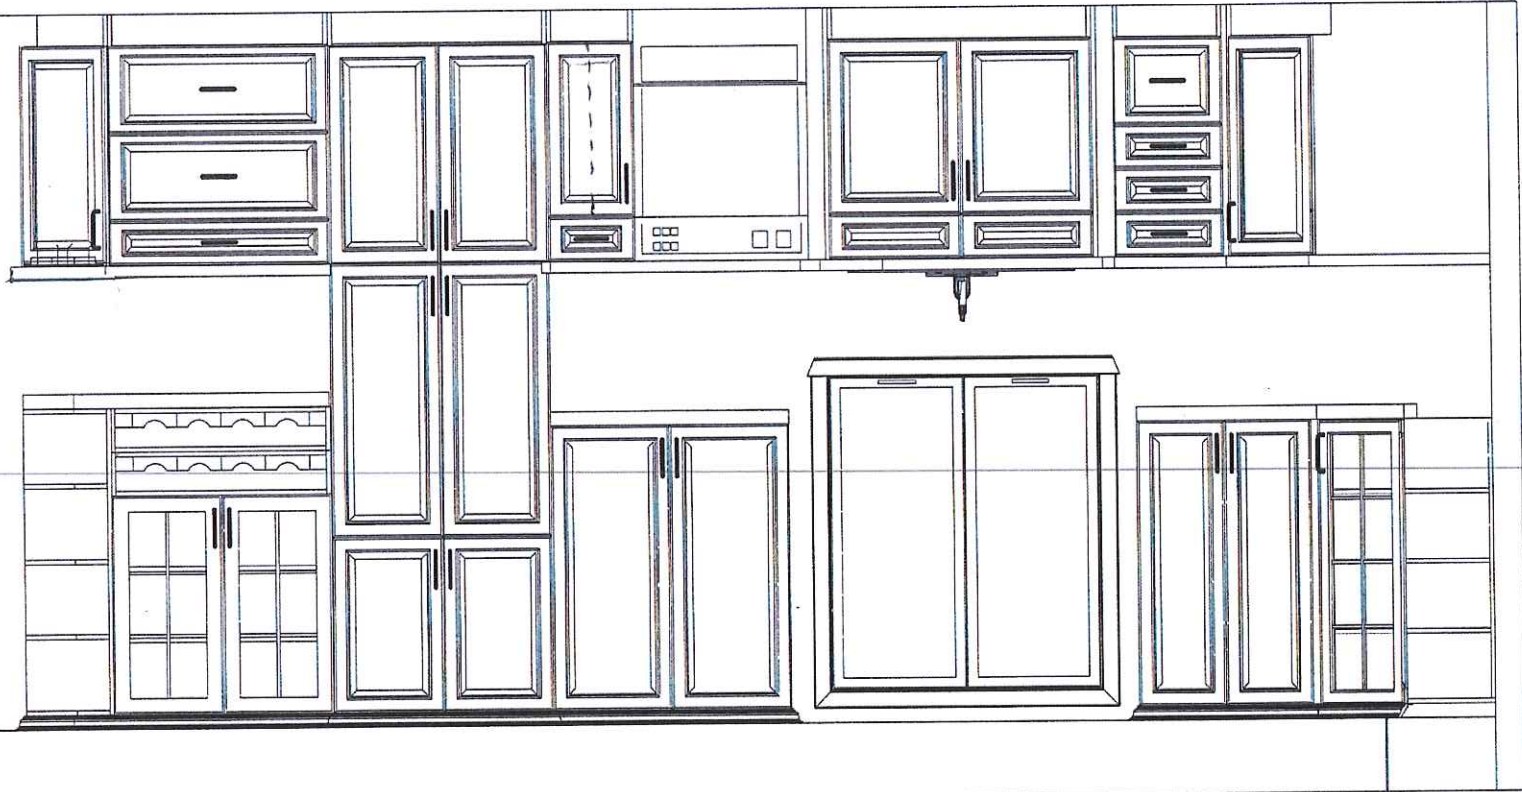


CUSTOMER APPROVAL

I have reviewed these drawings and understand the details of the layout and the Carter Kitchens specifications.

Signature: [Signature]

Date: Mar. 2/13

DCR #64 - SR2 - Kitchen (Custom S1)		DESIGNED BY: LORI DISAVERIO.	
All			
Drawing #: 1		Note: This drawing is an artistic interpretation of the general appearance of the design. It is not meant to be an exact rendition.	
Designed: 3/11/2012		Printed: 5/6/2012	

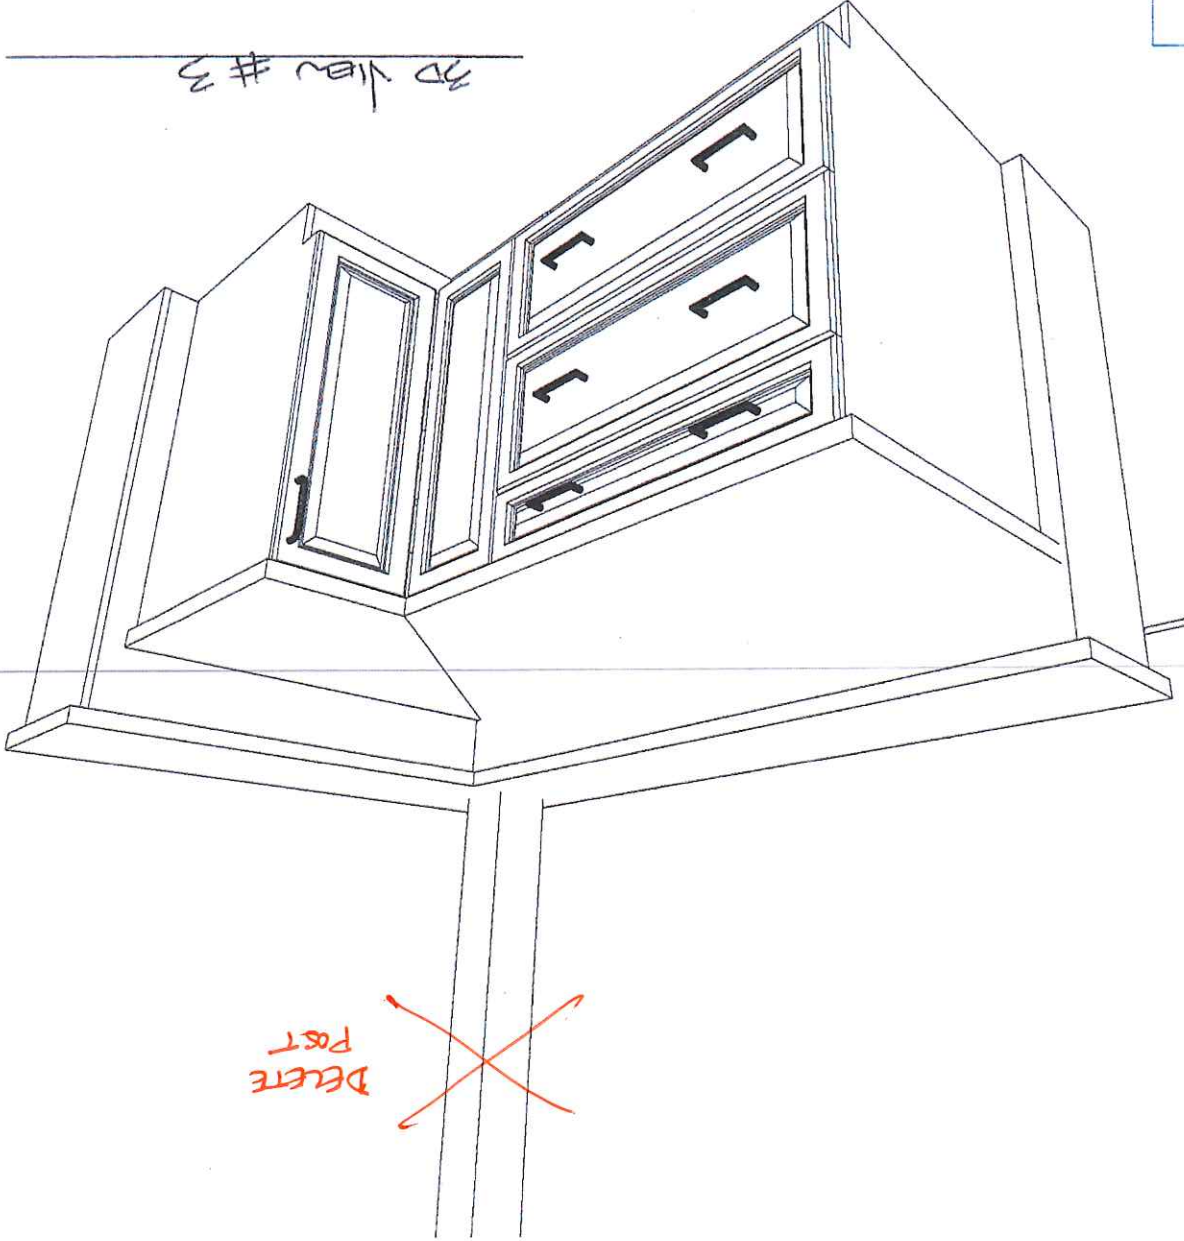


3D View #3

~~DELETE~~

DCR #64 - SR2 - Kitchen (Custom S1)		DESIGNED BY: LORI DISAVERIO.	
All		Note: This drawing is an artistic interpretation of the general appearance of the design. It is not meant to be an exact rendition.	
			
Designed: 3/11/2012		Printed: 5/6/2012	
Drawing #: 1			

Date: Mar. 2/13
 Signature: [Signature]
 I have reviewed these drawings and understand the details of the layout and the Carter Kitchens specifications.
CUSTOMER APPROVAL


3D View #1

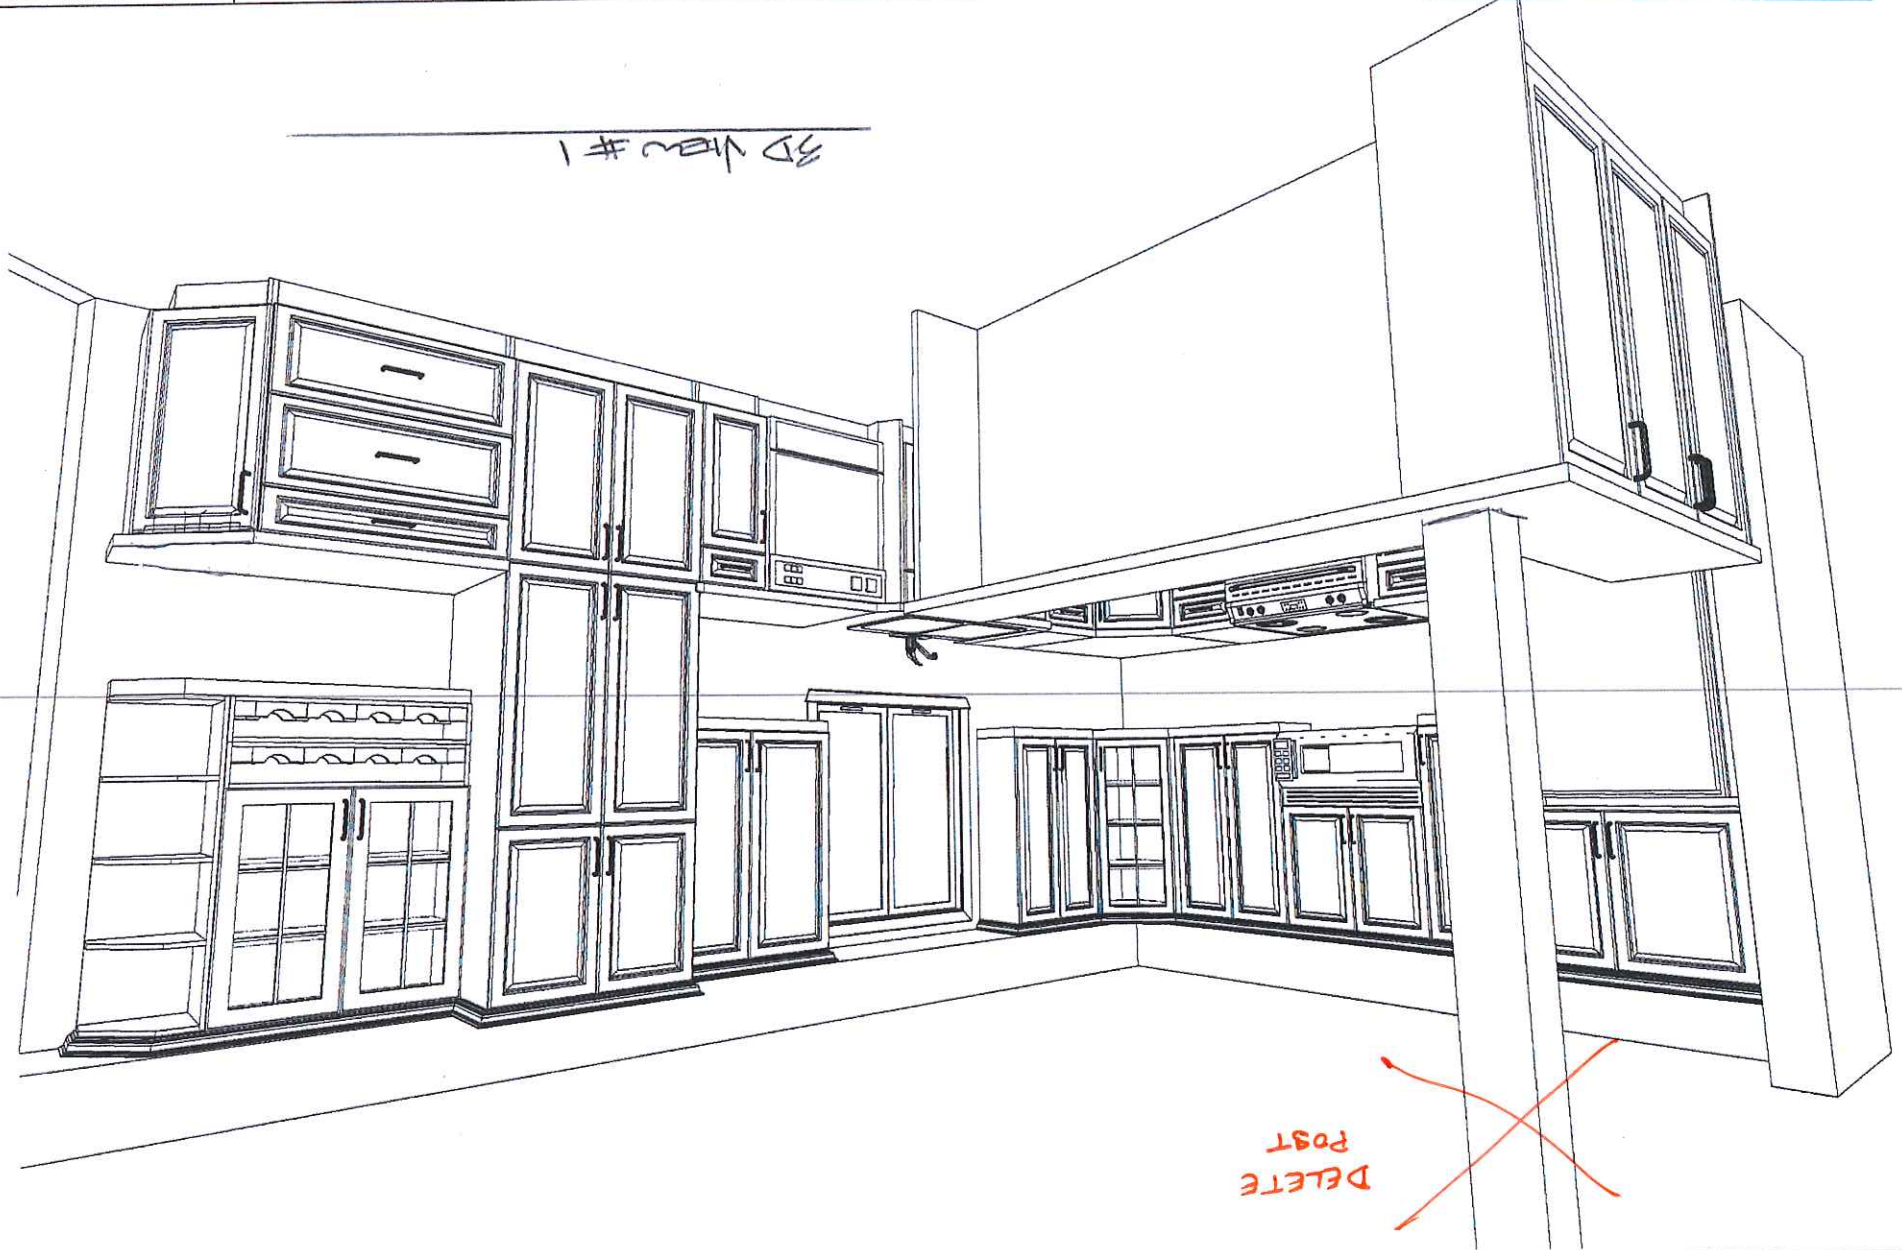

DELETE

CUSTOMER APPROVAL

I have reviewed these drawings and unders; and the details of the layout and the Carter Kitchens specifications.

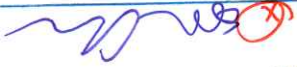Signature:  Date: Mar. 2/13

DCR #64 - SR2 - Kitchen (Custom S1)

DESIGNED BY: LORI DISAVERIO.

Note: This drawing is an artistic interpretation of the general appearance of the design. It is not meant to be an exact rendition.

2020 TECHNOLOGIES KITCHENS

Printed: 5/6/2012

Designed: 3/11/2012

All

Drawing #: 1

