


NOTE:
ROOF TRUSS INFORMATION REFER TO ROOF
TRUSS SHOP DRAWINGS FOR ALL ROOF FRAMING
INFORMATION UNLESS OTHERWISE NOTED.

NOTE: ROOF FRAMING INFORMATION
ALL LAMINATED VENEER LUMBER (LVL) BEAMS, BUILT-UP BEAMS, GIRDER TRUSSES AND METAL HANGER CONNECTIONS SUPPORTING ROOF FRAMING TO BE DESIGNED AND CERTIFIED BY ROOF TRUSS MANUFACTURER. REFER TO ROOF TRUSS SHOP DRAWINGS FOR ALL ROOF FRAMING INFORMATION UNLESS OTHERWISE NOTED ON ARCHITECTURAL DRAWINGS.




		PHOENIX HOMES	
Viljoen Architect Inc. 300 A. Wilson Avenue North York, Ontario M3H 1S8 TEL: (416) 630-2255 FAX: (416) 630-4782			
GREGORIAN-2007-A		SITE: SHADOW RIDGE 2	
LOT NUMBER: 64		CIVIC ADDRESS: 6535 WATERDOWN ST	
2 REV. AS PER CONST. SUMMARY			
2 REV. AS PER CONST. SUMMARY		MAY22-13	
1 REV. AS PER CONST. SUMMARY		JAN10-13	
No.		Description	
By		Date	
REVISIONS			

Footprint:	S1-A		
shl. title:	SECOND FLOOR-A		
drawn by:	GL		
checked by:	OF		
date:	FEB. 2007		
scale:	3/16"=1'		
sheet no:	3A 6		

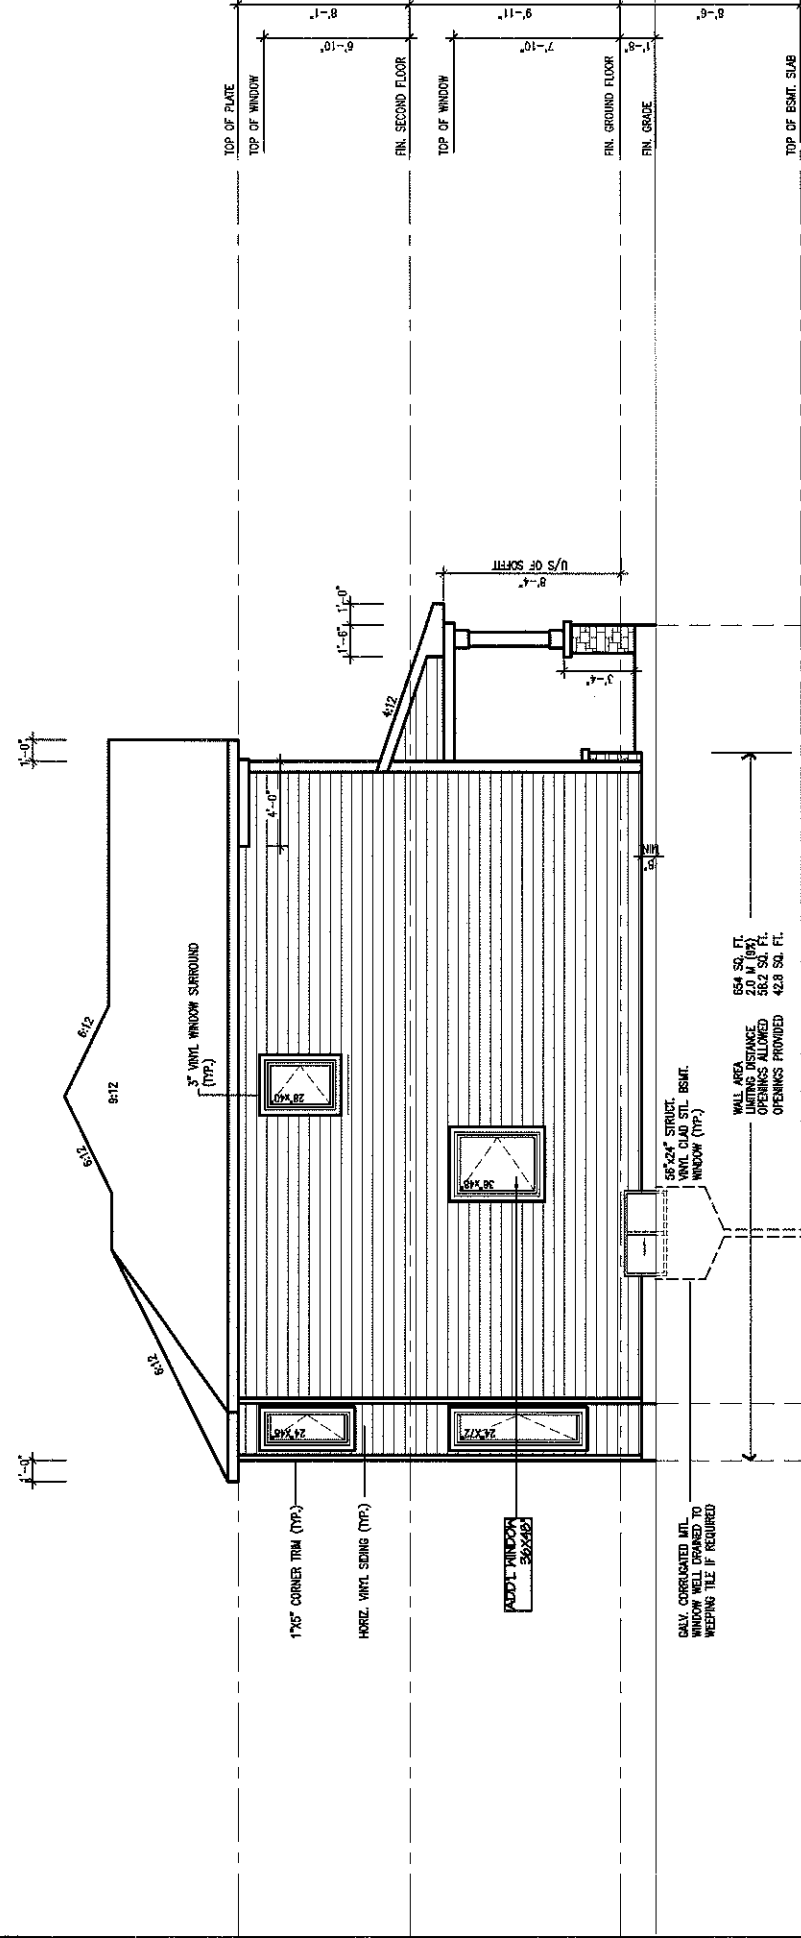

LEFT ELEVATION 'A'


NOTE:
REFER TO FRONT ELEVATION FOR TYPICAL
NOTES & INFORMATION

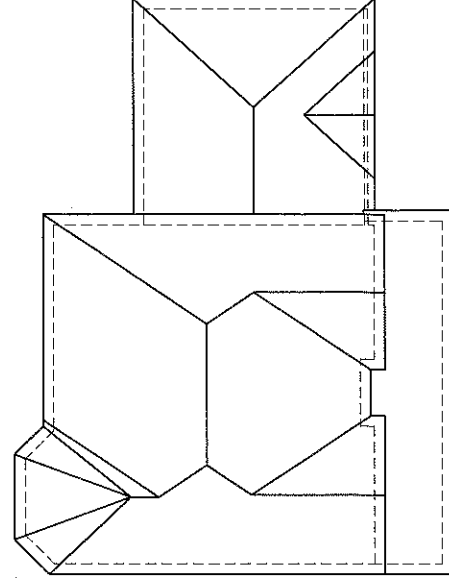

ROOF PLAN 'A'
N.T.S.



FRONT ELEVATION 'A' (SIDING W/ STONE BASE)

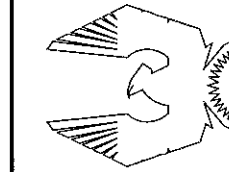

PHOENIX HOMES

Viljoen
Architect
Inc.

300 A. Wilson Avenue
North York, Ontario
M3H 1S8
TEL: (416) 630-2255
FAX: (416) 630-4782

GREGORIAN-2007-A

SITE: SHADOW RIDGE 2

LOT NUMBER:

64

CIVIC ADDRESS:
6535 WATERDOWN ST

Footprint: SI-A

Shit. title: ELEVATIONS-A

drawn by: CL

checked by: OF

date: FEB. 2007

scale: 1/8"=1'

sheet no:


4A
6

2 REV. AS PER CONST. SUMMARY MAY22-13 SD

1 REV. AS PER CONST. SUMMARY JAN10-13 SD


No. Description Date By

REVISIONS

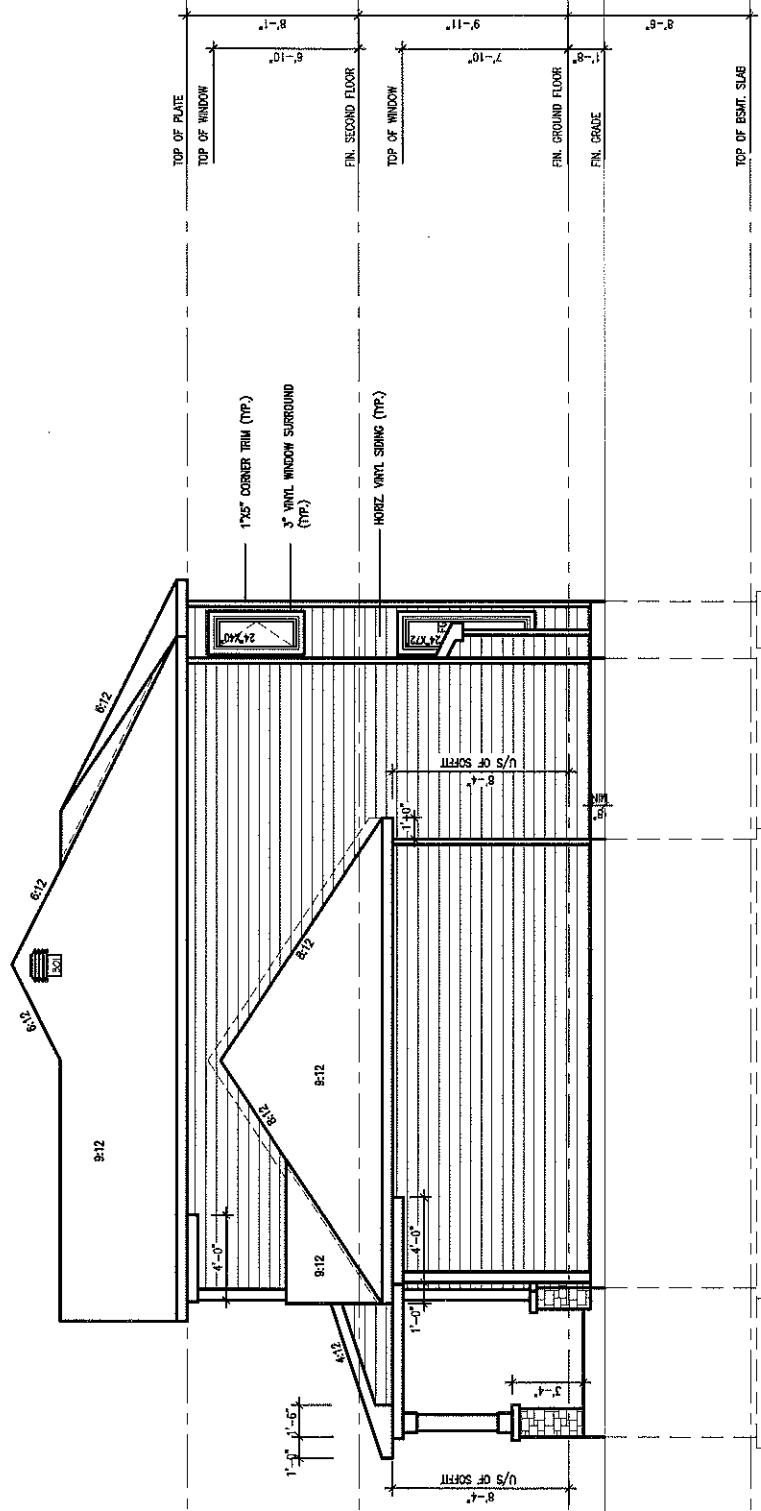


RIGHT ELEVATION 'A'

NOTE:
REFER TO FRONT ELEVATION FOR TYPICAL
NOTES & INFORMATION

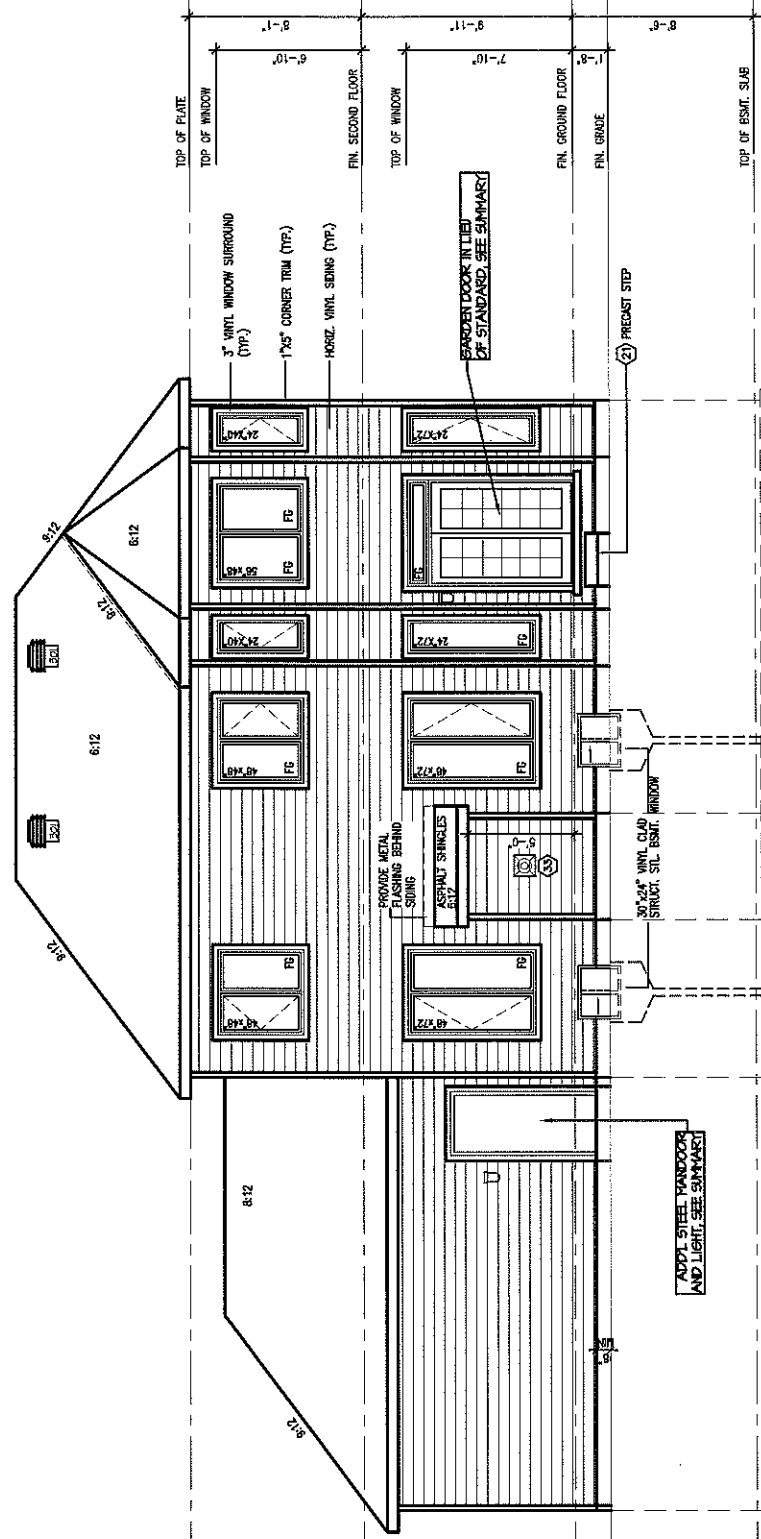

REAR ELEVATION 'A'

NOTE:
REFER TO FRONT ELEVATION FOR TYPICAL
NOTES & INFORMATION

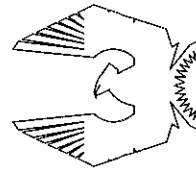

PHOENIX HOMES

Viljoen
Architect
Inc.

300 A Wilson Avenue
North York, Ontario
M3H 1S8
TEL: (416) 630-2255
FAX: (416) 630-4782

GREGORIAN-2007-A

SITE: SHADOW RIDGE 2

LOT NUMBER:

64

CIVIC ADDRESS:
6535 WATERDOWN ST

Footprint: S1-A

shl. title: ELEVATIONS-A

drawn by: CL

checked by: OF

date: FEB. 2007

scale: 1/8" = 1'

sheet no:

5A
6

2 REV. AS PER CONST. SUMMARY MAY22-13 SD


1 REV. AS PER CONST. SUMMARY JAN10-13 SD

No. Description

Date

By

REVISIONS

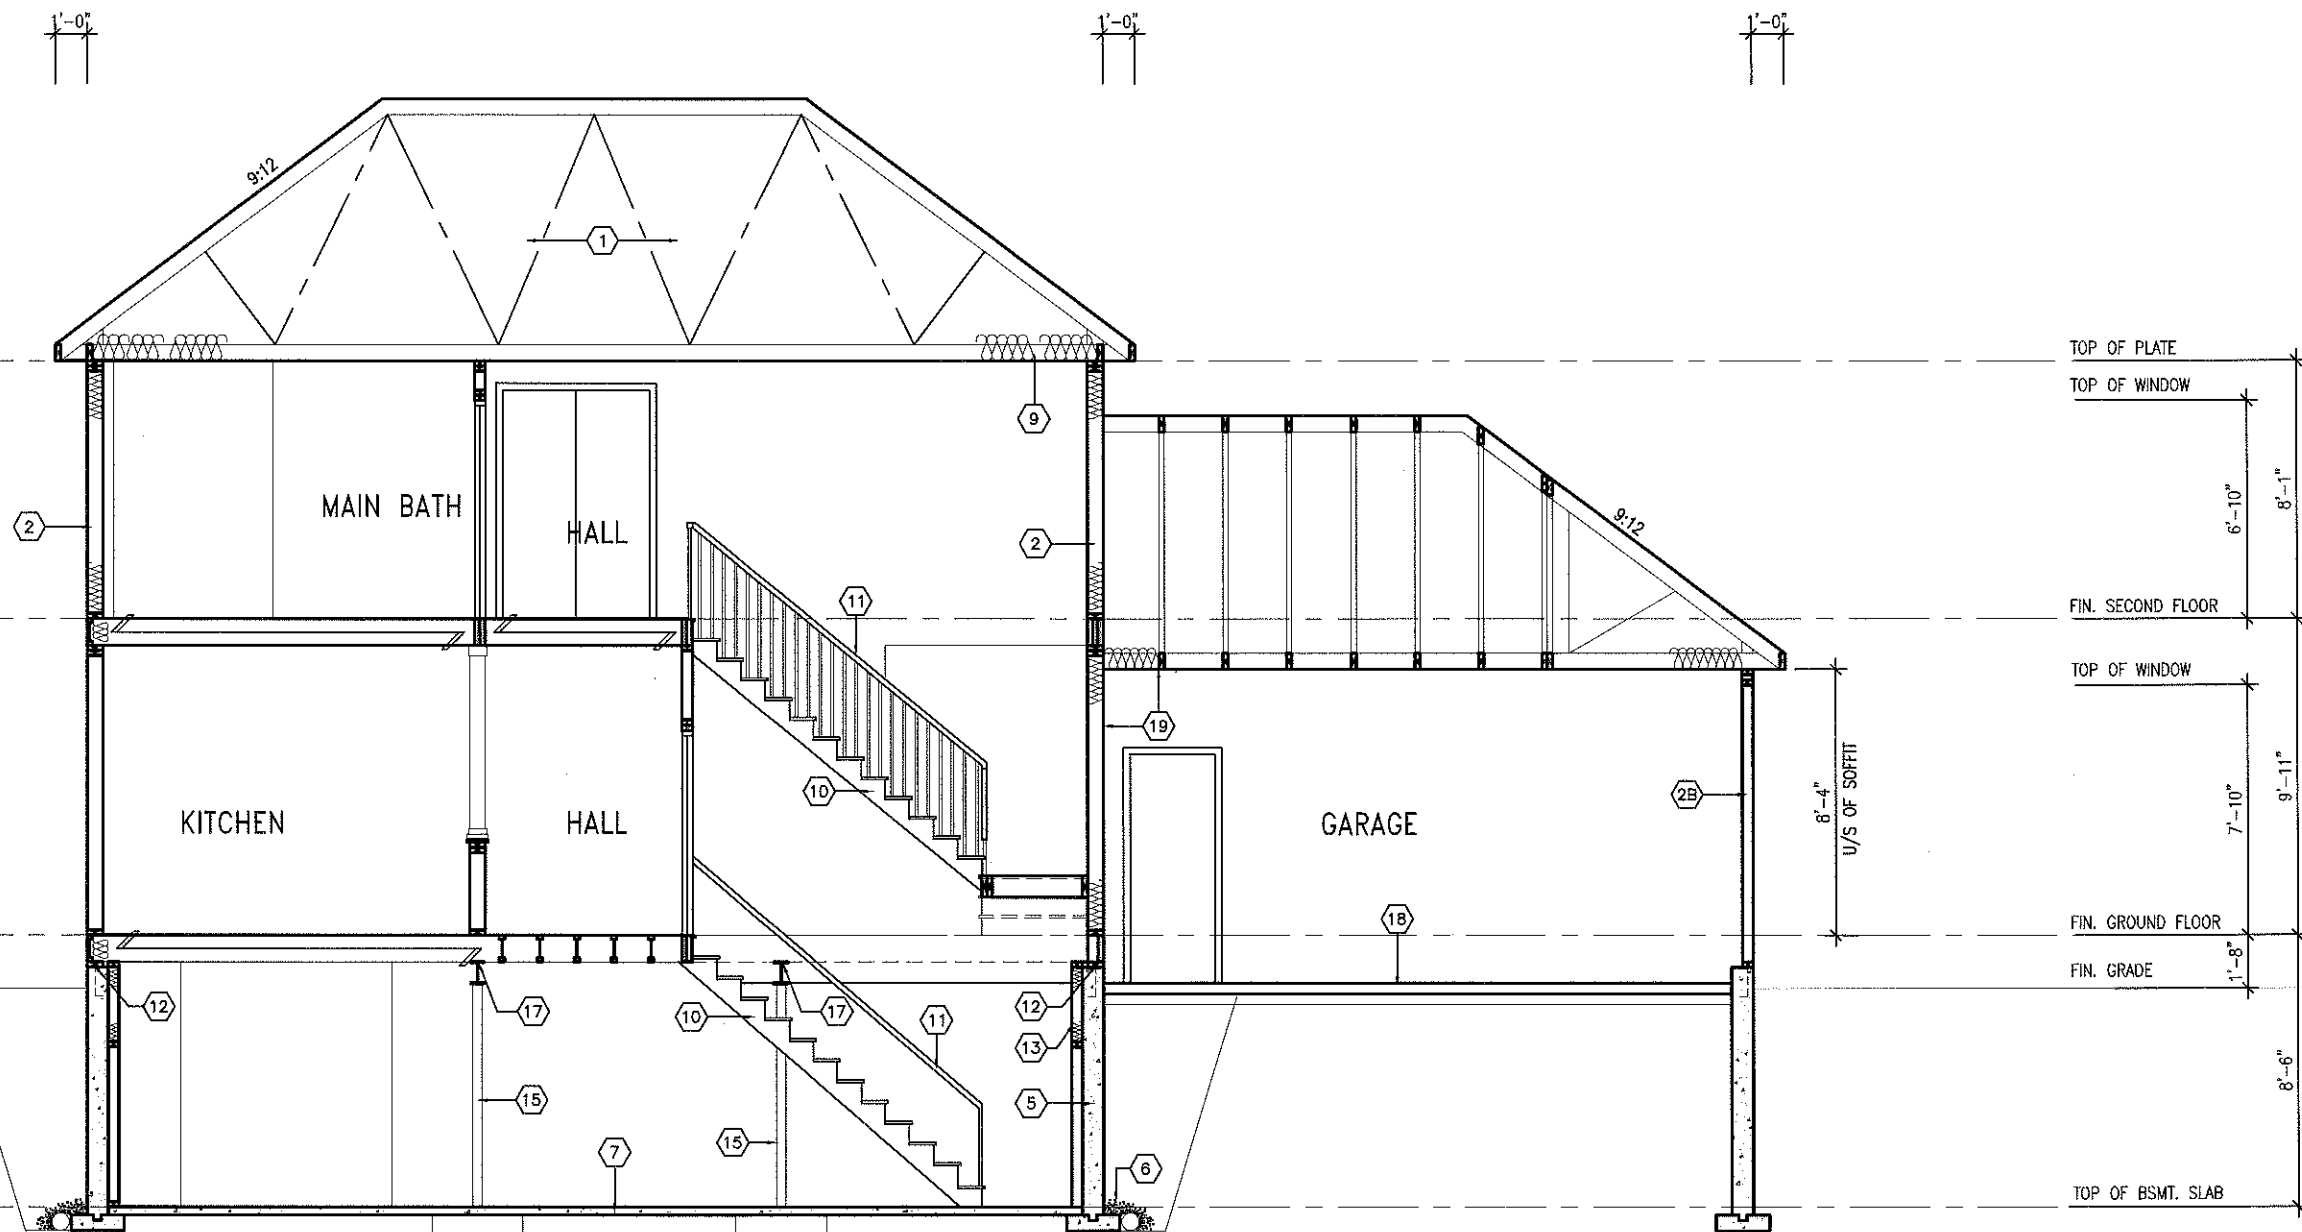

SECTION A-A



**Viljoen
Architect
Inc.**

300 A. Wilson Avenue
North York, Ontario
M3H 1S8
TEL: (416) 630-2255
FAX: (416) 630-4782

GREGORIAN-2007-A

SITE: SHADOW RIDGE 2

LOT NUMBER:

64

CIVIC ADDRESS:
6535 WATERDOWN ST

2	REV. AS PER CONST. SUMMARY	MAY22-13	SD
1	REV. AS PER CONST. SUMMARY	JAN10-13	SD
No.	Description	Date	By
REVISIONS			

Footprint: **SI-A**

sht. title: SECTION

drawn by: CL

checked by: OF

date: FEB. 2007

scale: 3/16"=1'

sheet no:

6
6