

CUSTOMER APPROVAL

I have reviewed these drawings and understand the details of the layout and the Carter Kitchens specifications.

Signature: *Jim MM*

Date: Aug. 14/13

DCR #69 SR2 - 508 Chesapeake - opt 2

DRAWN BY: LORI DISAVERIO, B.L.D

2020 TECHNOLOGIES

Printed: 6/27/2013

Designed: 7/1/2012


2020 KITCHENS

All

Drawing #: 1

Note: This drawing is an artistic interpretation of the general appearance of the design. It is not meant to be an exact rendition.

Budget max - 31215
REV. JUNE 27/13

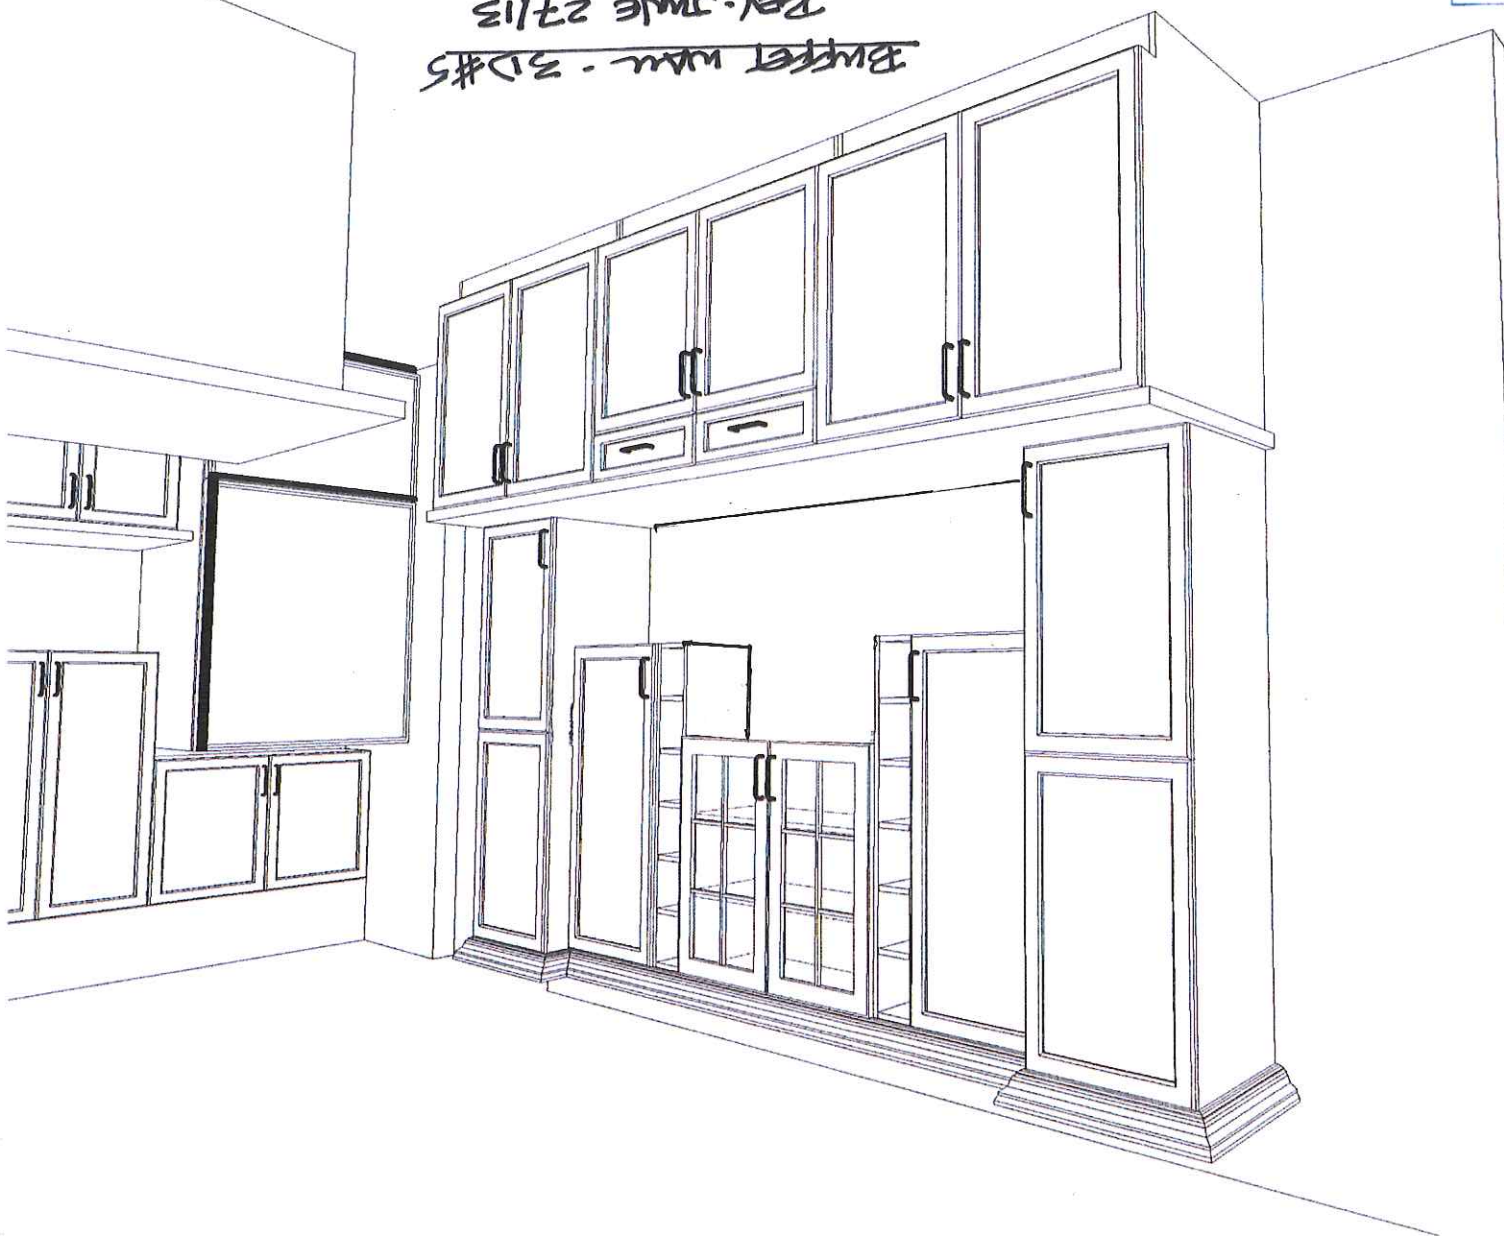

CUSTOMER APPROVAL

I have reviewed these drawings and understand the details of the layout, and the Carlier Kitchens specifications.

Signature: *[Signature]*

Date: Aug. 14/13

BRIDGE/STONE W/AN ELEVATION - Per. DATE 27/13



Note: This drawing is an artistic interpretation of the general appearance of the design. It is not meant to be an exact rendition.

DRAWN BY: LORI DISAVERIO, B.L.D

DCR #69 SR2 - 508 Chesapeake - opt 2

2020 TECHNOLOGIES

Printed: 6/27/2013

Designed: 7/1/2012

Drawing #: 1

CUSTOMER APPROVAL

I have reviewed these drawings and understand the details of the layout and the Carter Kitchens specifications.

Signature: *fm* *mm*

Date: *Aug. 14/13*

Note: This drawing is an artistic interpretation of the general appearance of the design. It is not meant to be an exact rendition.

DRAWN BY: LORI DISAVERIO, B.L.D.


DCR #69 SR2 - 508 Chesapeake - opt 2

2020 TECHNOLOGIES

ARCHES

Designed: 7/1/2012
Printed: 6/27/2013

Drawing #: 1

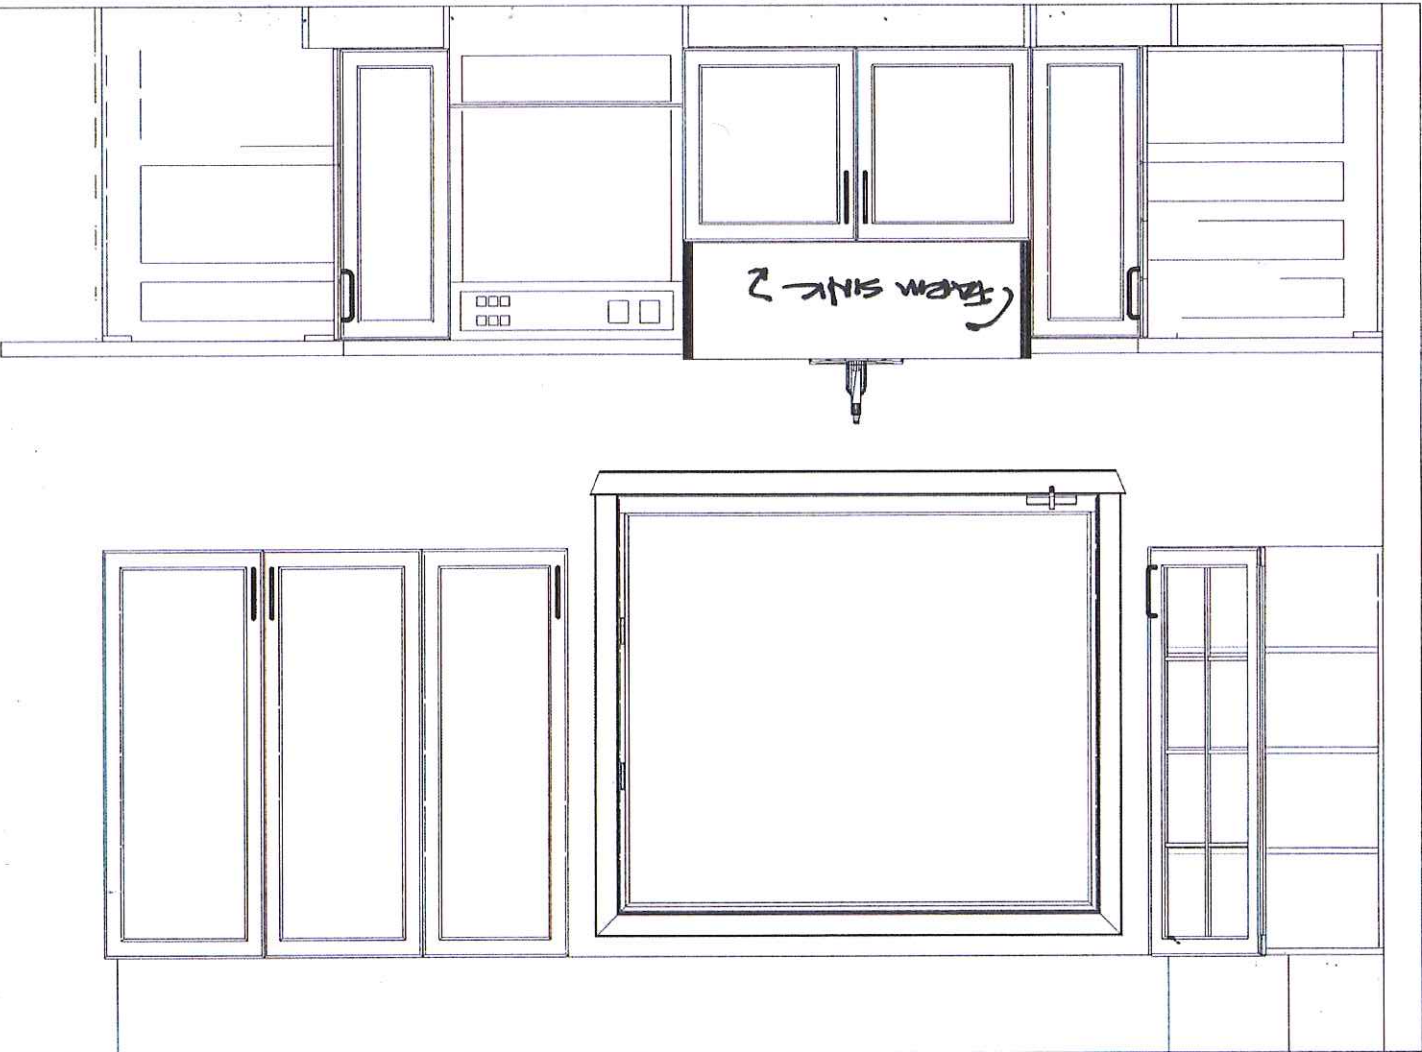


sink with elevation - per. 7/27/13

98"
36"
20"
42"

Date: Aug. 14/13
 Signature: [Signature]
 I have reviewed these drawings and understand the details of the layout and the Carter Kitchens specifications.
 CUSTOMER APPROVAL

Drawing #: 1
 All
 DCR #69 SR2 - 508 Chesapeake - opt 2
 DRAWN BY: LORI DISAVERIO, B.I.D.
 Note: This drawing is an artistic interpretation of the general appearance of the design. It is not meant to be an exact rendition.
 2020 TECHNOLOGIES
 Printed: 6/27/2013
 Designed: 7/1/2012

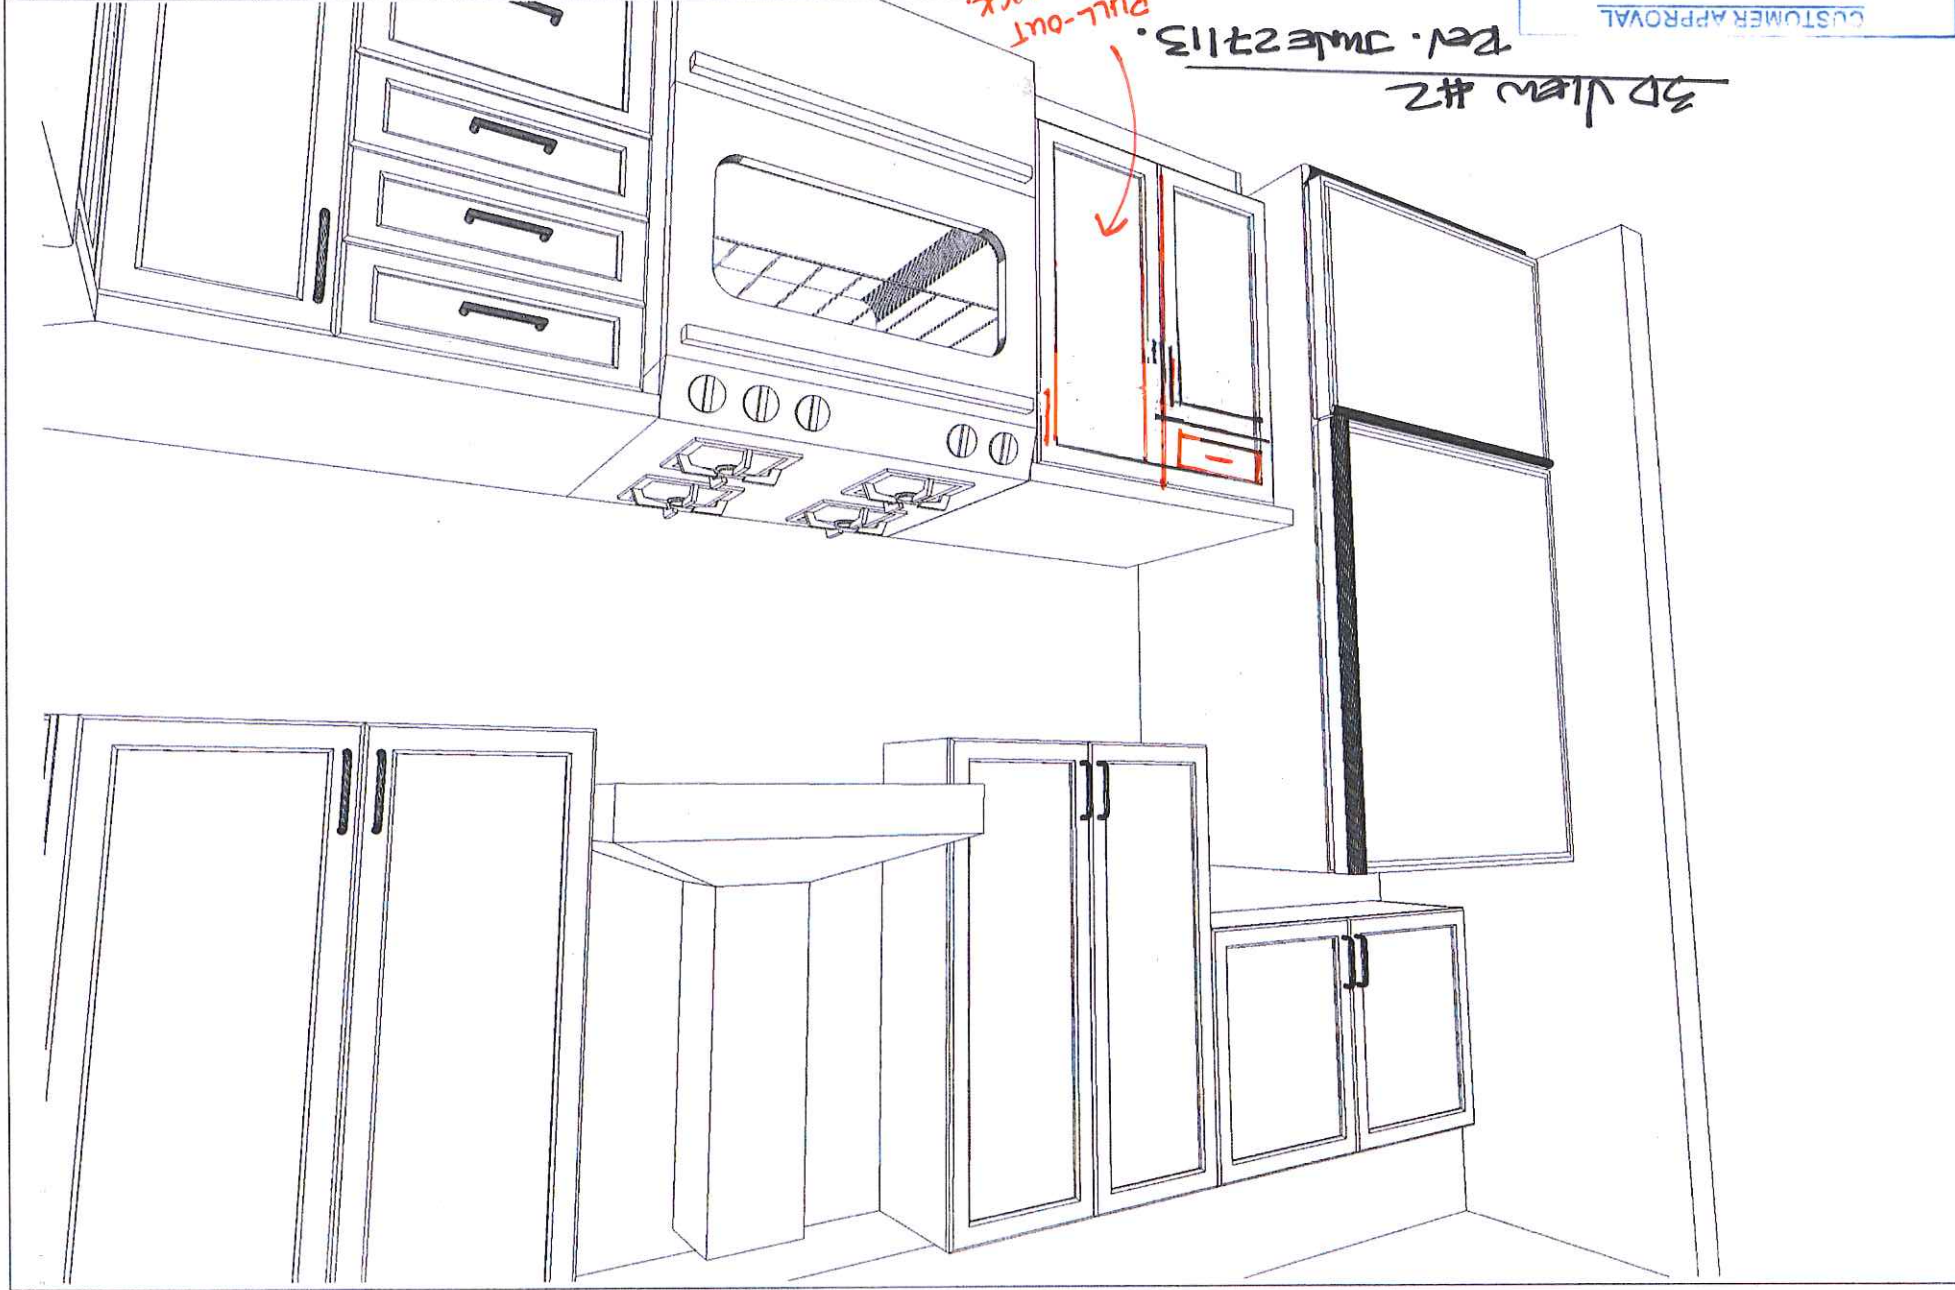

CUSTOMER APPROVAL

I have reviewed these drawings and understand the details of the layout and the Carter Kitchens specifications.

Signature: *[Signature]* *[Signature]*

Date: Aug. 14/13

DCR #69 SR2 - 508 Chesapeake - opt 2

DRAWN BY: LORI DISAVERIO, B.L.D

2020 TECHNOLOGIES

Printed: 6/27/2013

Designed: 7/1/2012

Drawing #: 1

All

Note: This drawing is an artistic interpretation of the general appearance of the design. It is not meant to be an exact rendition.

BURGER PLAN Elevation - Rev. July 27/13

