

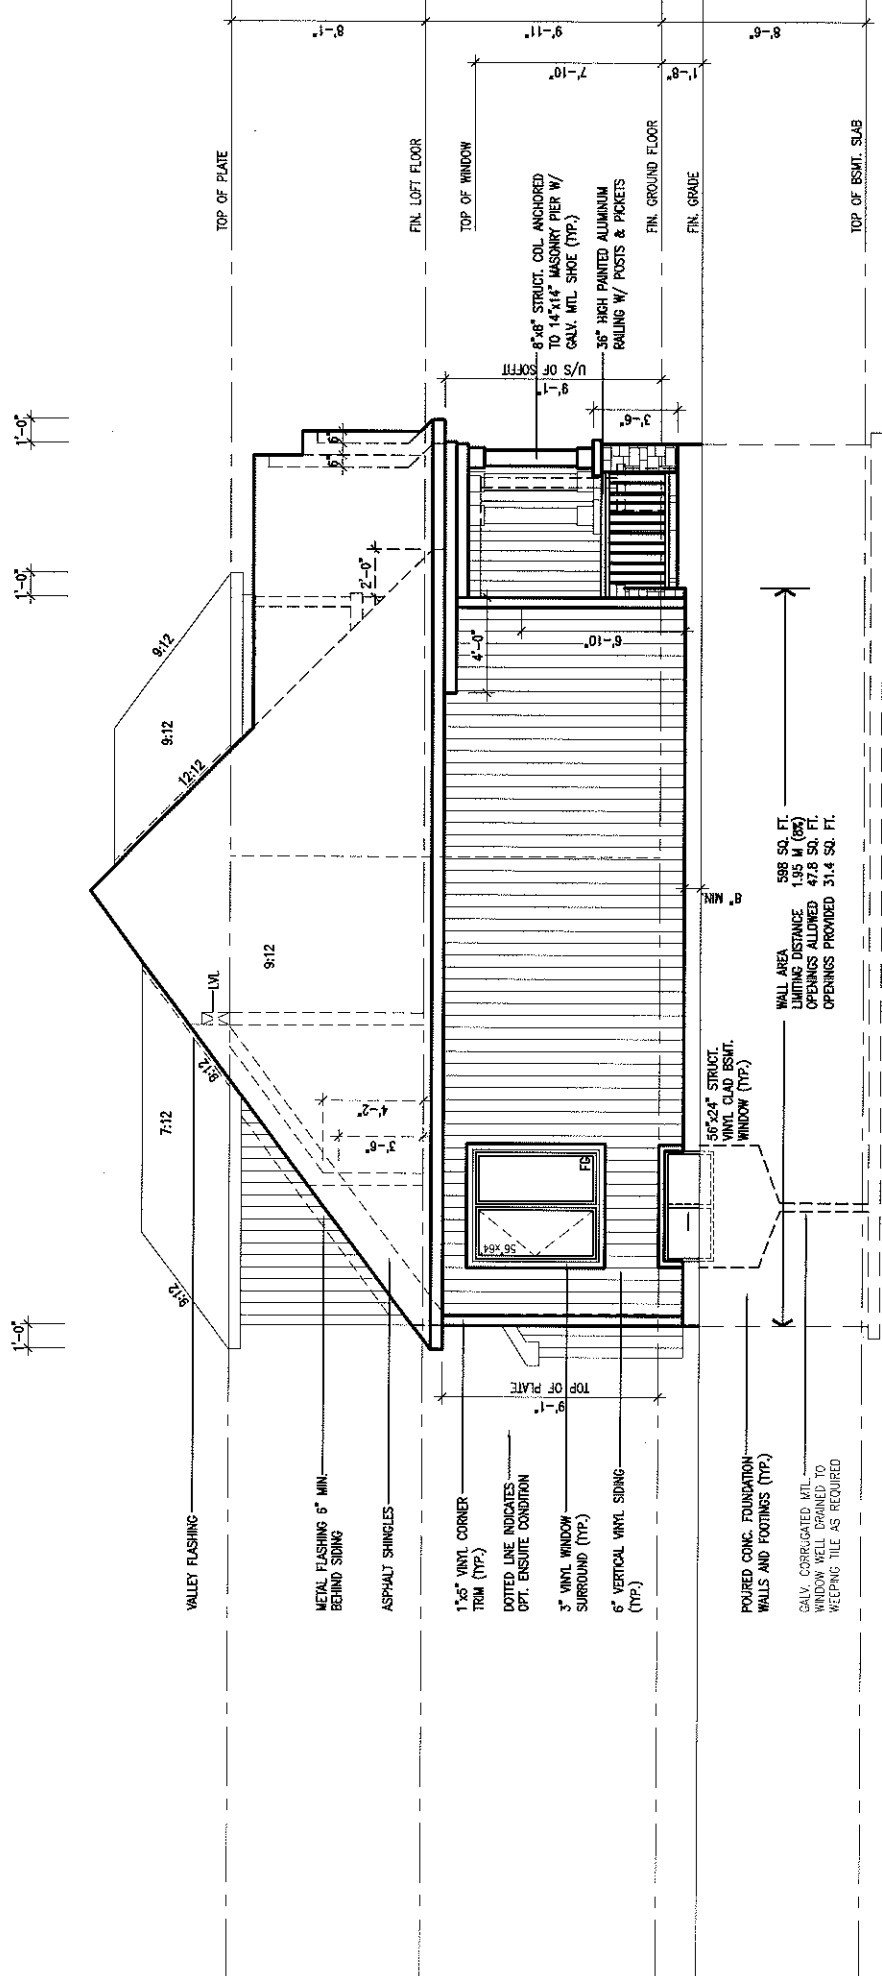


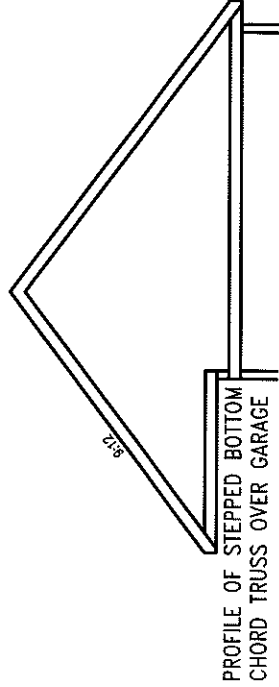


LEFT SIDE ELEVATION 'A'

NOTE: REFER TO FRONT ELEVATION FOR TYPICAL NOTE INFORMATION

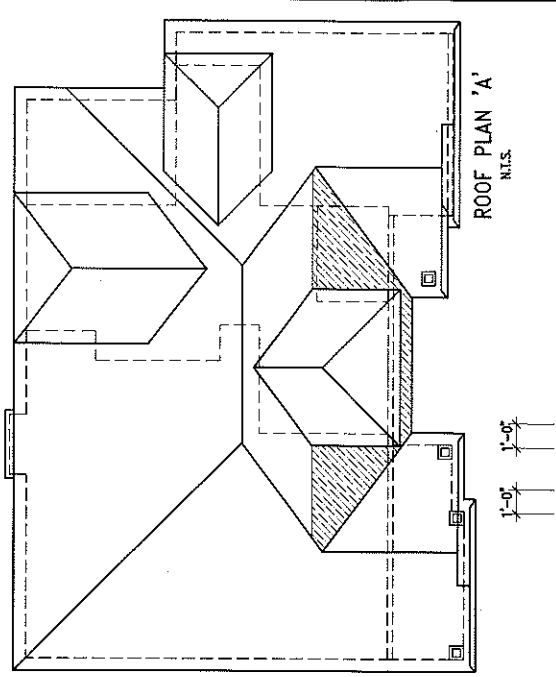


PROFILE OF STEPPED BOTTOM CHORD TRUSS OVER GARAGE

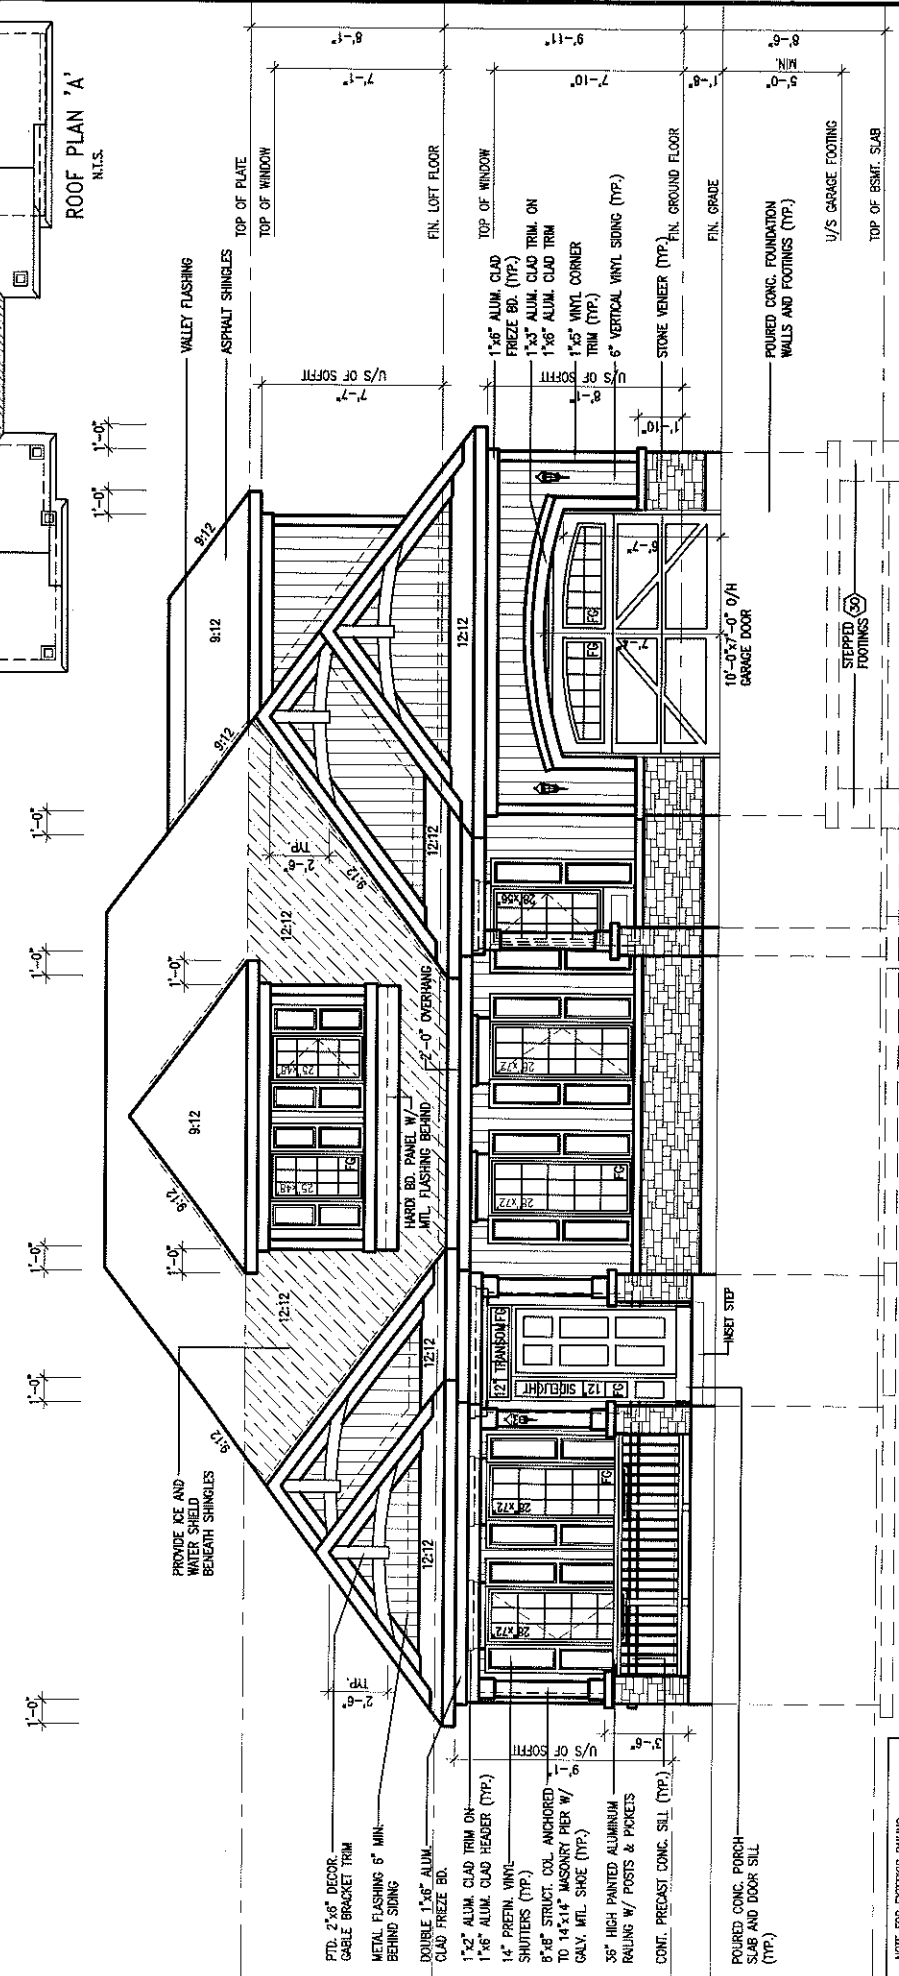

FRONT ELEVATION 'A' (SIDING W/ STONE BASE)

NOTE: FOR EXTERIOR DRILLING, 3/8" HRS WHERE DISTANCE EXCEEDS 2'-0" 4/2" HRS WHERE DISTANCE EXCEEDS 9'-11"

LOFT

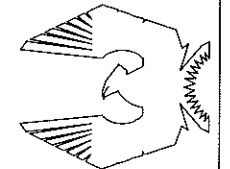

PHOENIX HOMES

Viljoen Architect Inc.

300 A Wilson Avenue
North York, Ontario
M3H 1S8
TEL: (416) 630-2255
FAX: (416) 630-4782

B5-A EQUINOX


SITE: SHADOW RIDGE2

LOT NUMBER: 70

CIVIC ADDRESS:
6547 WATERDOWN ST.


No.	Description	Date	By
2	REV. AS PER CONST. SUMMARY	JUNE28-12	SD
1	ISSUED FOR FOUNDATION ONLY	JUNE14-12	SD

Footprint: B-5A	Sheet title: ELEVATIONS-A
Drawn by: N	Checked by:
Date: JUNE 2007	Scale: 1/8"=1'
Sheet no: 4A	6

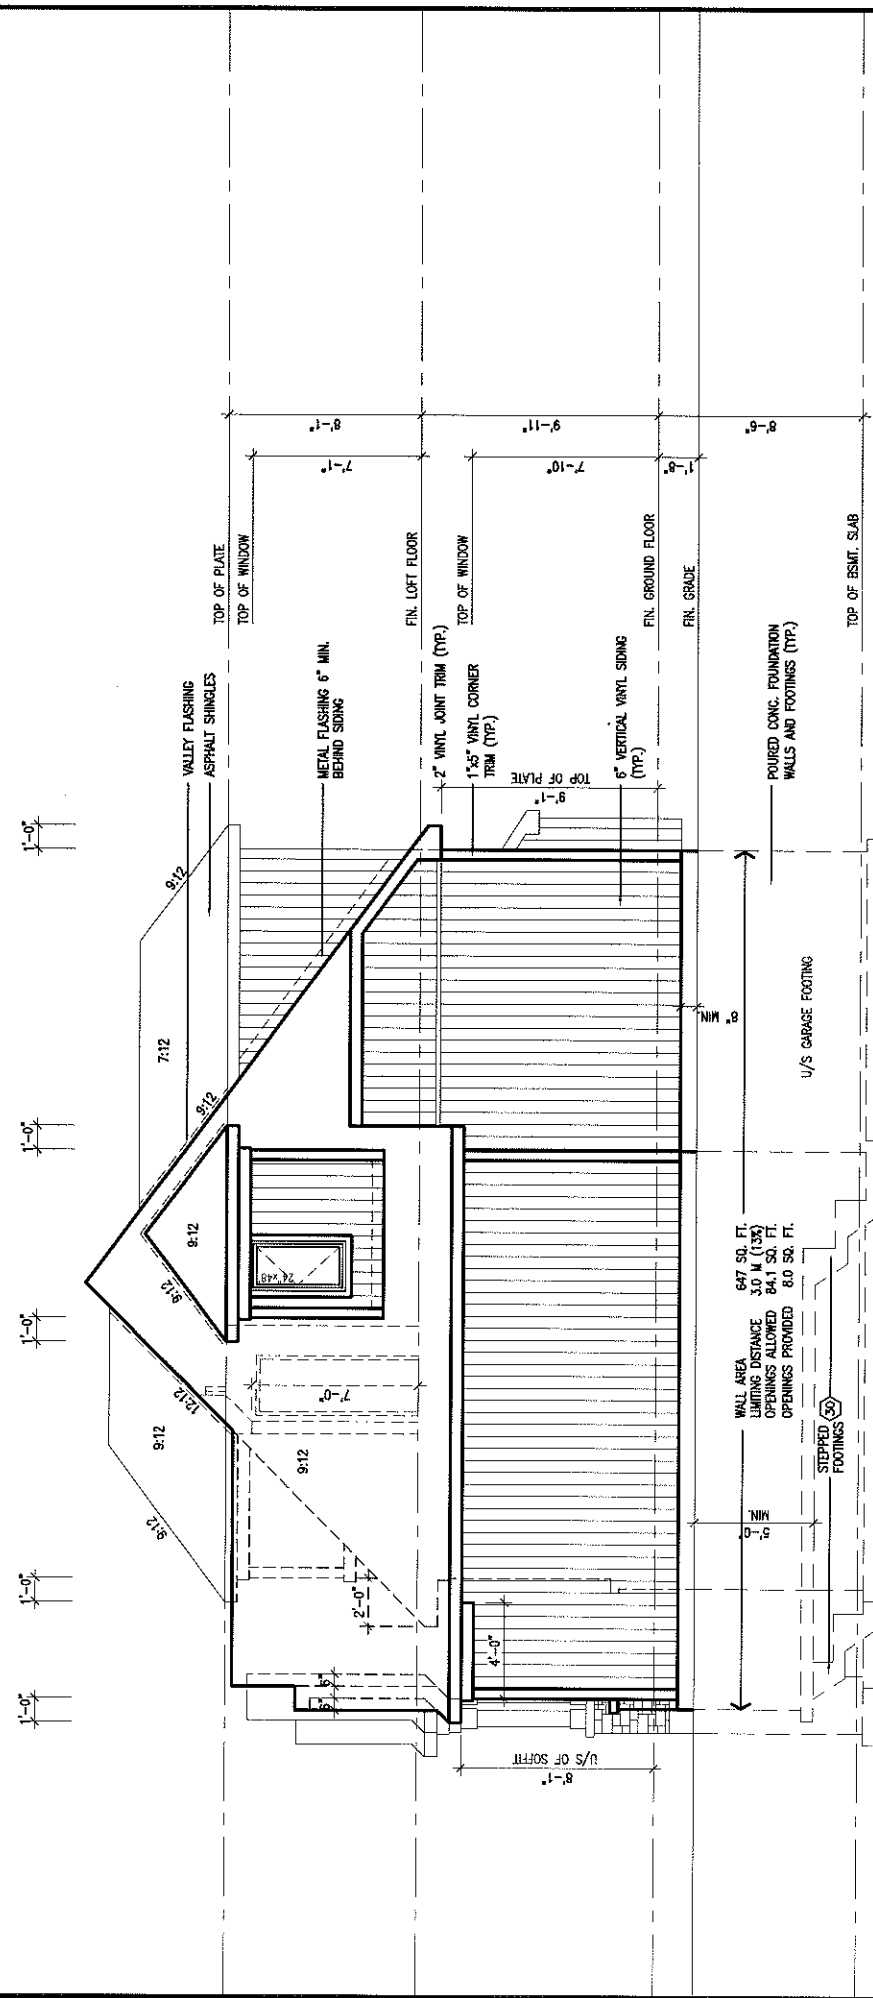

RIGHT SIDE ELEVATION 'A'


NOTE: REFER TO FRONT ELEVATION FOR TYPICAL INFORMATION

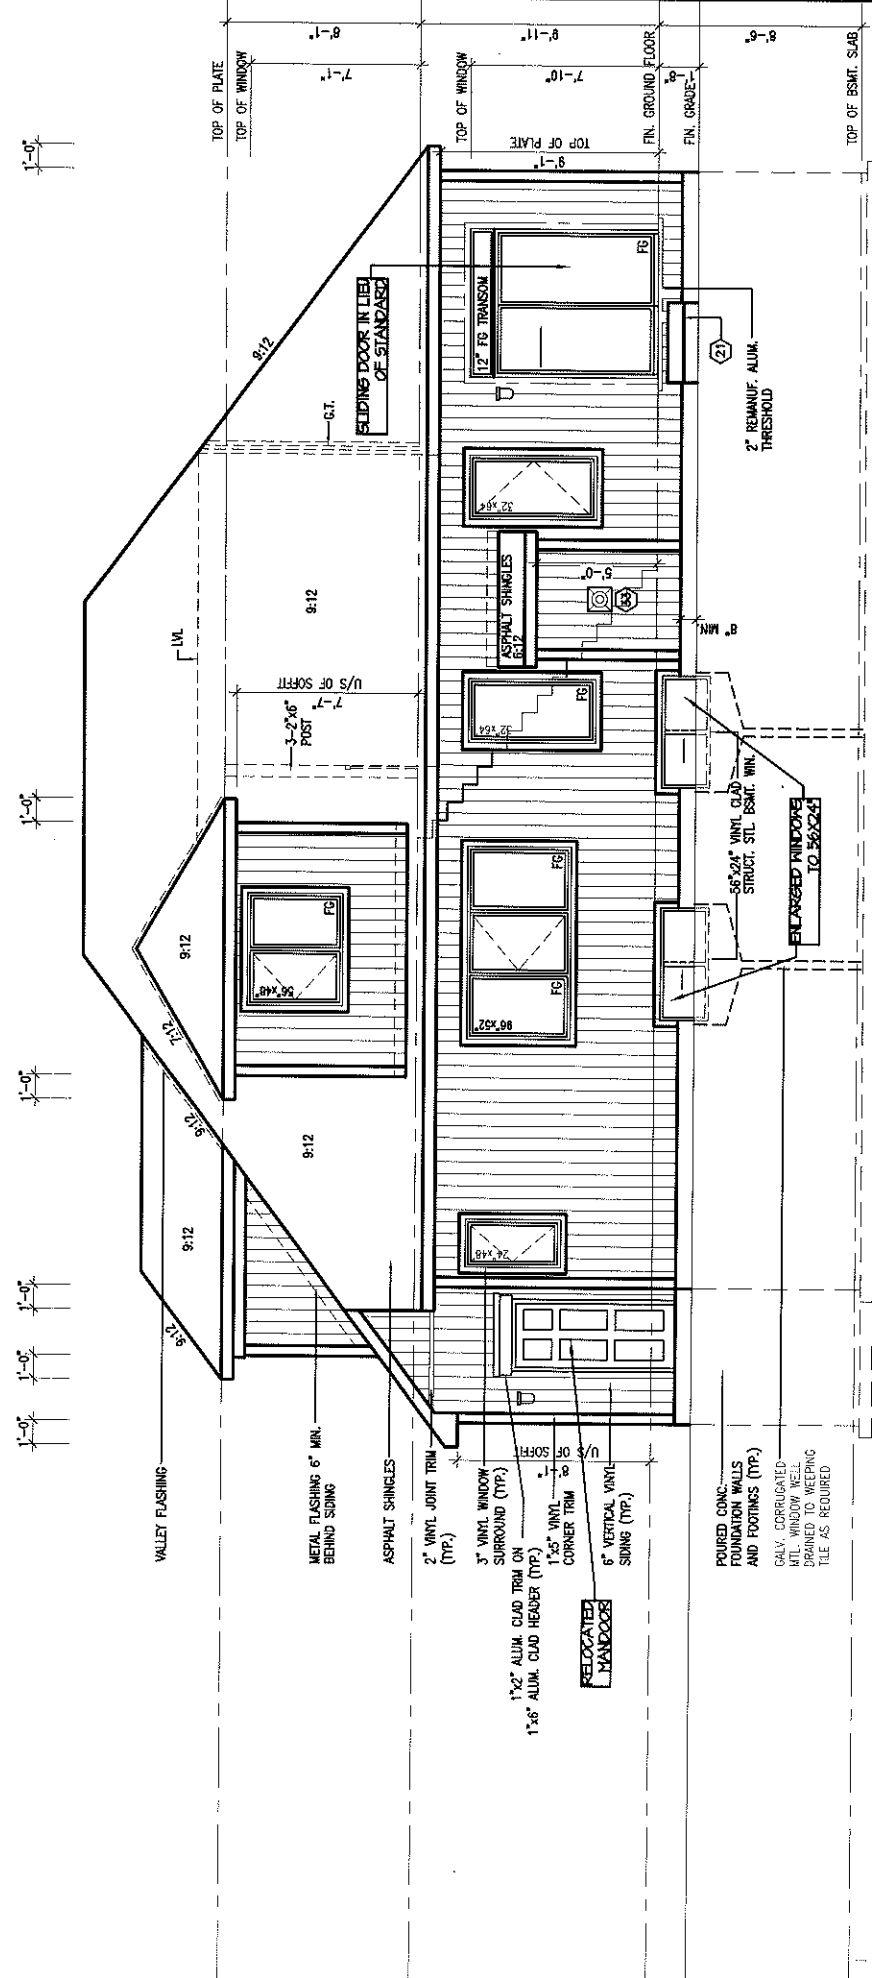

REAR ELEVATION 'A'

NOTE: REFER TO FRONT ELEVATION FOR TYPICAL INFORMATION

LOFT

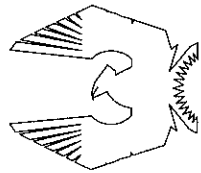

PHOENIX HOMES

Viljoen Architect Inc.

300 A Wilson Avenue
North York, Ontario
M3H 1S8
TEL: (416) 630-2255
FAX: (416) 630-4782

B5-A EQUINOX

SITE: SHADOW RIDGE2

LOT NUMBER:

70

CIVIC ADDRESS:
6541 WATERDOWN ST.

footprint: B-5A
sh. title: ELEVATIONS-A
drawn by: N
checked by:
date: JUNE 2007
scale: 1/8"=1'
sheet no:
5A
6

No.	Description	Date	By
2	REV. AS PER CONST. SUMMARY	JUNE28-12	SD
1	ISSUED FOR FOUNDATION ONLY	JUNE14-12	SD

