


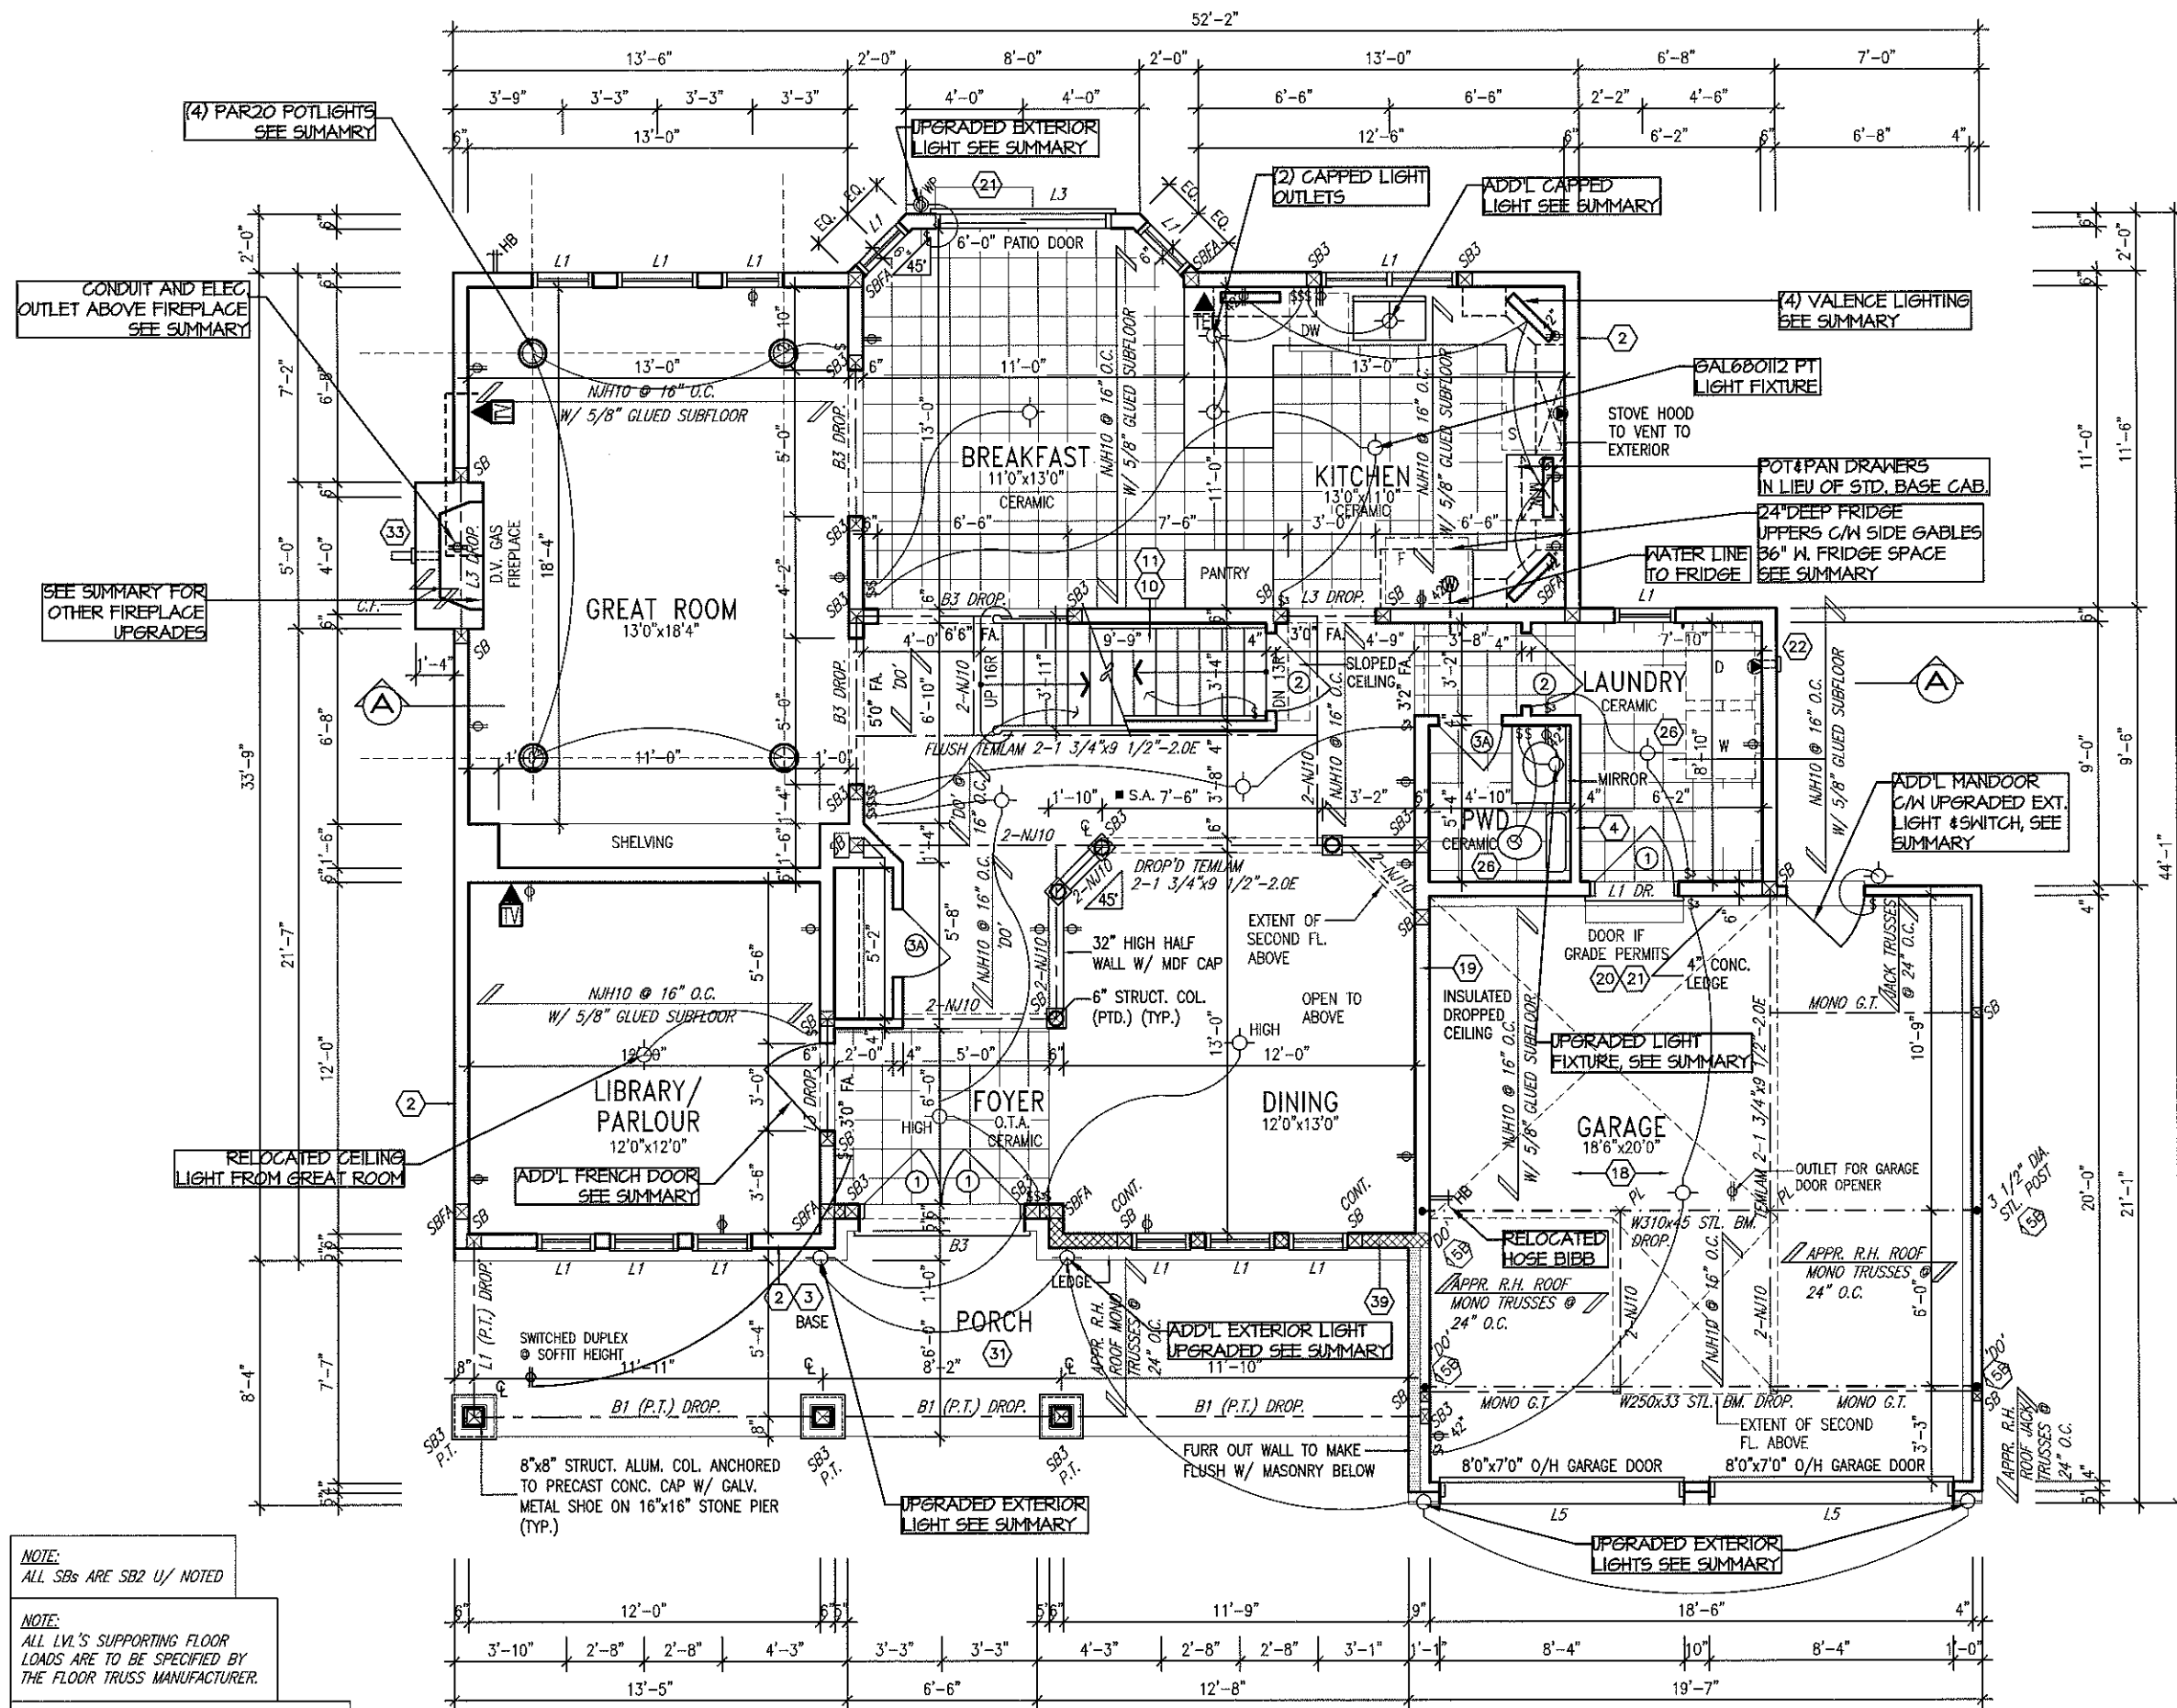

GROUND FLOOR PLAN-A

footprint:	53-A	
slt. title:	GROUND FLOOR-A	
drawn by:	TD'S	
checked by:	OF	
date:	FEB. 2007	
scale:	3/16"=1'	
sheet no:		

[illegible]

BABYLONIAN-2007-A


SITE: SHADOW RIDGE 2

LOT NUMBER: 75


CIVIC ADDRESS: 6552 WATERDOWN ST.

**Viljoen
Architect
Inc.**

300 A Wilson Avenue
North York, Ontario
M3H 1S8
TEL: (416) 630-2255
FAX: (416) 630-4782

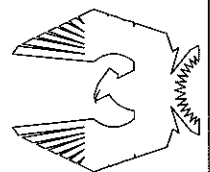

PHOENIX HOMES

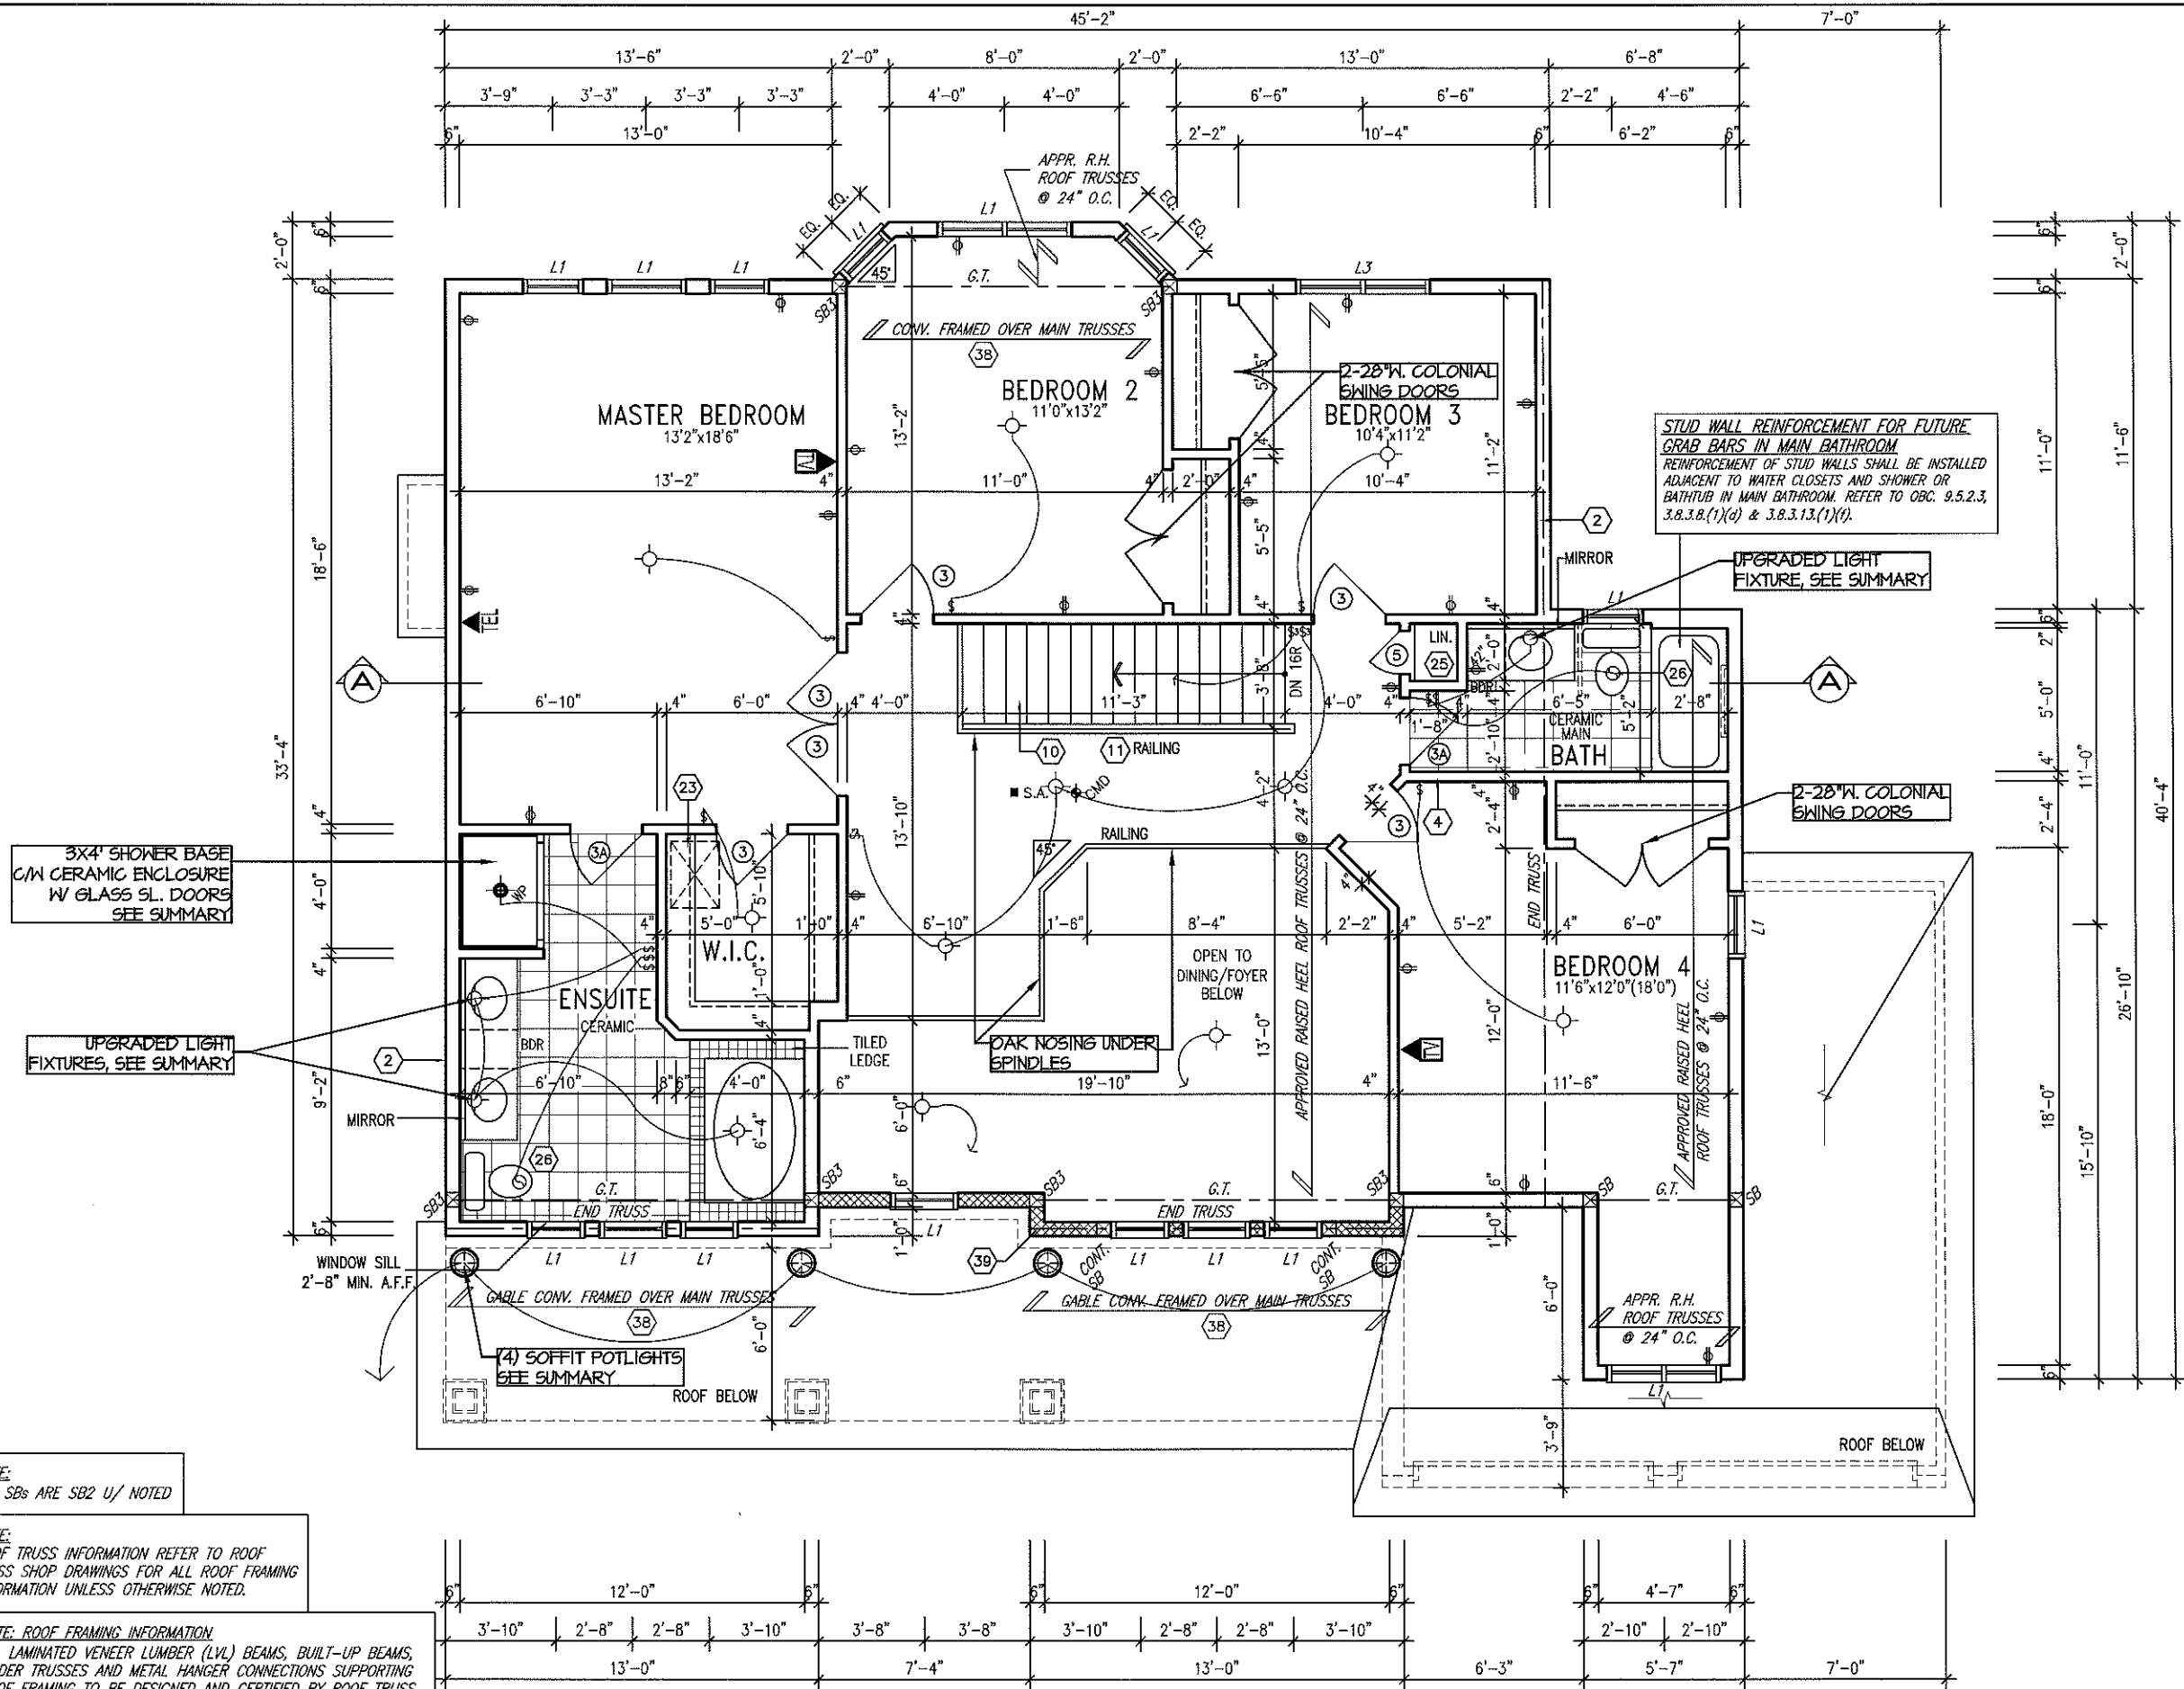

NOTE:
ALL SBs ARE SB2 U/ NOTED

NOTE:
ROOF TRUSS INFORMATION REFER TO ROOF TRUSS SHOP DRAWINGS FOR ALL ROOF FRAMING INFORMATION UNLESS OTHERWISE NOTED.

NOTE: ROOF FRAMING INFORMATION
ALL LAMINATED VENEER LUMBER (LVL) BEAMS, BUILT-UP BEAMS, GIRDER TRUSSES AND METAL HANGER CONNECTIONS SUPPORTING ROOF FRAMING TO BE DESIGNED AND CERTIFIED BY ROOF TRUSS MANUFACTURER. REFER TO ROOF TRUSS SHOP DRAWINGS FOR ALL ROOF FRAMING INFORMATION UNLESS OTHERWISE NOTED ON ARCHITECTURAL DRAWINGS.

SECOND FLOOR PLAN-A

53-A

Sheet title: SECOND FLOOR-A

Drawn by: TD5

Checked by: OF

Date: FEB. 2007

Scale: 3/16"=1'

Sheet no: 3A

6

No.	Description	By	Date
2	REV. AS PER CONST. SUMMARY	SD	AUG23-13
1	REV. AS PER CONST. SUMMARY	SD	JUL24-13

BABYLONIAN-2007-A

SITE: SHADOW RIDGE2


LOT NUMBER: 75

CIVIC ADDRESS: 6552 WATERDOWN ST.


Viljoen Architect Inc.

300 A. Wilson Avenue
North York, Ontario
M3H 1S8
TEL: (416) 630-2255
FAX: (416) 630-4782


PHOENIX HOMES

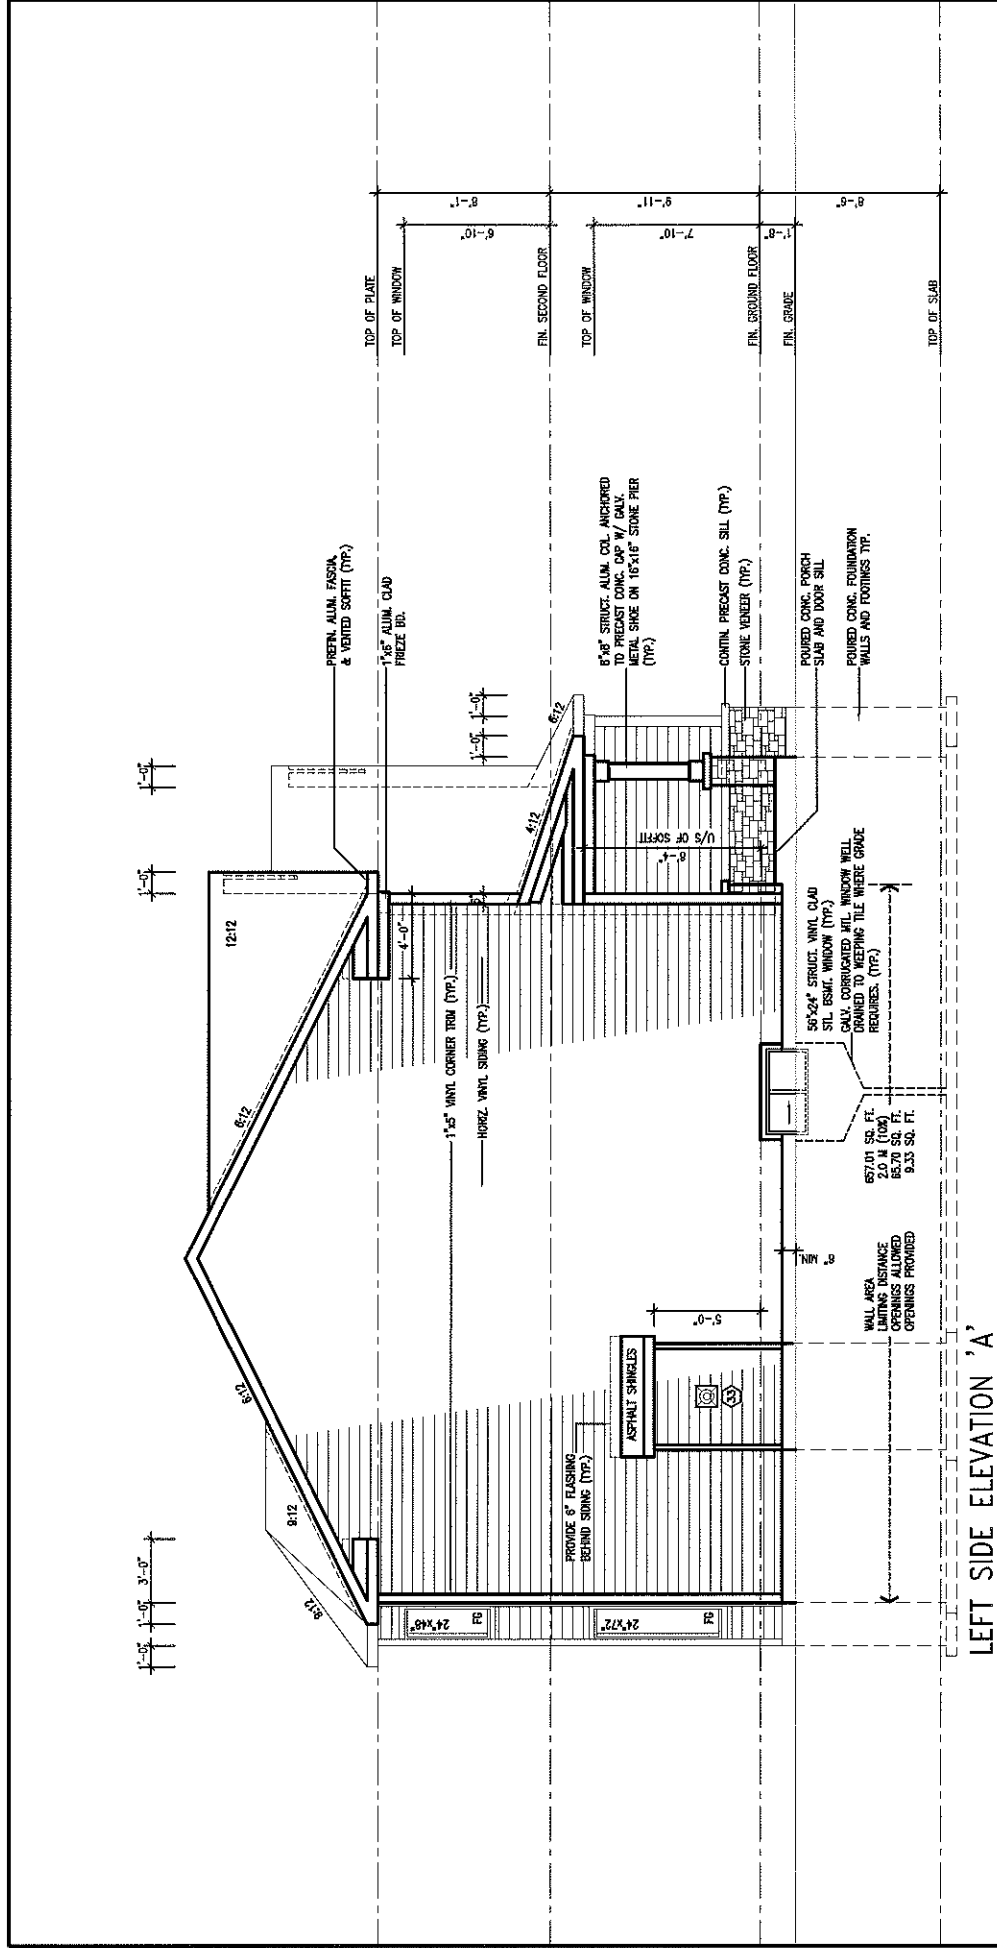


LEFT SIDE ELEVATION 'A'

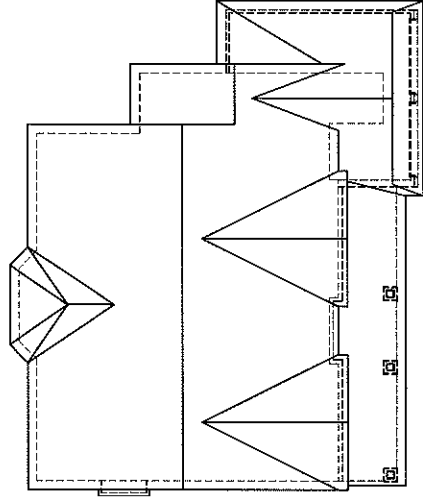

ROOF PLAN 'A'

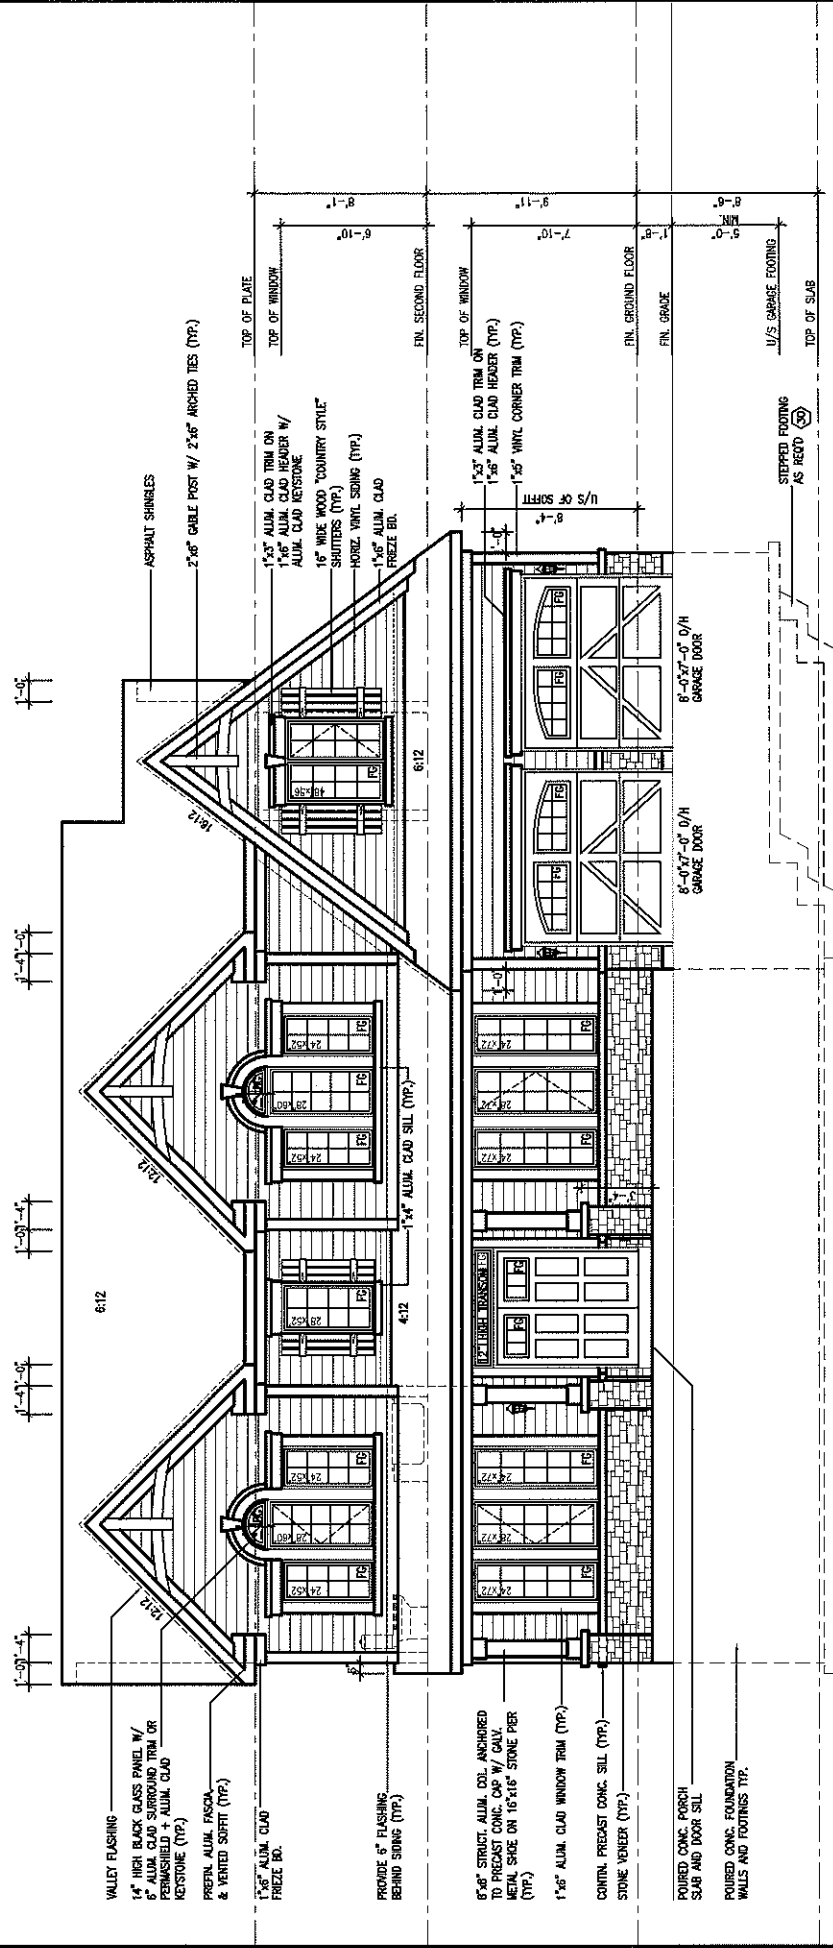

FRONT ELEVATION 'A'

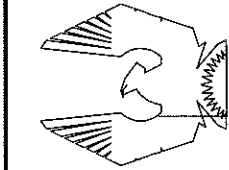

PHOENIX HOMES

Viljoen
Architect
Inc.

300 A. Wilson Avenue
North York, Ontario
M3H 1S8
TEL: (416) 630-2255
FAX: (416) 630-4782

BABYLONIAN-2007-A

SITE: SHADOW RIDGE2

LOT NUMBER:

75

CIVIC ADDRESS:
6552 WATERDOWN ST.

Footprint: S3-A

Site Title: ELEVATIONS-A

Drawn by: TDS

Checked by: OF


Date: FEB. 2007

Scale: 1/8"=1'


Sheet No:

4A
6


No.	Description	Date	By
2	REV. AS PER CONST. SUMMARY	AUG23-13	SD
1	REV. AS PER CONST. SUMMARY	JUL24-13	SD

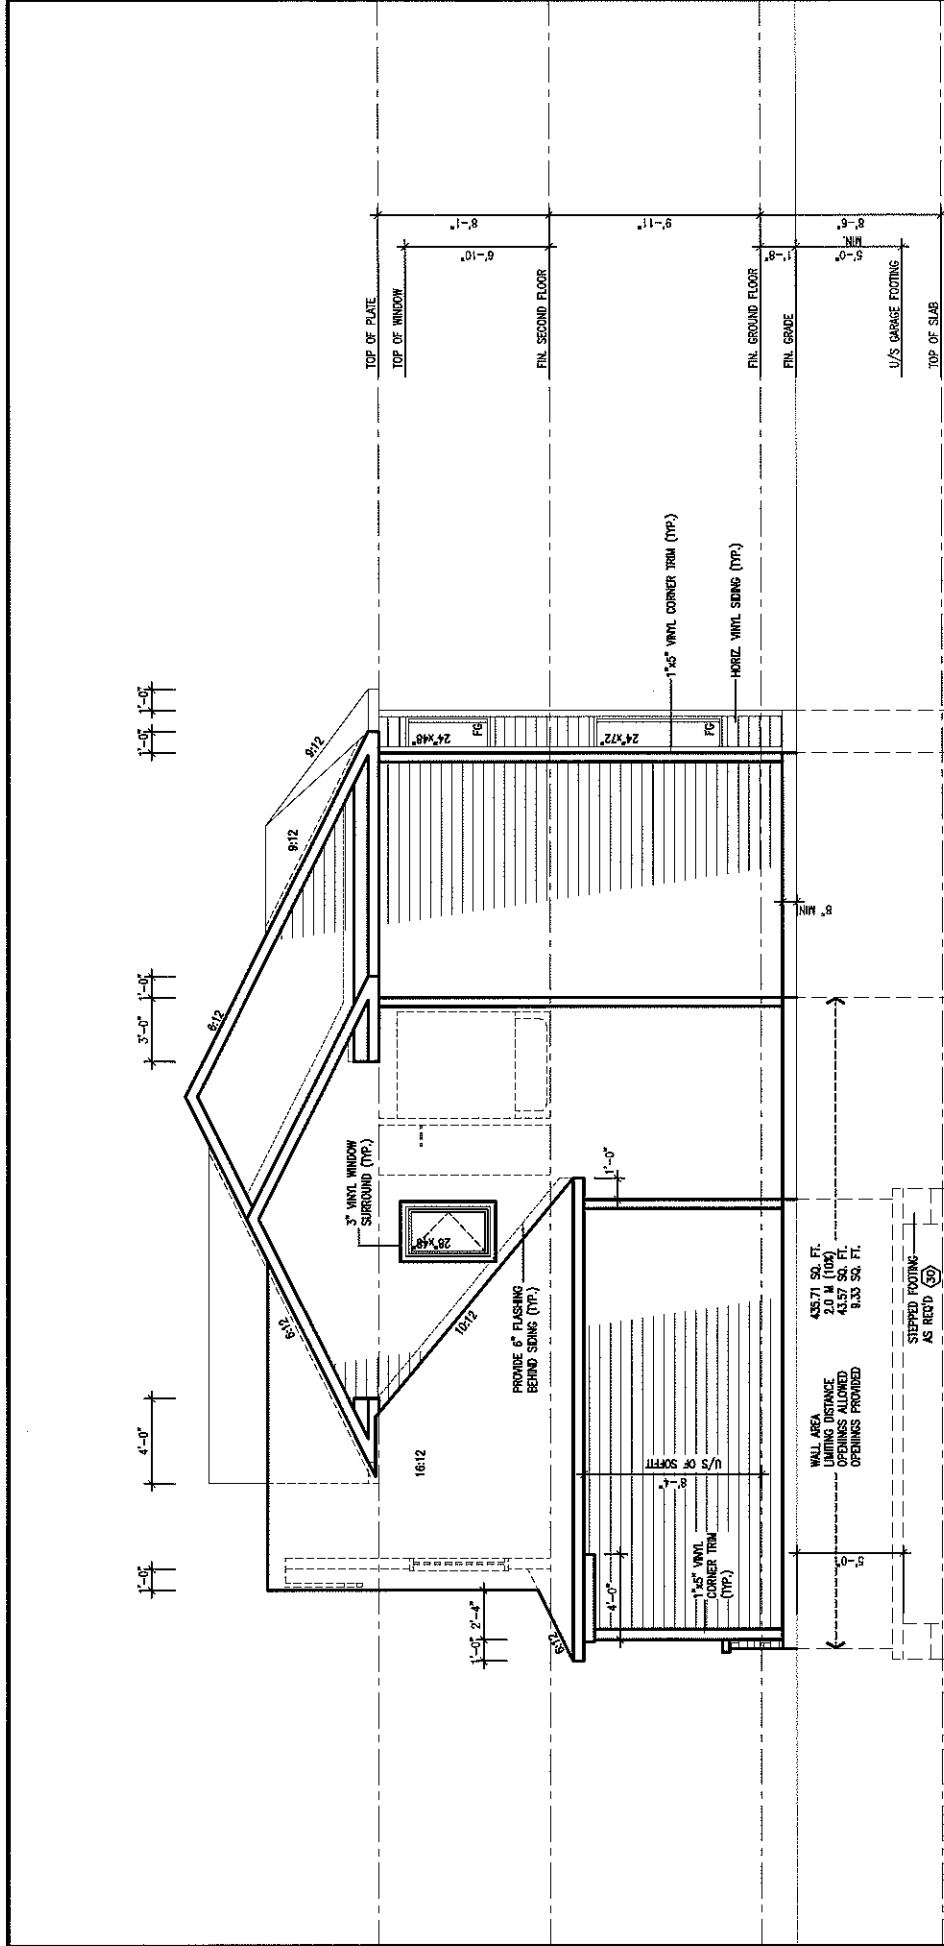

RIGHT SIDE ELEVATION 'A'

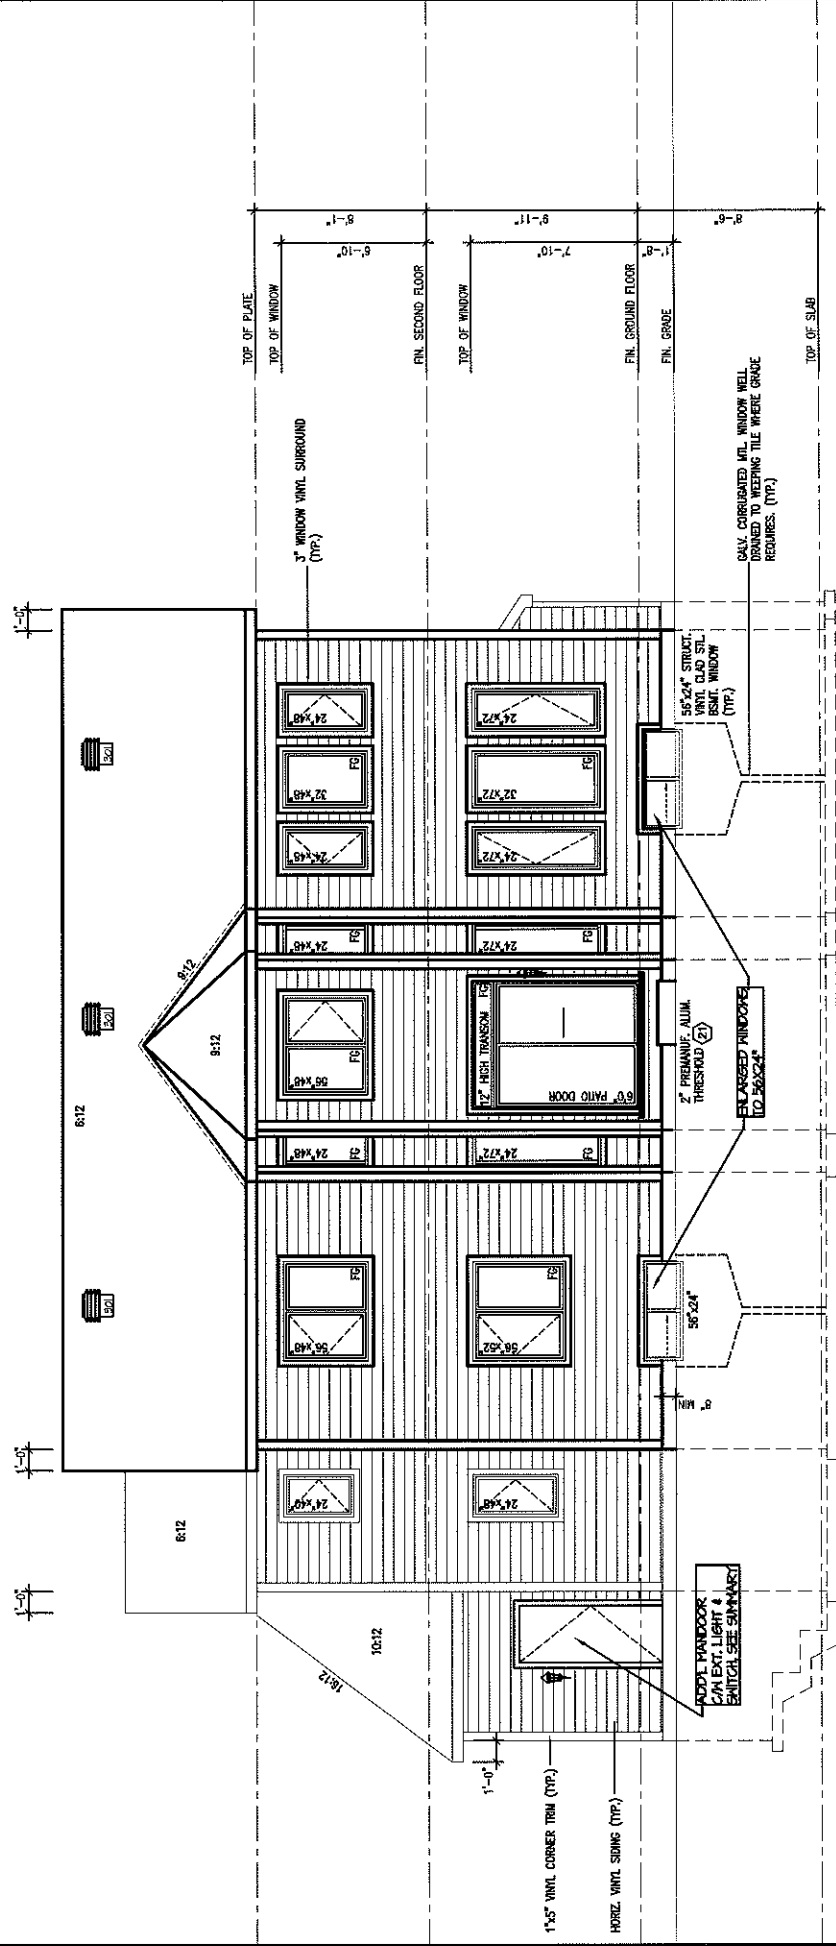

REAR ELEVATION 'A'

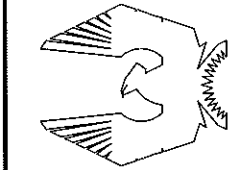

Viljoen
Architect
Inc.

300 A Wilson Avenue
North York, Ontario
M3H 1S8
TEL: (416) 630-2255
FAX: (416) 630-4782

PHOENIX HOMES

BABYLONIAN-2007-A

SITE: SHADOW RIDGE2

LOT NUMBER:

75

CIVIC ADDRESS:
6552 WATERDOWN ST.

Footprint: S3-A

Shit. title: ELEVATIONS-A

drawn by: TDS

checked by: OF

date: FEB. 2007

scale: 1/8" = 1'

sheet no:


5A
6

2 REV. AS PER CONST. SUMMARY AUG23-13 5D

1 REV. AS PER CONST. SUMMARY JUL24-13 5D

No. Description Date By

REVISIONS

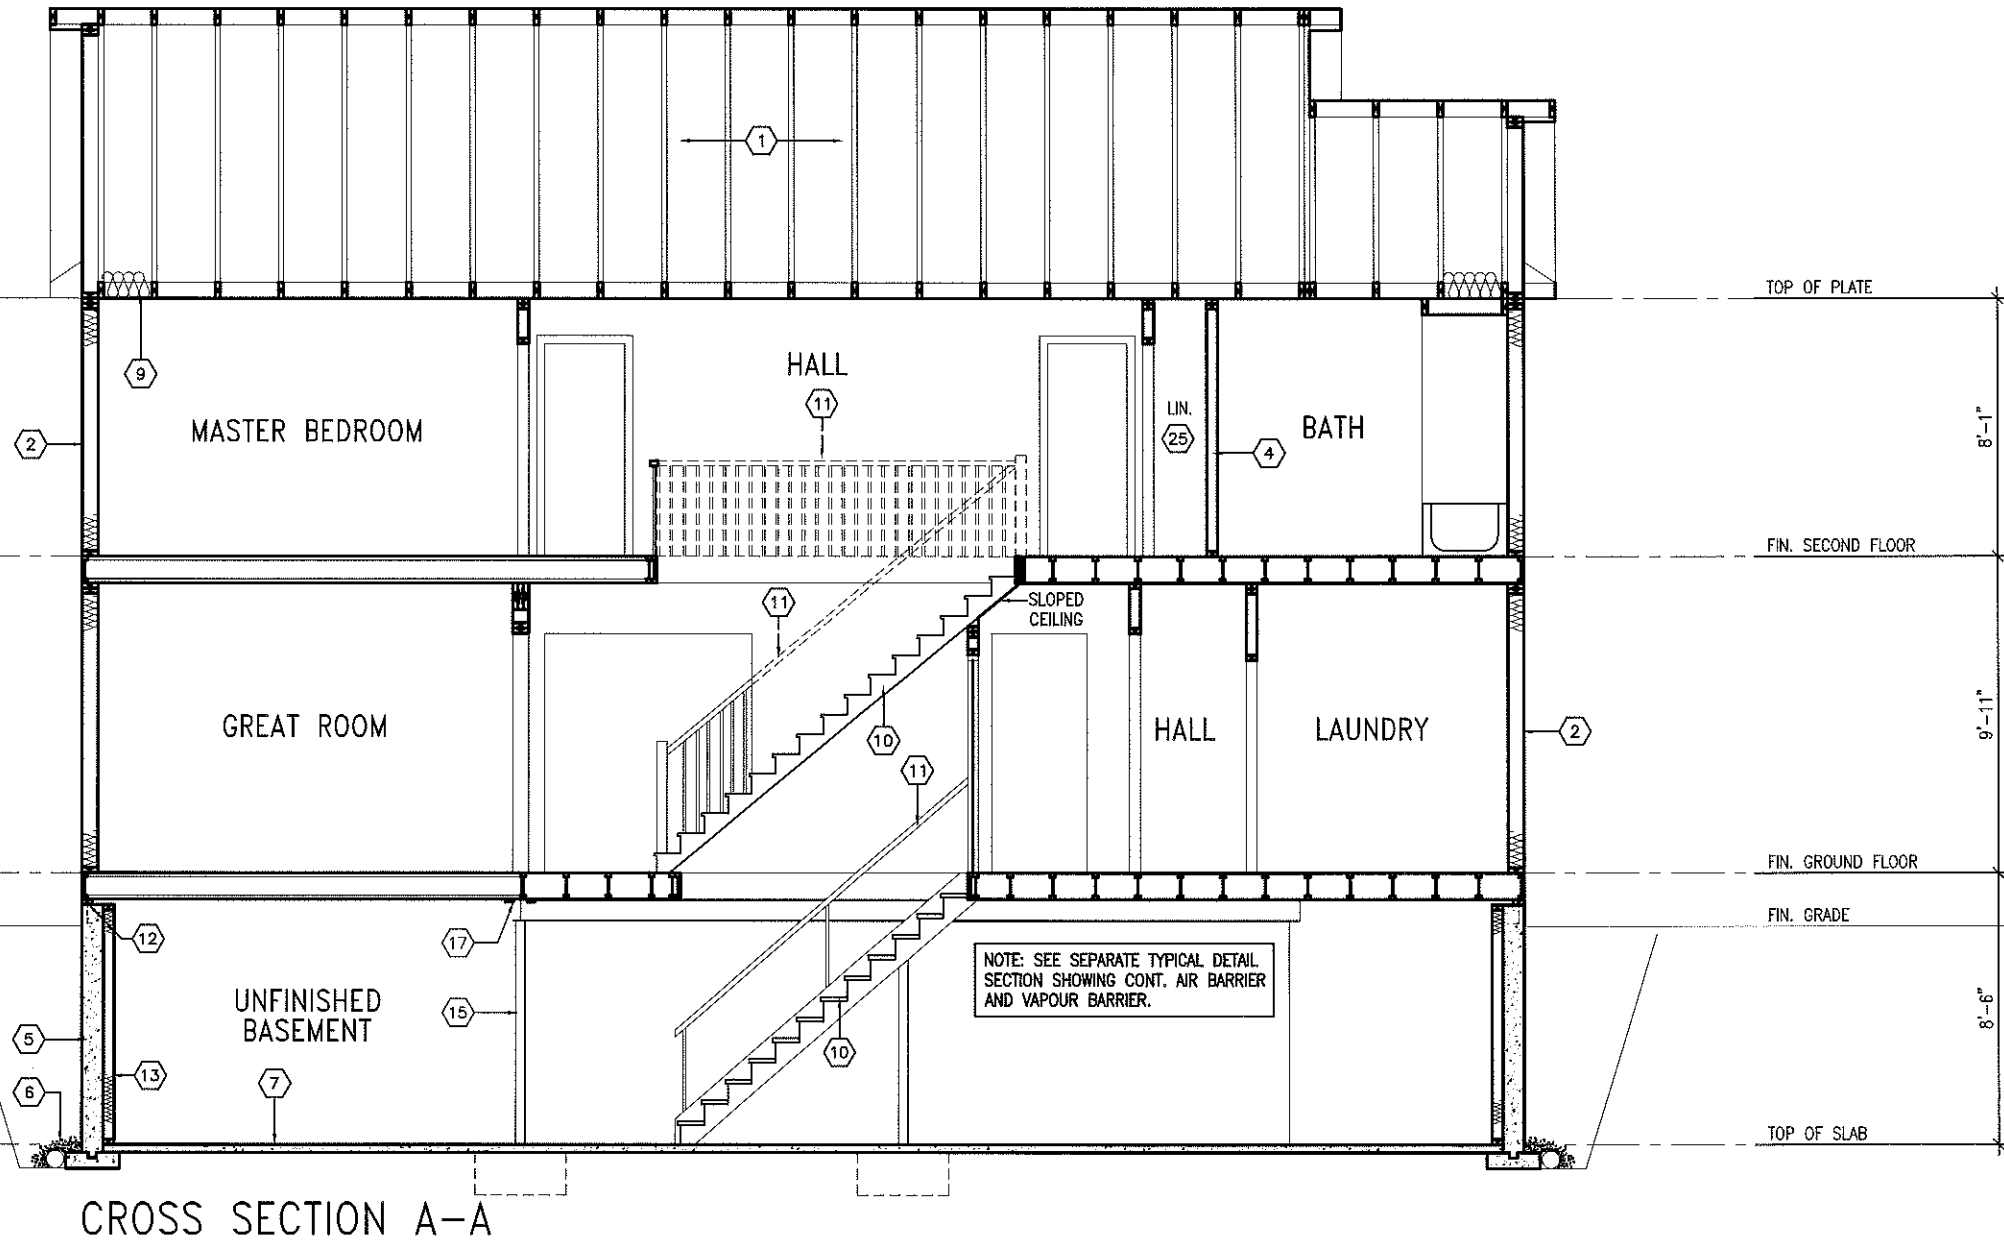

Footprint: 53	
Sht. title: SECTION	
drawn by: TD'S	
checked by: OF	
date: FEB. 2001	
scale: 3/16"=1'	
sheet no:	6

No.	Description	Date	By
2	REV. AS PER CONST. SUMMARY	AUG 23-13	SD
1	REV. AS PER CONST. SUMMARY	JUL 24-13	SD

BABYLONIAN-2007	
SITE: SHADOW RIDGE 2	
LOT NUMBER: 75	
CIVIC ADDRESS: 6552 WATERDOWN ST.	

Viljoen Architect Inc.	
300 A. Wilson Avenue North York, Ontario M3H 1S8 TEL: (416) 630-2255 FAX: (416) 630-4782	

PHOENIX HOMES	
---------------	--