


NOTE: PROVIDE 2-10M TOP AND BOTTOM BARS ALL AROUND FOUNDATION WALLS (UNLESS NOTED OTHERWISE)

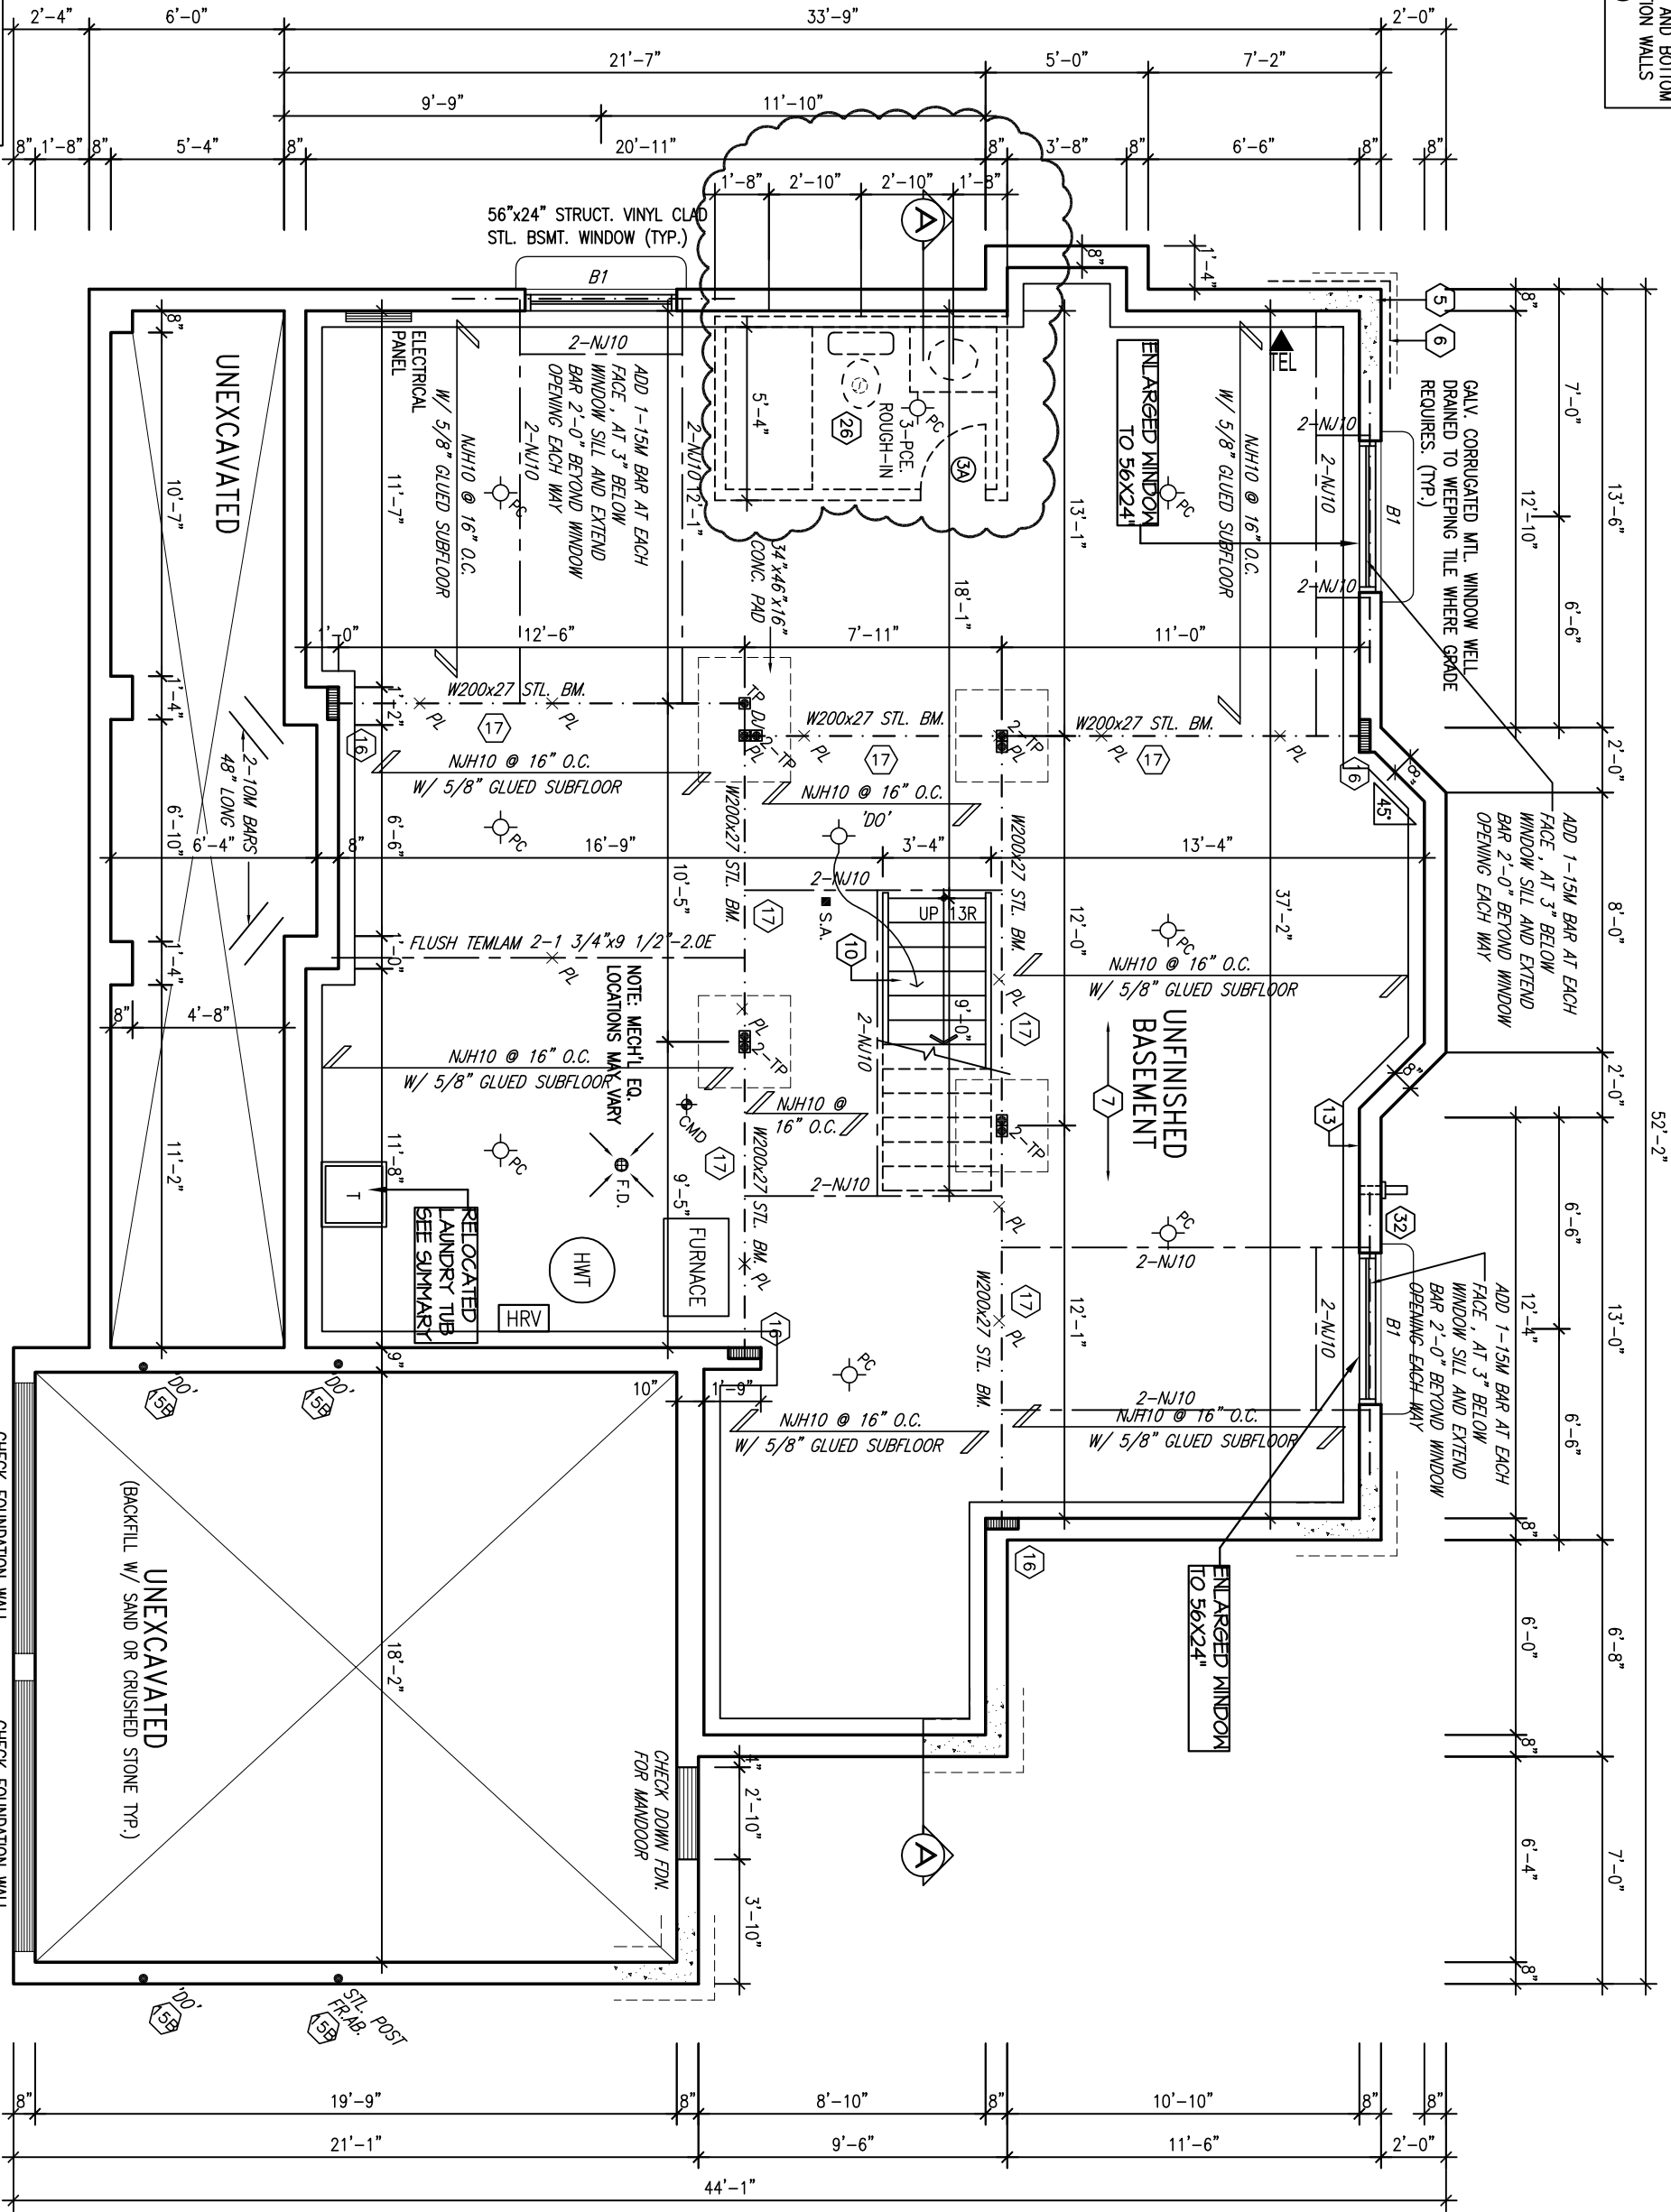

AREA CALCULATIONS	
	ELEV. A
GROUND FLOOR AREA	1314 SF
SECOND FLOOR AREA	1463 SF
SUBTOTAL	2777 SF
DEDUCT ALL OPEN AREAS	200 SF
TOTAL NET AREA	2577 SF
	(239.40 m ²)
FINISHED BSMT. AREA	00 SF
COVERAGE	1720 SF
W/OUT PORCH	(159.79 m ²)
COVERAGE	1922 SF
	(178.55 m ²)

BASEMENT PLAN-A

Viljoen
Architect
Inc.

300 A Wilson Avenue
North York, Ontario
M3H 1S8
TEL: (416) 630-2255
FAX: (416) 630-4782


BABYLONIAN-2007-A

SITE: SHADOW RIDGE2

LOT NUMBER:

CIVIC ADDRESS:
6552 WATERDOWN ST.

75

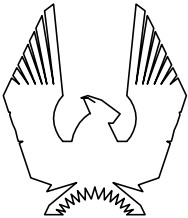


PHOENIX HOMES

Footprint: 53-A
sht. title: BASEMENT-A
drawn by: TDS
checked by: OF
date: FEB. 2007
scale: 3/16"=1'

sheet no:

1A
6

No.	Description	Date	By
2	REV. AS PER CONST. SUMMARY	AUG23-13	SD
1	REV. AS PER CONST. SUMMARY	JUL24-13	SD
REVISIONS			

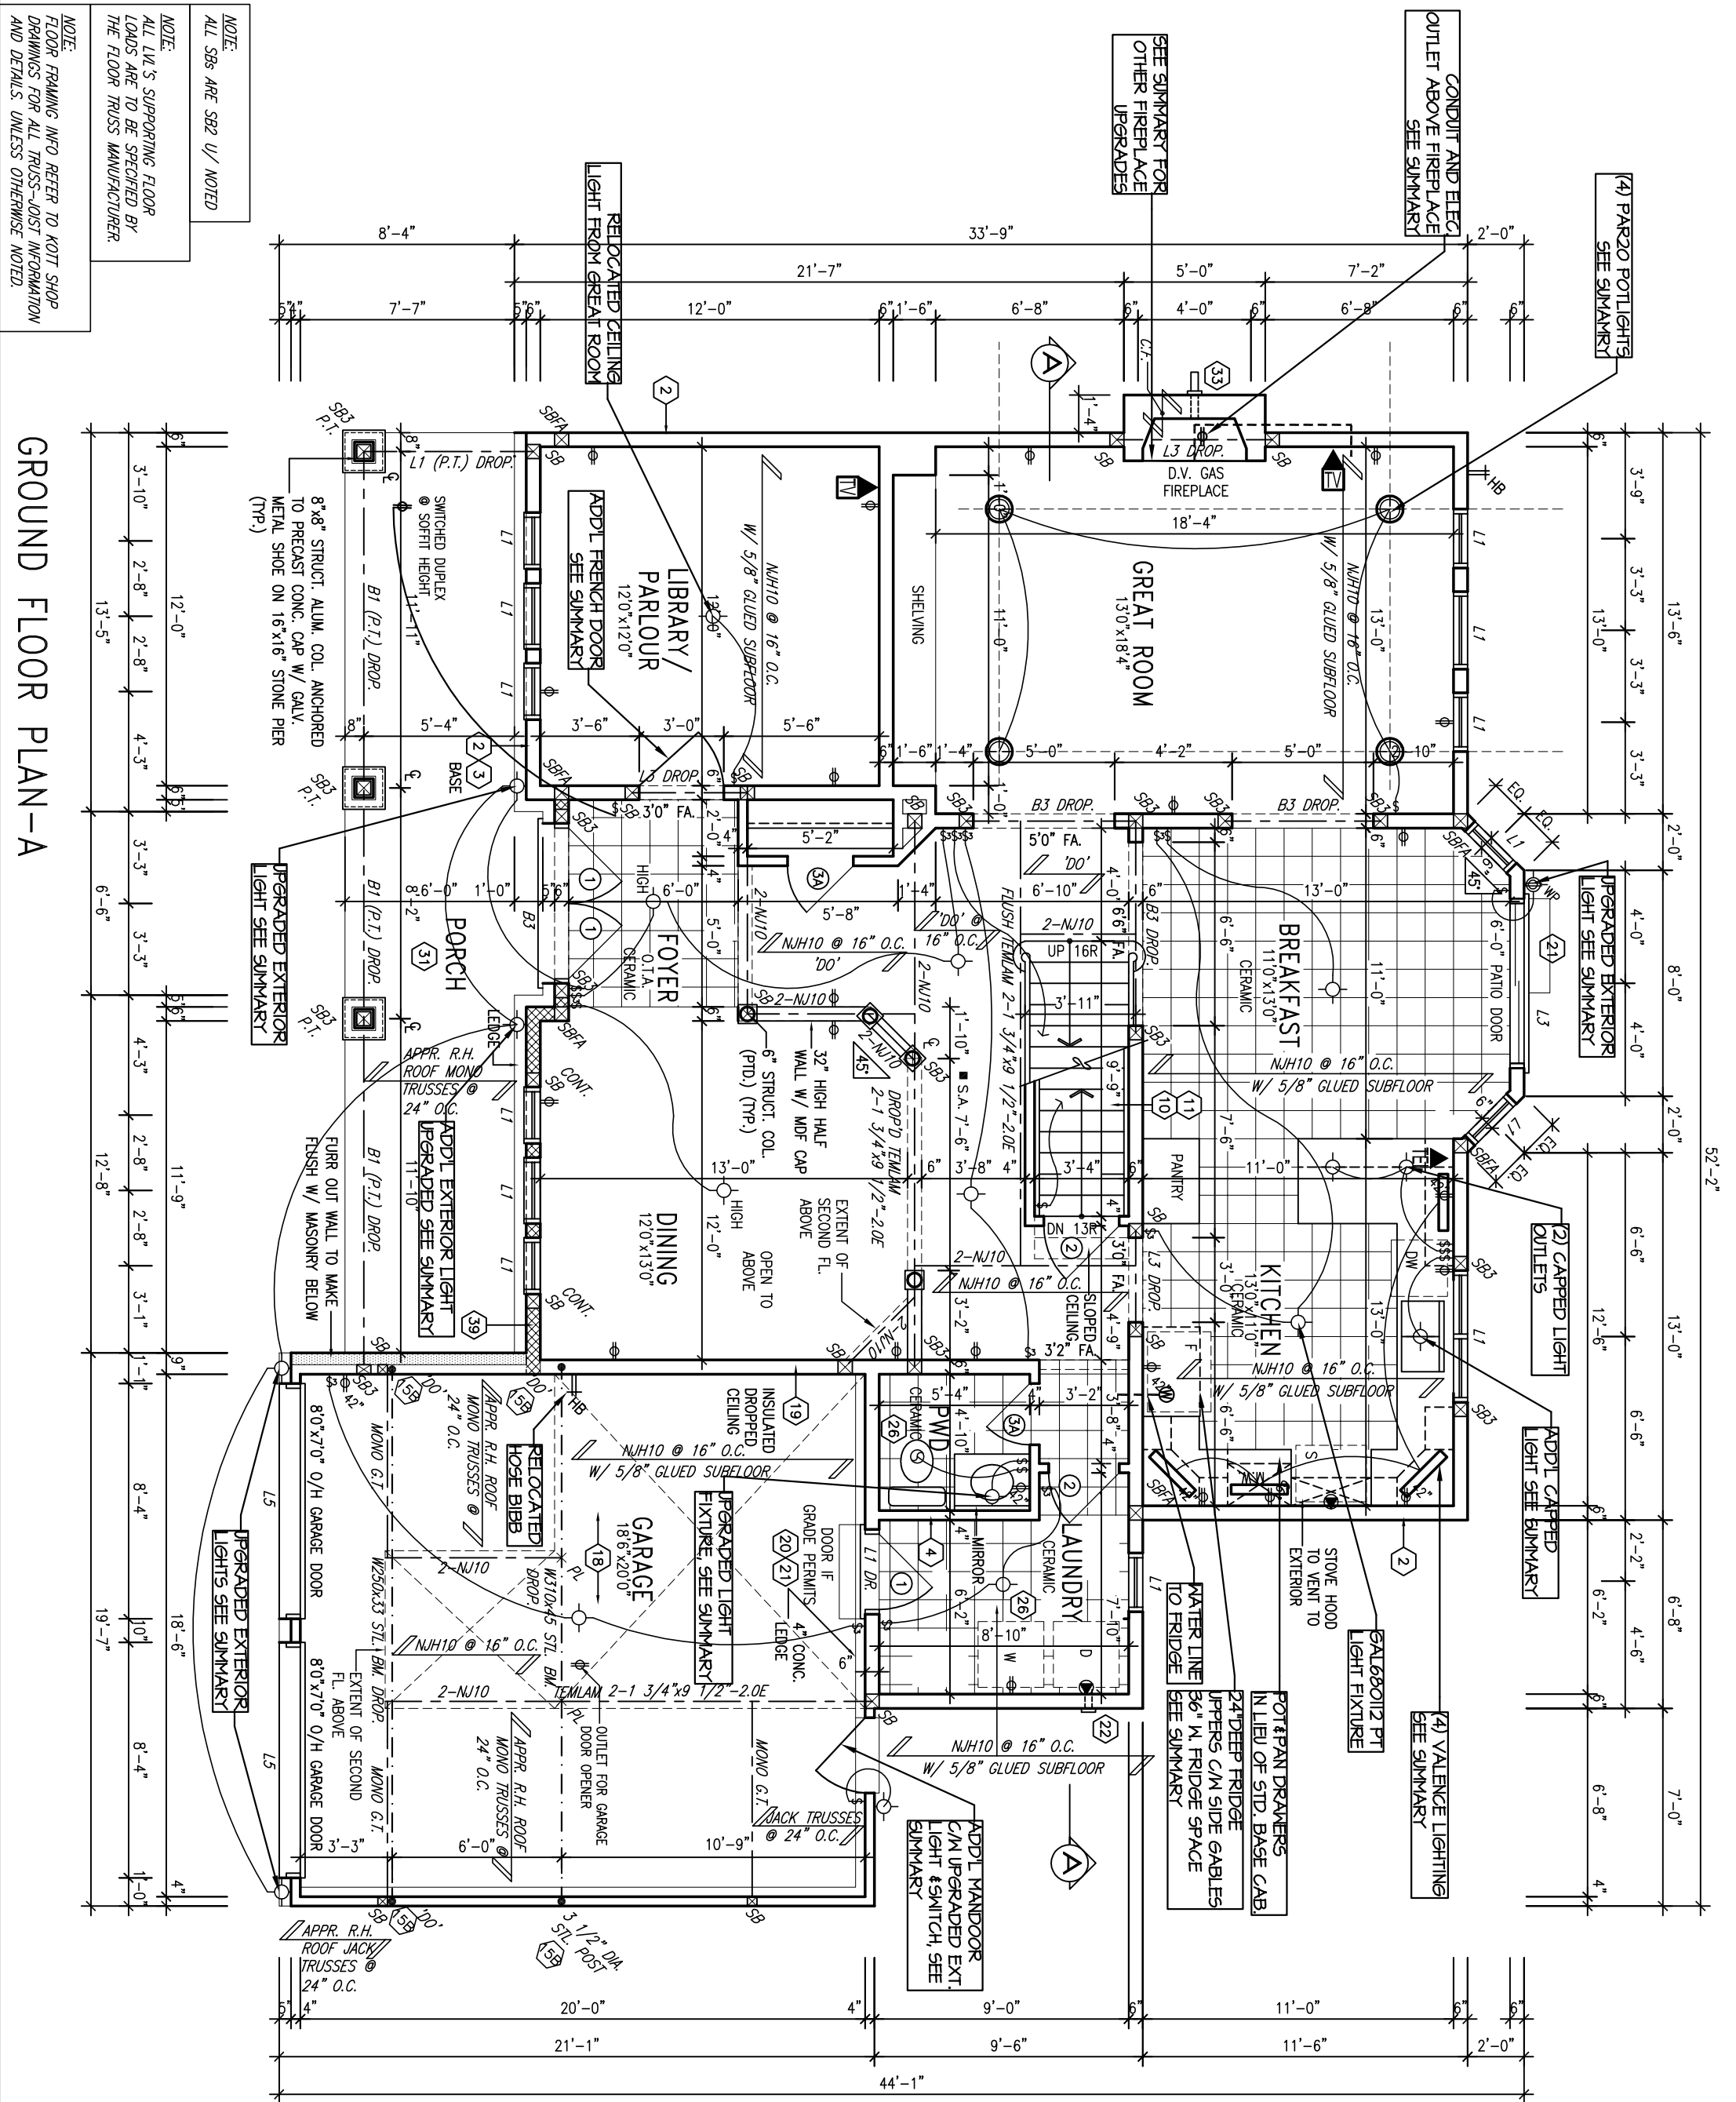

GROUND FLOOR PLAN-A

NOTE:
ALL SRS ARE SB2 U/ NOTED

NOTE:
ALL LVL'S SUPPORTING FLOOR LOADS ARE TO BE SPECIFIED BY THE FLOOR TRUSS MANUFACTURER.

NOTE:
FLOOR FRAMING INFO REFER TO KOTT SHOP DRAWINGS FOR ALL TRUSS-JOIST INFORMATION AND DETAILS, UNLESS OTHERWISE NOTED.



Viljoen Architect Inc.

300 A Wilson Avenue
North York, Ontario
M3H 1S8
TEL: (416) 630-2255
FAX: (416) 630-4782

BABYLONIAN-2007-A

SITE: SHADOW RIDGE2

LOT NUMBER:

CIVIC ADDRESS:
6552 WATERDOWN ST.

75

No.	Description	Date	By
2	REV. AS PER CONST. SUMMARY	AUG23-13	SD
1	REV. AS PER CONST. SUMMARY	JUL24-13	SD
REVISIONS			

footprint:	S3-A
sht. title:	GROUND FLOOR-A
drawn by:	TD5
checked by:	OF
date:	FEB. 2007
scale:	3/16"=1'
sheet no:	2A 6



300 A Wilson Avenue
North York, Ontario
M3H 1S8
TEL: (416) 630-2255
FAX: (416) 630-4782

BABYLONIAN-2007-A

SITE: SHADOW RIDGE2




LOT NUMBER:

CIVIC ADDRESS:
6552 WATERDOWN ST.

75

2	REV. AS PER CONST. SUMMARY	AUG23-13	SD
1	REV. AS PER CONST. SUMMARY	JUL24-13	SD
No.	Description	Date	By
REVISIONS			

footprint: 53-A	
sht. title: SECOND FLOOR-A	
drawn by: TDS	
checked by: OF	
date: FEB. 2007	
scale: 3/16"=1'	
sheet no:	

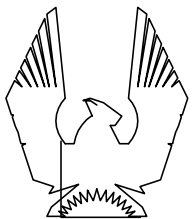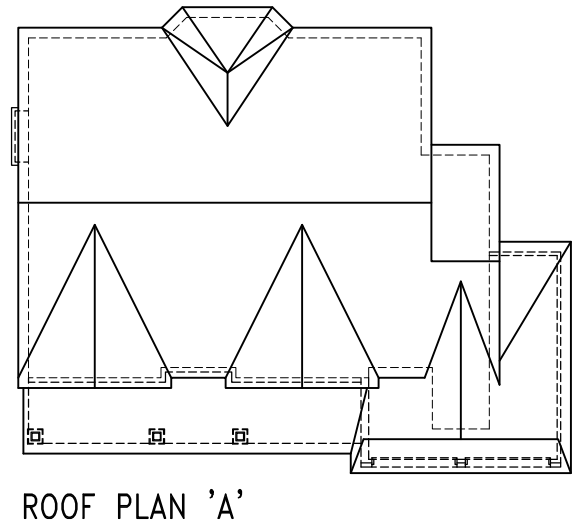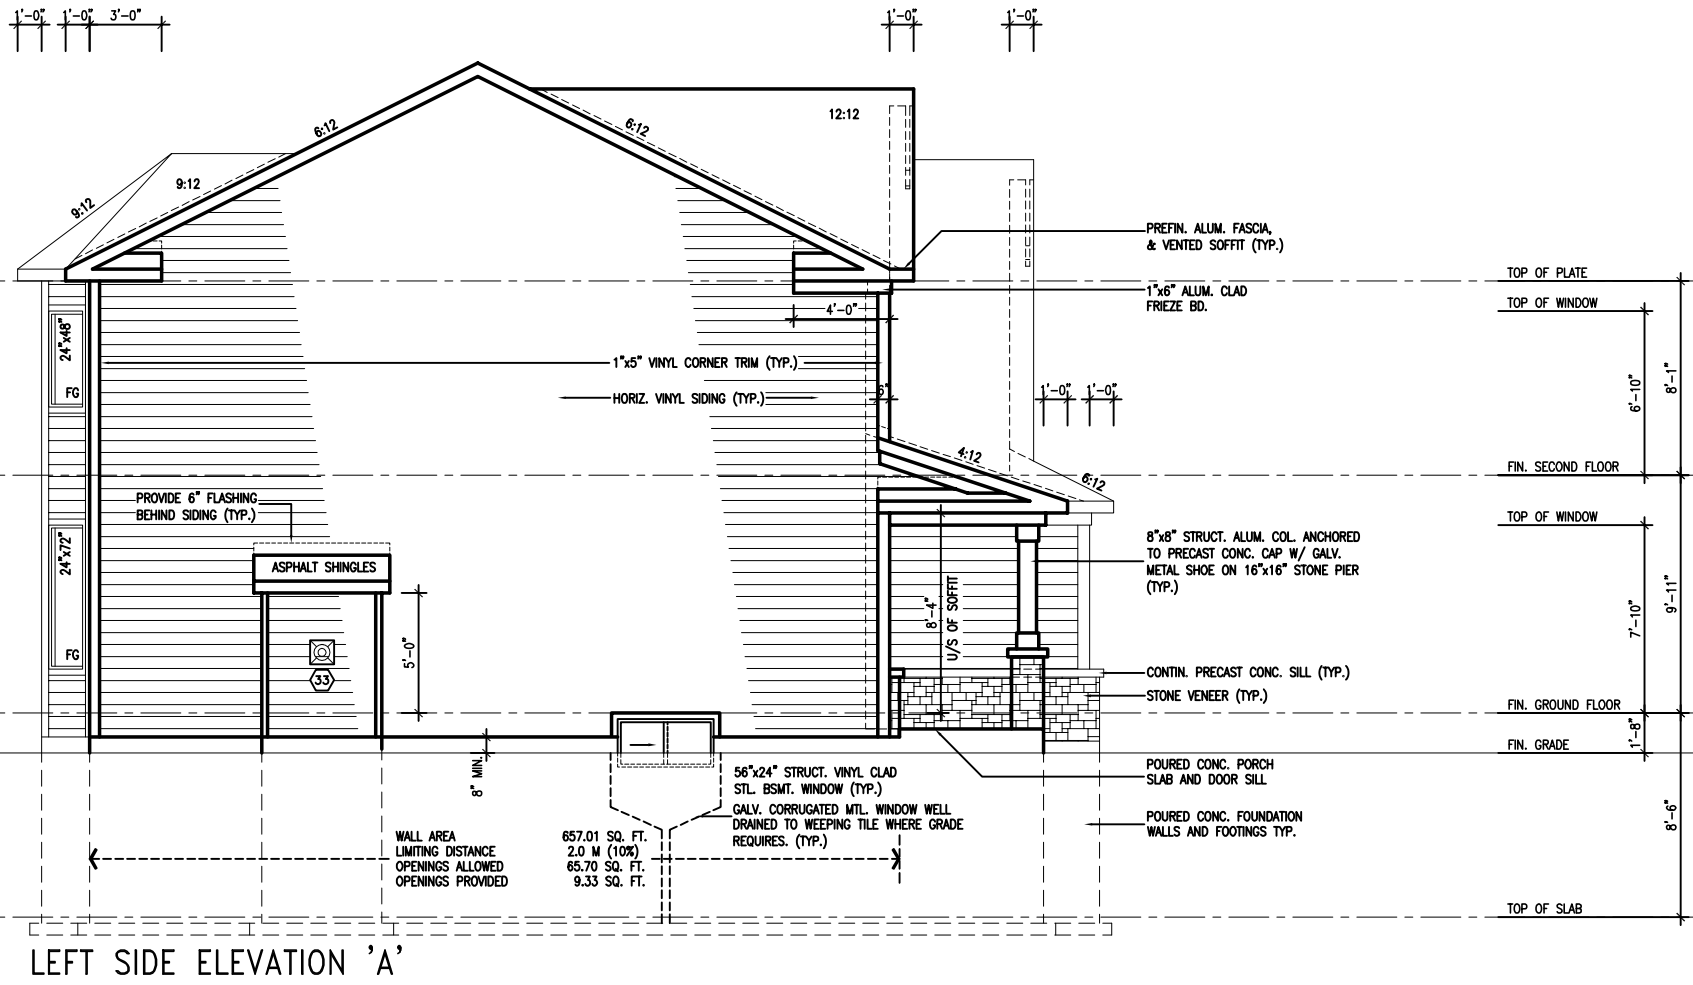

PHOENIX HOMES

Viljoen Architect Inc.

300 A Wilson Avenue
North York, Ontario
M3H 1S8
TEL: (416) 630-2255
FAX: (416) 630-4782

BABYLONIAN-2007-A

SITE: SHADOW RIDGE2

LOT NUMBER:

75




CIVIC ADDRESS:
6552 WATERDOWN ST.

No.	Description	Date	By
2	REV. AS PER CONST. SUMMARY	AUG23-13	SD
1	REV. AS PER CONST. SUMMARY	JUL24-13	SD
REVISIONS			

Footprint: S3-A
sht. title: ELEVATIONS-A
drawn by: TDS
checked by: OF
date: FEB. 2007
scale: 1/8"=1'

sheet no:

4A
6

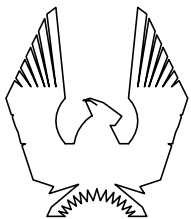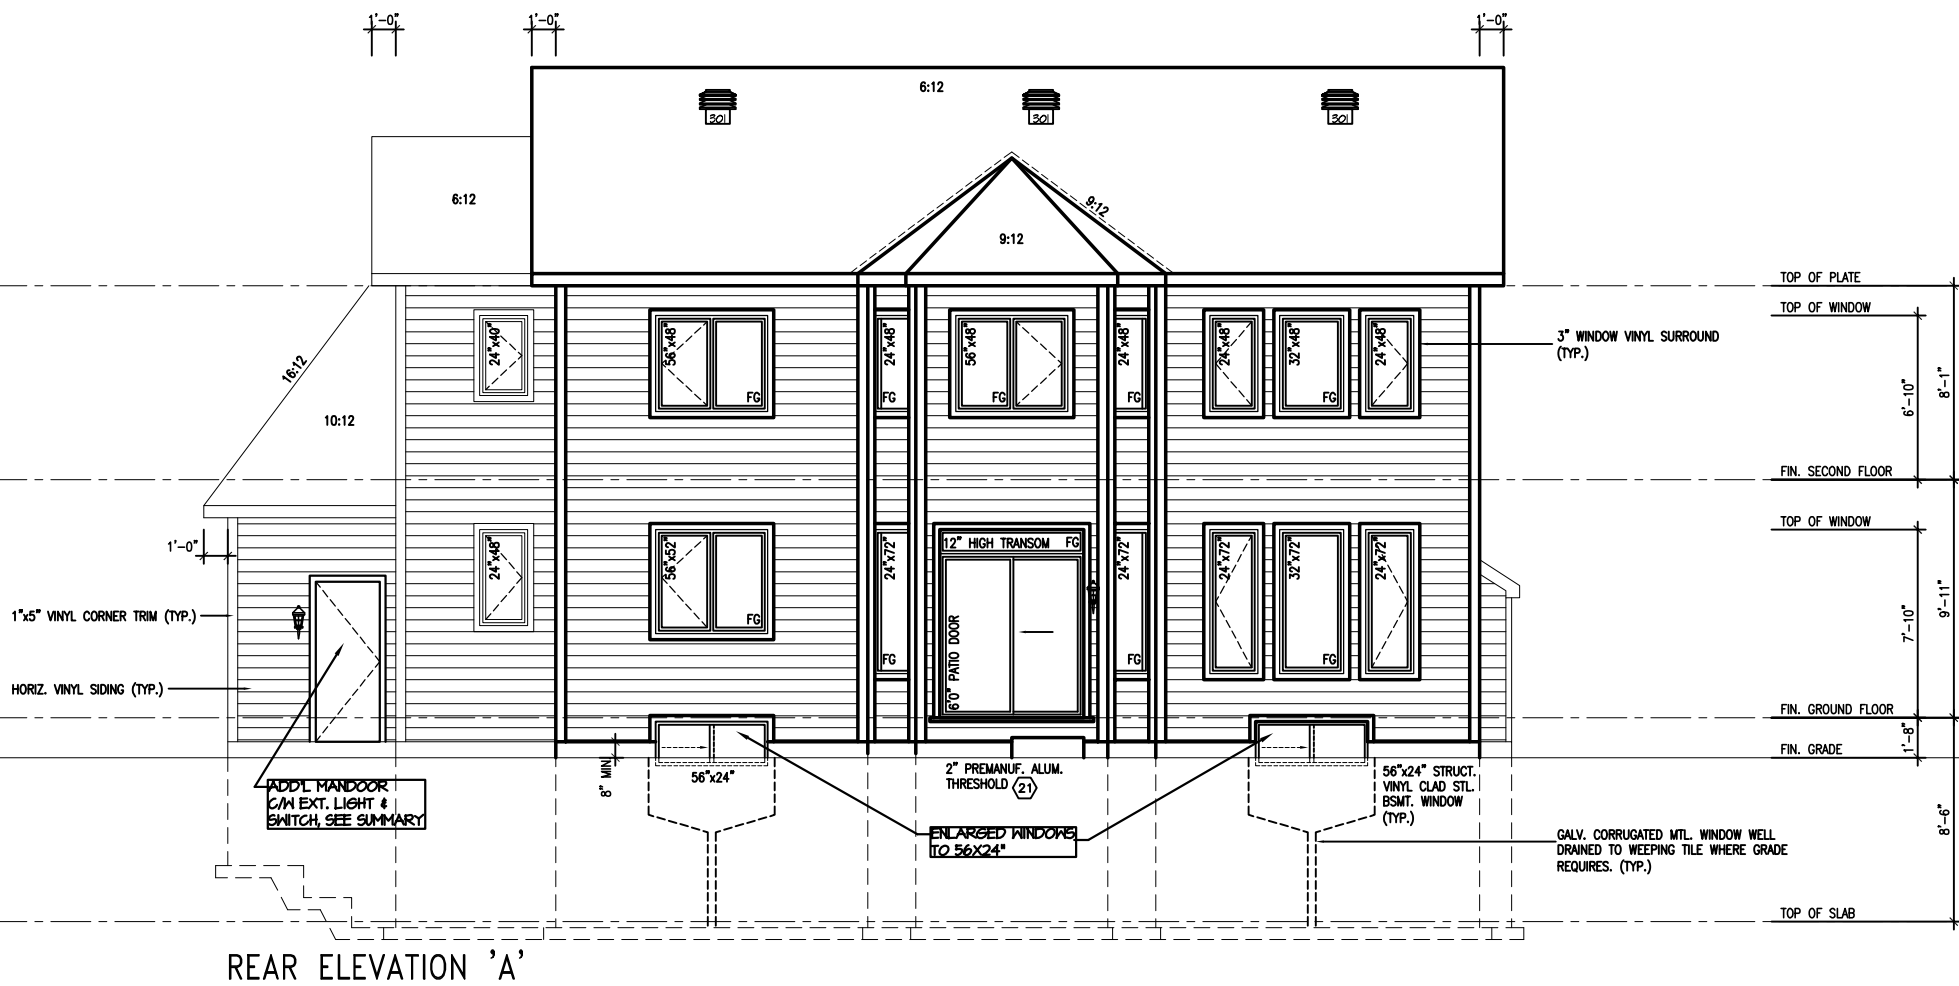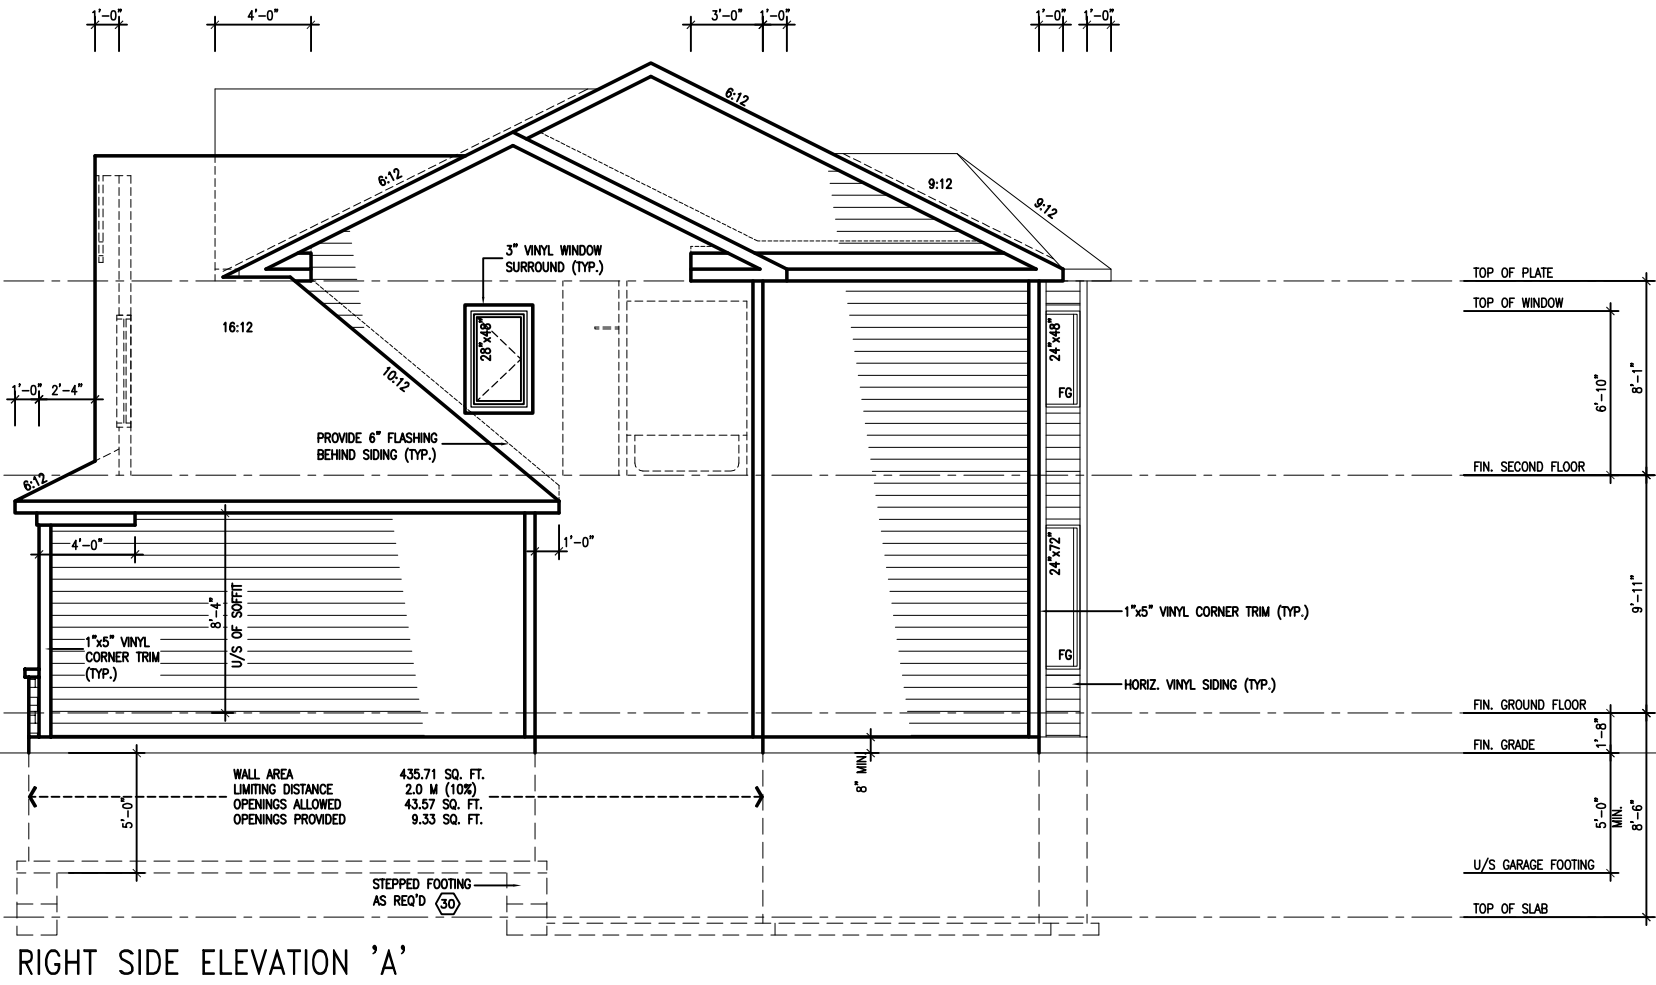

PHOENIX HOMES

**Viljoen
Architect
Inc.**

300 A Wilson Avenue
North York, Ontario
M3H 1S8
TEL: (416) 630-2255
FAX: (416) 630-4782

BABYLONIAN-2007-A

SITE: SHADOW RIDGE2

LOT NUMBER:

75

CIVIC ADDRESS:
6552 WATERDOWN ST.

No.	Description	Date	By
2	REV. AS PER CONST. SUMMARY	AUG23-13	SD
1	REV. AS PER CONST. SUMMARY	JUL24-13	SD
REVISIONS			

Footprint: **S3-A**

sht. title: **ELEVATIONS-A**

drawn by: **TDS**



checked by: **OF**

date: **FEB. 2007**

scale: **1/8"=1'**

sheet no:

5A
6

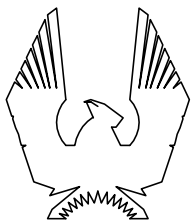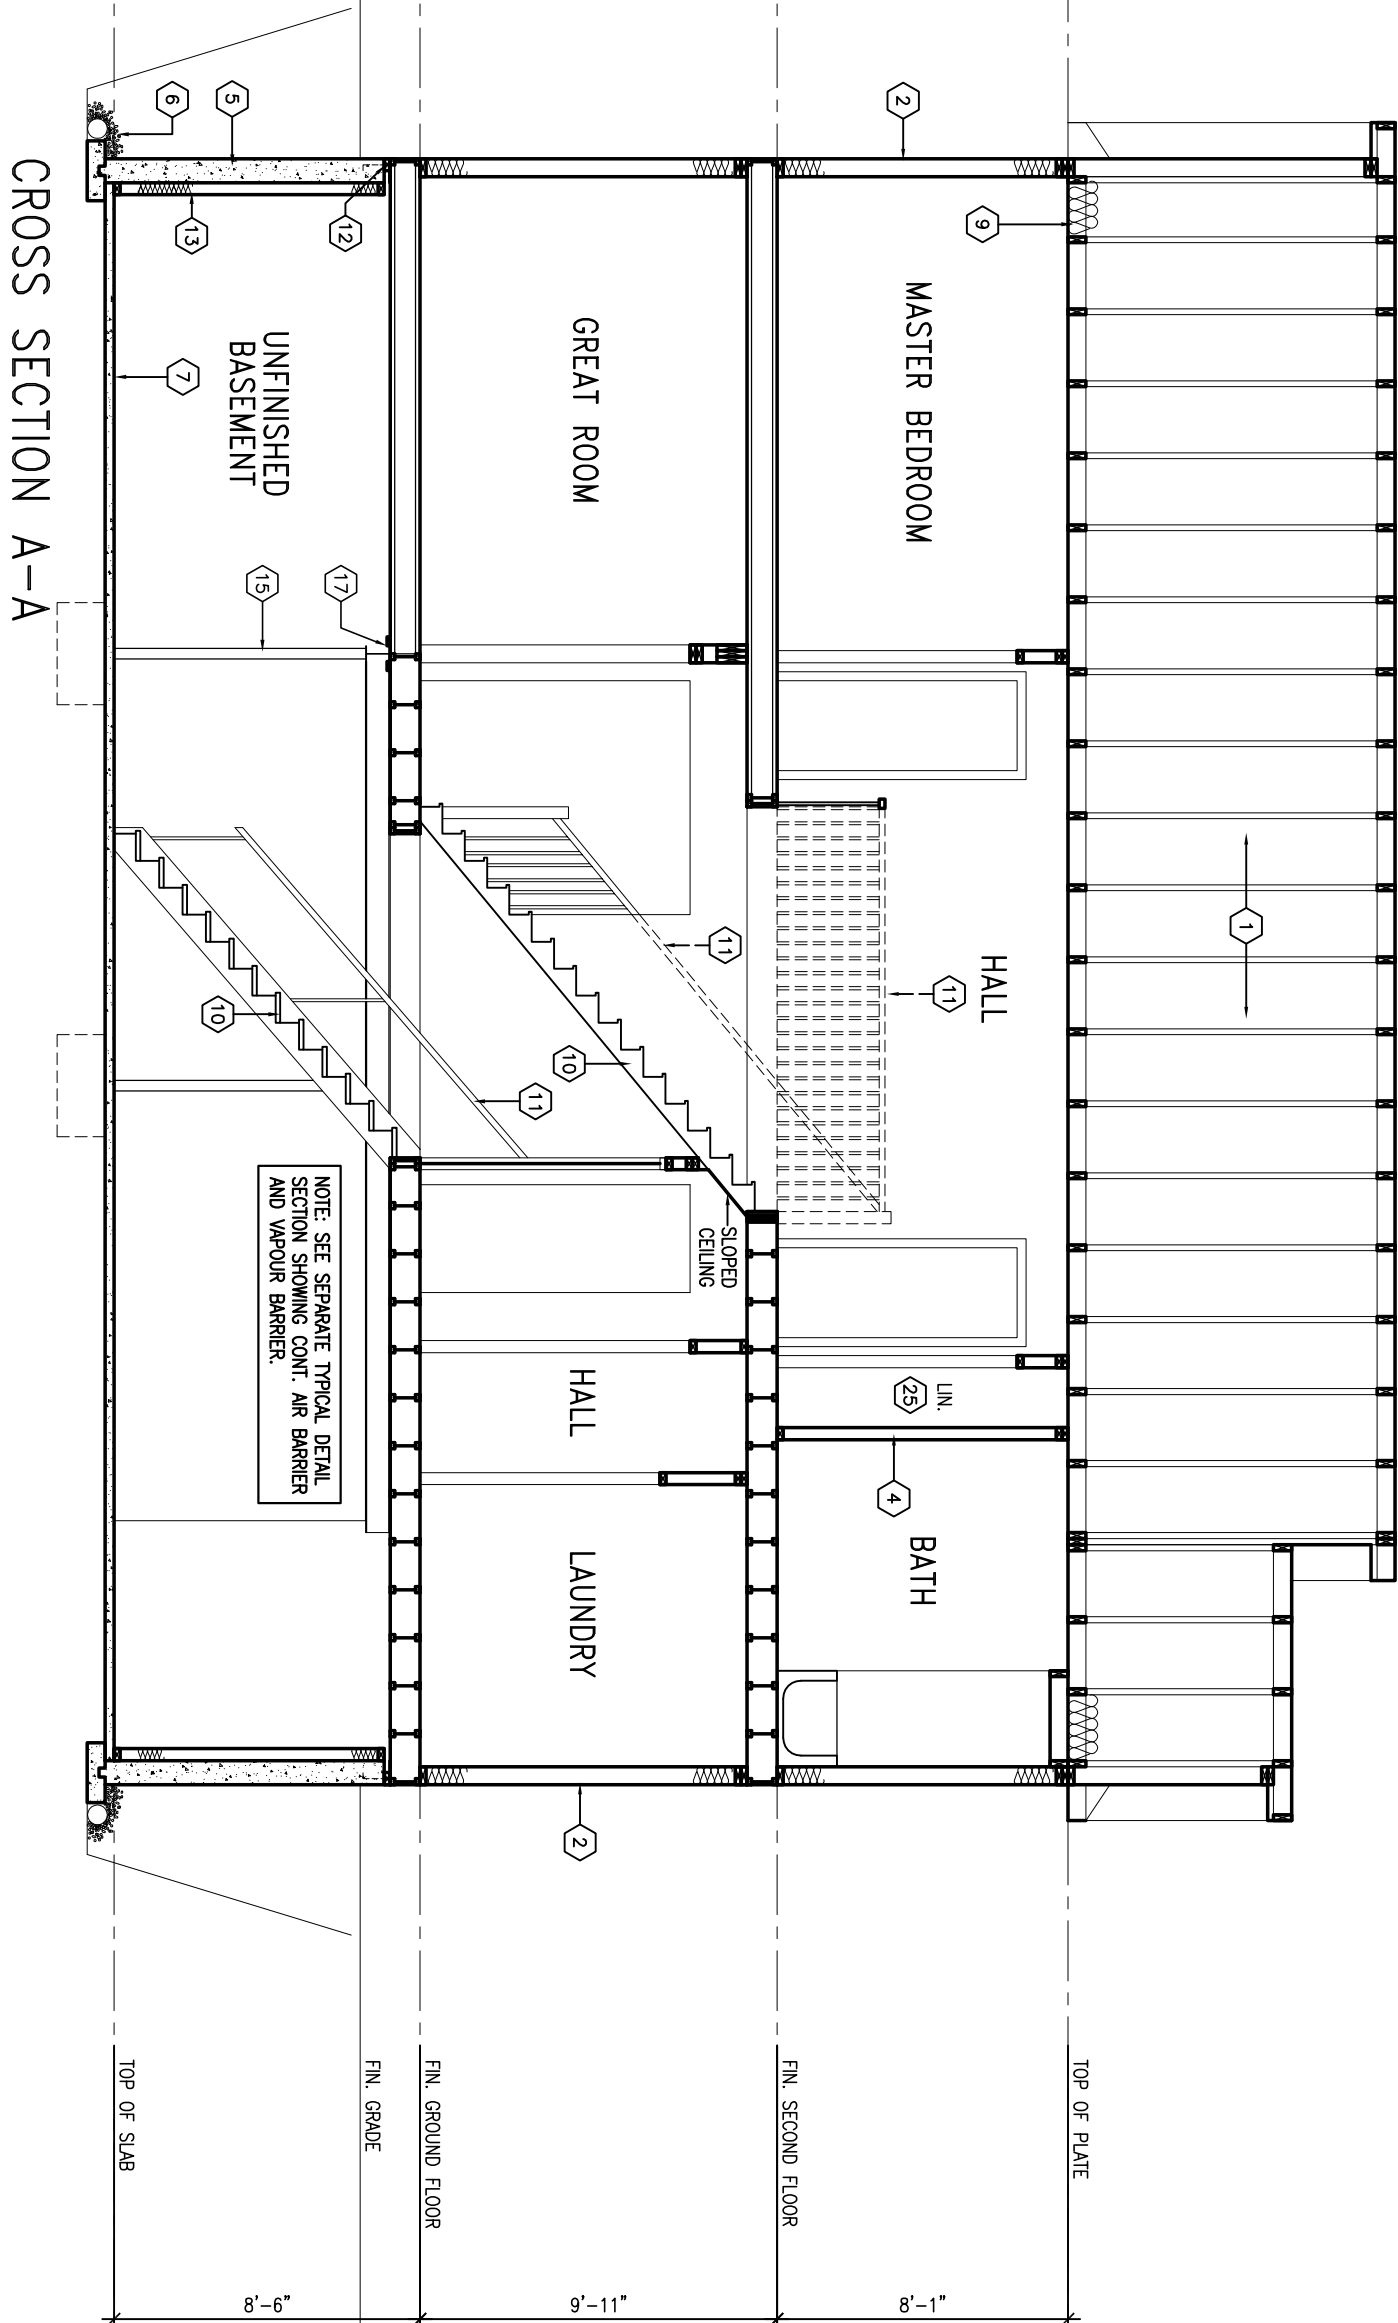

PHOENIX HOMES

**Viljoen
Architect
Inc.**

300 A Wilson Avenue
North York, Ontario
M3H 1S8
TEL: (416) 630-2255
FAX: (416) 630-4782

BABYLONIAN-2007

SITE: **SHADOW RIDGE2**

LOT NUMBER:

75

CIVIC ADDRESS:
6552 WATERDOWN ST.

No.	Description	Date	By
2	REV. AS PER CONST. SUMMARY	AUG23-13	SD
1	REV. AS PER CONST. SUMMARY	JUL24-13	SD
REVISIONS			

Footprint: **S3**

sht. title: **SECTION**

drawn by: **TDS**

checked by: **OF**

date: **FEB. 2007**

scale: **3/16"=1'**

sheet no:

6
6