

DCR PHOENIX HOMES

SHADOW RIDGE 2

LOT #77

MODEL - TUSCANA (S-6)

KITCHEN / VANITIES



MOUNTING HT: 90"

CUSTOMER APPROVAL


I have reviewed these drawings and understand the details of the layout and the Cartier Kitchens specifications.

Signature: *[Signature]*


Date: April 30/13

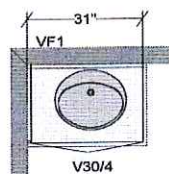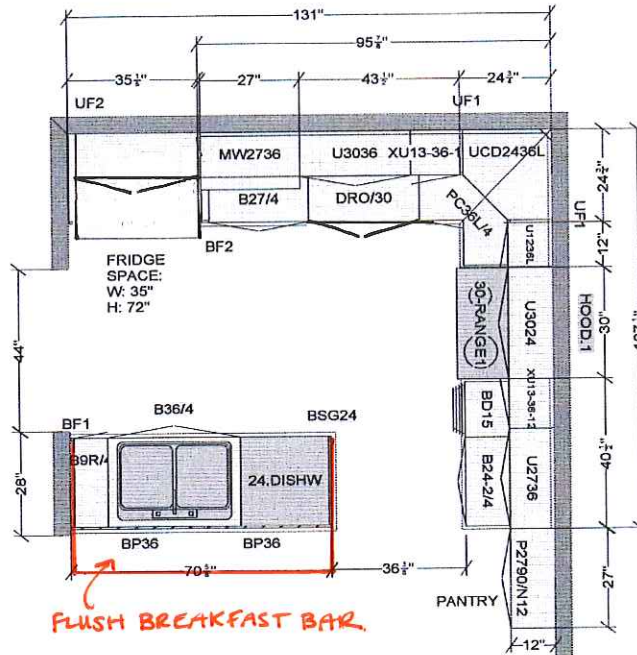

POWDER ROOM

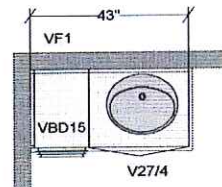

MAIN BATH

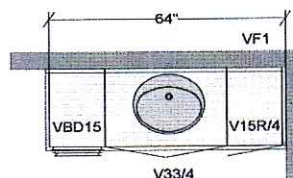

MASTER ENSUITE

All dimensions size designations given are subject to verification on job site and adjustment to fit job conditions.

CARTIER KITCHENS OTTAWA

DCR - #77 SR2 - S6 - TUSCANA



2020 TECHNOLOGIES


This is an original design and must not be released or copied unless applicable fee has been paid or job order placed.

DRAWN BY: LD
CARTIER KITCHENS OTTAWA

Designed: 2/14/2013
Printed: 2/14/2013

All

Drawing #: 1 No Scale.

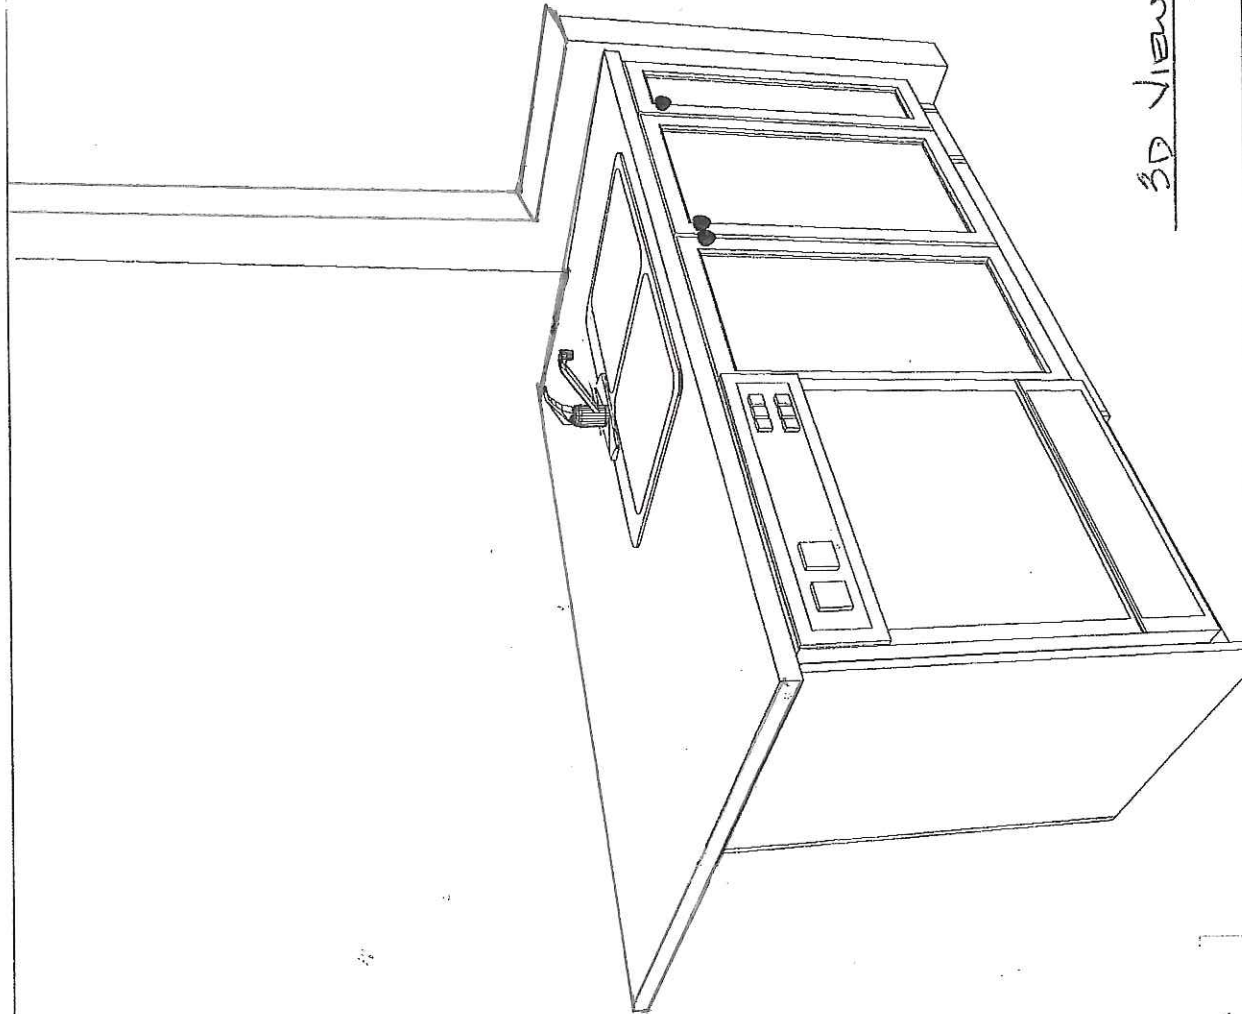

3D View #3

CUSTOMER APPROVAL

I have reviewed these drawings and understand the details of the layout and the Cartier Kitchens specifications.

Signature 

Date April 30/13

Note: This drawing is an artistic interpretation of the general appearance of the design. It is not meant to be an exact rendition.


DESIGNED BY: LORI DISAVERIO.

DCR - #77 SR2 - S6 - TUSCANA



Designed: 2/14/2013
Printed: 2/14/2013

Drawing #: 1

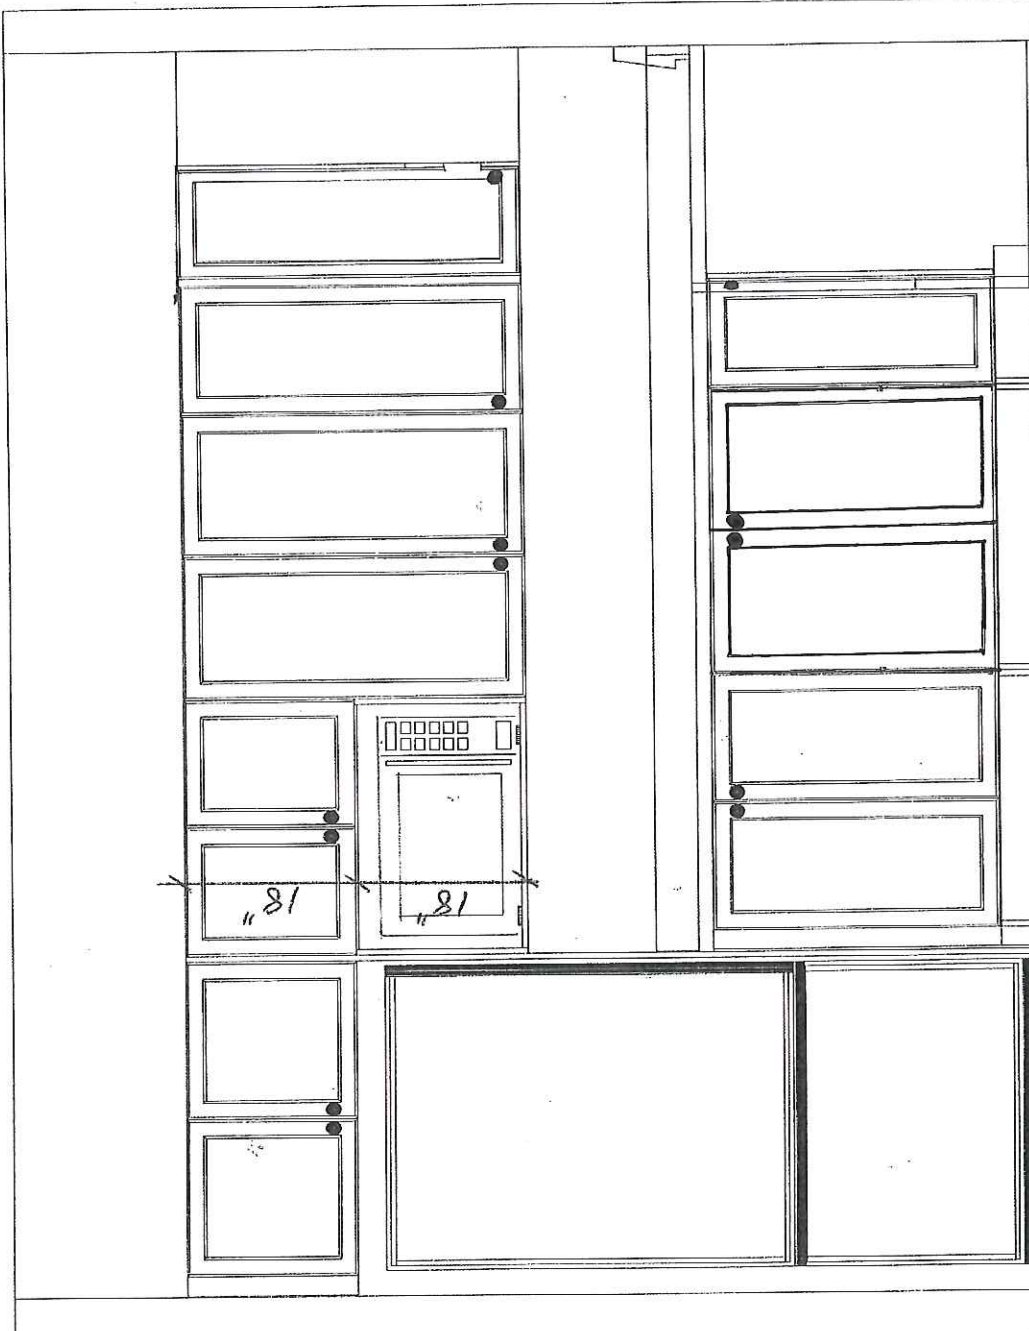

FEIDGE WALL ELEVATION

CUSTOMER APPROVAL

I have reviewed these drawings and understand the details of the layout and the Cartier Kitchens specifications.

Signature *Lori Disaverio*
 Date April 30/13

Note: This drawing is an artistic interpretation of the general appearance of the design. It is not meant to be an exact rendition.


DESIGNED BY: LORI DISAVERIO.
 DCR - #77 SR2 - S6 - TUSCANA



Designed: 2/14/2013
 Printed: 2/14/2013

Drawing #: 1

All

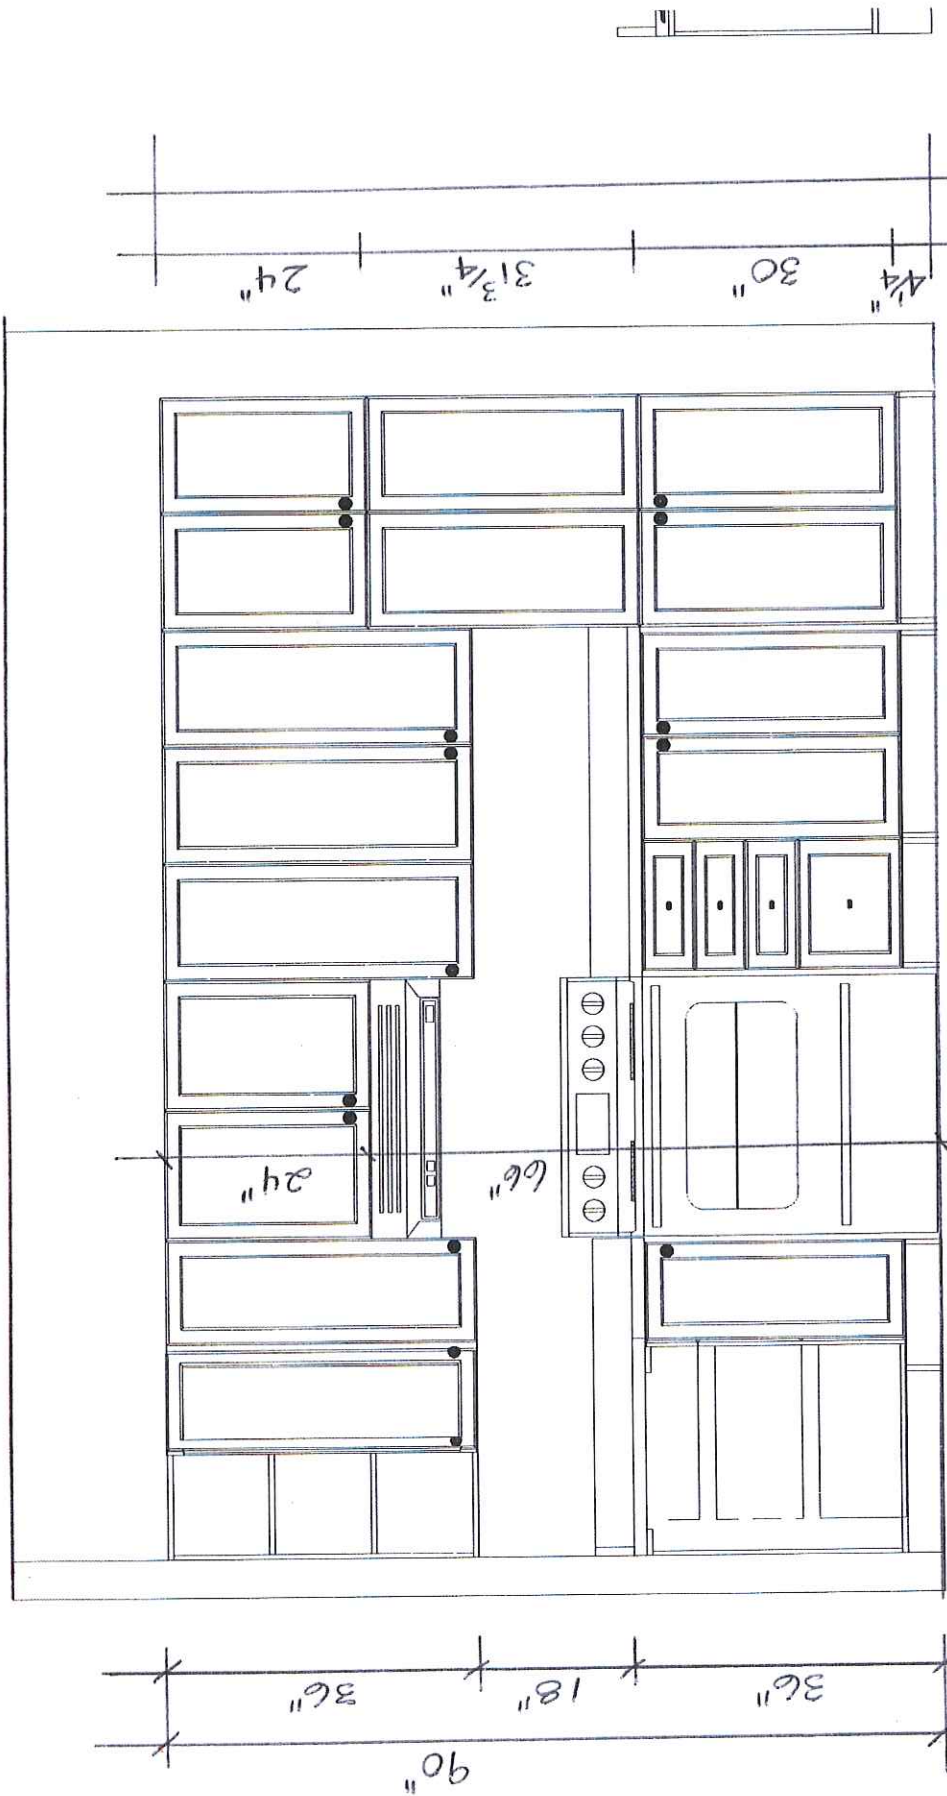

STONE WALL ELEVATION

CUSTOMER APPROVAL

I have reviewed these drawings and understand the details of the layout and the Cartier Kitchens specifications.

Signature *[Signature]*
 Date *April 30/13*

Note: This drawing is an artistic interpretation of the general appearance of the design. It is not meant to be an exact rendition.

DESIGNED BY: LORI DISAVERIO.
 DCR - #77 SR2 - S6 - TUSCANA



Designed: 2/14/2013
 Printed: 2/14/2013

Drawing #: 1