



Contractor must verify all dimensions on the job and report any discrepancy to D.C.R./Phoenix before proceeding with the work. Drawings are NOT to be scaled.

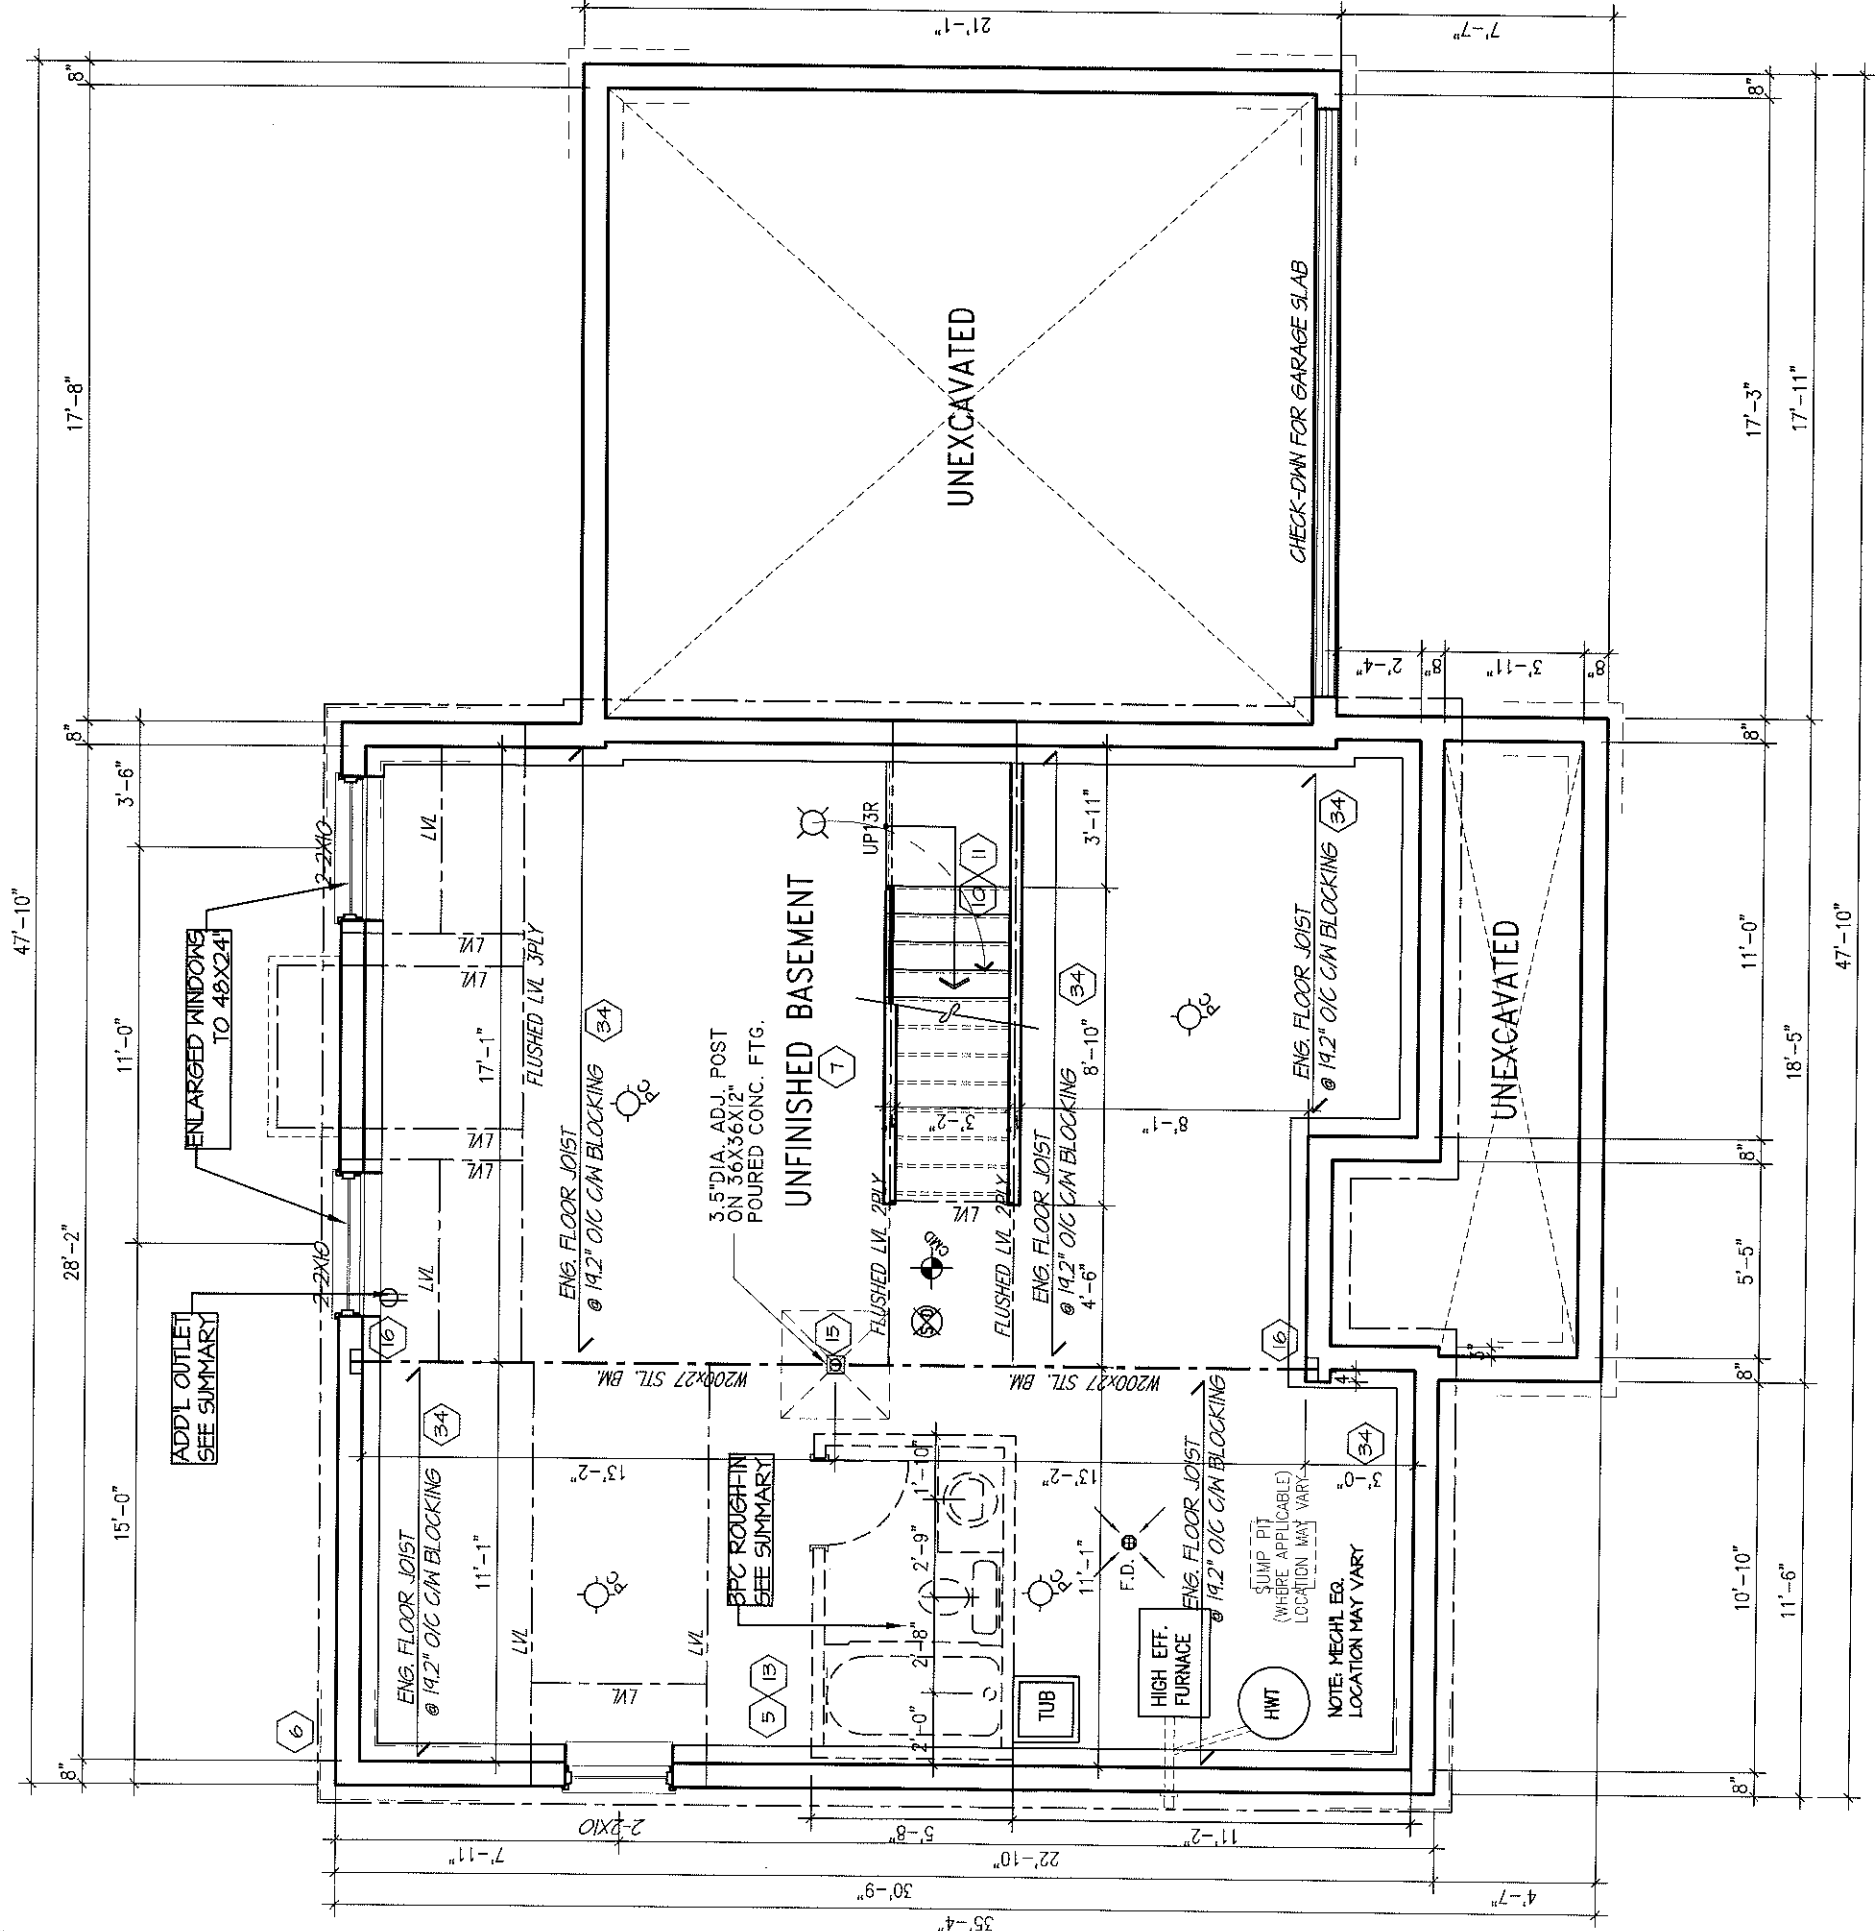

BASEMENT PLAN A

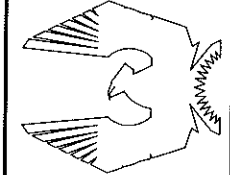

PHOENIX HOMES

TUSCANA-2011-A

SITE: SHADOW RIDGE2

LOT NUMBER:

CIVIC ADDRESS:
6548 WATERDOWN STREET

77


PHOENIX HOMES

No.	Description	Date	By
2	REV. AS PER CONST. SUMMARY	MAY-13	SD
1	REV. AS PER CONST. SUMMARY	APR24-13	SD
REVISIONS			


footprint:	S6
drawn by:	TL
date:	NOV/11
scale:	3/16"=1'-0"
sheet no:	2A 7

NOTE: LOCATIONS AND DIMENSIONS SHOWN FOR
POTLIGHTS ARE APPROXIMATE AND MAY BE
ADJUSTED PER SITE CONDITIONS.

Contractor must verify all dimensions on the job and report any
discrepancy to D.C.R./Phoenix before proceeding with the work.
Drawings are NOT to be scaled.

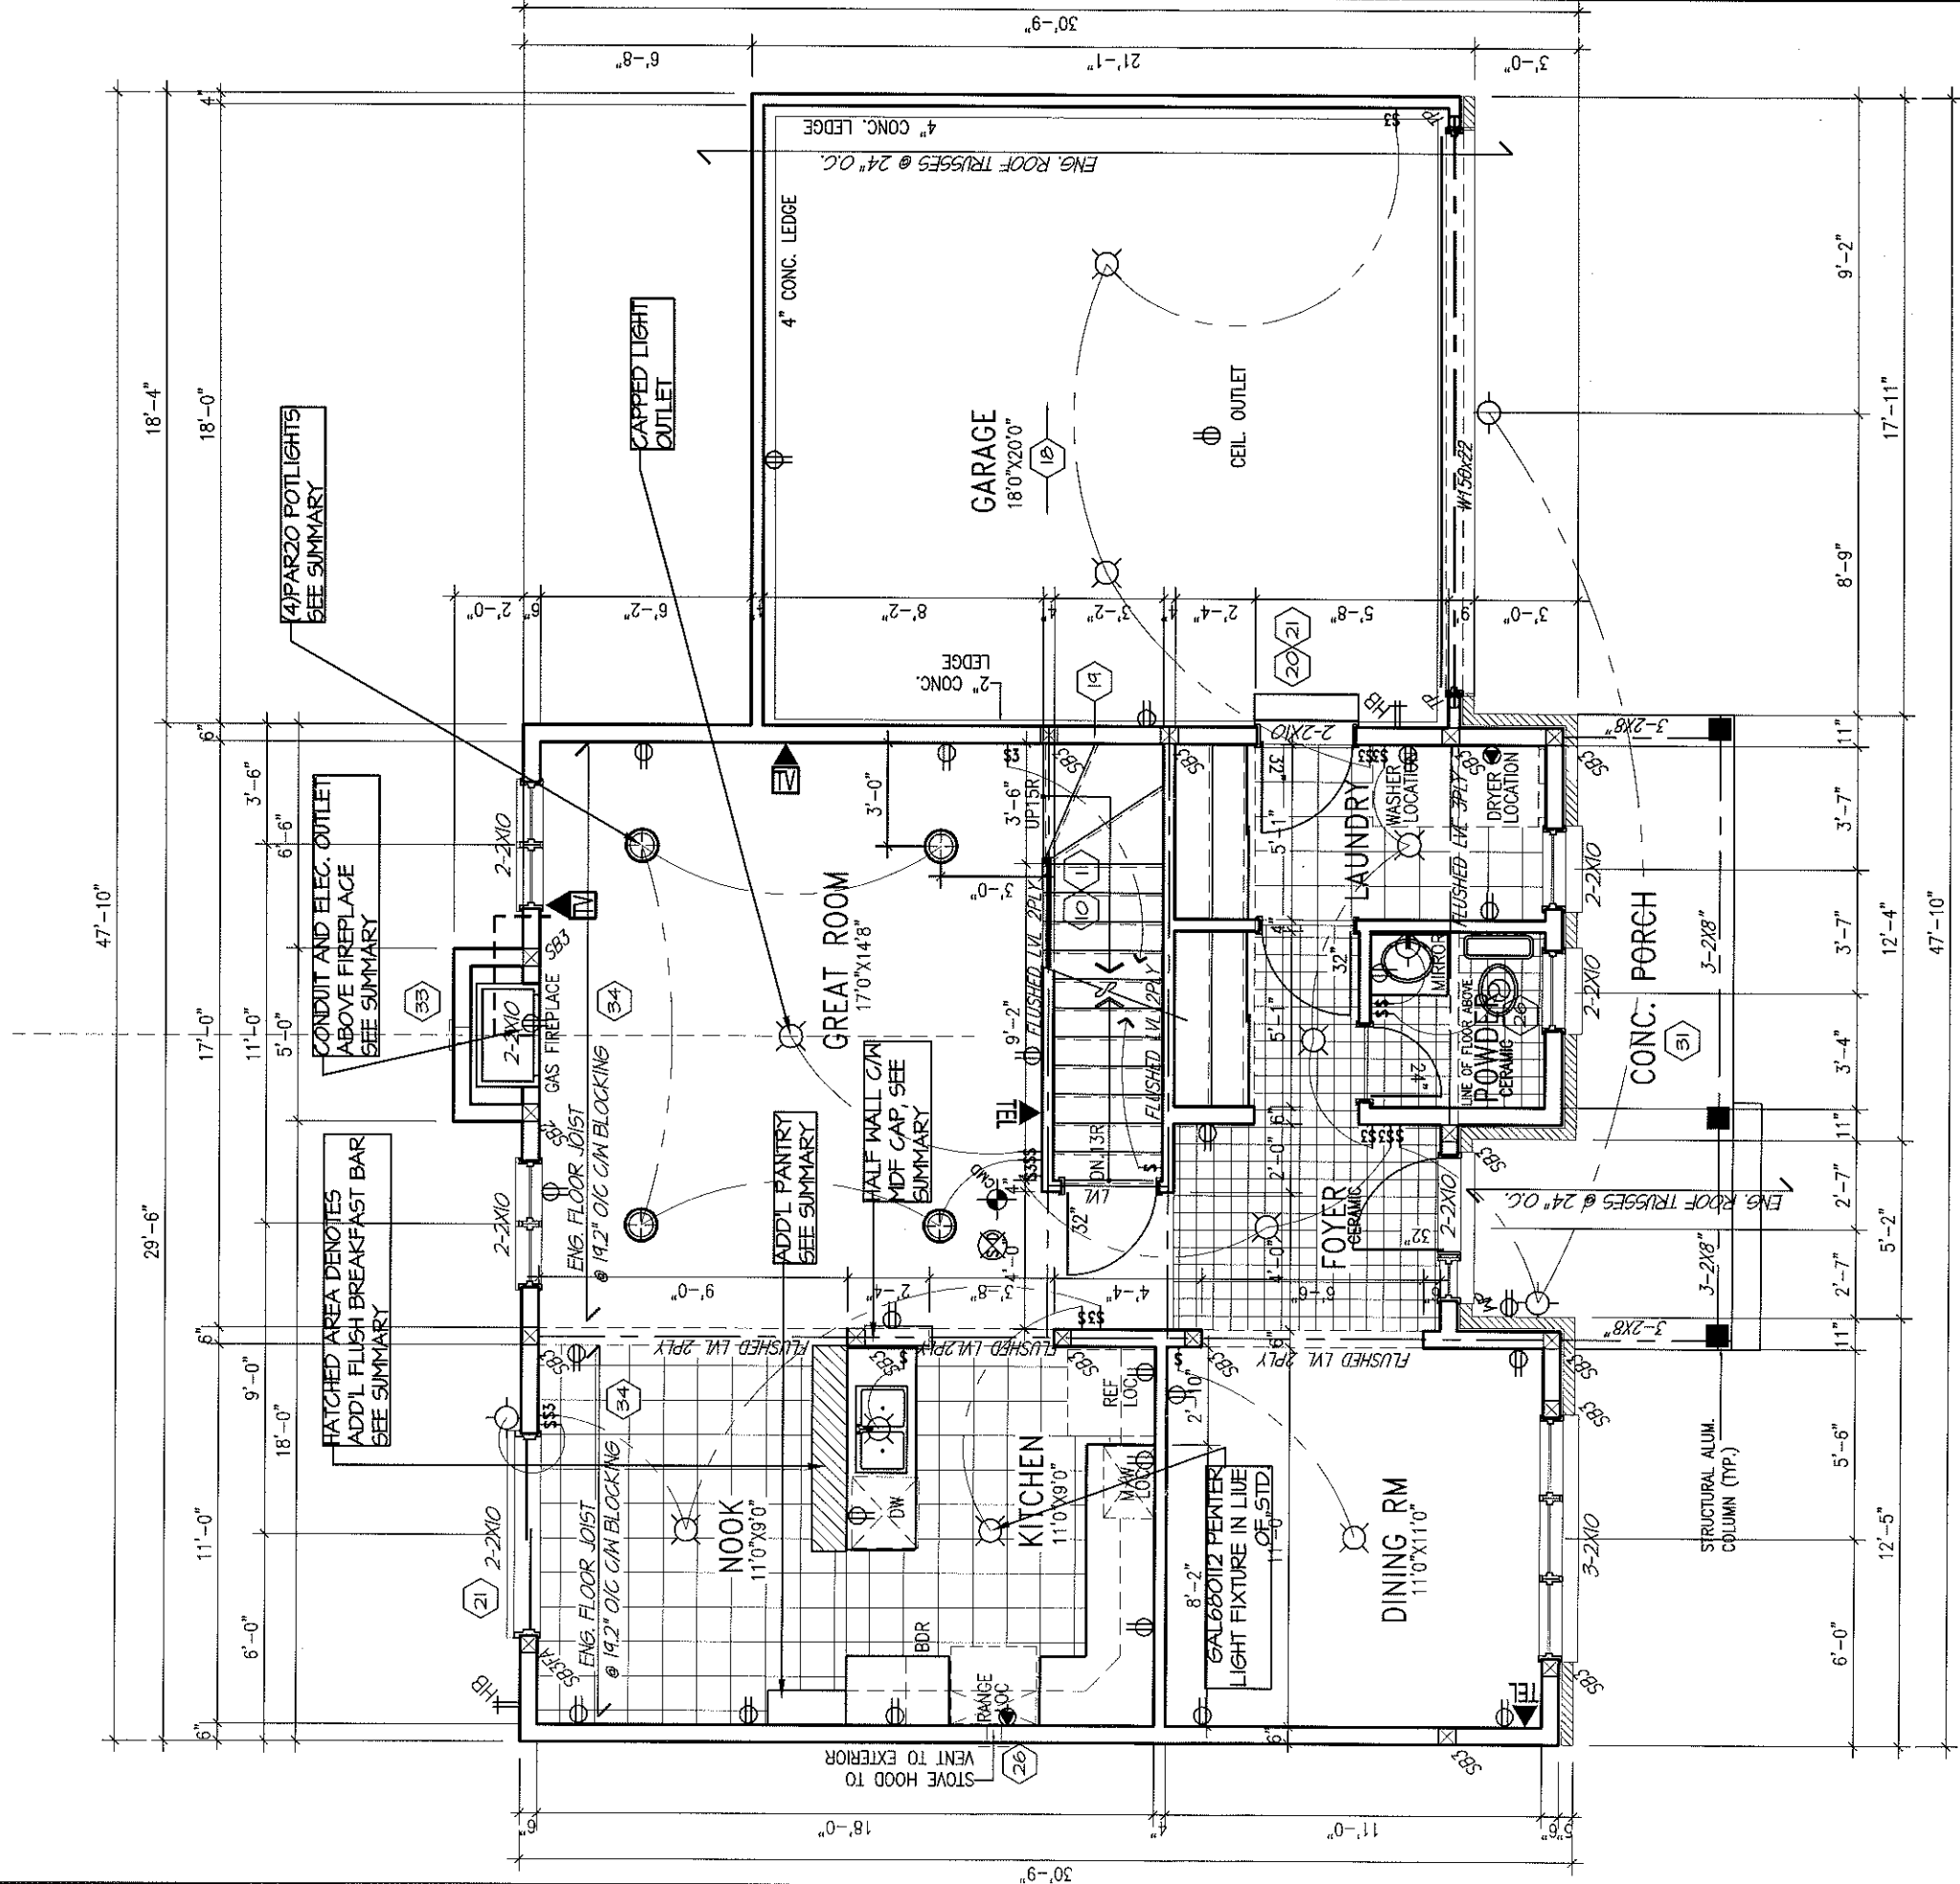

GROUND FLOOR PLAN A
898 SQ FT

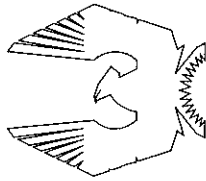

PHOENIX HOMES

TUSCANA-2011-A

SITE: **SHADOW RIDGE 2**

LOT NUMBER:


77

CIVIC ADDRESS:
6548 WATERDOWN STREET


footprint:	S6
drawn by:	TL
date:	NOV/11
scale:	3/16"=1'-0"
sheet no:	3A 7

No.	Description	Date	By
2	REV. AS PER CONST. SUMMARY	MAY-13	SD
1	REV. AS PER CONST. SUMMARY	APR-13	SD

Contractor must verify all dimensions on the job and report any discrepancy to D.C.R./Phoenix before proceeding with the work. Drawings are NOT to be scaled.

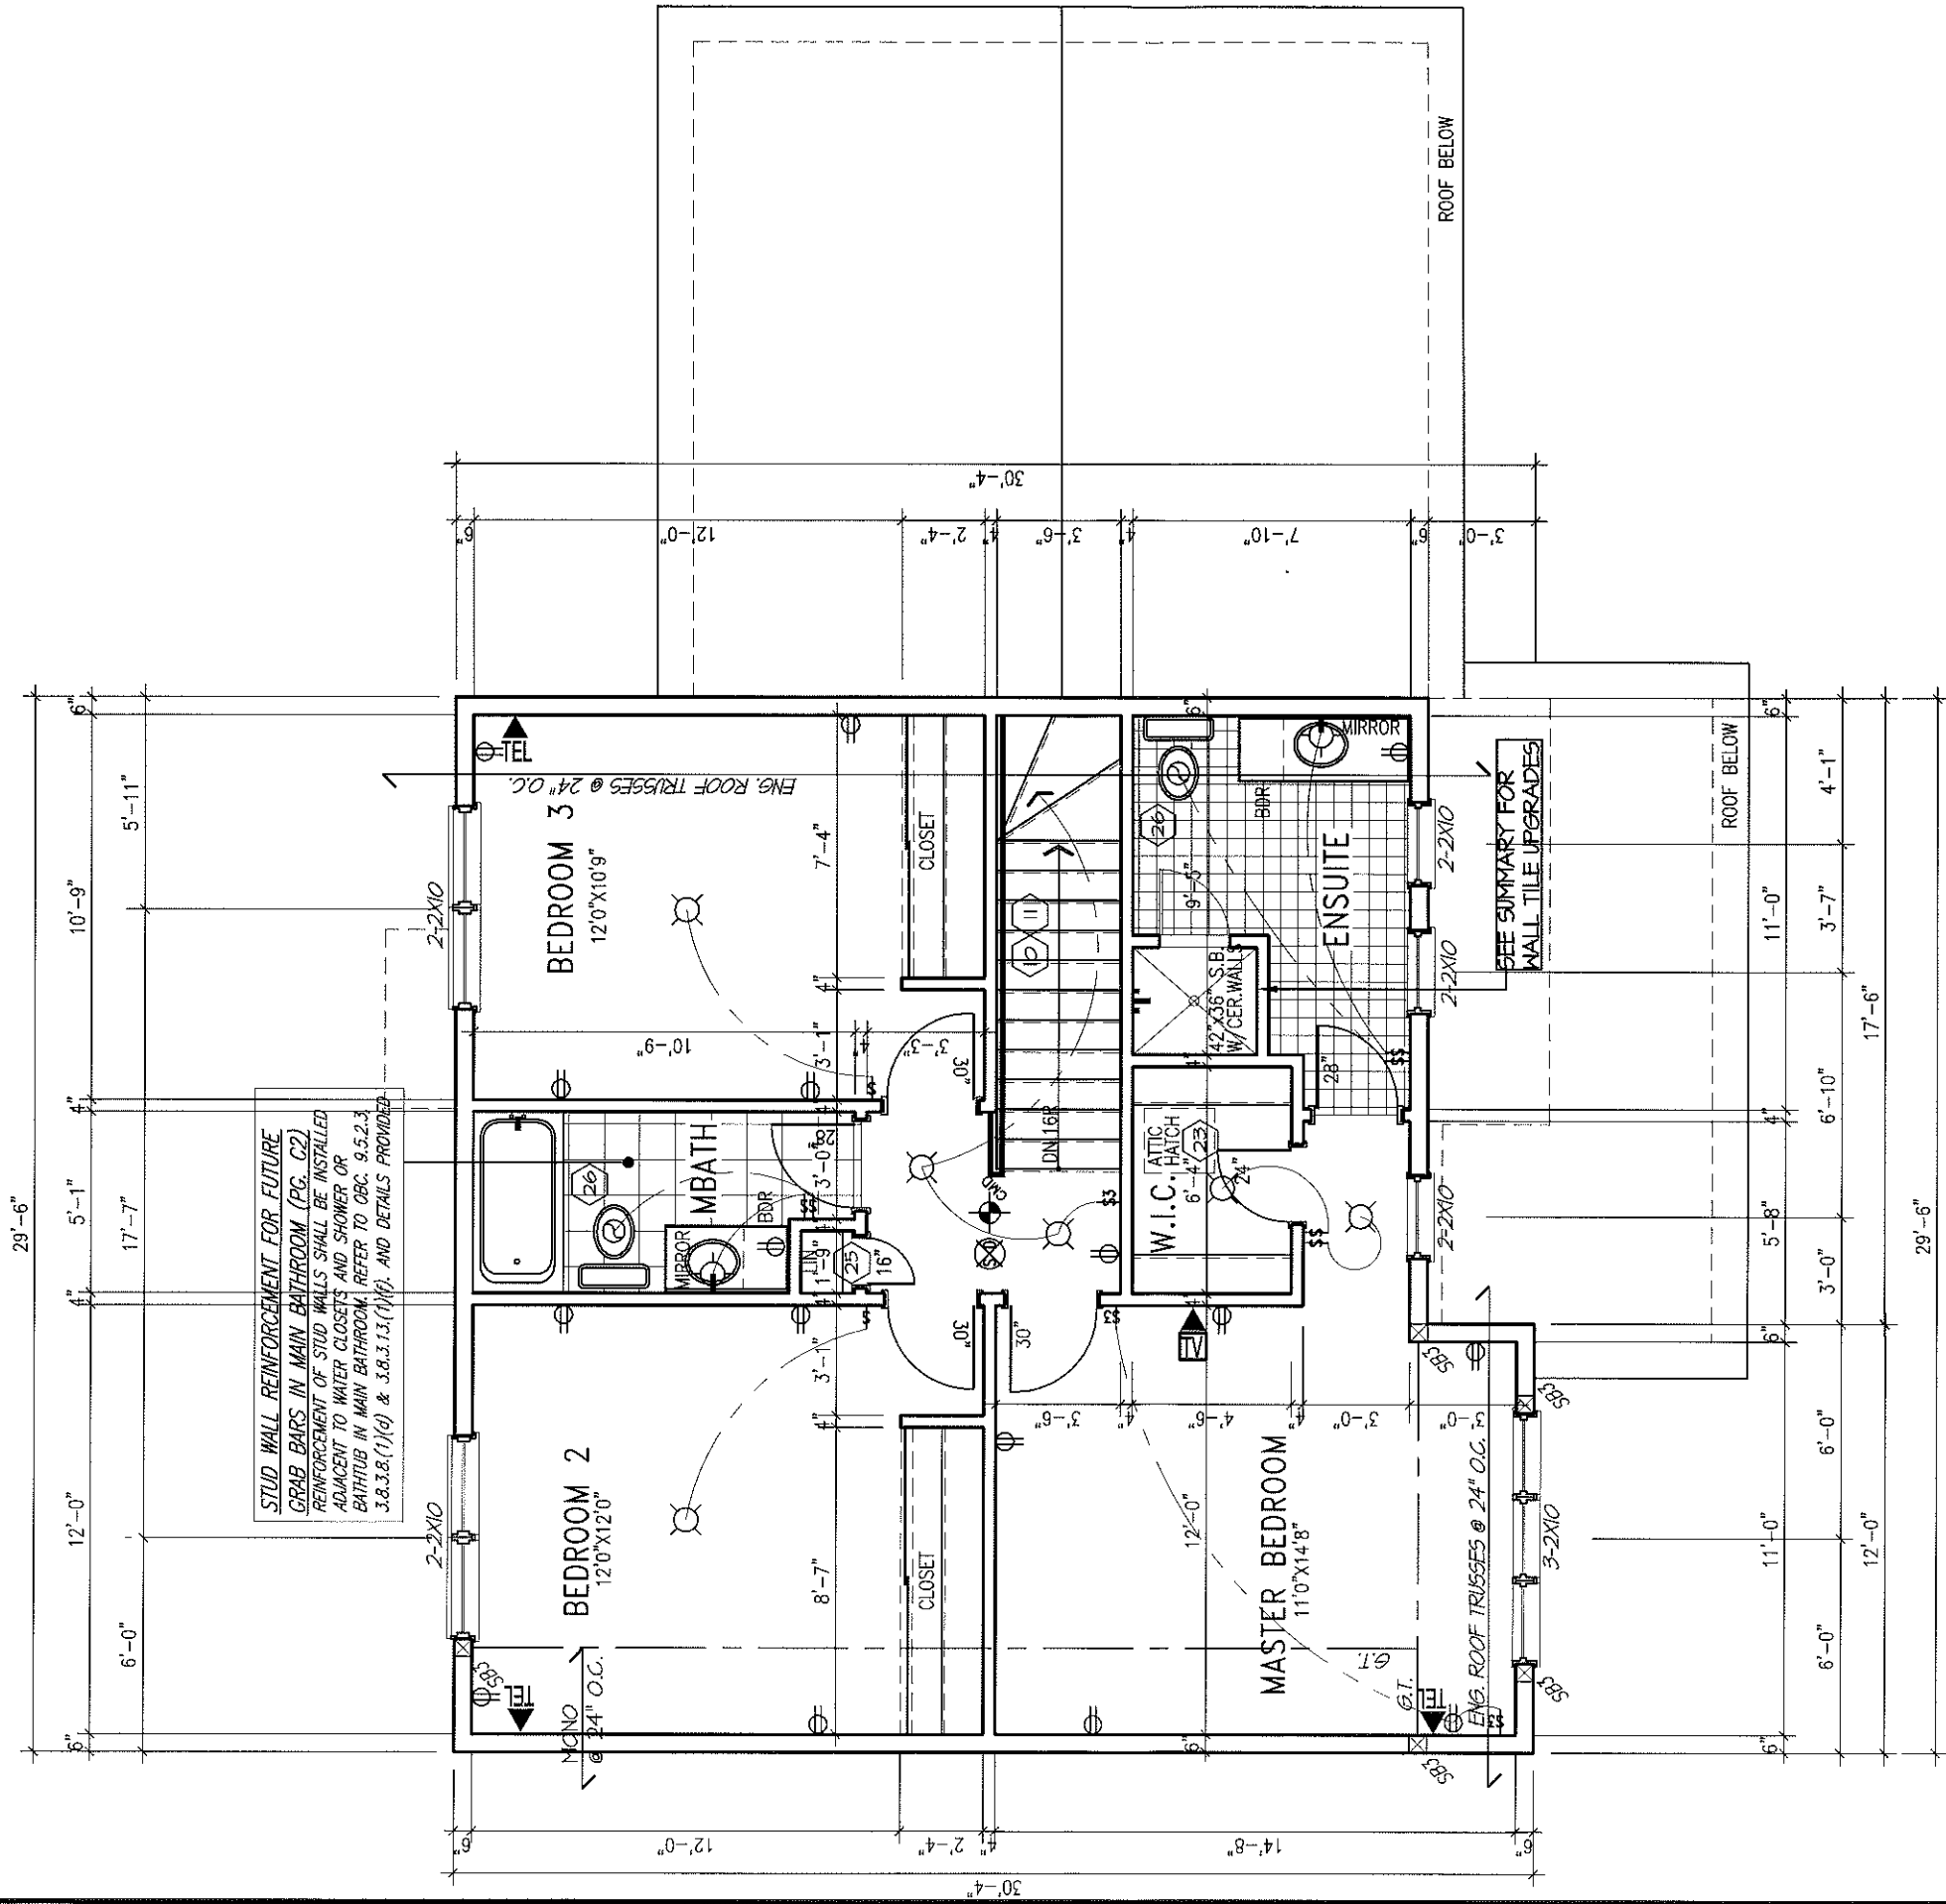

SECOND FLOOR PLAN A
842 SQ FT

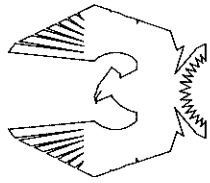

PHOENIX HOMES

TUSCANA-2011-A

SITE: SHADOW RIDGE 2

LOT NUMBER:

CIVIC ADDRESS:
6548 WATERDOWN STREET

22

No.	Description	By
2	REV. AS PER CONST. SUMMARY	MAY-13 SD
1	REV. AS PER CONST. SUMMARY	APR24-13 SD
		Date

REVISIONS

footprint: 56

drawn by: TL...

date: NOV/11

scale: $3/16" = 1'-0"$

sheet no:

