

DCR PHOENIX HOMES

SHADOW RIDGE 2

LOT #78

PLATINA (512)

KITCHEN

CUSTOMER APPROVAL


I have reviewed these drawings and understand the details of the layout and the Cartier Kitchens specifications.

Signature [Signature]

Date April 6/13

MOUNTING HT: 96"

PLUS ~~2" CROWN MOULDING~~

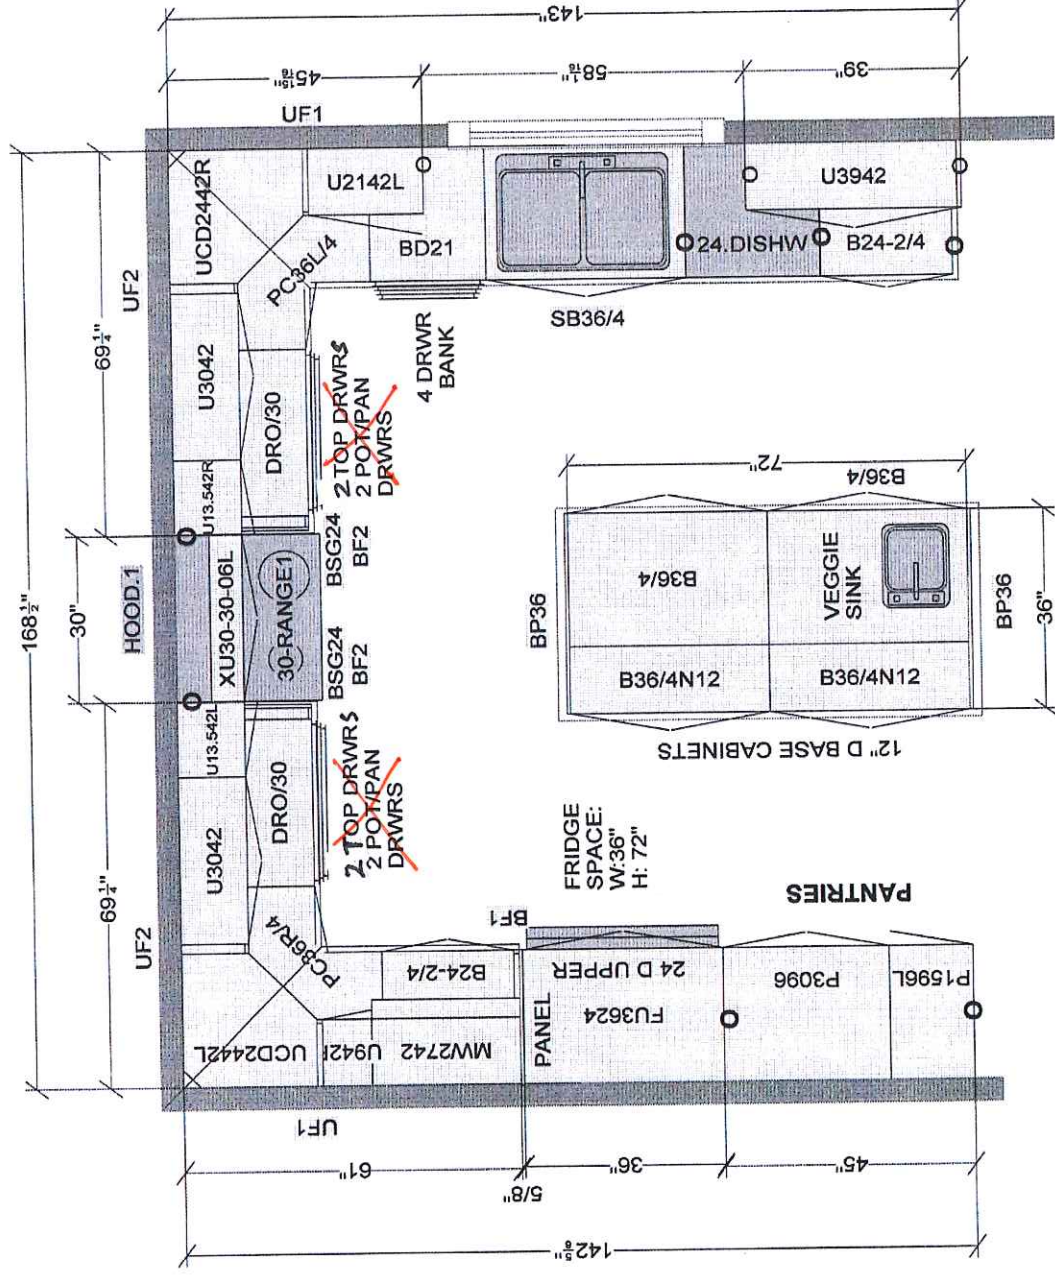

NOTE: LENGTH OF ISLAND CABINETS
EXTENDED BY 12"
(EATING BAR OVERHANG ELIMINATED)

All dimensions size designations given are subject to verification on job site and adjustment to fit job conditions.

CARTIER KITCHENS OTTAWA




DRAWN BY: LD
CARTIER KITCHENS OTTAWA

This is an original design and must not be released or copied unless applicable fee has been paid or job order placed.

Designed: 11/25/2012
Printed: 11/25/2012

DCR - #78 SR2 - PLATINA (512) - RIGHT- KITCHEN

Drawing #: 1 No Scale.

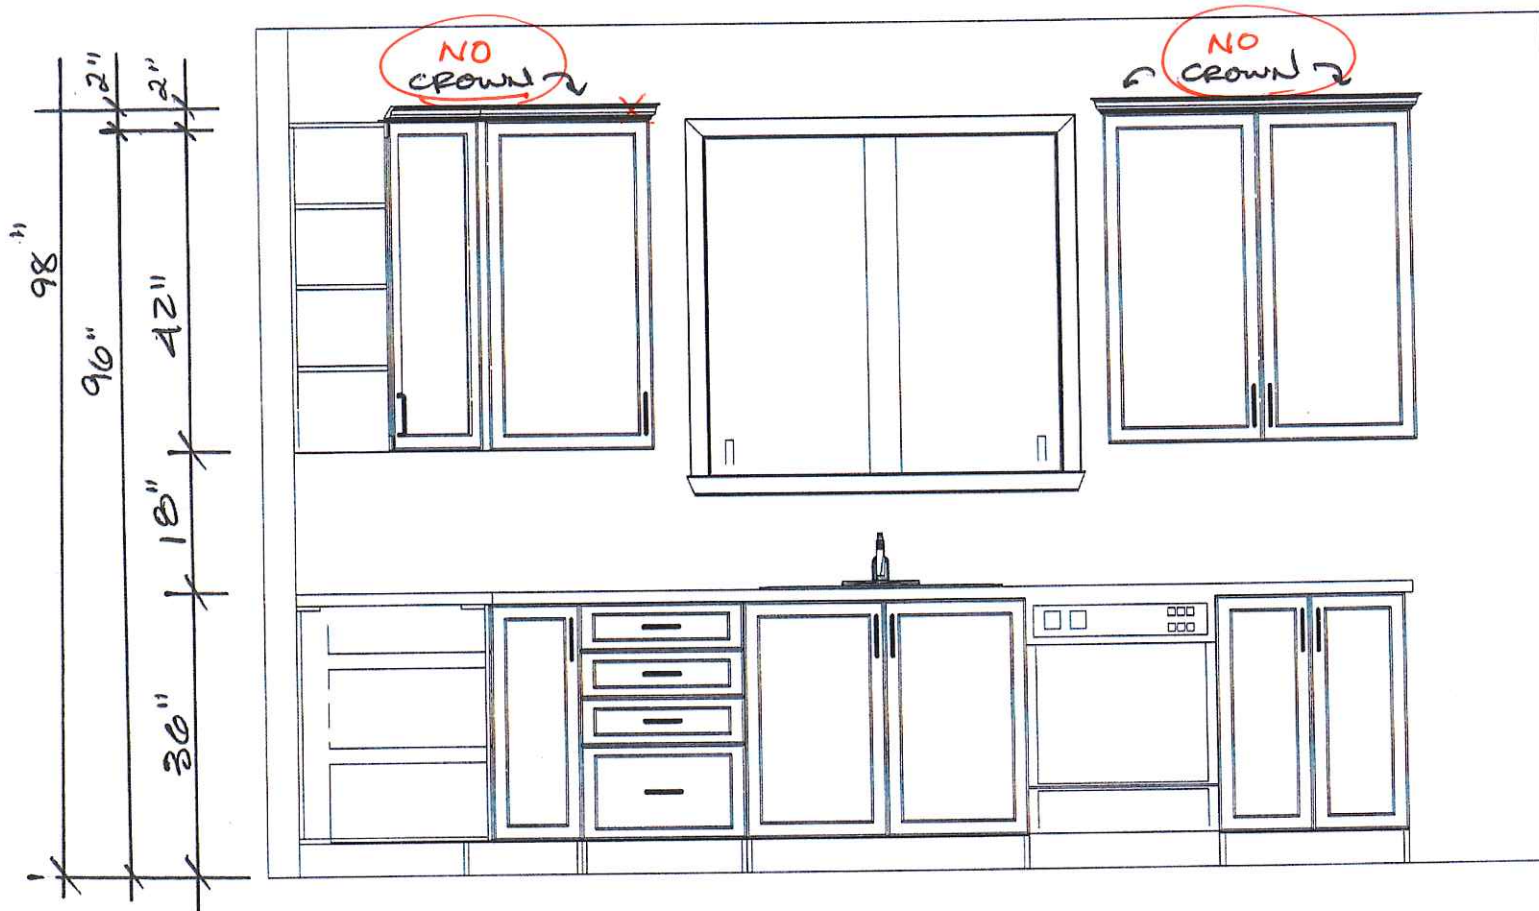

SINK WALL ELEVATION

CUSTOMER APPROVAL

I have reviewed these drawings and understand the details of the layout and the Cartier Kitchens specifications.

Signature (x) [Signature]

Date April 6/13

Note: This drawing is an artistic interpretation of the general appearance of the design. It is not meant to be an exact rendition.

DESIGNED BY: LORI DISAVERIO.

DCR - #78 SR2 - PLATINA (512) - RIGHT-




Designed: 11/25/2012
Printed: 11/25/2012

All

Drawing #: 1

98"
76"
42"
18"
36"

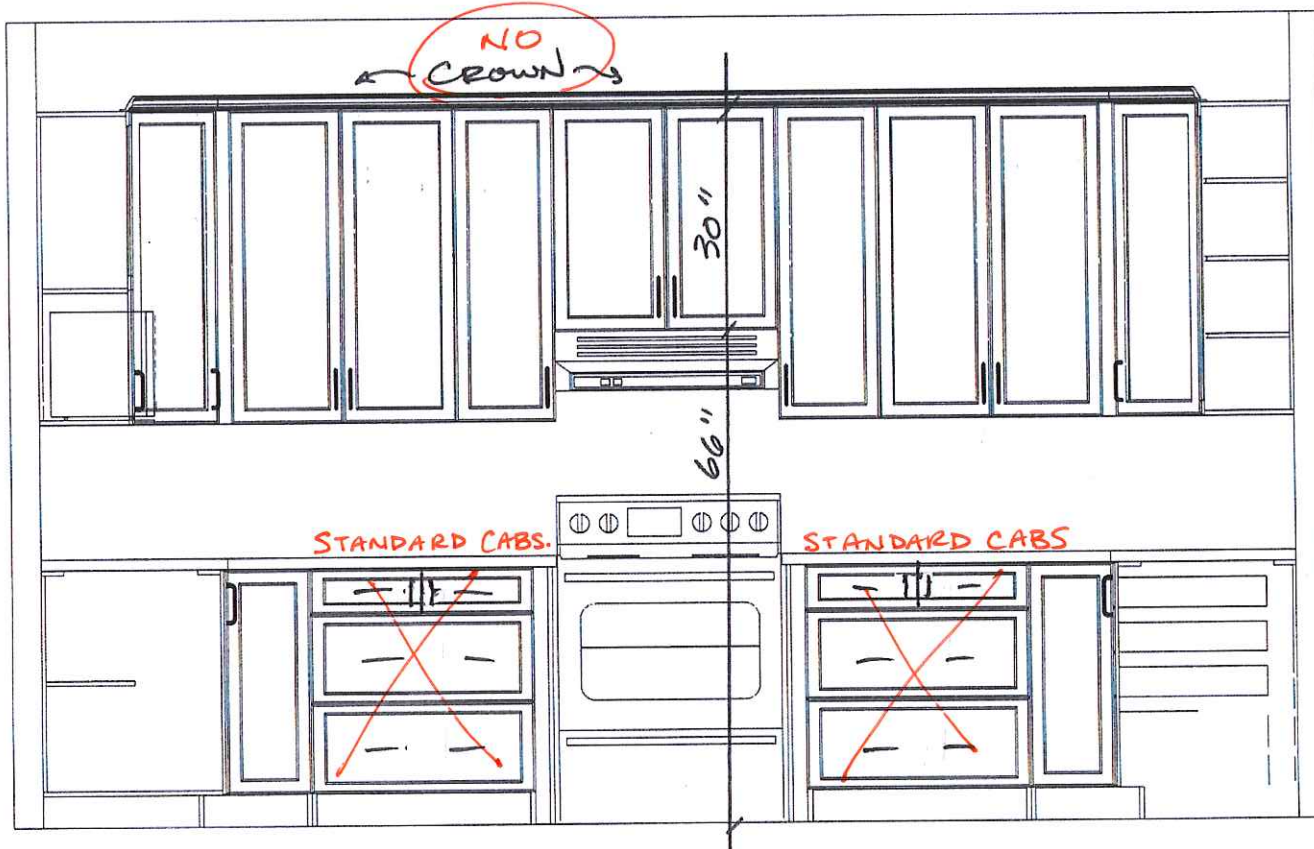

SIDE WALL ELEVATION

CUSTOMER APPROVAL

I have reviewed these drawings and understand the details of the layout and the Cartier Kitchens specifications.

Signature 
Date April 6/13

Note: This drawing is an artistic interpretation of the general appearance of the design. It is not meant to be an exact rendition.




Designed: 11/25/2012
Printed: 11/25/2012

DESIGNED BY: LORI DISAVERIO.
DCR - #78 SR2 - PLATINA (512) - RIGHT-

All

Drawing #: 1

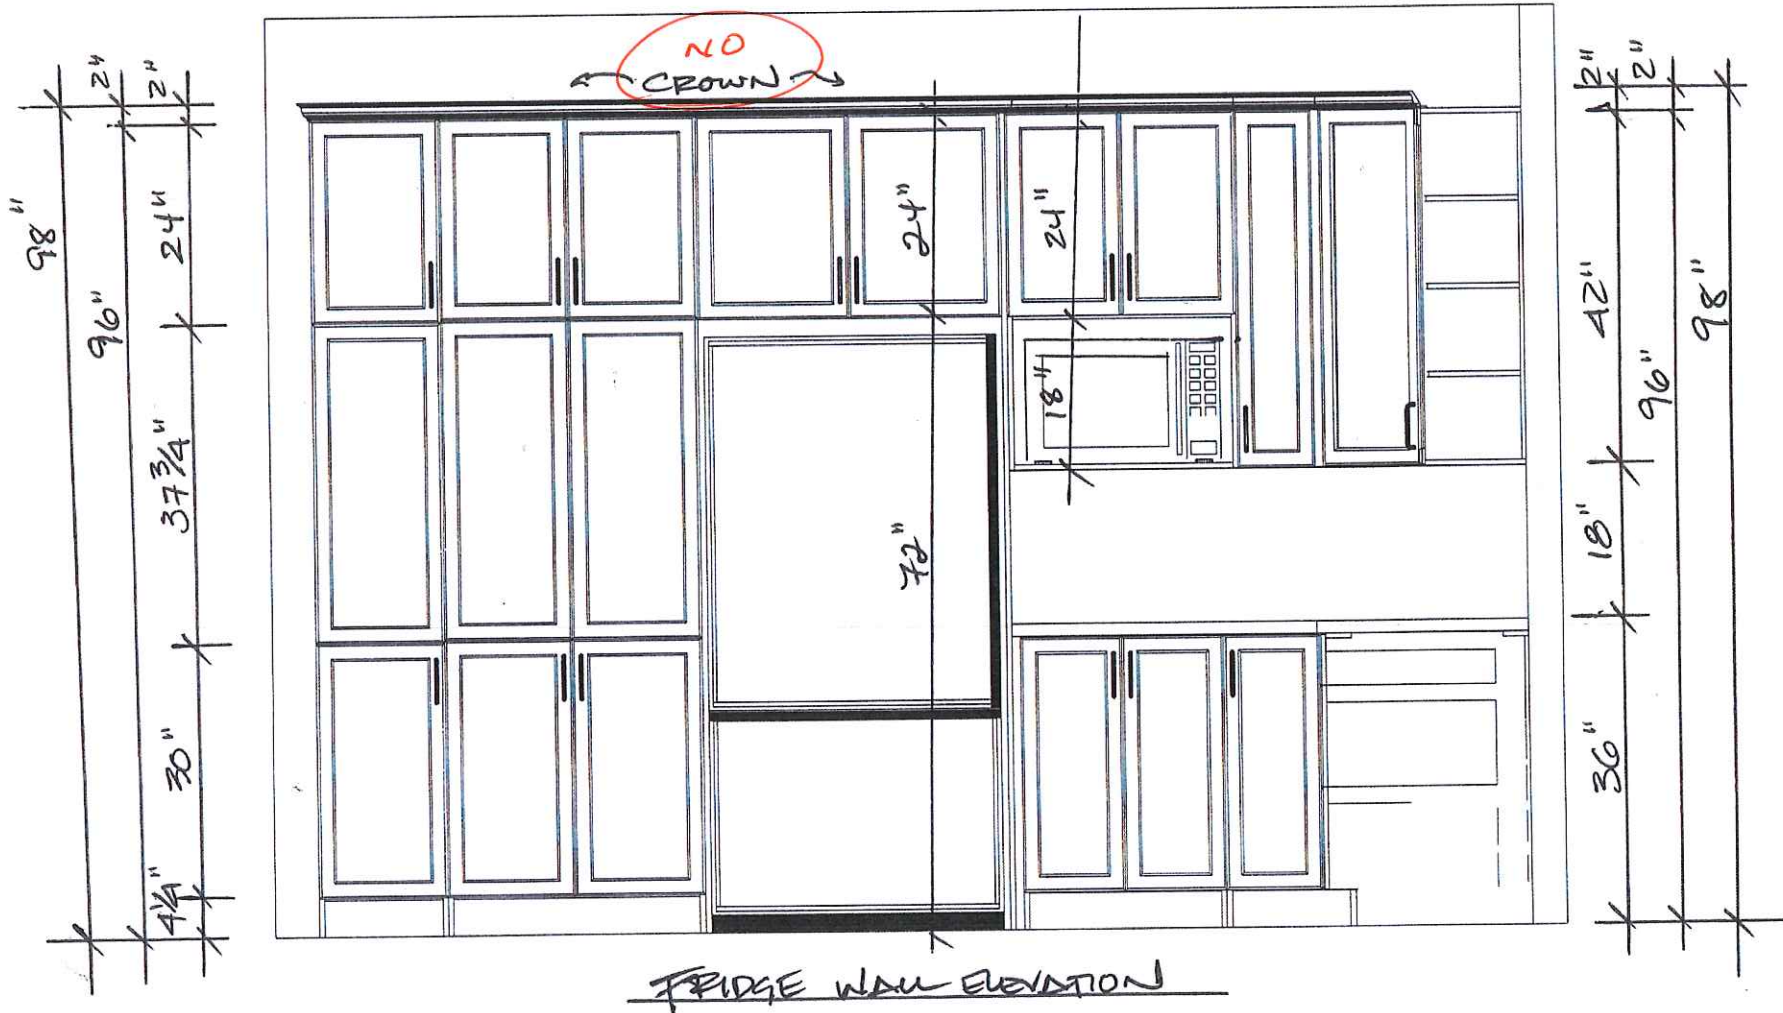

CUSTOMER APPROVAL

I have reviewed these drawings and understand the details of the layout and the Cartier Kitchens specifications.

Signature: (x) [Signature]
 Date: April 6/13

Note: This drawing is an artistic interpretation of the general appearance of the design. It is not meant to be an exact rendition.




Designed: 11/25/2012
 Printed: 11/25/2012

DESIGNED BY: LORI DISAVERIO.
 DCR - #78 SR2 - PLATINA (512) - RIGHT-

All

Drawing #: 1

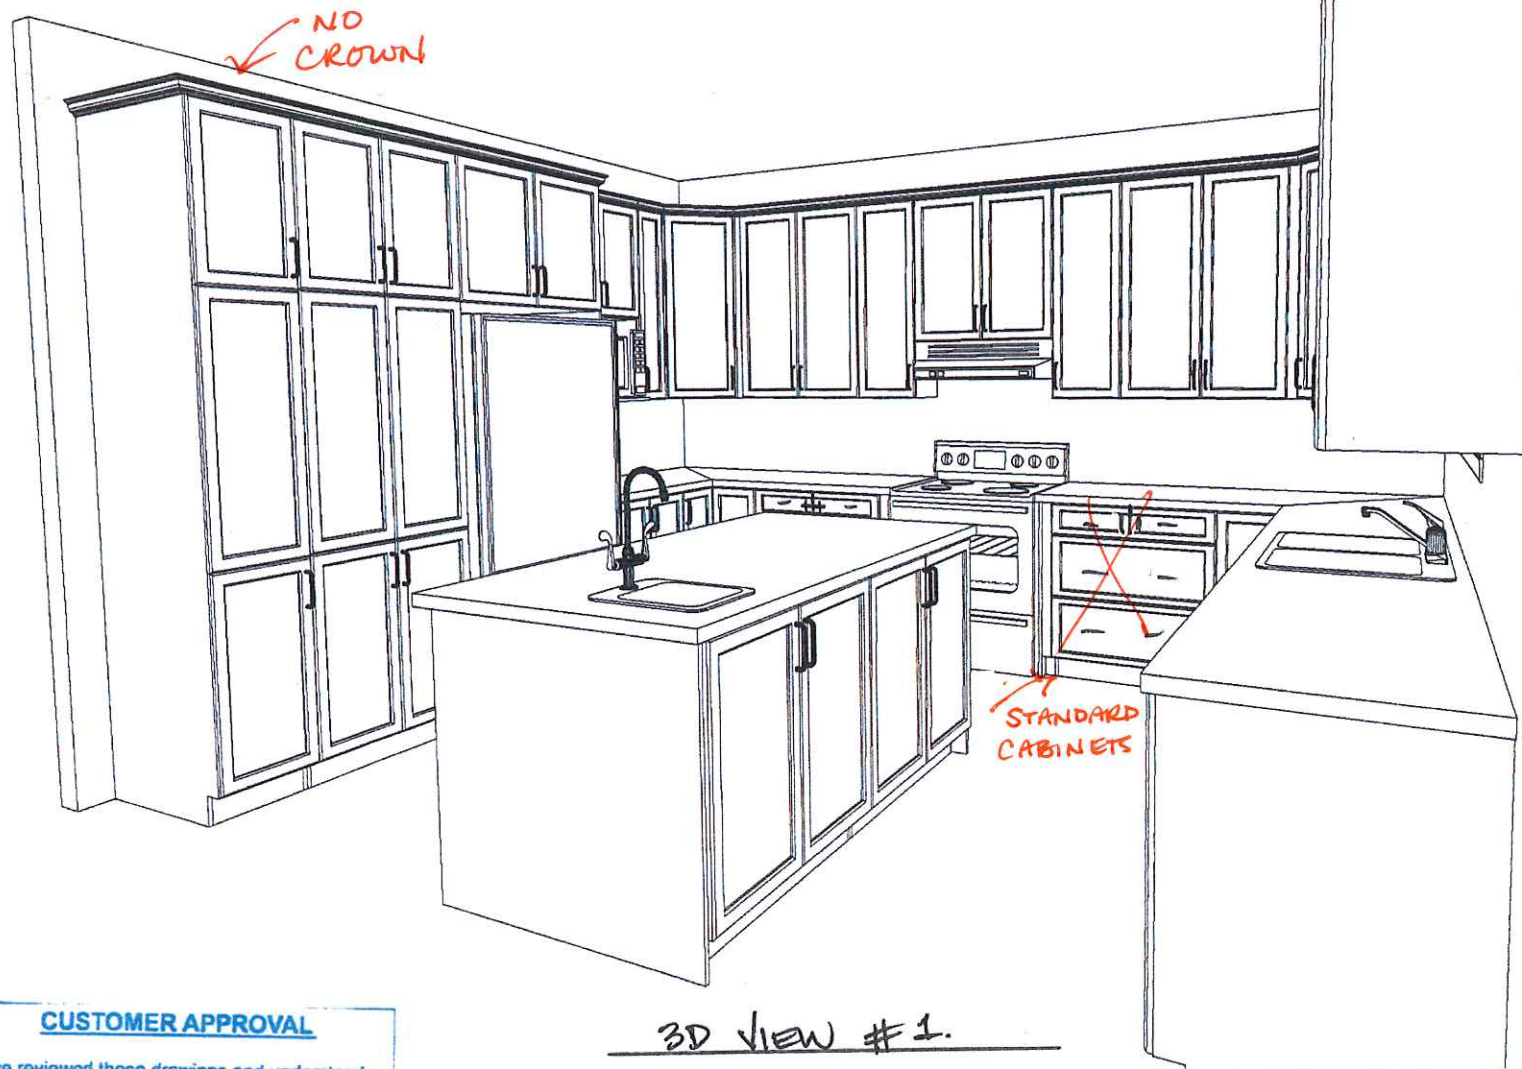

CUSTOMER APPROVAL

I have reviewed these drawings and understand the details of the layout and the Cartier Kitchens specifications.

Signature

[Signature]

Date

April 16/13

3D VIEW #1.

Note: This drawing is an artistic interpretation of the general appearance of the design. It is not meant to be an exact rendition.

DESIGNED BY: LORI DISAVERIO.


DCR - #78 SR2 - PLATINA (512) - RIGHT-



Designed: 11/25/2012
Printed: 11/25/2012

All

Drawing #: 1

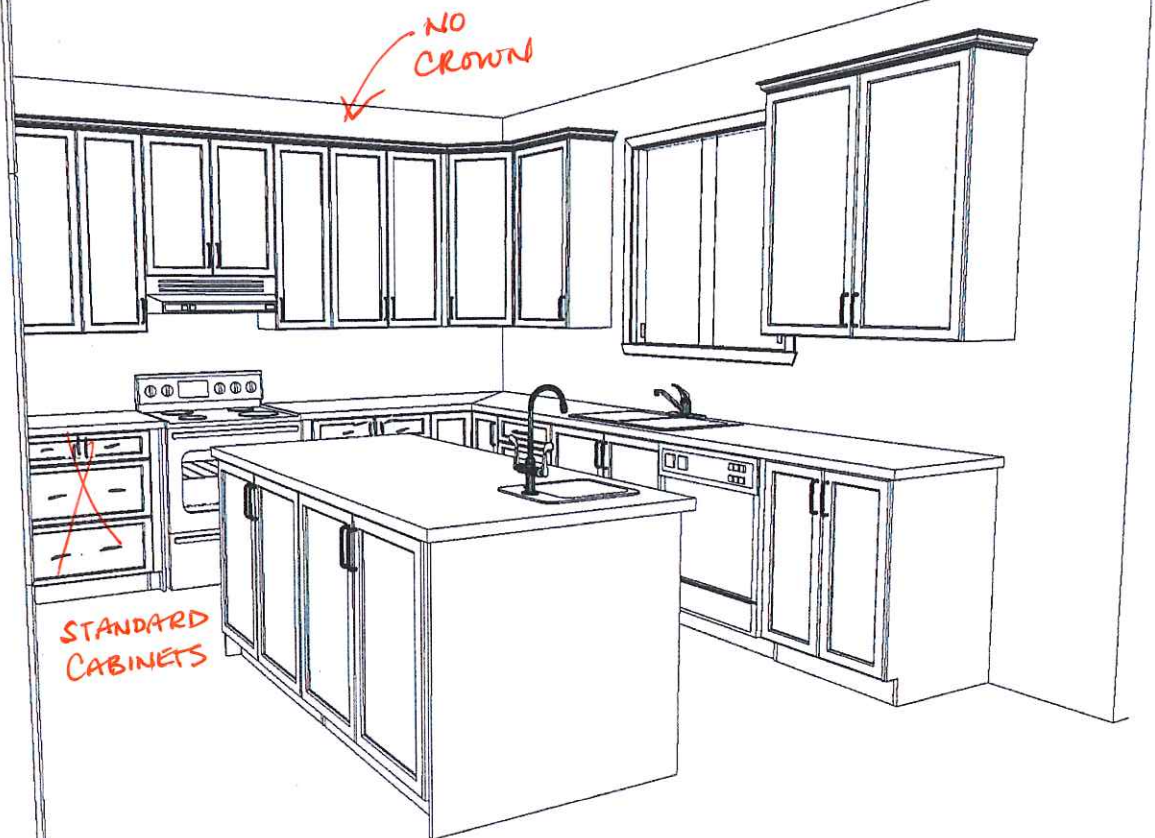

3D View # 2

CUSTOMER APPROVAL

I have reviewed these drawings and understand the details of the layout and the Cartier Kitchens specifications.

Signature (x) [Signature]
Date April 6/13

Note: This drawing is an artistic interpretation of the general appearance of the design. It is not meant to be an exact rendition.



Designed: 11/25/2012
Printed: 11/25/2012

DESIGNED BY: LORI DISAVERIO,
DCR - #78 SR2 - PLATINA (512) - RIGHT-

All

Drawing #: 1