

STONE DESIGN
CONCEPTS

DCFR PHOENIX HOMES

SHADOW RIDGE 2

LOT #79

MODEL - GREGORIAN (S1)


KITCHEN

CUSTOMER APPROVAL

I have reviewed these drawings and understand the details of the layout and the Cartier Kitchens specifications.

Signature *[Signature]*

Date *04/05/2012*

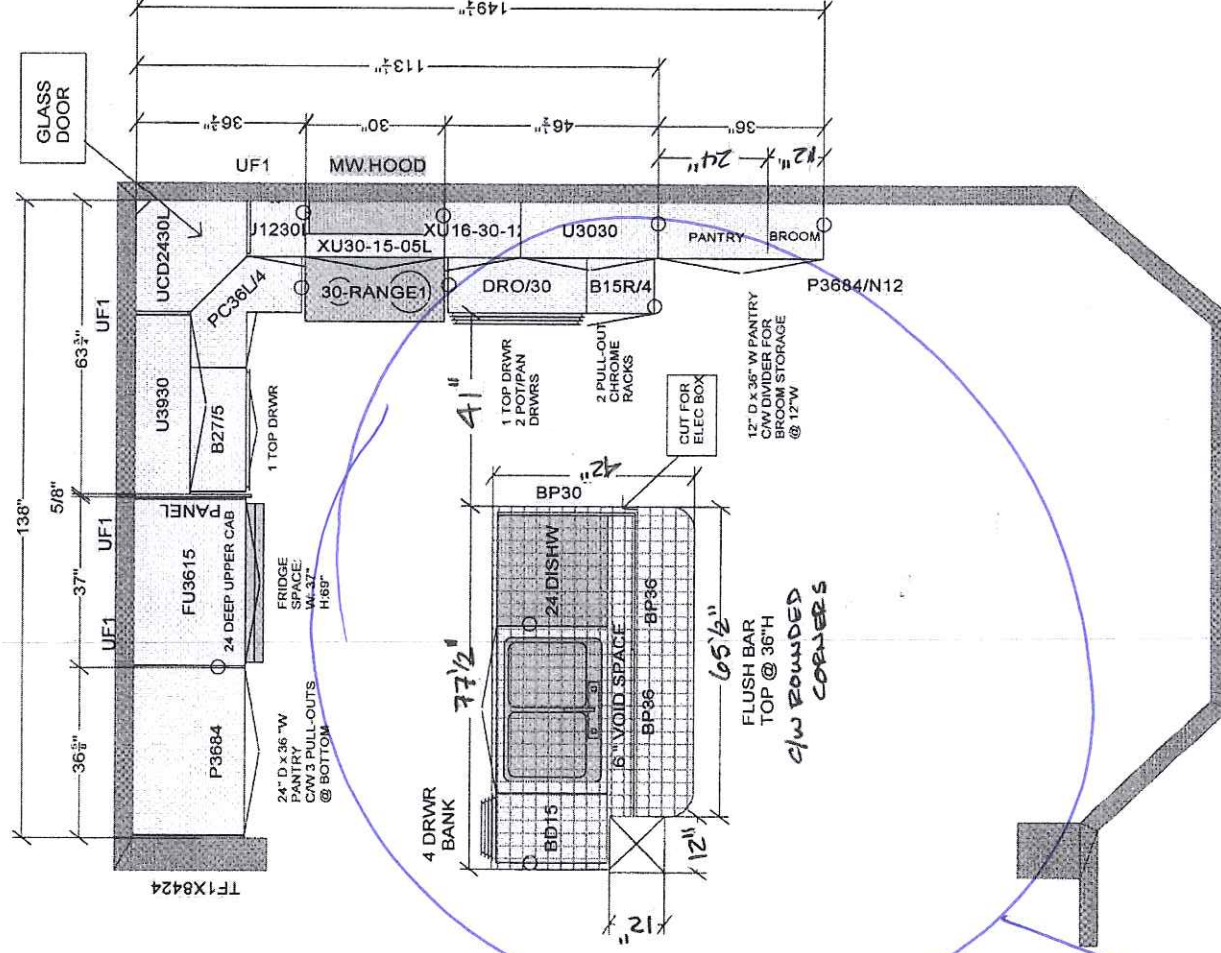

All dimensions, size designations given are subject to verification on job site and adjustment to fit job conditions.

CARTIER KITCHENS OTTAWA

DCR - #79 SR - Kitchen



2020 TECHNOLOGIES

This is an original design and must not be released or copied unless applicable fee has been paid or job order placed.

DRAWN BY: LD
CARTIER KITCHENS OTTAWA

All

Drawing #: 1 | No Scale.

Designed: 10/4/2012
Printed: 10/4/2012

for granite shop.