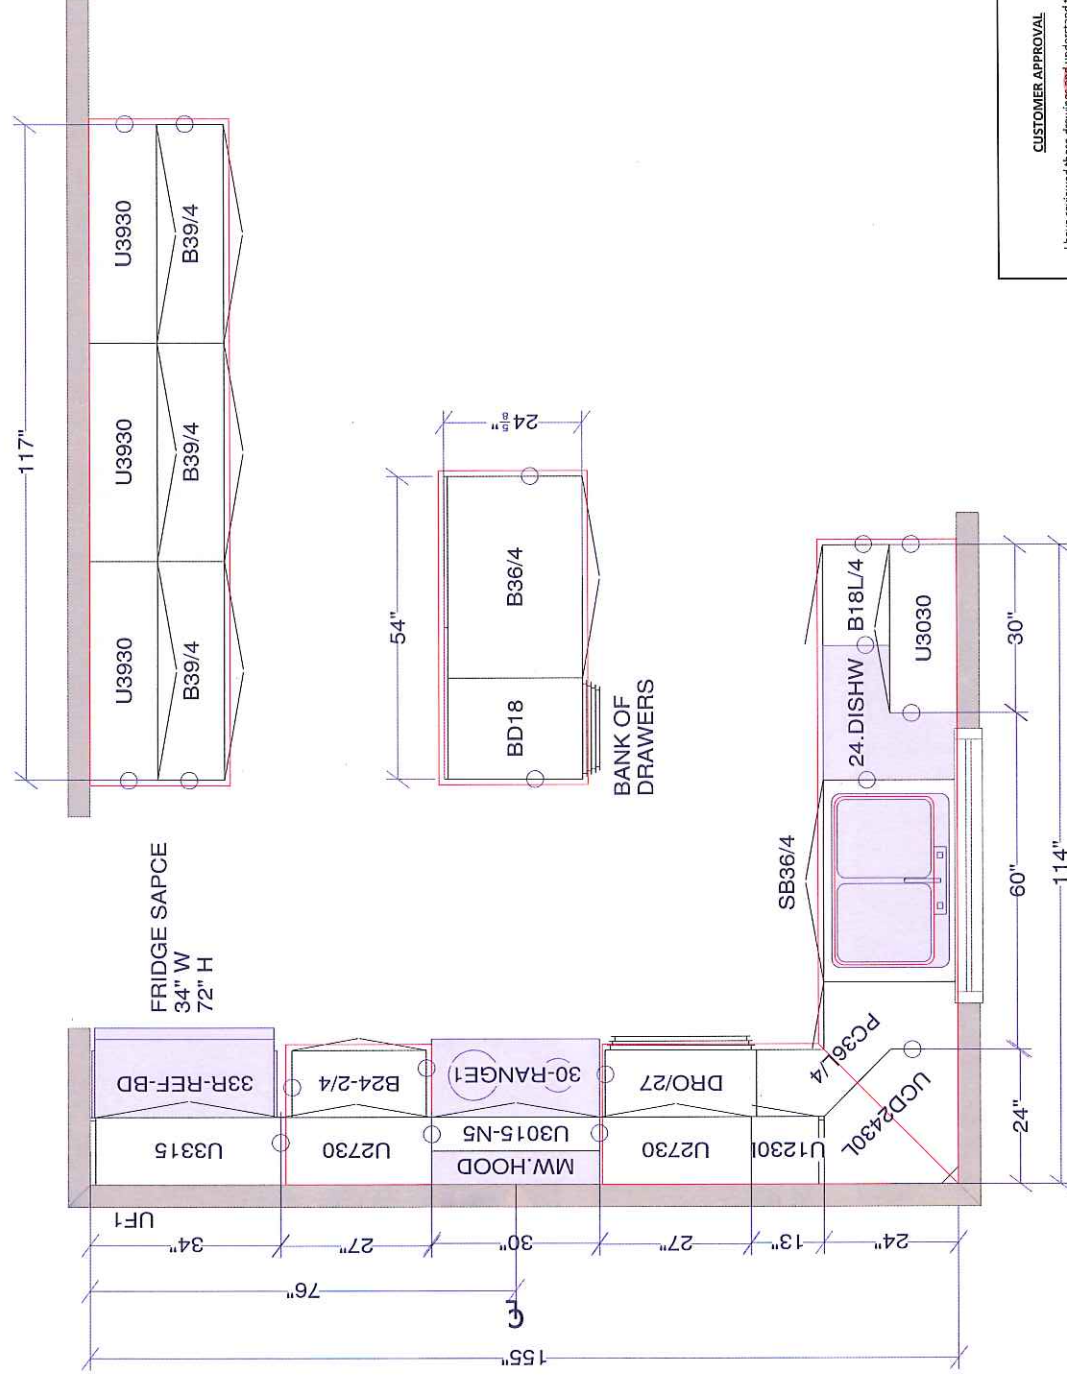


50

KITCHEN

84 =

~~4 PCS - RECESSED LIGHT VALANCE~~

Date A

Drawing #: 1	No Scale
--------------	----------

I have reviewed these drawings and understand the details of the design and the Cartier Kitchens specifications

Signature *[Signature]* Date 10/11/15

CUSTOMER APPROVAL

3D KITCHEN VIEW #1
DCR PHOENIX - LOT 74 SHADOW RIDGE 3

85

Note: This drawing is an artistic interpretation of the general appearance of the design. It is not meant to be an exact rendition.




Designed: 10/16/2015
 Printed: 10/19/2015

Drawing # 1

All

DCR - SHADOW RIDGE 21 OT 74

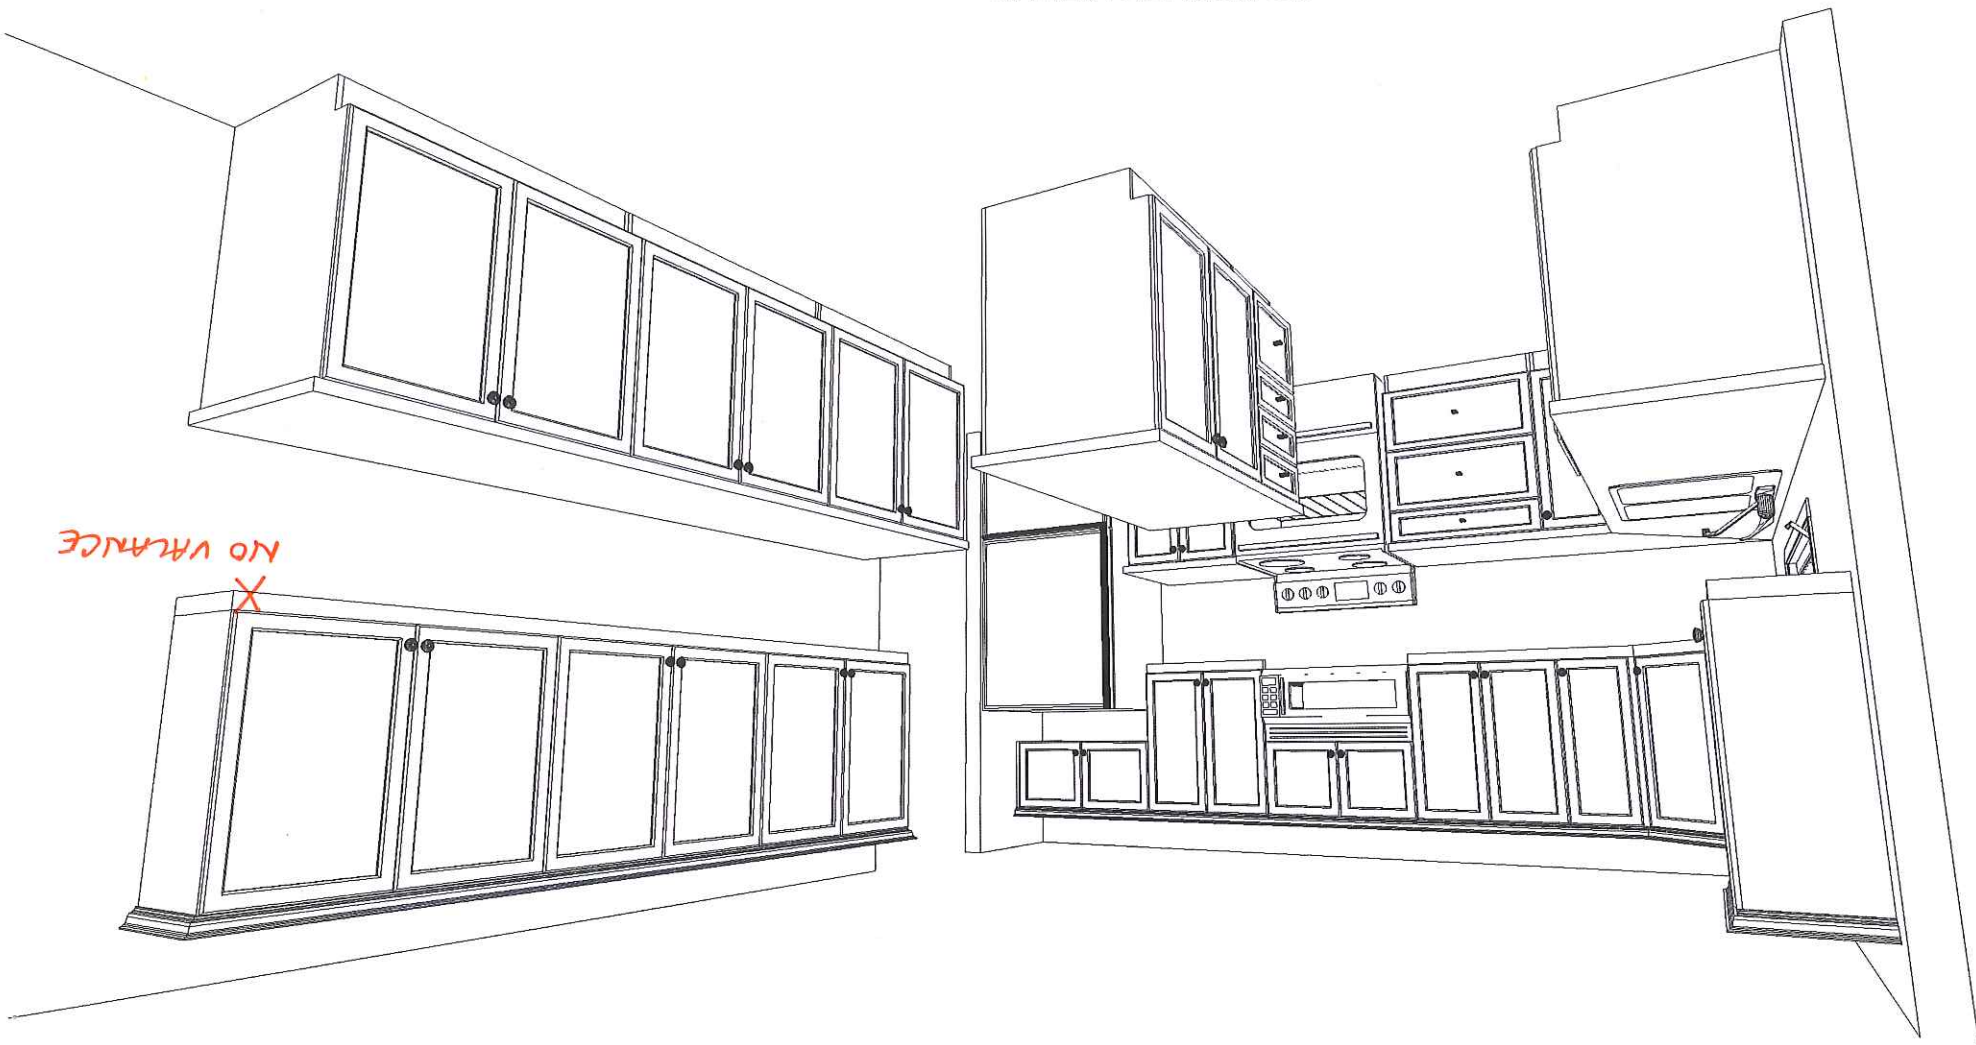

NO VANCE
 X

I have reviewed these drawings and understand the details of the design and the Carter Kitchen's specifications
 Signature _____
 Date Nov. 11/15
CUSTOMER APPROVAL

3D KITCHEN VIEW #2
DCR PHOENIX - LOT 74 SHADOW RIDGE 2



Note: This drawing is an artistic interpretation of the general appearance of the design. It is not meant to be an exact rendition.
 DCR - SHADOW RIDGE 2 LOT 74
 All
 Drawing # - 1
 2020 TECHNOLOGIES
 SPECTRUM
 Designed: 10/16/2015
 Printed: 10/19/2015

CUSTOMER APPROVAL

I have reviewed these drawings and understand the details of the design and the Cartier kitchens specifications

Signature _____

Date Nov. 11/15

3D KITCHEN VIEW #3

DCR PHOENIX - LOT 74 SHADOW RIDGE 2

85



Note: This drawing is an artistic interpretation of the general appearance of the design. It is not meant to be an exact rendition.



All

DCR - SHADOW RIDGE 2 1 OF 74

Drawing # - 1

Designed: 10/16/2015
Printed: 10/19/2015

CUSTOMER APPROVAL


I have reviewed these drawings and understand the details of the design and the Carlier Kitchens specifications

Signature _____

Date Nov. 11/15

STOVE & FRIDGE WALL ELEVATION


DCR PHOENIX - LOT 74 SHADOW RIDGE 2

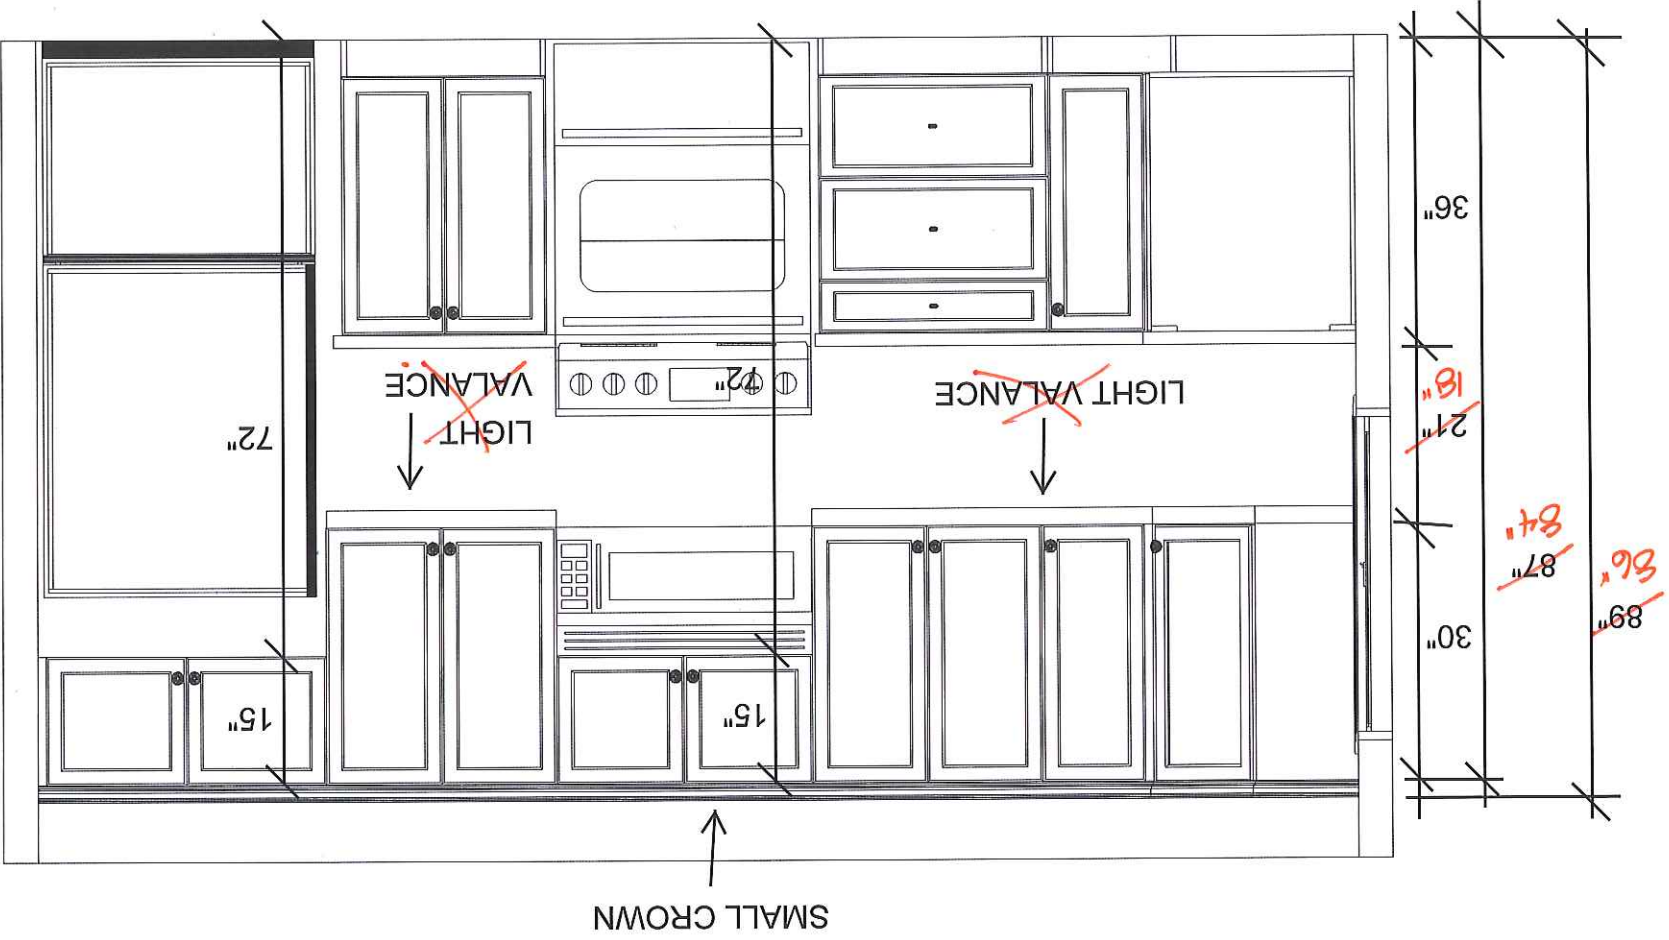

Date Nov. 11/15

DCR PHOENIX - LOT 74 SHADOW RIDGE 2

WALL ELEVATION

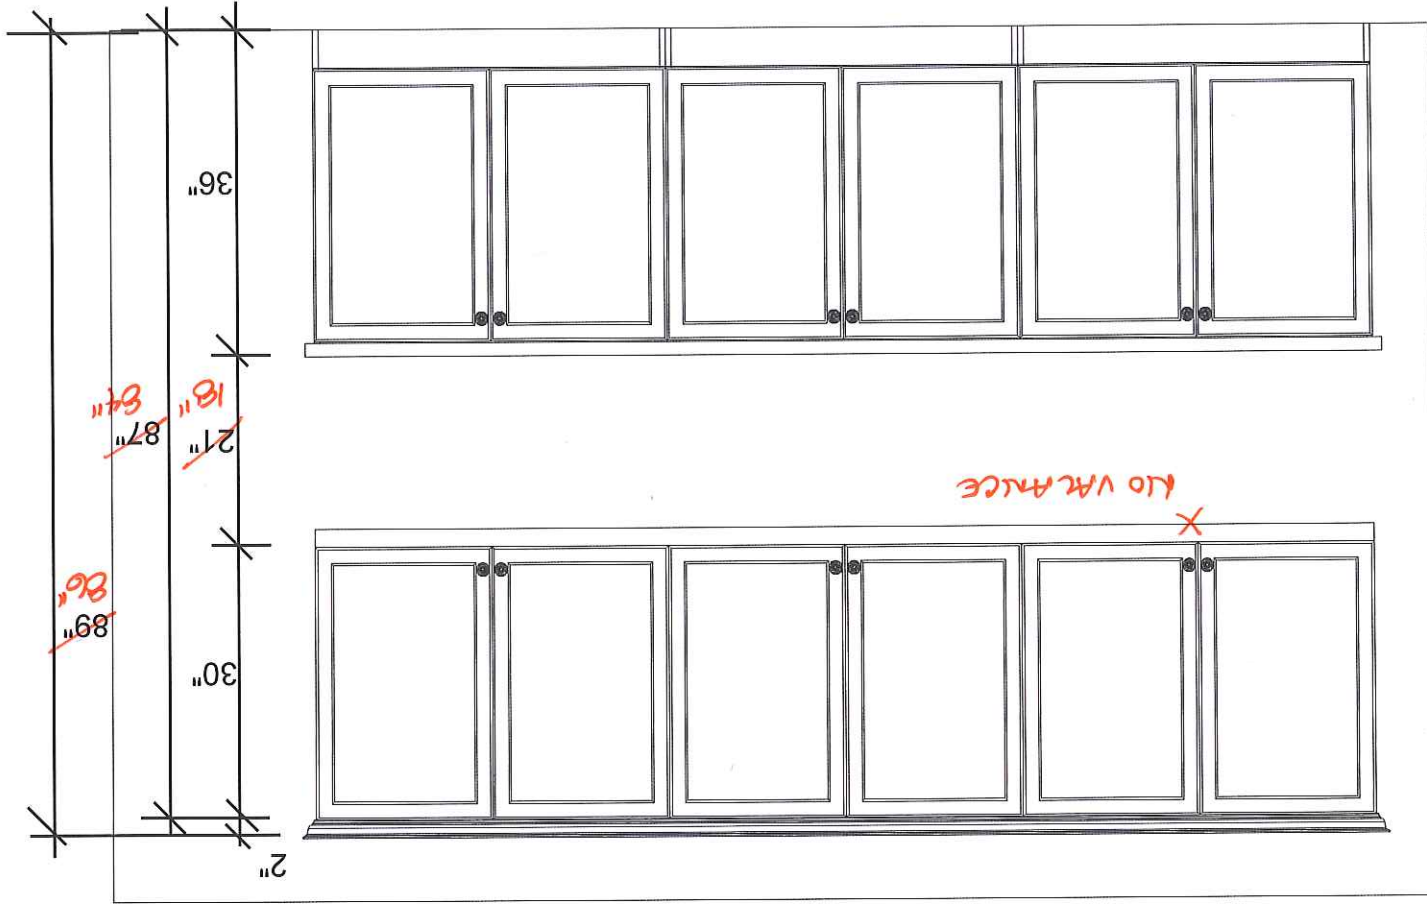

Note: This drawing is an artistic interpretation of the general appearance of the design. It is not meant to be an exact rendition.



11 Δ

PCR - SHADOW RINGE 21 OT 74

U.S. #. 1

Designed: 10/16/2015
Printed: 10/19/2015

Signature _____
 Date 10/14/15
 I have reviewed these drawings and understand the details of the design and the Cartier Kitchens specifications


CUSTOMER APPROVAL

Note: This drawing is an artistic interpretation of the general appearance of the design. It is not meant to be an exact rendition.



Designed: 10/16/2015
 Printed: 10/19/2015
 Drawing #. 1

DCR PHOENIX - LOT 74 ⁸⁵SHADOW RIDGE 2
 SINK WALL ELEVATION

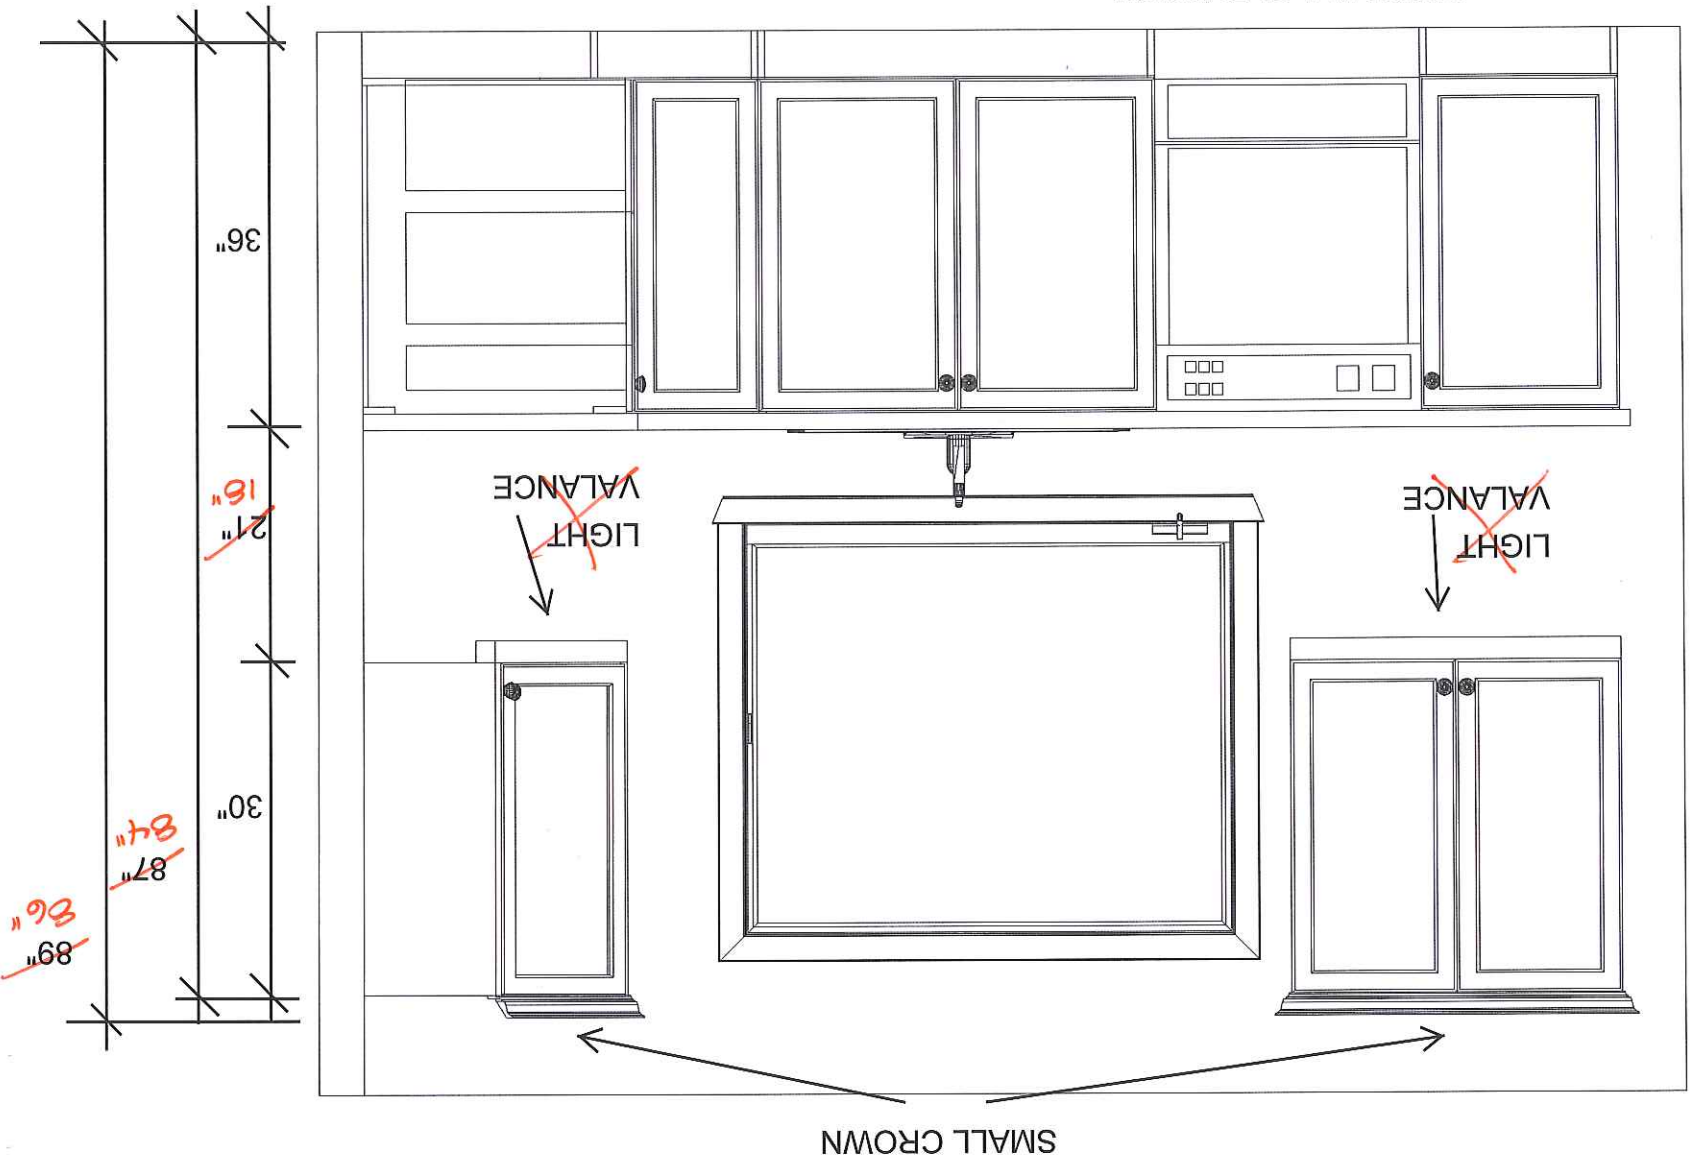

CUSTOMER APPROVAL


I have reviewed these drawings and understand the details of the design and the Cartier Kitchens specifications

Signature *MS*

Date Nov. 11/15

ISLAND ELEVATION

DCR PHOENIX - LOT 74 ⁸⁵ SHADOW RIDGE 2

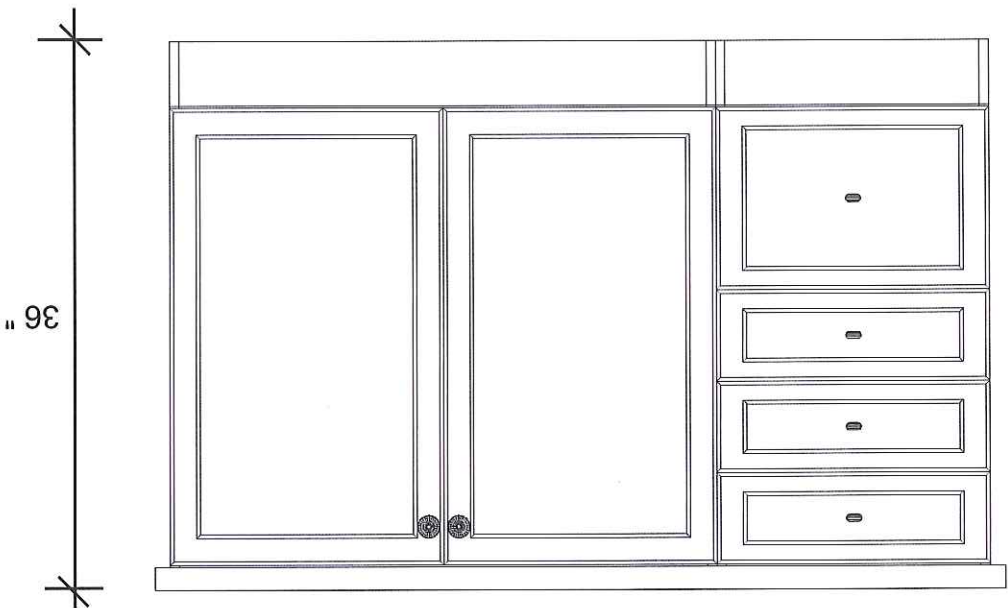


Note: This drawing is an artistic interpretation of the general appearance of the design. It is not meant to be an exact rendition.		DCR - SHADOW RIDGE 2 LOT 74
2020 TECHNOLOGIES SPECTRUM		All
Designed: 10/16/2015 Printed: 10/19/2015		Drawing #. 1

DCR PHOENIX HOMES


LOT 74 ~~85~~ SHADOW RIDGE 2
CHESAPEAKE (508)
STANDARD 4 BEDROOM

VANITIES


- LINE -
- HARDWARE -
- STANDARD WHITE INTERIOR
- METAL DRAWER BOX
- 3 PCS - KICK

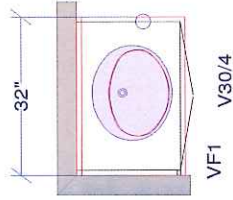


POWDER ROOM

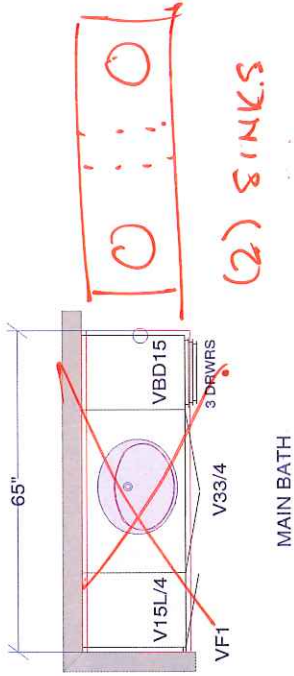

MAIN BATH

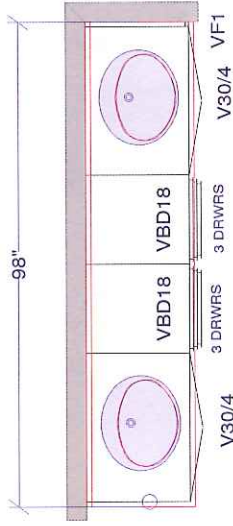


ENSUITE OPTION 1

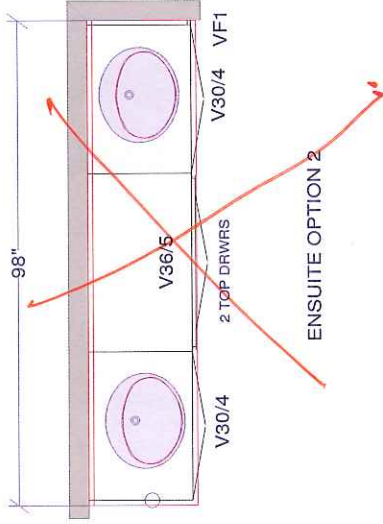

ENSUITE OPTION 2

CUSTOMER APPROVAL

I have reviewed these drawings and understand the details of the design and the Carrier's specifications

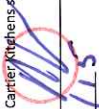Signature 
Date Nov. 11/15

All dimensions, size designations given are subject to verification on job site and adjustment to fit job conditions.

SPECTRUM KITCHENS INC.



This is an original design and must not be released or copied unless applicable fee has been paid or job order placed.


Drawn by: Lori Di Saverio, B.I.D.
SPECTRUM KITCHENS INC.

Designed: 19/10/201
Printed: 20/10/2015

DCR - #74 SR2 - VANITIES.kit

All

Drawing #: 1 | No Scale

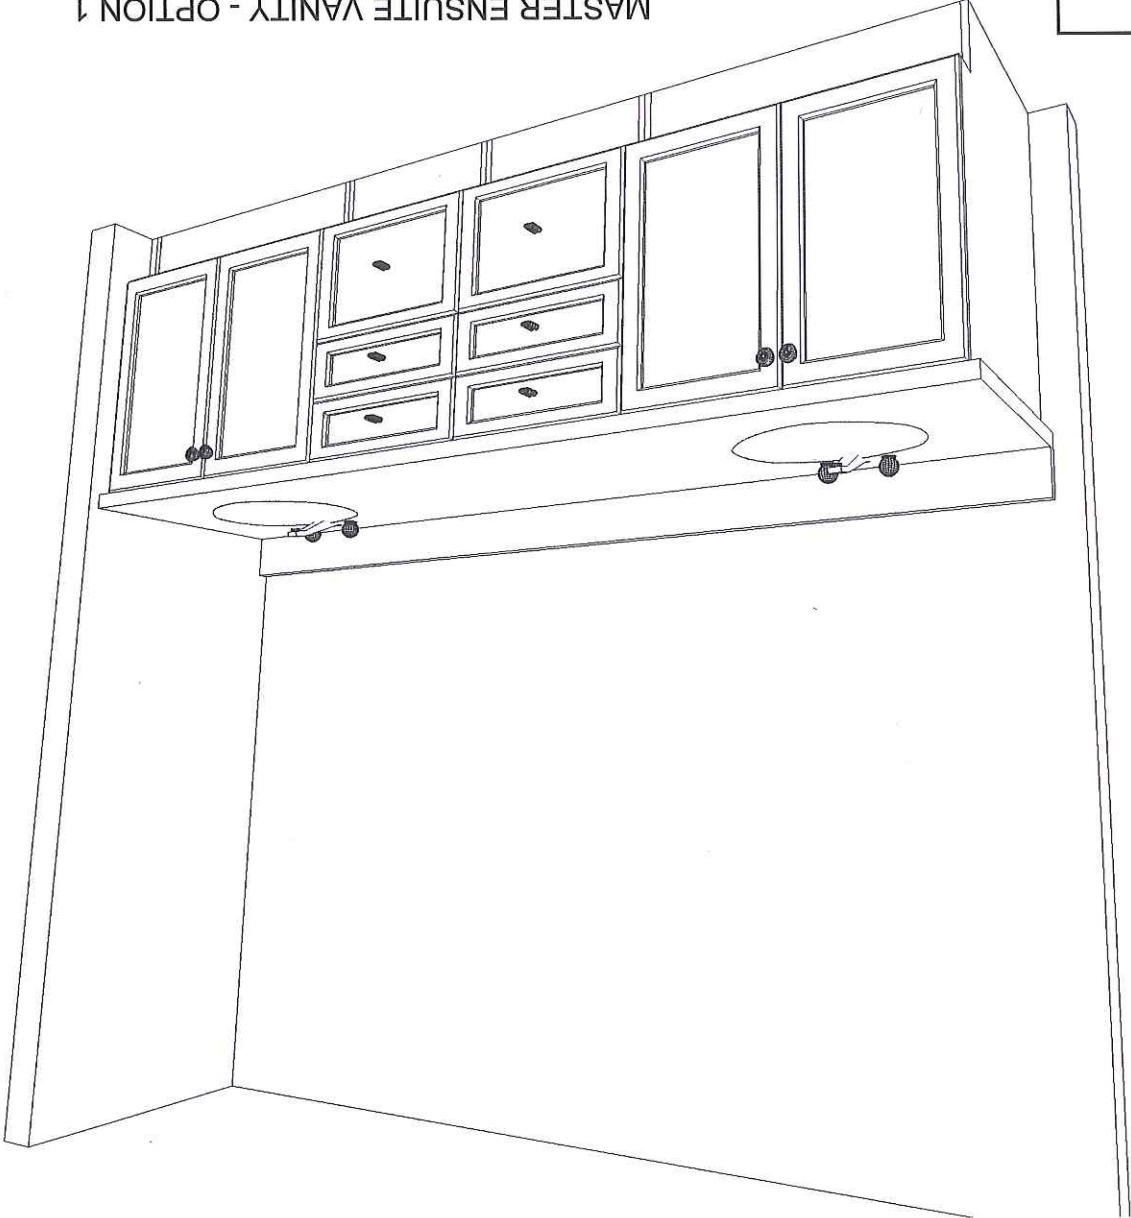

MASTER ENSUITE VANITY - OPTION 1
~~LOT 14~~⁸⁵ SHADOW RIDGE 2

Note: This drawing is an artistic interpretation of the general appearance of the design. It is not meant to be an exact rendition.

Drawn By: Lori D Saverio, B.I.D.
 SPECTRUM KITCHENS INC


2020 TECHNOLOGIES
 Designed: 19/10/2015
 Printed: 20/10/2015

CUSTOMER APPROVAL

I have reviewed these drawings and understand the details of the design and the Cartier Kitchens specifications

Signature

Date Nov. 11/15

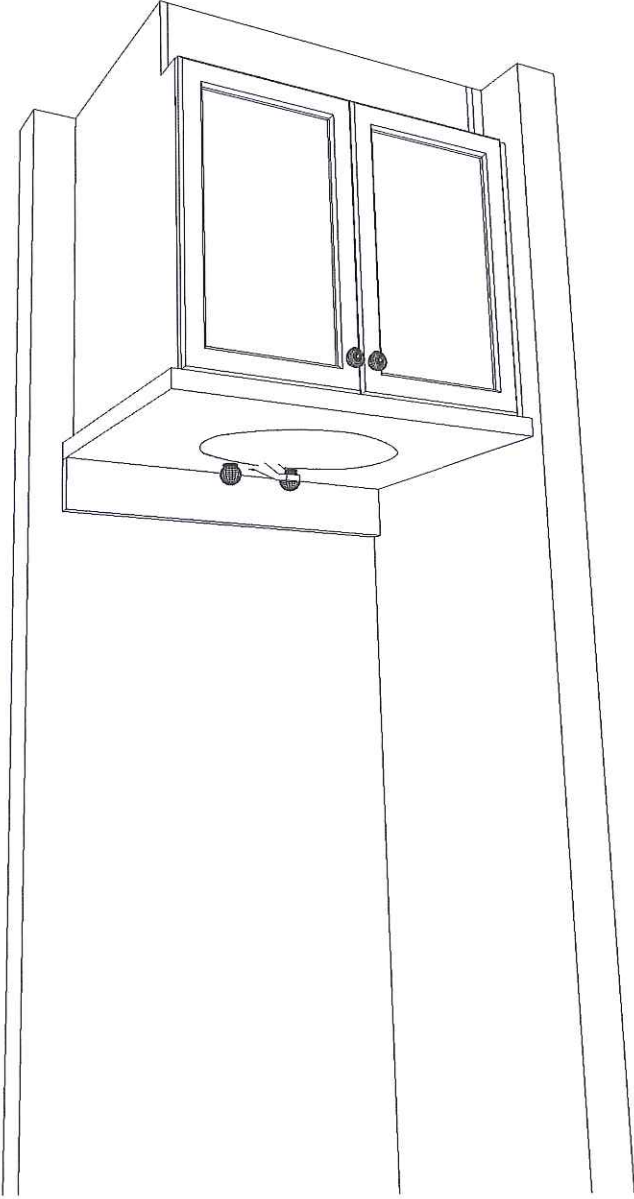

POWDER ROOM VANITY
LOT 74 SHADOW RIDGE 2
 85

Note: This drawing is an artistic interpretation of the general appearance of the design. It is not meant to be an exact rendition.

Drawn By: Lori D Saverio, B.I.D.
 SPECTRUM KITCHENS INC



Designed: 19/10/2015
 Printed: 20/10/2015

CUSTOMER APPROVAL

I have reviewed these drawings and understand the details of the design and the Cartier Kitchens specifications

Signature 

Date Nov. 11/15