


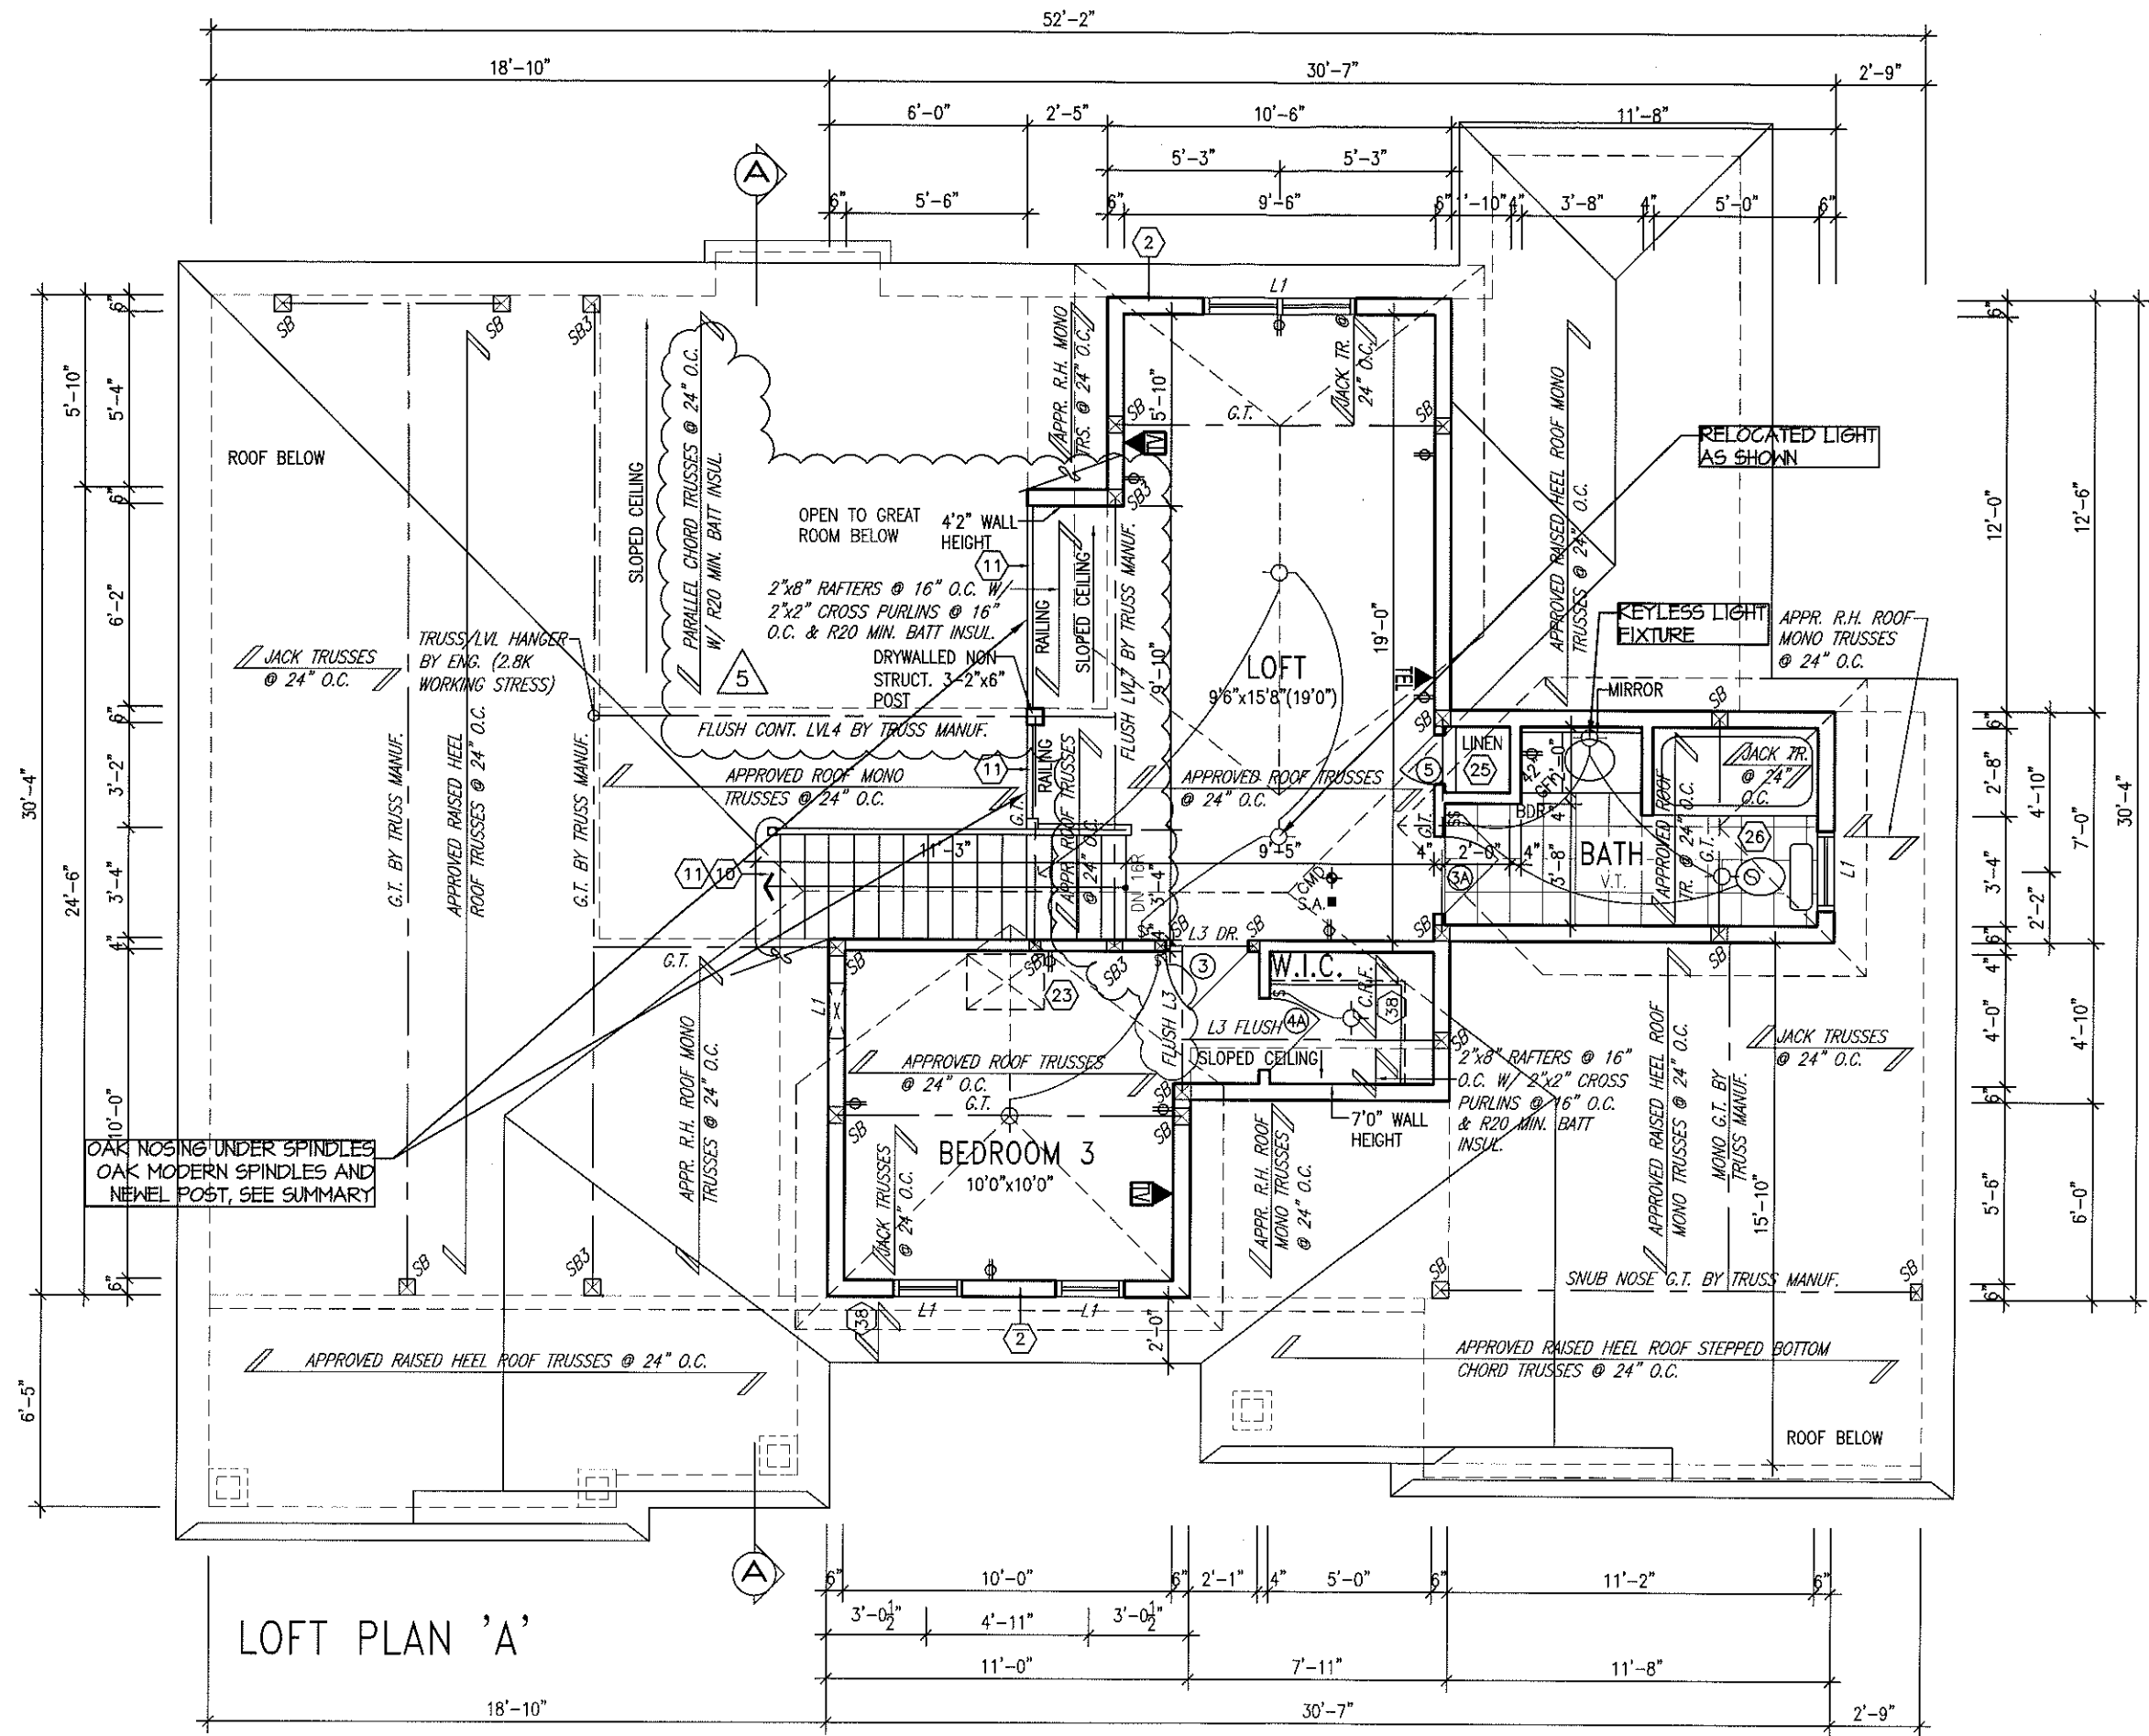

footprint:	B5-A
sh. title:	LOFT PLAN
drawn by:	IV
checked by:	JUNE 2007
date:	3/16"=1'
scale:	sheet no:
	3A
	6

No.	Description	Date	By
2	REV. AS PER CONST. SUMMARY	JUL30-13	SD
1	REV. AS PER CONST. SUMMARY	JUNE24-13	SD

B5-A EQUINOX

SITE: SHADOW RIDGE 2

LOT NUMBER: 86


CIVIC ADDRESS: 1611 STONECROP AVE.

Viljoen Architect Inc.

300 A Wilson Avenue
 North York, Ontario
 M2H 1S8
 TEL: (416) 630-2255
 FAX: (416) 630-4782


PHOENIX HOMES

LOFT

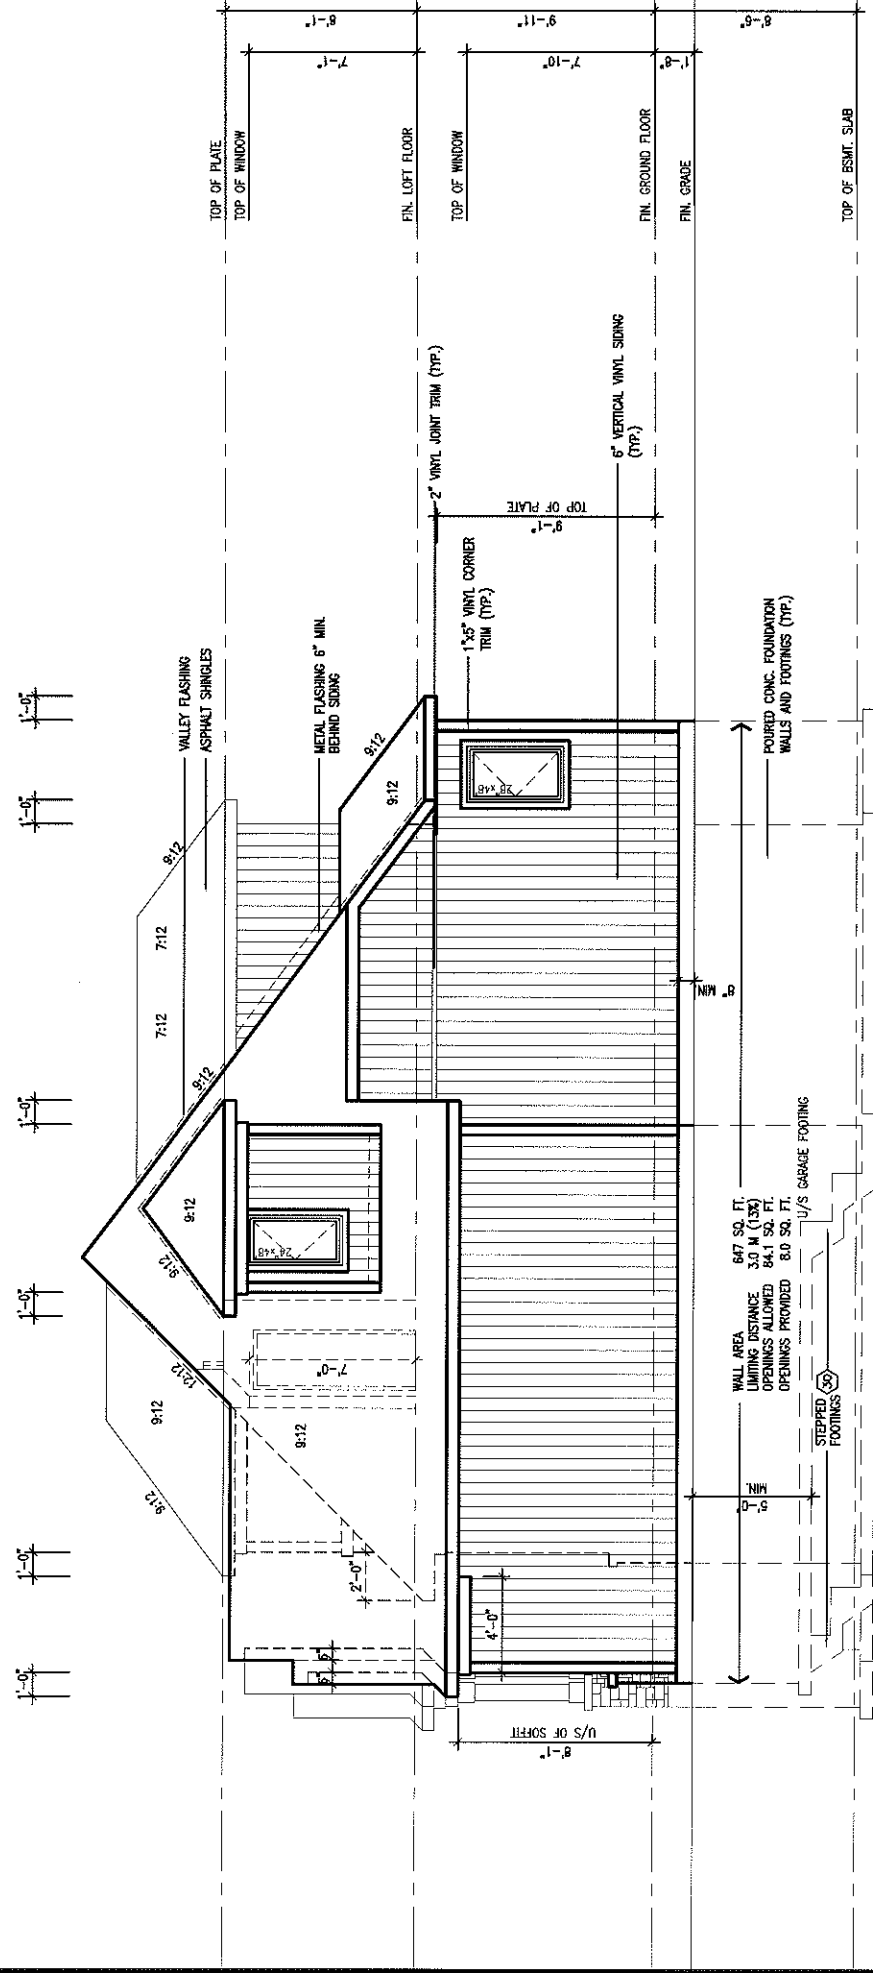

RIGHT SIDE ELEVATION 'A'


NOTE: REFER TO FRONT
ELEVATION FOR TYPICAL NOTE
INFORMATION

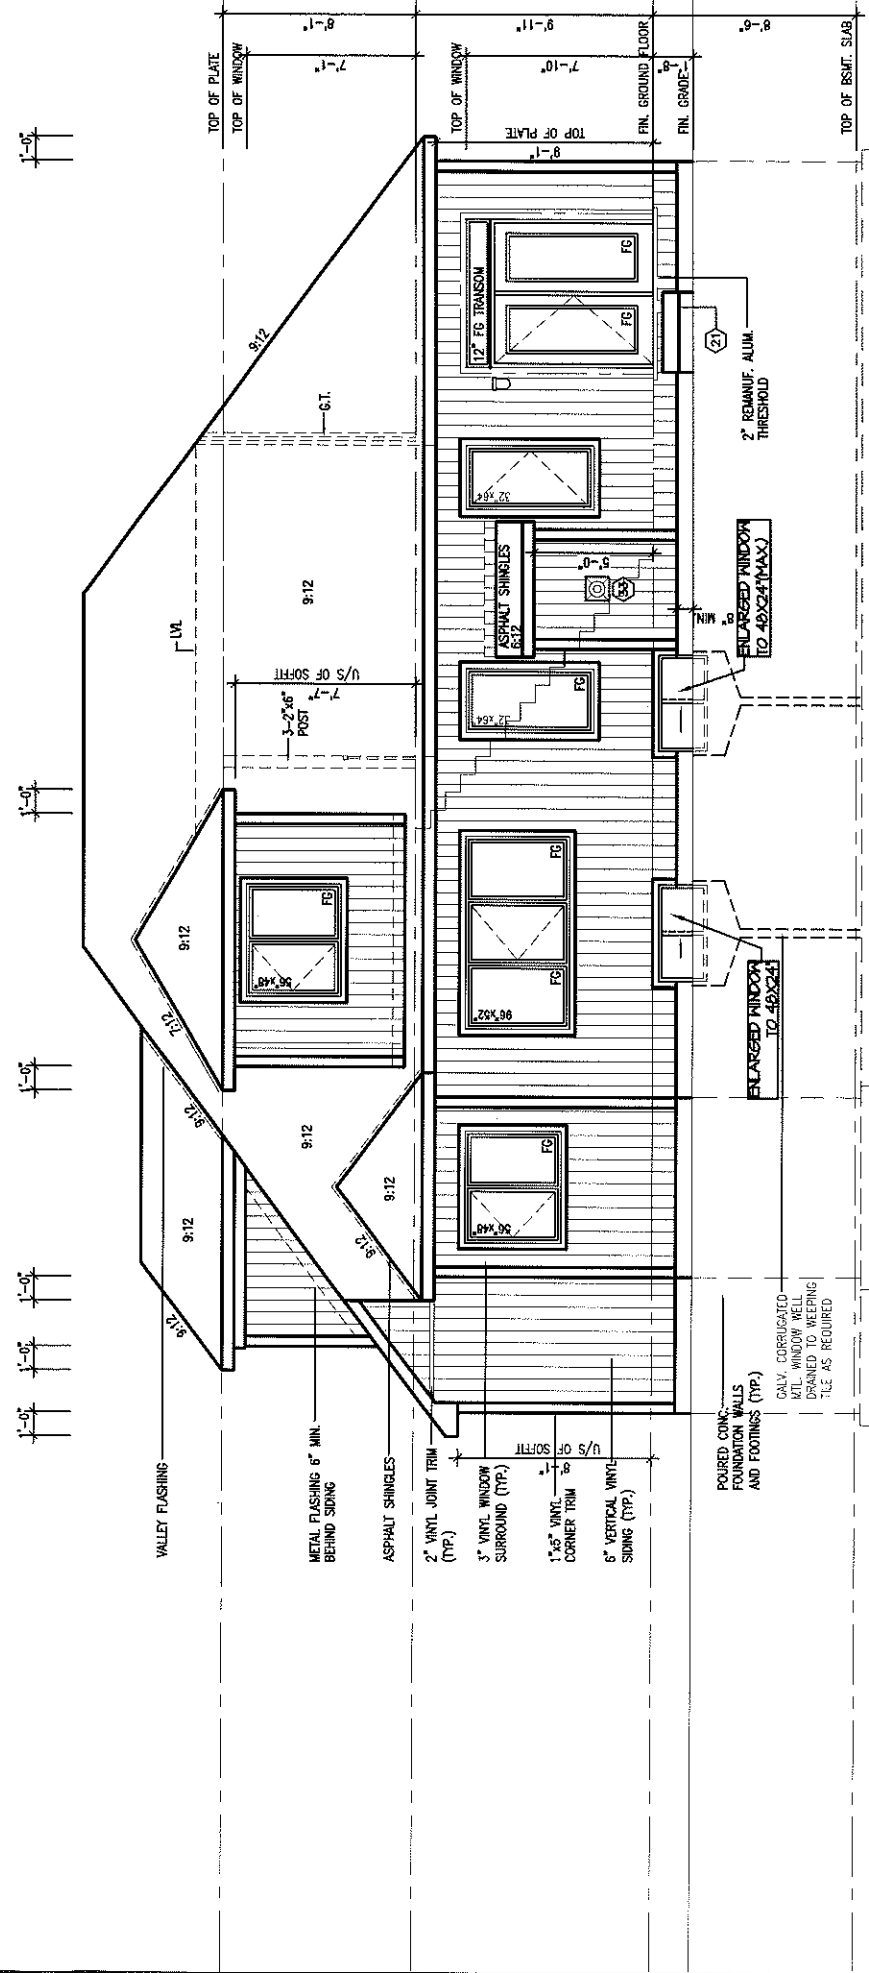

REAR ELEVATION 'A'

NOTE: REFER TO FRONT
ELEVATION FOR TYPICAL NOTE
INFORMATION

LOFT

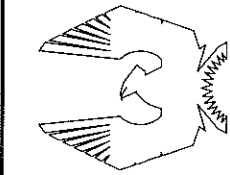

PHOENIX HOMES

Viljoen
Architect
Inc.

300 A. Wilson Avenue
North York, Ontario
M3H 1S8
TEL: (416) 630-2255
FAX: (416) 630-4782

B5-A EQUINOX


SITE: SHADOW RIDGE 2

LOT NUMBER:
CIVIC ADDRESS:
1611 STONECROP AVE.

86

No.	Description	Date	By
2	REV. AS PER CONST. SUMMARY	JUL30-13	SD
1	REV. AS PER CONST. SUMMARY	JUNE24-13	SD

footprint: B-5A	sheet title: ELEVATIONS-A
drawn by: IV	checked by:
date: JUNE 2007	scale: 1/8"=1'
sheet no: 5A	6

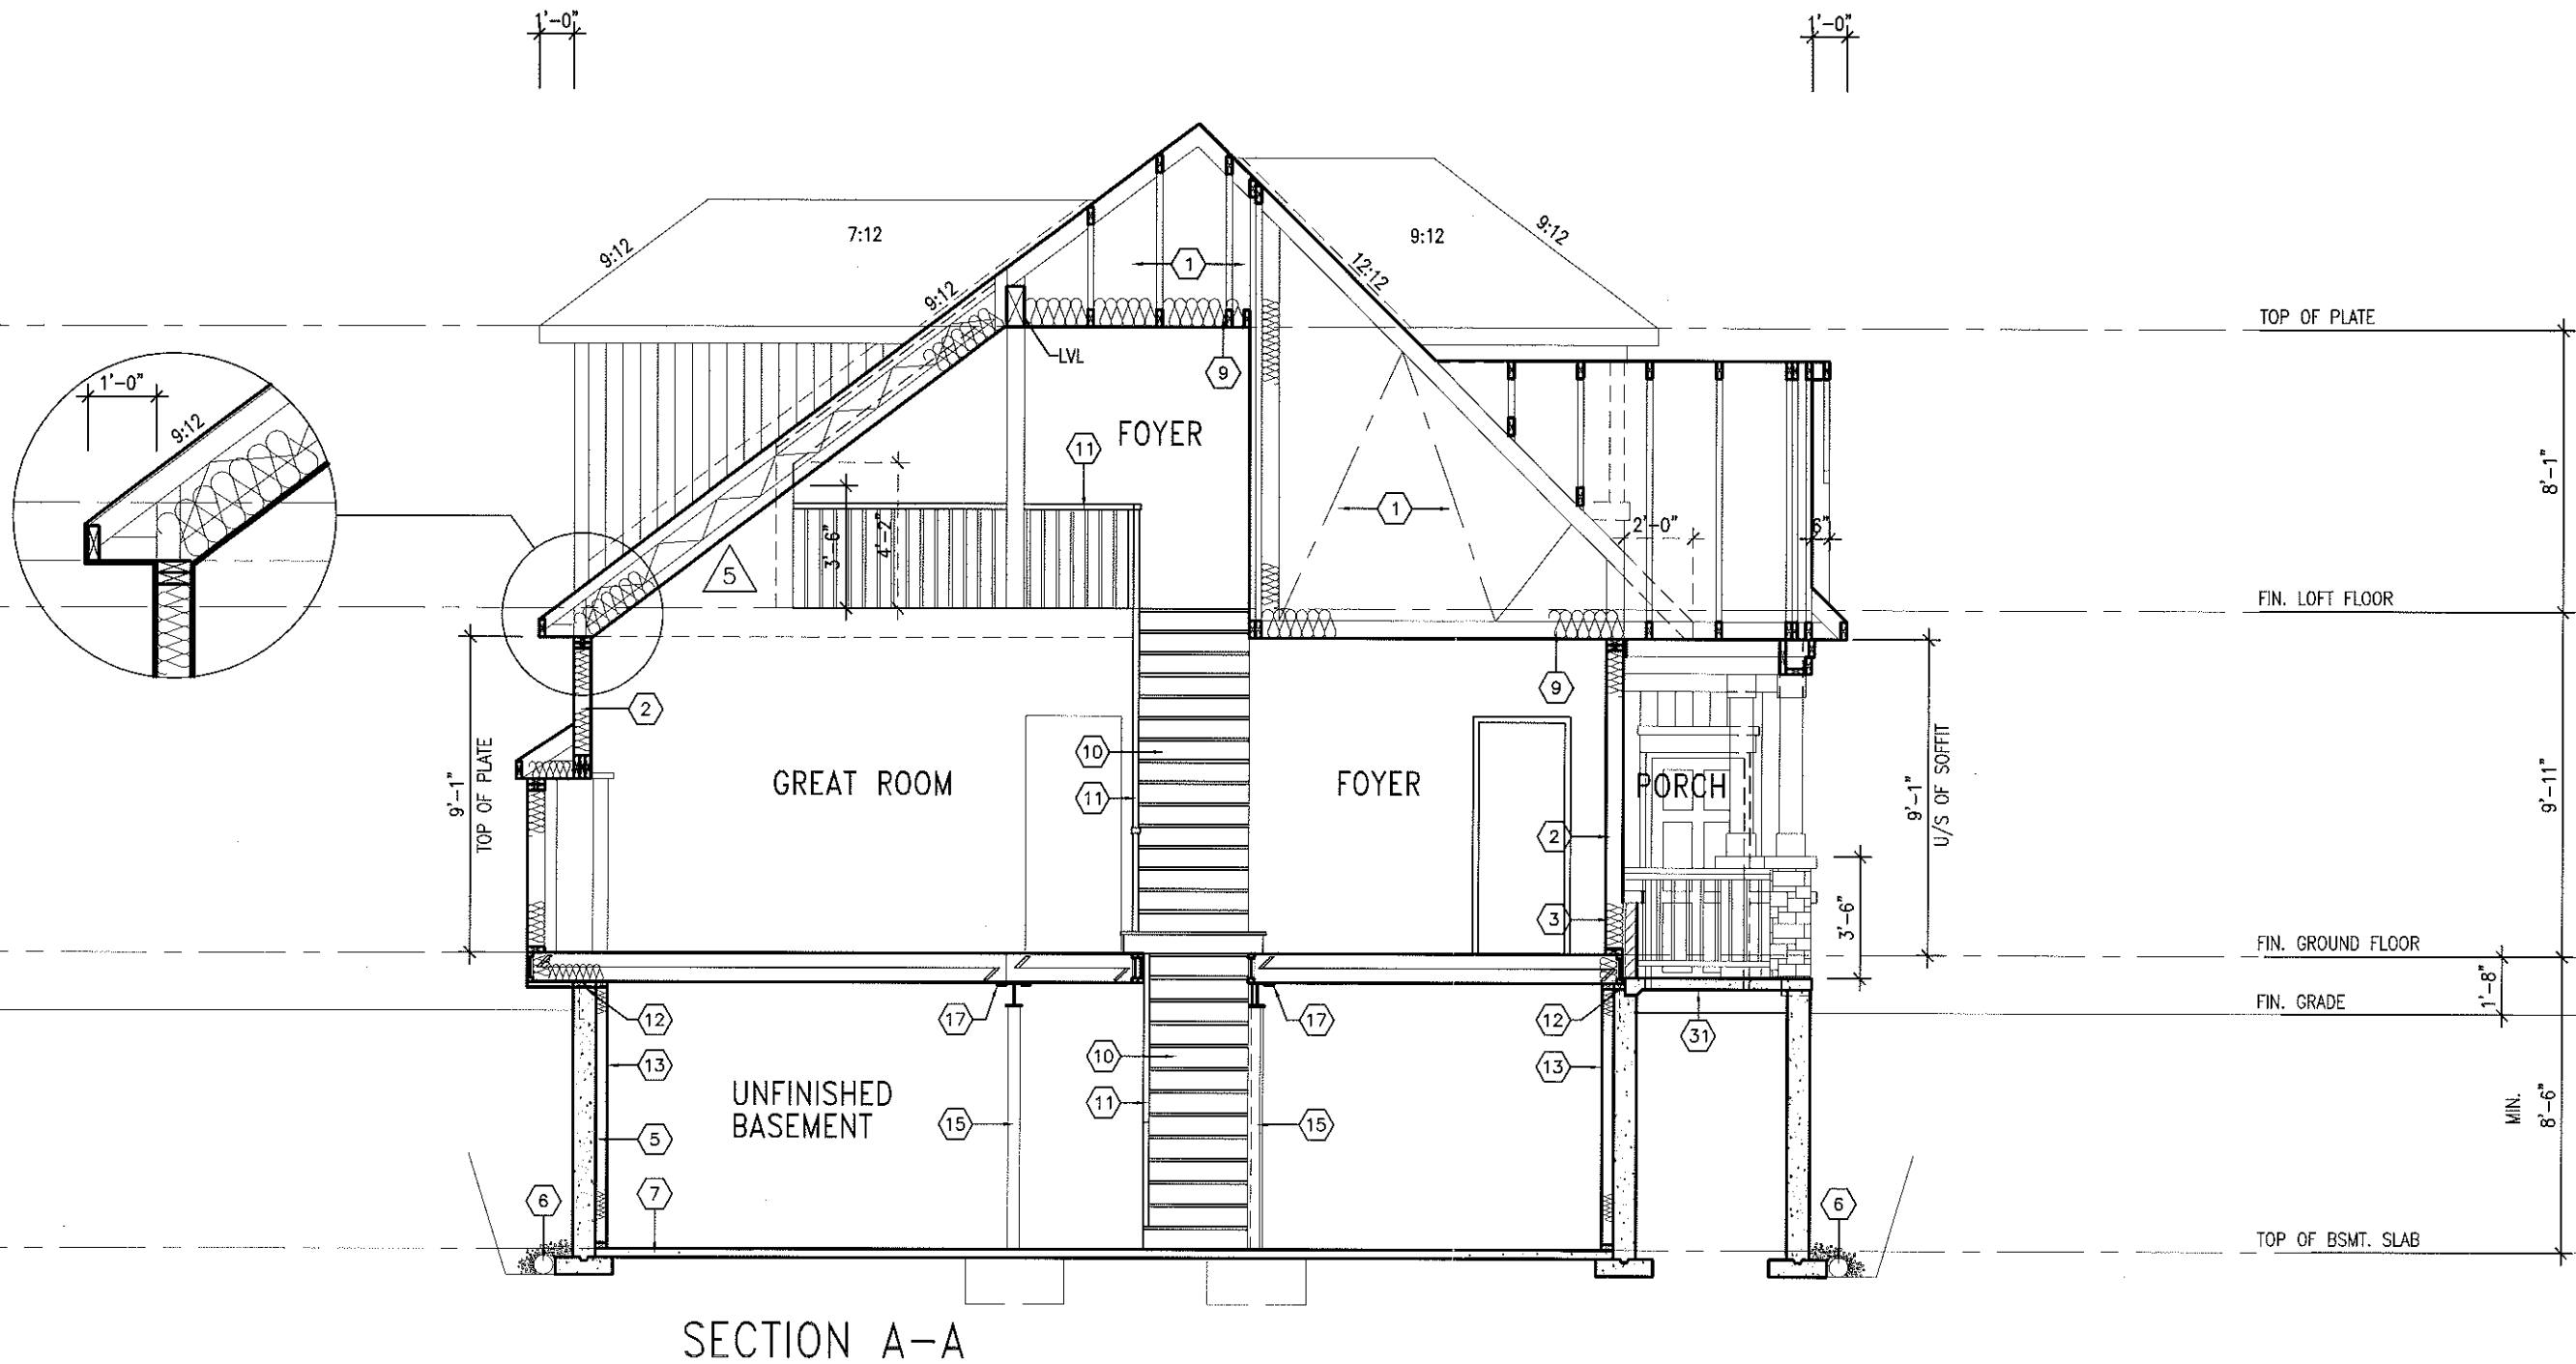

footprint: B5-LOFT
ent. title: SECTION
drawn by: IV
checked by:
date: JUNE 2007
scale: 3/16"=1'
sheet no:
6

2 REV. AS PER CONST. SUMMARY	JUL30-13	SD
1 REV. AS PER CONST. SUMMARY	JUNE24-13	SD
No. Description	Date	By
REVISIONS		

B5-A EQUINOX
SITE: SHADOW RIDGE 2
LOT NUMBER: 86
CIVIC ADDRESS: 1611 STONECROP AVE.

Viljoen Architect Inc.
300 A Wilson Avenue North York, Ontario M3H 1S8 TEL: (416) 630-2255 FAX: (416) 630-4782

PHOENIX HOMES
