

DCR PHOENIX HOMES



SHADOW RIDGE 2

06# LOT


MODEL - TUSCANA (S-6)

KITCHEN

MOUNTING HT: 93"

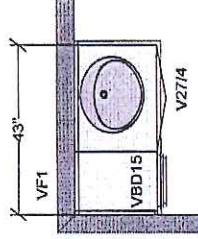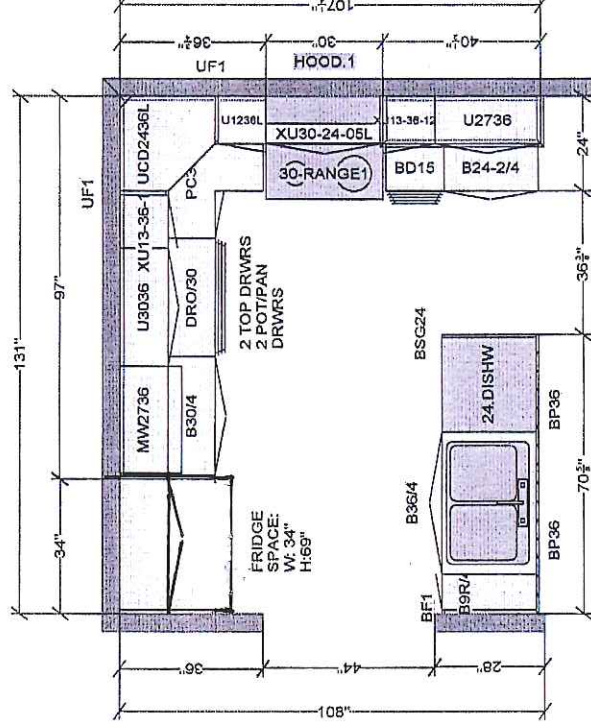

POWDER ROOM

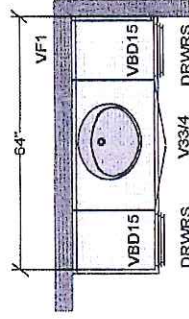

MAIN BATH

MASTER ENSUITE

100-443887-100

CARTIER KITCHENS OTTAWA



This is an original design and must not be released or copied unless applicable fee has been paid or job order placed.


DRAWN BY: LD
CARTIER KITCHENS OTTAWA

Designed: 9/5/2012
Printed: 9/5/2012

DCR - #90 SR2 - S6 - TUSCANA

Drawing #: 1	No Scale.
--------------	-----------

93"
36"
21"
36"

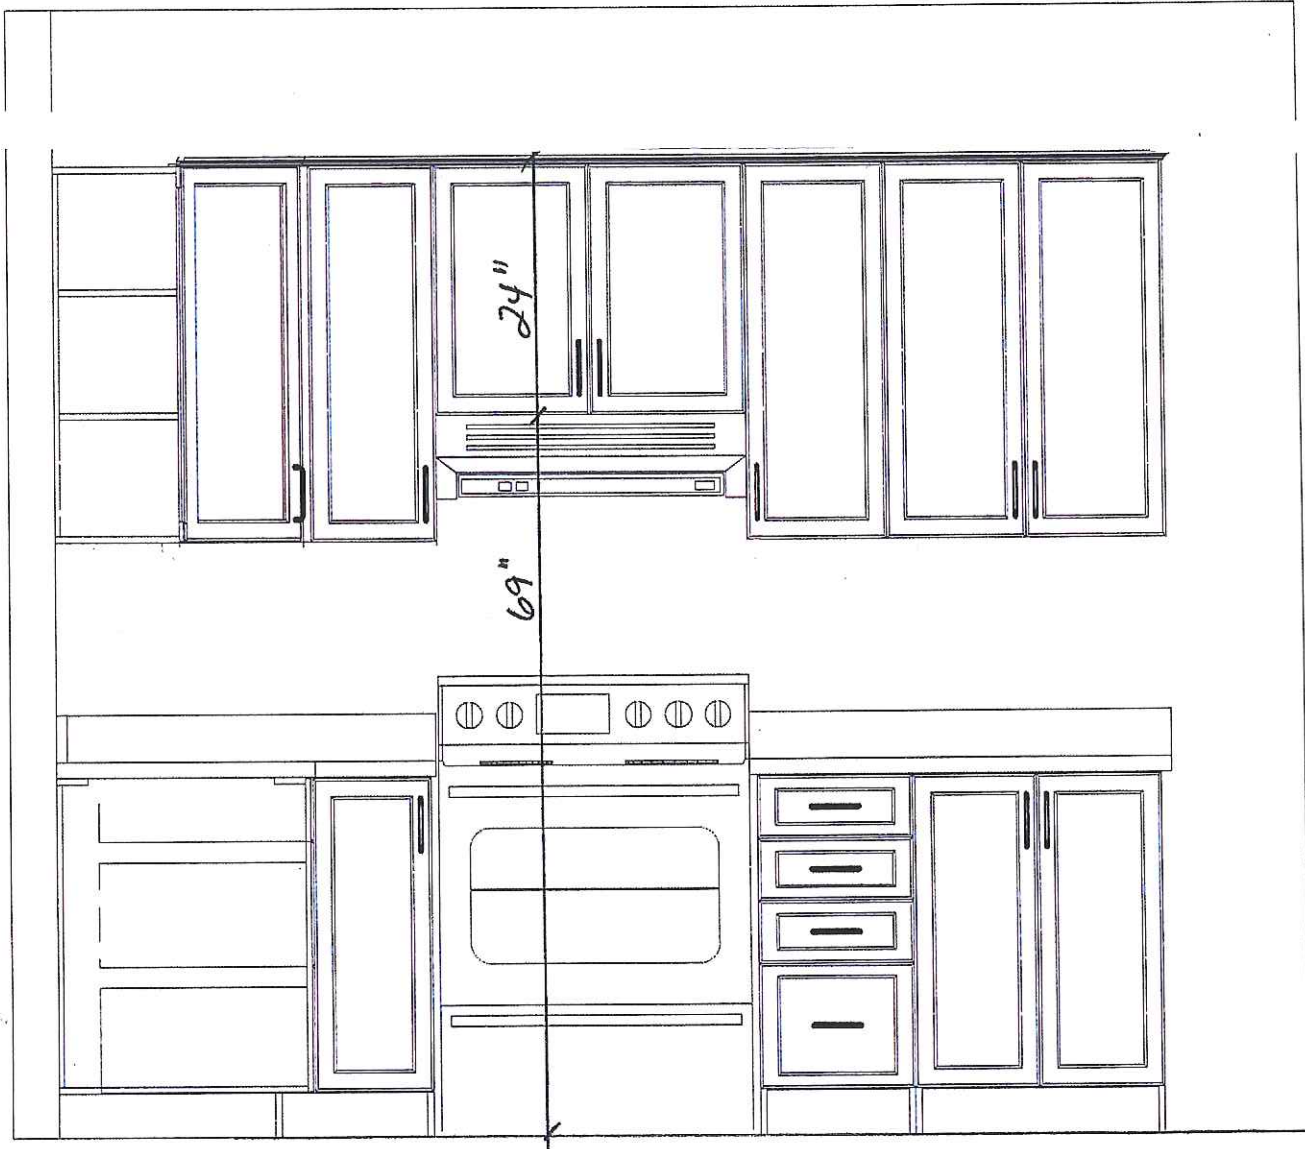

STOVE WALL ELEVATION

CUSTOMER APPROVAL

I have reviewed these drawings and understand the details of the layout and the Cartier Kitchens specifications.

Signature

[Signature]

Date

Dec. 11/2

Note: This drawing is an artistic interpretation of the general appearance of the design. It is not meant to be an exact rendition.

DESIGNED BY: LORI DISAVERIO,
DCR - #90 SR2 - S6 - TUSCANA




Designed: 9/5/2012
Printed: 9/5/2012

All

Drawing #: 1

93" 24" 69"

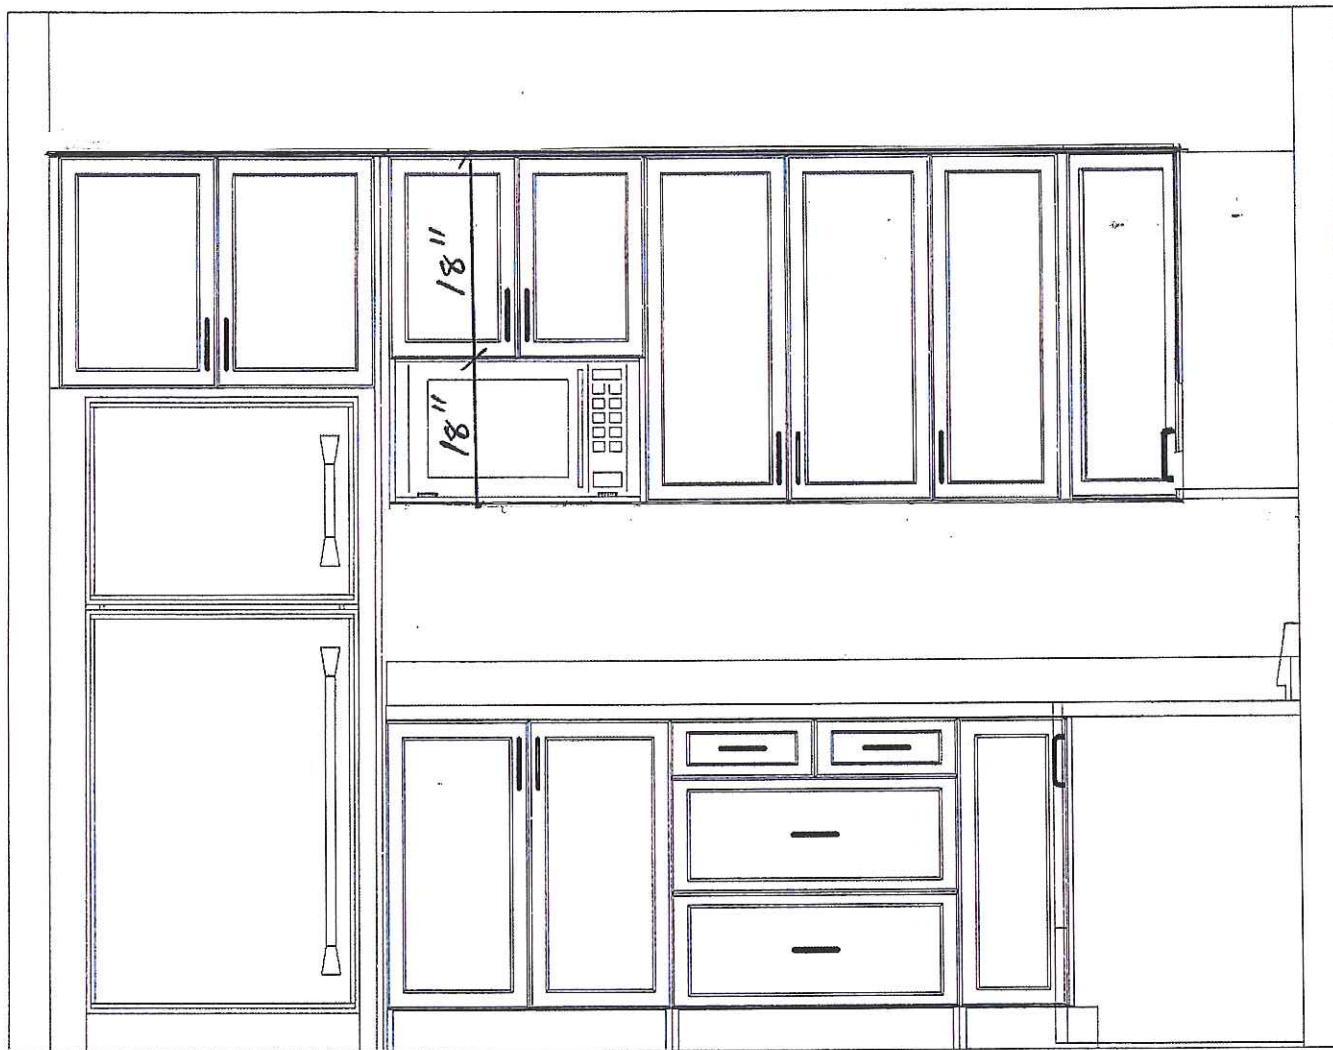

36" 21" 93" 36"

FRIDGE WALL ELEVATION

CUSTOMER APPROVAL

I have reviewed these drawings and understand the details of the layout and the Cartier Kitchens specifications.

Signature

[Signature]

Date

Dec. 11/12

Note: This drawing is an artistic interpretation of the general appearance of the design. It is not meant to be an exact rendition.

DESIGNED BY: LORI DISAVERIO.

DCR - #90 SR2 - S6 - TUSCANA



Designed: 9/5/2012
Printed: 9/5/2012

All

Drawing #: 1

STANDARD 12" DEEP
UPPER

3D VIEW #2

CUSTOMER APPROVAL

I have reviewed these drawings and understand the details of the layout and the Cartier Kitchens specifications.

Signature: 

Date: Dec. 11/12

Note: This drawing is an artistic interpretation of the general appearance of the design. It is not meant to be an exact rendition.

DESIGNED BY: LORI DISAVERIO,
DCR - #90 SR2 - S6 - TUSCANA



Designed: 9/5/2012
Printed: 9/5/2012

All

Drawing #: 1



3D View #1

CUSTOMER APPROVAL

I have reviewed these drawings and understand the details of the layout and the Cartier Kitchens specifications.

Signature: X [Signature]
Date: Dec. 11/12

Note: This drawing is an artistic interpretation of the general appearance of the design. It is not meant to be an exact rendition.


DESIGNED BY: LORI DISAVERIO.
DCR - #90 SR2 - S6 - TUSCANA



Designed: 9/5/2012
Printed: 9/5/2012

All

Drawing #: 1

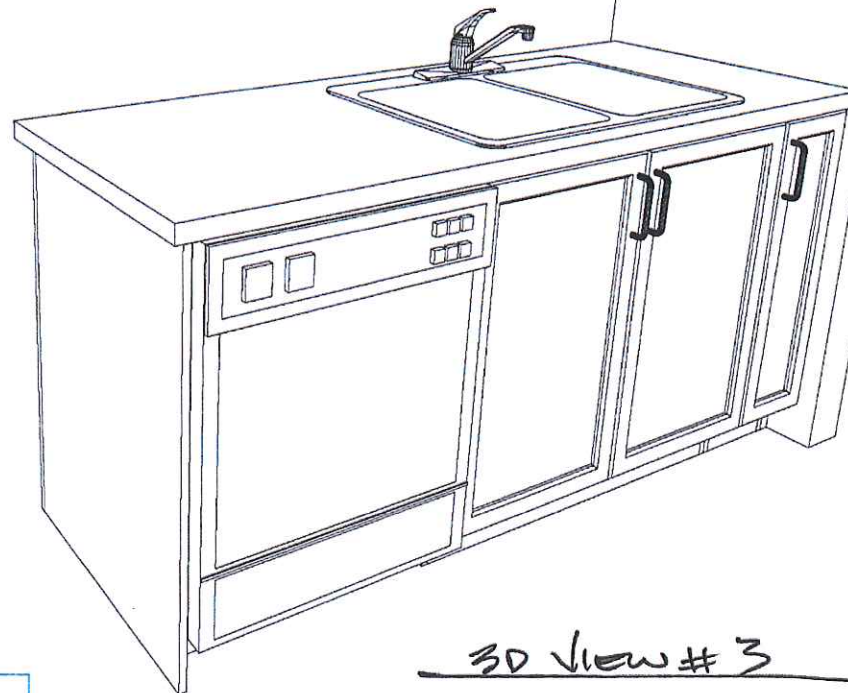

3D View # 3

CUSTOMER APPROVAL

I have reviewed these drawings and understand the details of the layout and the Cartier Kitchens specifications.

Signature

[Handwritten signature]

Date

Dec. 11/12

Note: This drawing is an artistic interpretation of the general appearance of the design. It is not meant to be an exact rendition.



Designed: 9/5/2012
Printed: 9/5/2012

DESIGNED BY: LORI DISAVERIO.
DCR - #90 SR2 - S6 - TUSCANA

All

Drawing #: 1