



NOTE: PROVIDE 2-10M TOP AND BOTTOM BARS ALL AROUND FOUNDATION WALLS (UNLESS NOTED OTHERWISE)

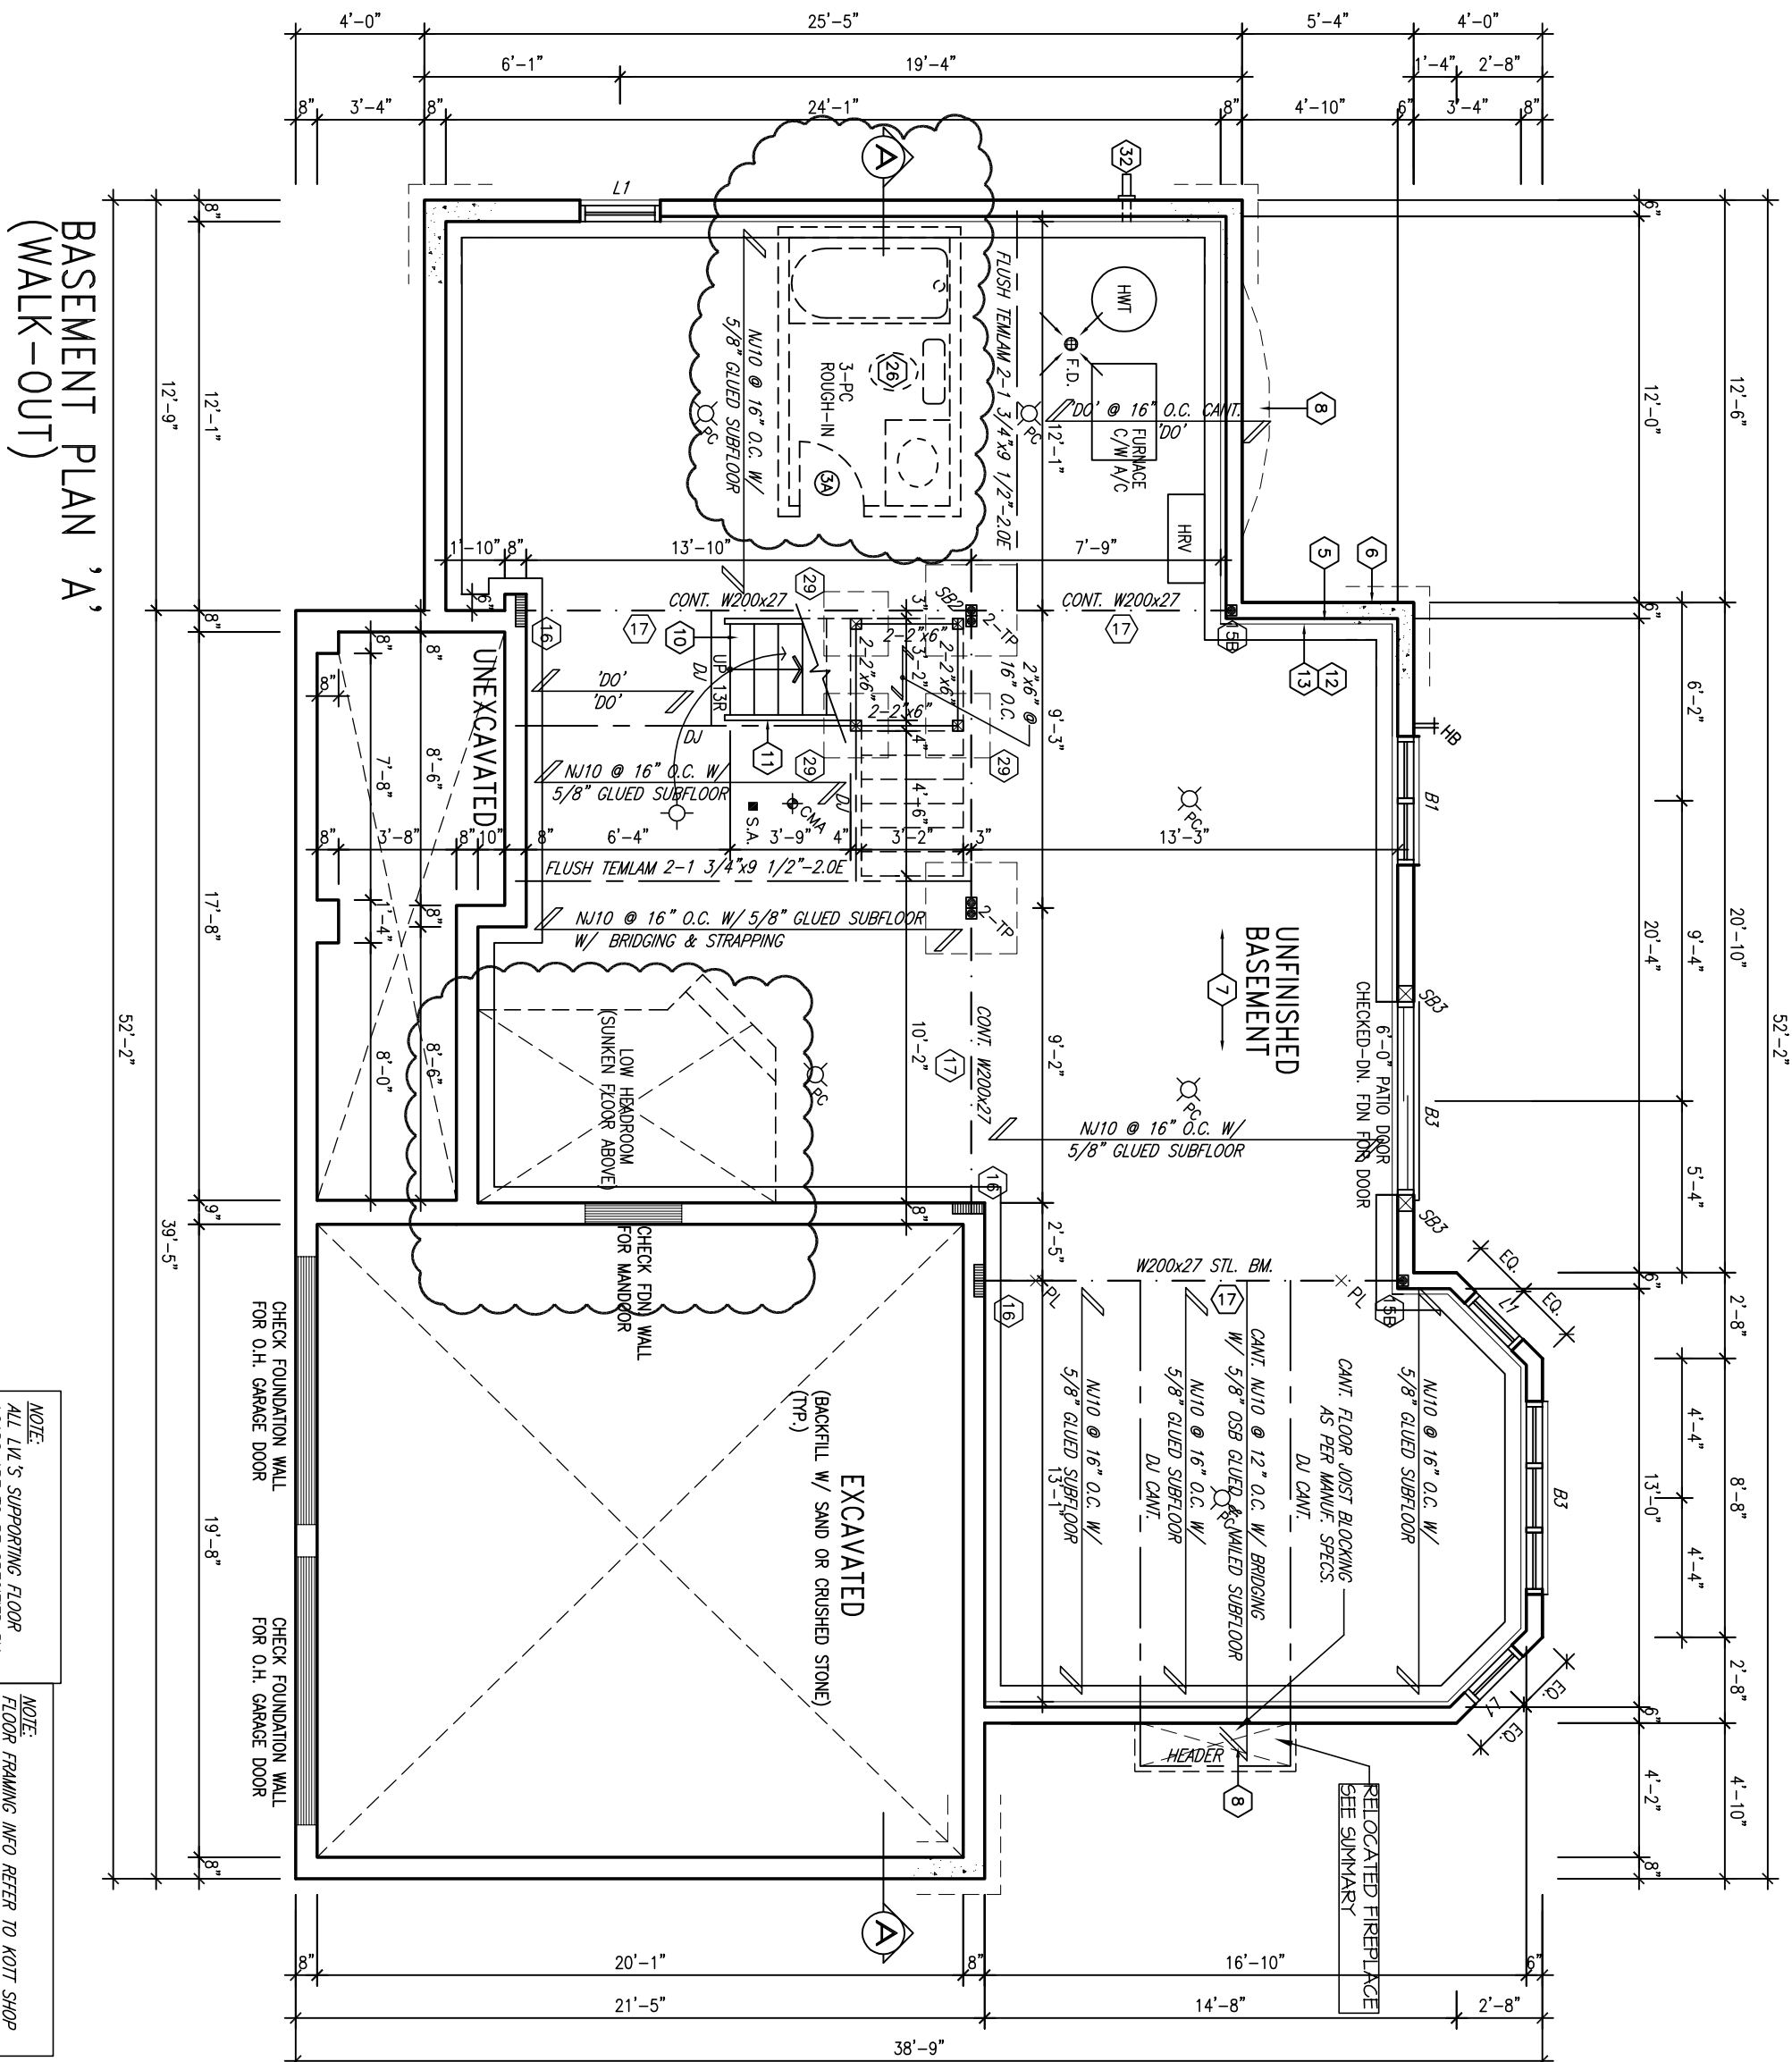

NOTE:
ALL LVLS SUPPORTING FLOOR
LOADS ARE TO BE SPECIFIED BY
THE FLOOR TRUSS MANUFACTURER.

NOTE:
FLOOR FRAMING INFO REFER TO KOTT SHOP
DRAWINGS FOR ALL TRUSS-JOIST INFORMATION
AND DETAILS. UNLESS OTHERWISE NOTED.

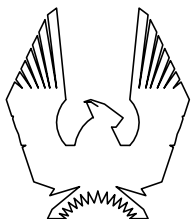

PHOENIX HOMES

Viljoen
Architect
Inc.

300 A Wilson Avenue
North York, Ontario
M3H 1S8
TEL: (416) 630-2255
FAX: (416) 630-4782

MERKHET-2008-A

SITE: WHITE TAIL RIDGE

LOT NUMBER:

CIVIC ADDRESS:
176 ANTLER COURT

19


6	REV. AS PER CONST. SUMMARY	JUL28-14	SD
5	REV. AS PER CONST. SUMMARY	JUL15-14	SD
4	ISSUED FOR B.E.P. ONLY	JUN26-14	SD
3	SUNKEN LAUNDRY PER PURCHASER	JUNE13-14	SD
2	ISSUED FOR B.E.P. ONLY	JUNE5-14	SD
1	ISSUED FOR PERMIT APPLICATION	MAY5-14	SD
No.	Description	Date	By
REVISIONS			

footprint:	S2-A
sht. title:	BASEMENT-A
drawn by:	MB
checked by:	OF
date:	FEB. 2007
scale:	3/16" = 1'
sheet no:	

NOTE: ROOF TRUSS INFORMATION REFER TO ROOF TRUSS SHOP DRAWINGS FOR ALL ROOF FRAMING INFORMATION UNLESS OTHERWISE NOTED.

NOTE: ROOF FRAMING INFORMATION
ALL LAMINATED VENEER LUMBER (LVL) BEAMS, BUILT-UP BEAMS, GIRDER TRUSSES AND METAL HANGER CONNECTIONS SUPPORTING ROOF FRAMING TO BE DESIGNED AND CERTIFIED BY ROOF TRUSS MANUFACTURER. REFER TO ROOF TRUSS SHOP DRAWINGS FOR ALL ROOF FRAMING INFORMATION UNLESS OTHERWISE NOTED ON ARCHITECTURAL DRAWINGS.

SECOND FLOOR PLAN (3 BEDROOM) 'A'

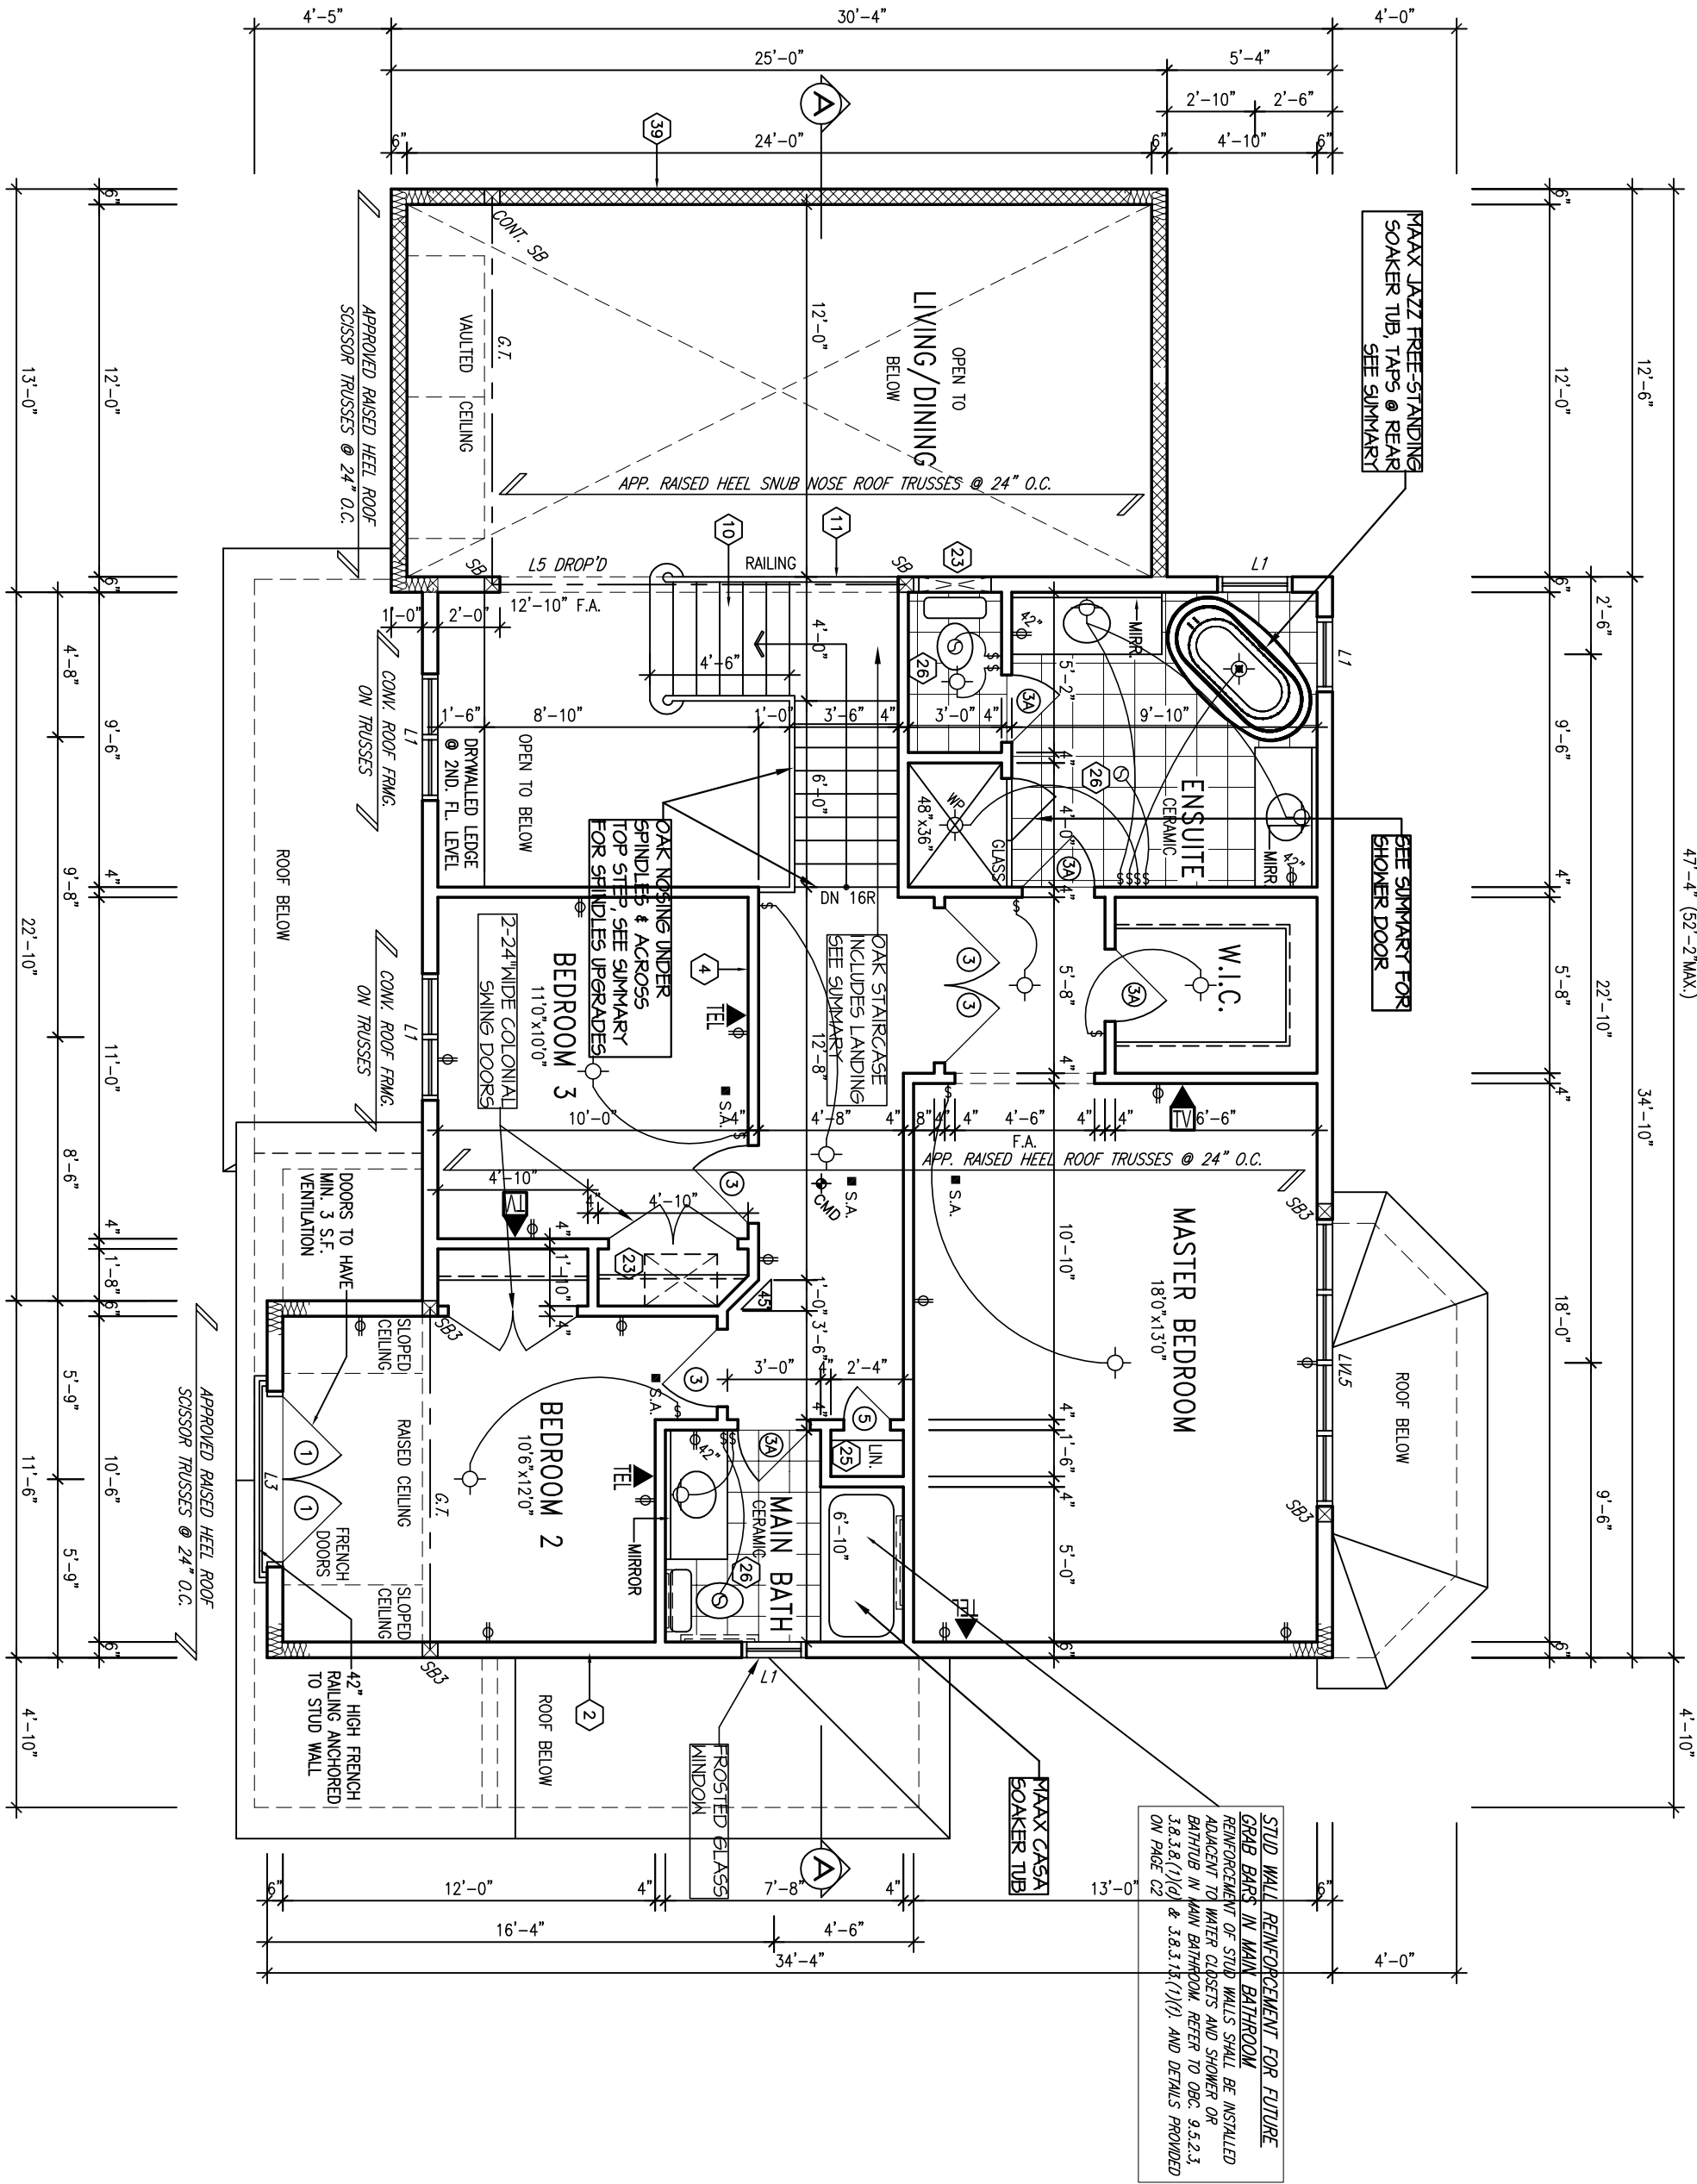

Viljoen Architect Inc.

300 A Wilson Avenue
North York, Ontario
M3H 1S8
TEL: (416) 630-2255
FAX: (416) 630-4782

MERKHET-2008-A

SITE: **WHITE TAIL RIDGE**

LOT NUMBER: **19**

CIVIC ADDRESS:
176 ANTLER COURT

6	REV. AS PER CONST. SUMMARY	JUL28-14	SD
5	REV. AS PER CONST. SUMMARY	JUL15-14	SD
4	ISSUED FOR B.E.P. ONLY	JUN26-14	SD
3	SUNKEN LAUNDRY PER PURCHASER	JUNE13-14	SD
2	ISSUED FOR B.E.P. ONLY	JUNE5-14	SD
1	ISSUED FOR PERMIT APPLICATION	MAY5-14	SD
No.	Description	Date	By
REVISIONS			

Footprint: **S2-A**

sht. title: **ALT. SECOND FLOOR-A**

drawn by: **MB**

checked by: **OF**

date: **FEB. 2007**

scale: **3/16"=1'**


sheet no: **3A.4**
6






REAR ELEVATION 'A' (3 BEDRM. W/O)


NOTE:
REFER TO FRONT ELEVATION FOR
TYPICAL NOTES & INFORMATION

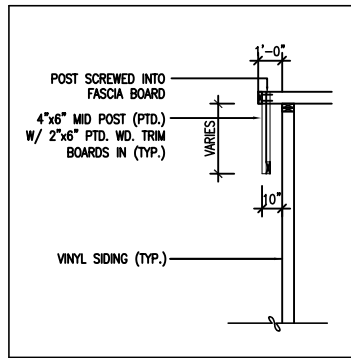

GABLE DECOR. DETAIL

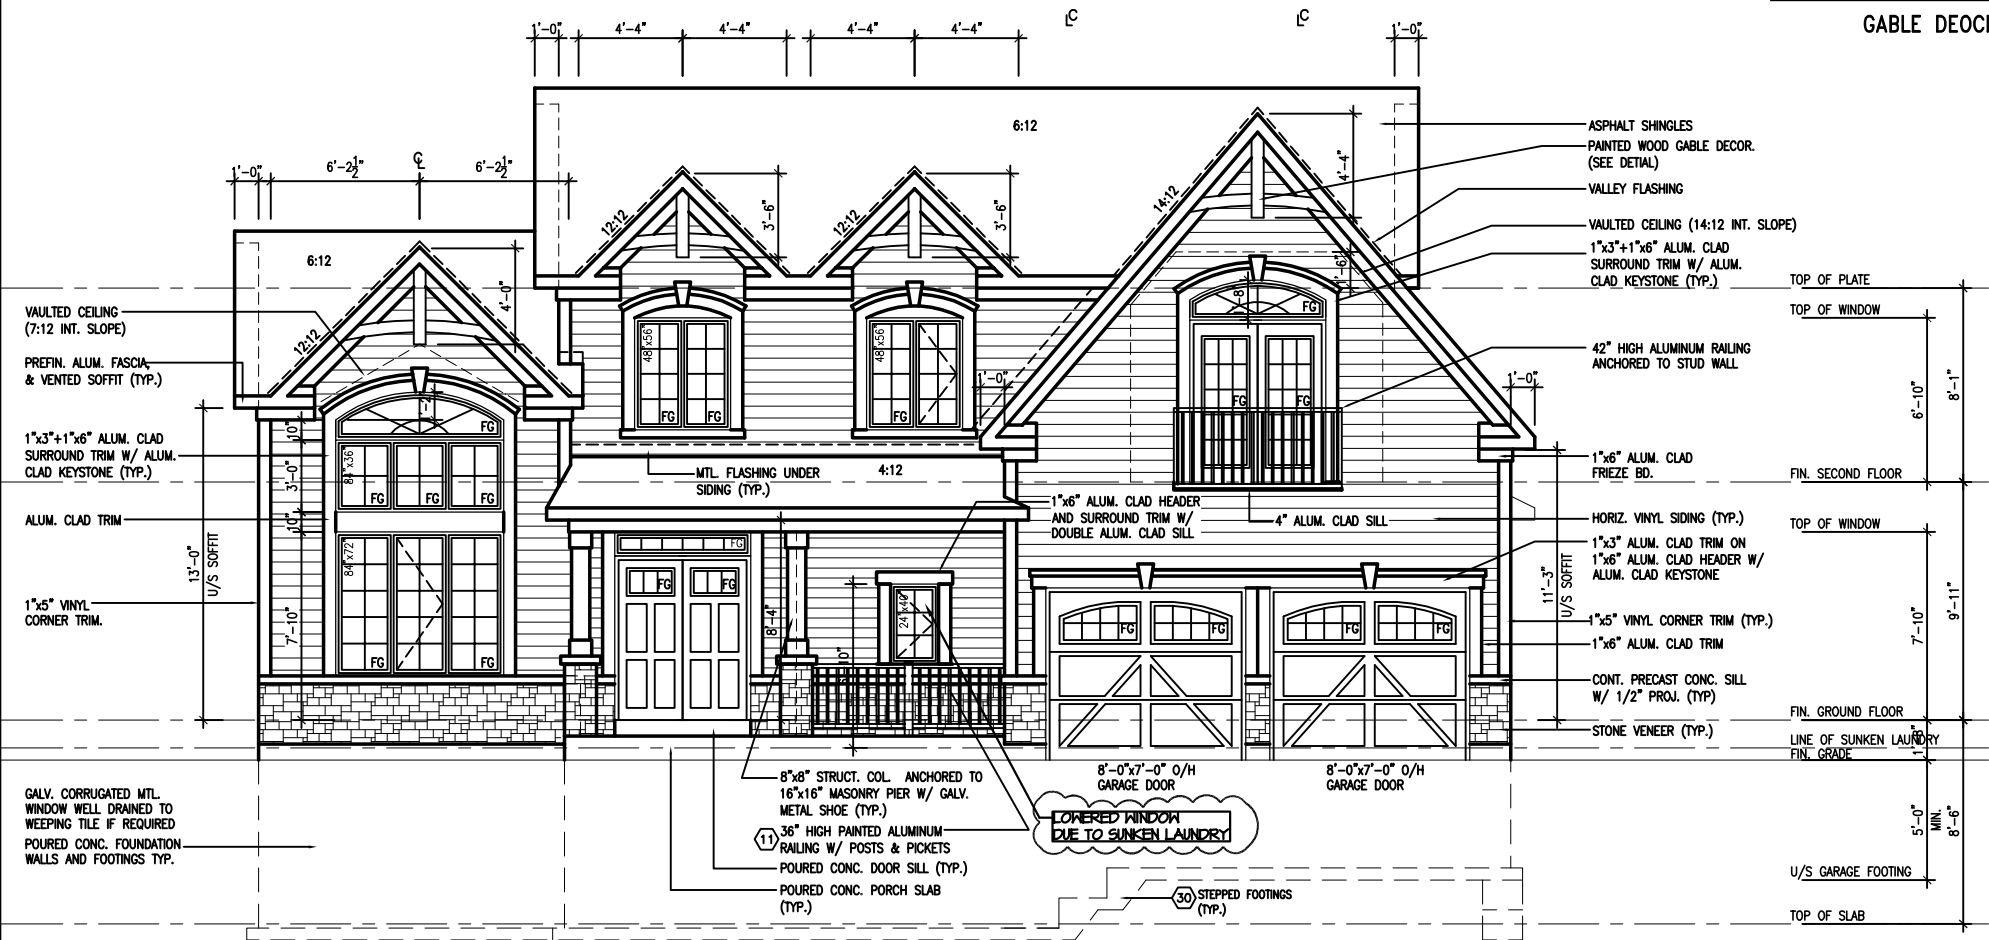

FRONT ELEVATION 'A'

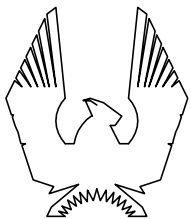

PHOENIX HOMES

Viljoen
Architect
Inc.

300 A Wilson Avenue
North York, Ontario
M3H 1S8
TEL: (416) 630-2255
FAX: (416) 630-4782

MERKHET-2008-A

SITE: WHITE TAIL RIDGE

LOT NUMBER:

CIVIC ADDRESS:
176 ANTLER COURT

19

6	REV. AS PER CONST. SUMMARY	JUL28-14	SD
5	REV. AS PER CONST. SUMMARY	JUL15-14	SD
4	ISSUED FOR B.E.P. ONLY	JUN26-14	SD
3	SUNKEN LAUNDRY PER PURCHASER	JUNE13-14	SD
2	ISSUED FOR B.E.P. ONLY	JUNE5-14	SD
1	ISSUED FOR PERMIT APPLICATION	MAY5-14	SD
No.	Description	Date	By
REVISIONS			

Footprint: S2-A

sht. title: ELEVATIONS-A

drawn by: MB




checked by: OF

date: FEB. 2007

scale: 1/8"=1'

sheet no:

4A
6

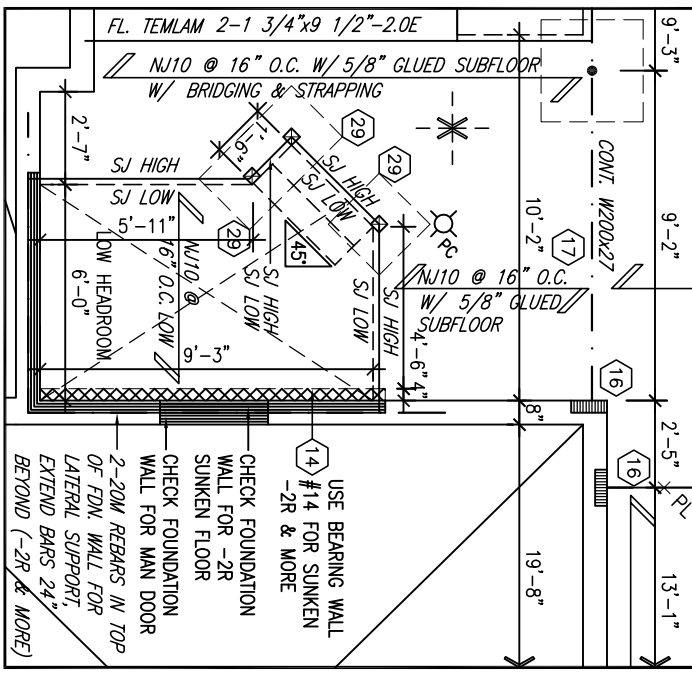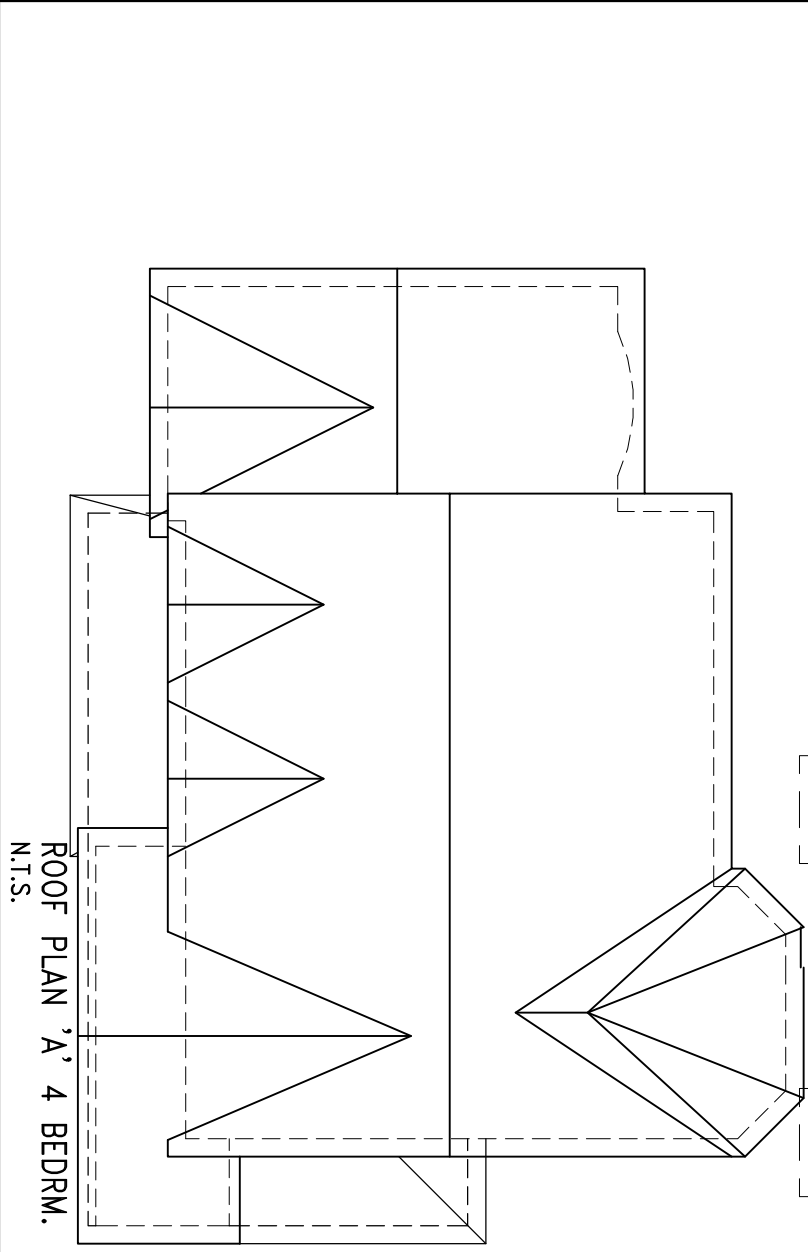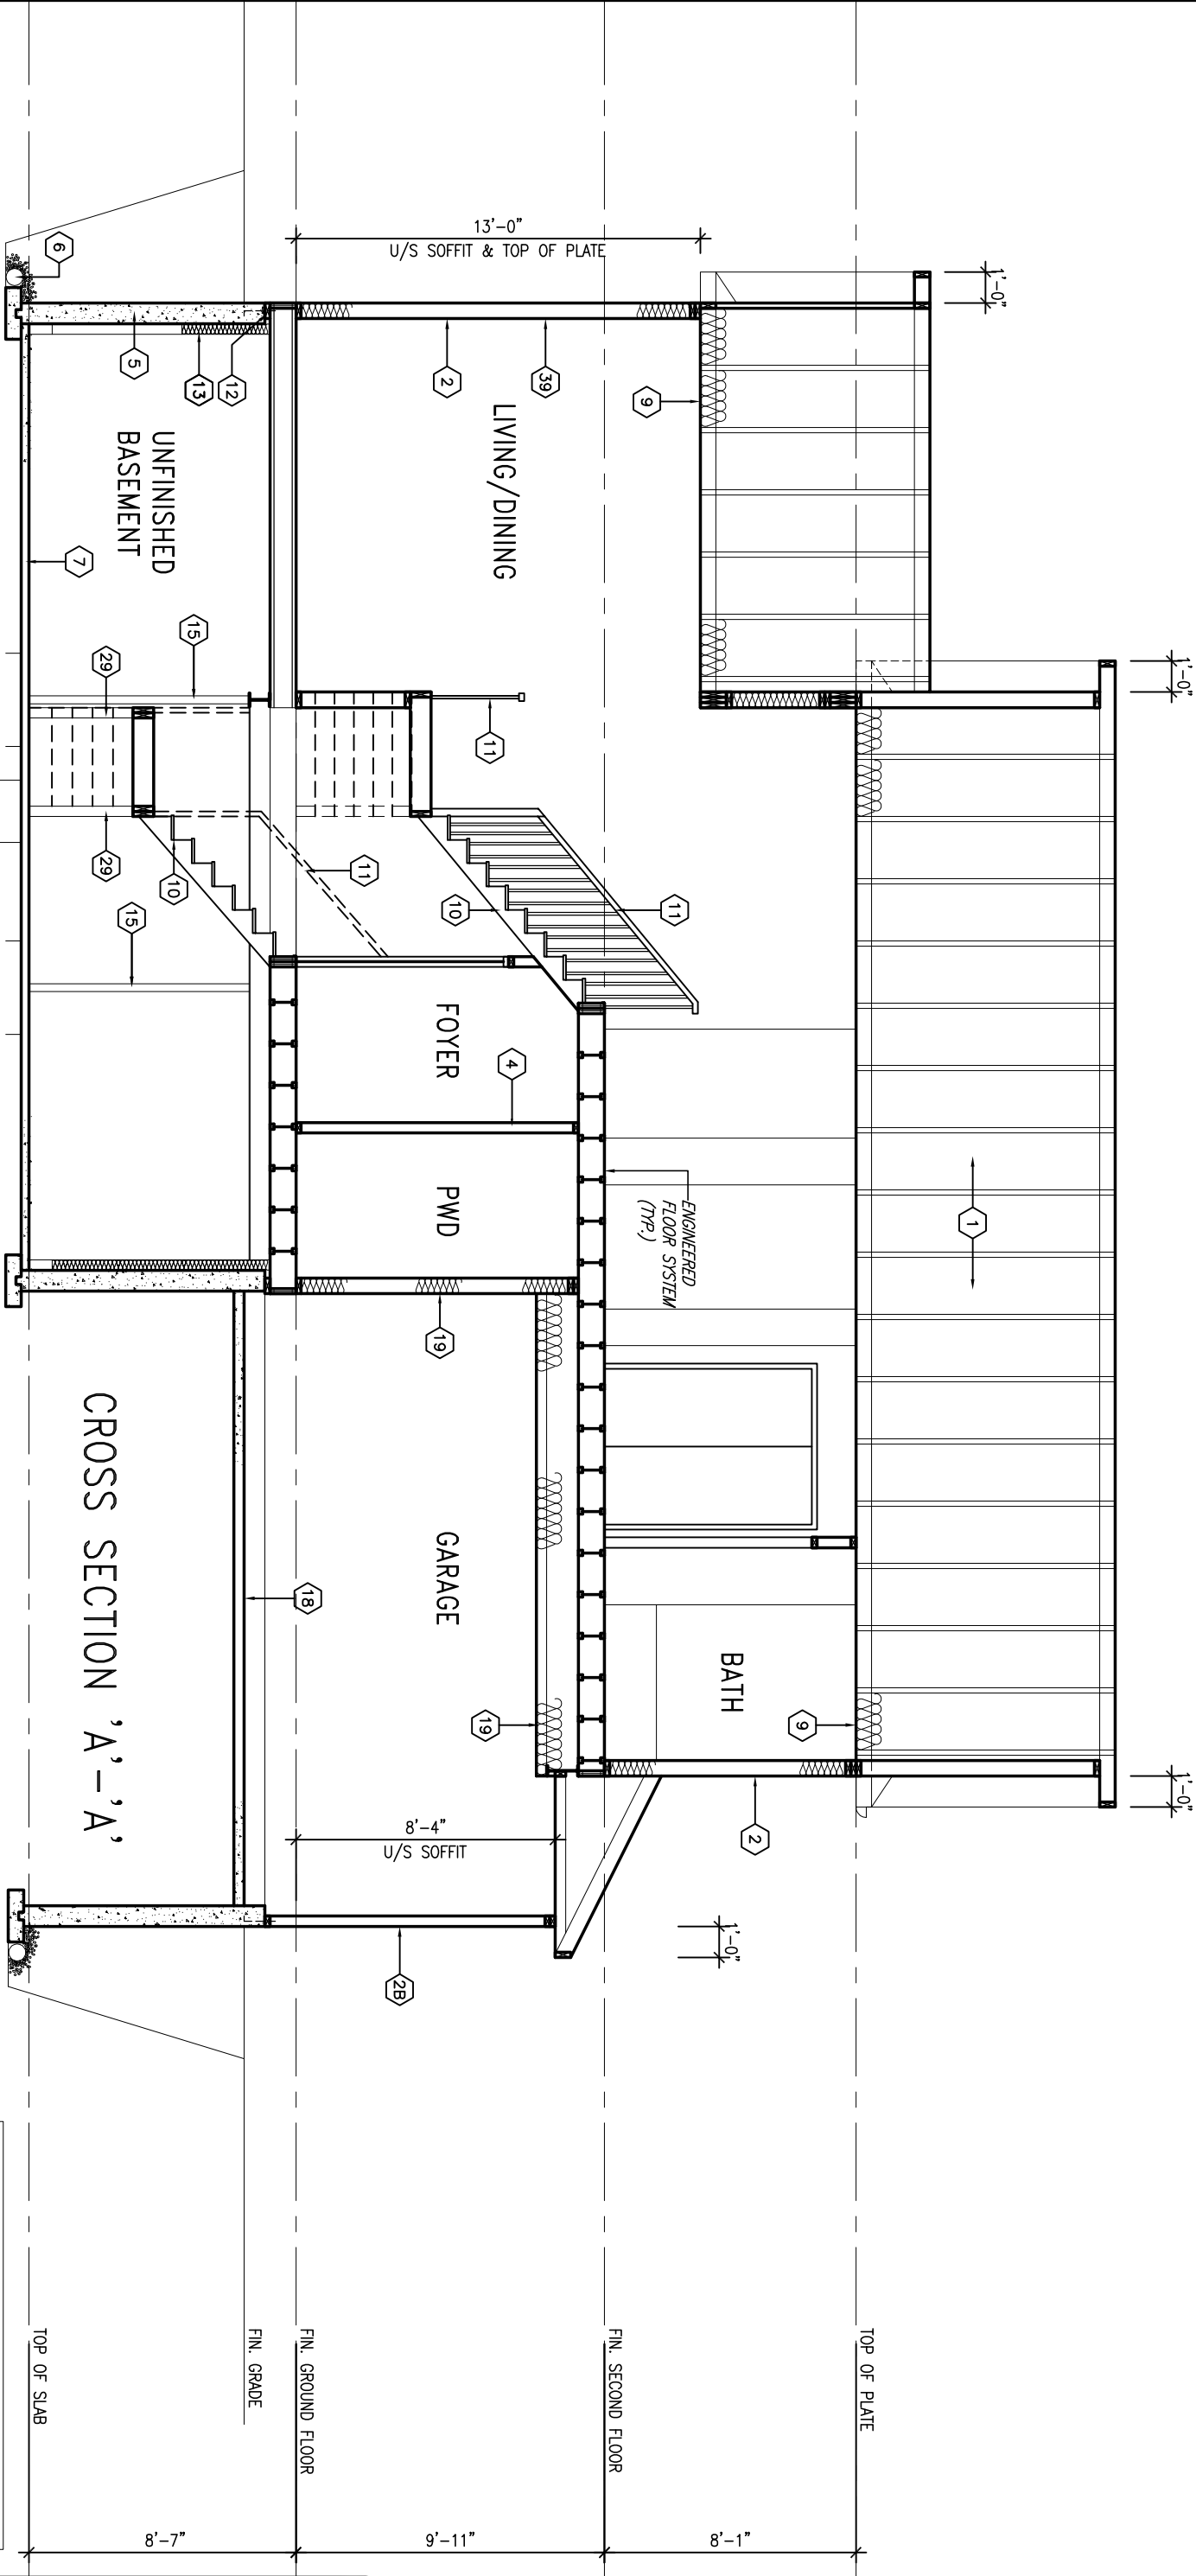

ELEV. A	AREA CALCULATIONS
4 BEDRM.	GROUND FLOOR AREA
1151 SF	SECOND FLOOR AREA
1441 SF	SUBTOTAL
2592 SF	DEDUCT ALL OPEN AREAS
368 SF	TOTAL NET AREA
2224 SF	FINISHED BSMT AREA
(206.6 m ²)	COVERAGE
0 SF	W/OUT PORCH
1576 SF	COVERAGE
(146.4 m ²)	W/ PORCH
1680 SF	COVERAGE
(156.1 m ²)	W/ PORCH



Viljoen Architect Inc.

300 A Wilson Avenue
North York, Ontario
M3H 1S8
TEL: (416) 630-2255
FAX: (416) 630-4782

MERKHET-2008-A

SITE: **WHITE TAIL RIDGE**

LOT NUMBER: **19**

CIVIC ADDRESS:
176 ANTLER COURT

6	REV. AS PER CONST. SUMMARY	JUL28-14	SD
5	REV. AS PER CONST. SUMMARY	JUL15-14	SD
4	ISSUED FOR B.E.P. ONLY	JUN26-14	SD
3	SUNKEN LAUNDRY PER PURCHASER	JUNE13-14	SD
2	ISSUED FOR B.E.P. ONLY	JUNE5-14	SD
1	ISSUED FOR PERMIT APPLICATION	MAY5-14	SD
No.	Description	Date	By
REVISIONS			

Footprint:	S2-A
sht. title:	ALT. SECOND FLOOR-A
drawn by:	MB
checked by:	OF
date:	FEB. 2007
scale:	3/16"=1'
sheet no:	6