


CUSTOMER APPROVAL

I have reviewed these drawings and understand the details of the layout and the Carver Kitchens specifications.

Signature: 

Date: Aug. 31/15

**LOT 77 WHITE TAIL RIDGE
KITCHEN - 3D VIEW #1**

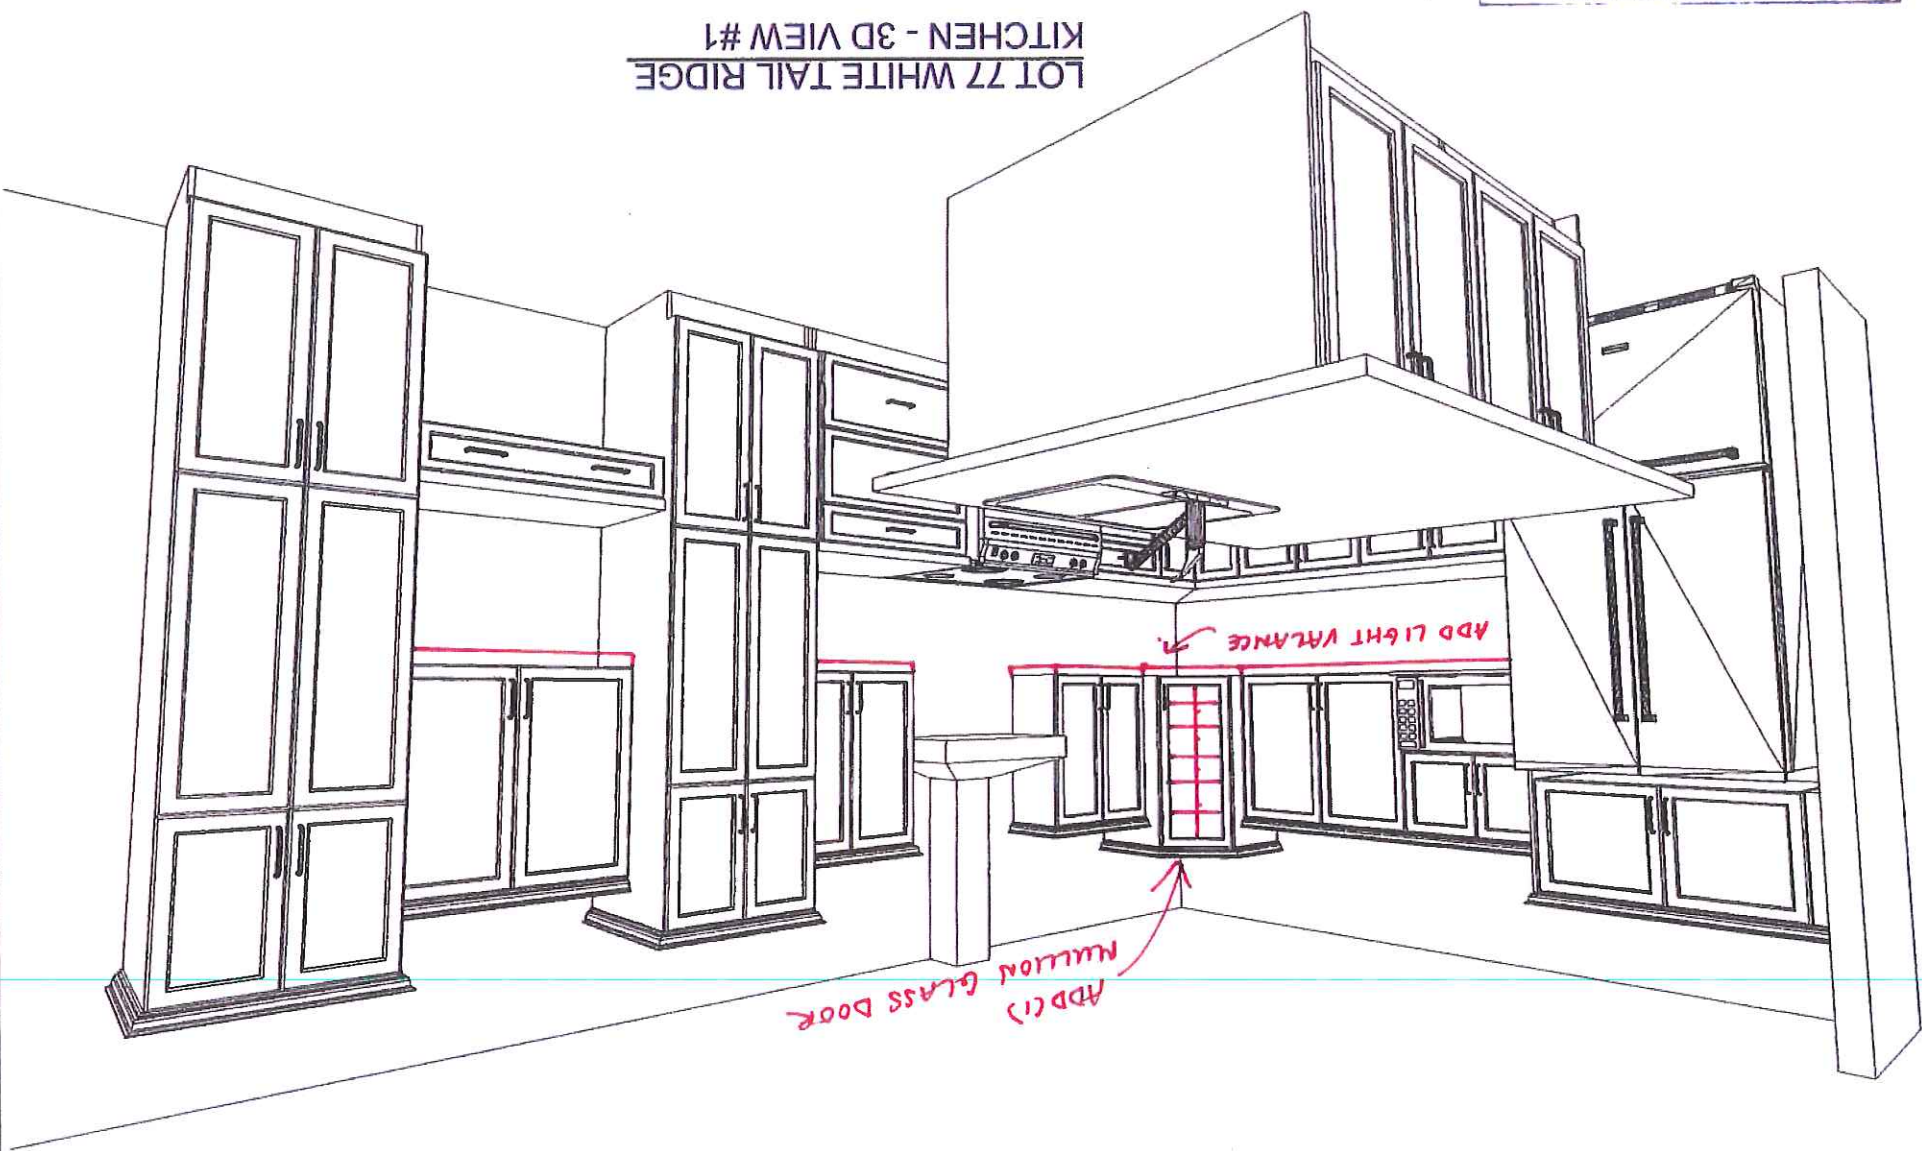

Note: This drawing is an artistic interpretation of the general appearance of the design. It is not meant to be an exact rendition.

Drawn By: Lori D Saverio, B.I.D.
SPECTRUM KITCHENS INC



Designed: 20/07/2015
Printed: 20/07/2015


A 11

Drawings #1


LOT 77 WHITE TAIL RIDGE
KITCHEN - 3D VIEW #2

CUSTOMER APPROVAL

I have reviewed these drawings and understand the details of the layout and the Carter Kitchens specifications.

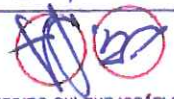Signature: 

Date: Aug. 31/15

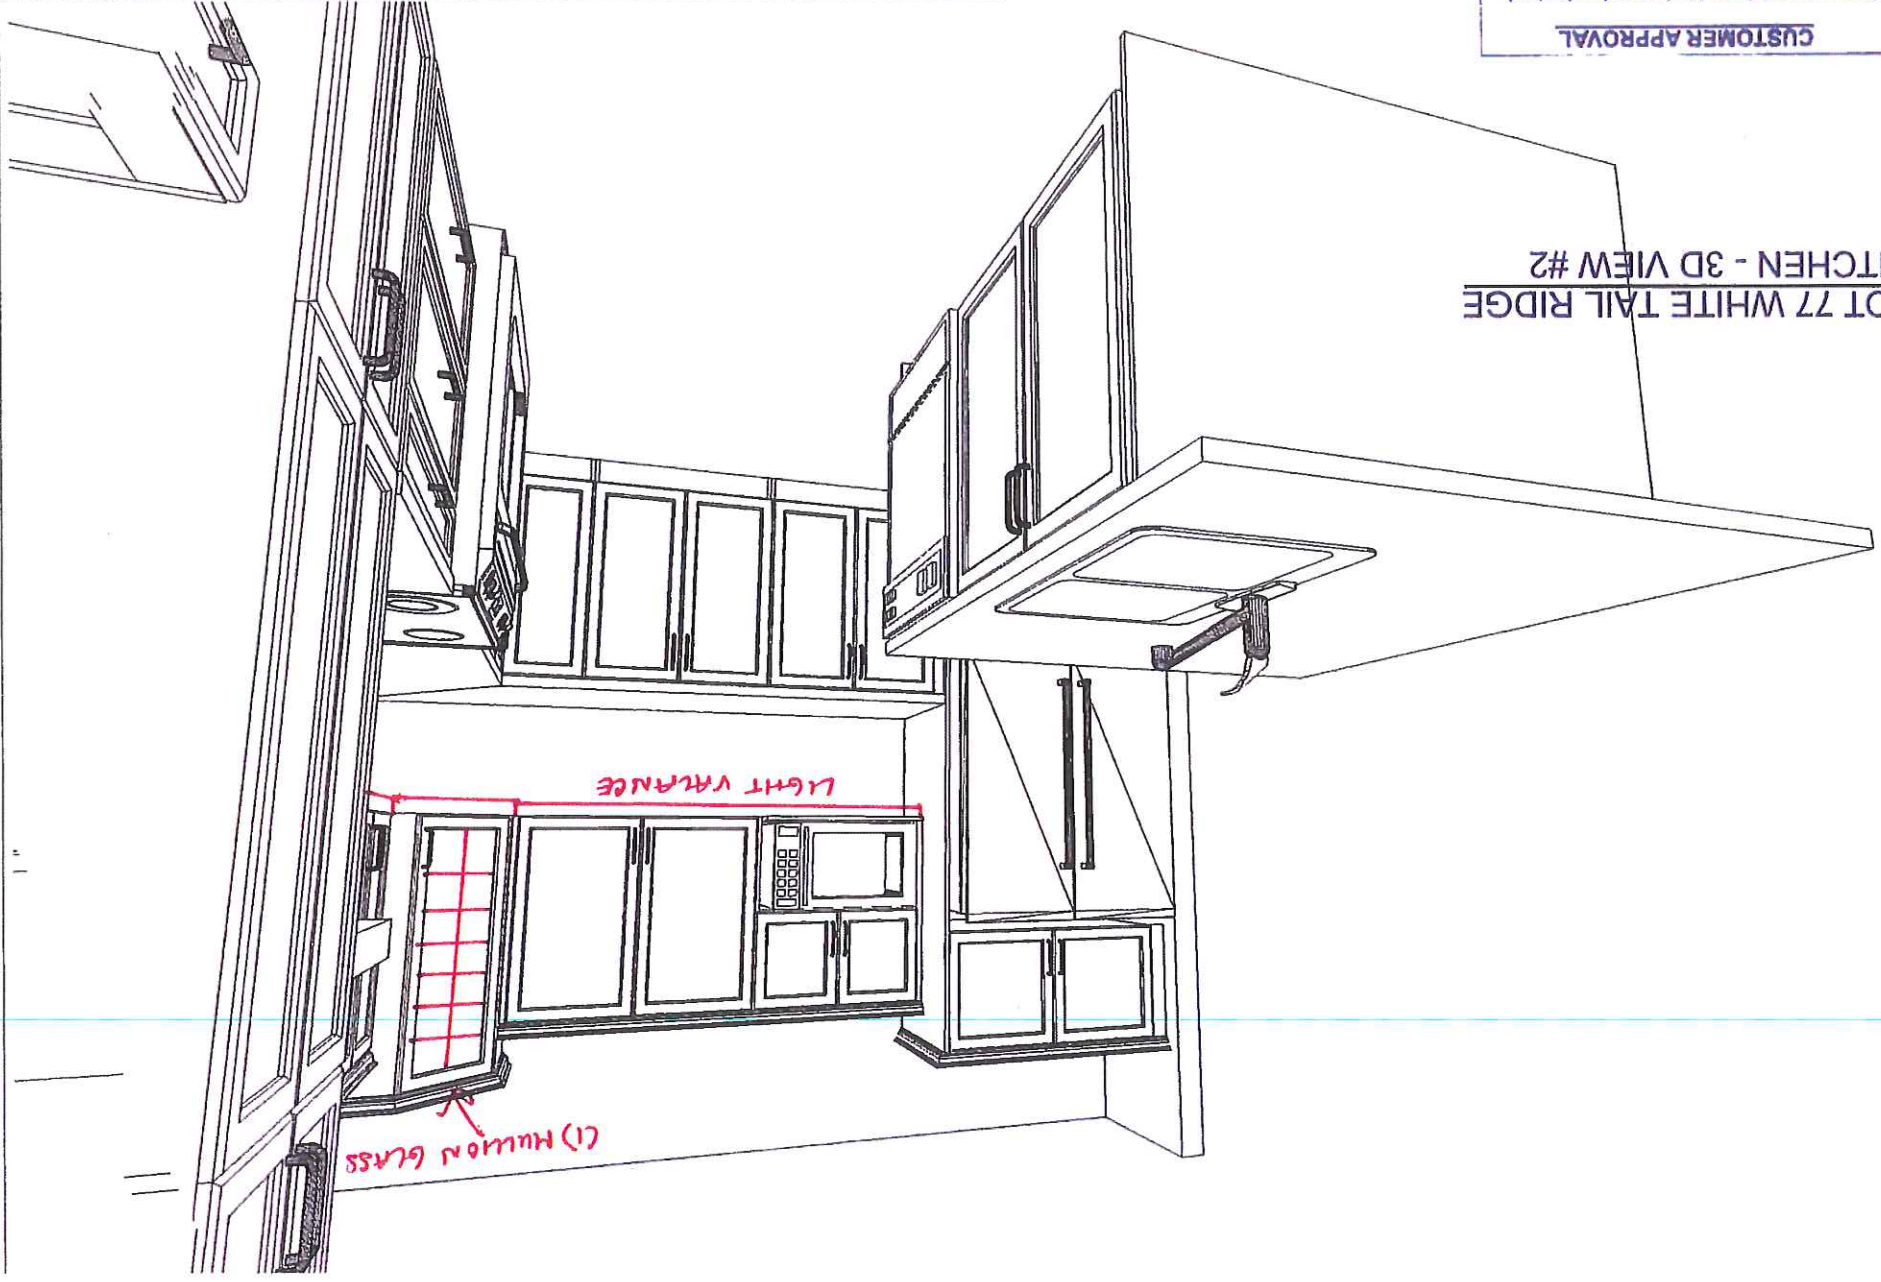

Note: This drawing is an artistic interpretation of the general appearance of the design. It is not meant to be an exact rendition.

Drawn By: Lori D Saverio, B.I.D.
 SPECTRUM KITCHENS INC

20/20 TECHNOLOGIES


Designed: 20/07/2015
 Printed: 20/07/2015

CUSTOMER APPROVAL

I have reviewed these drawings and understand the details of the layout and the Carter Kitchens specifications.

Signature: 

Date: Aug. 31/15

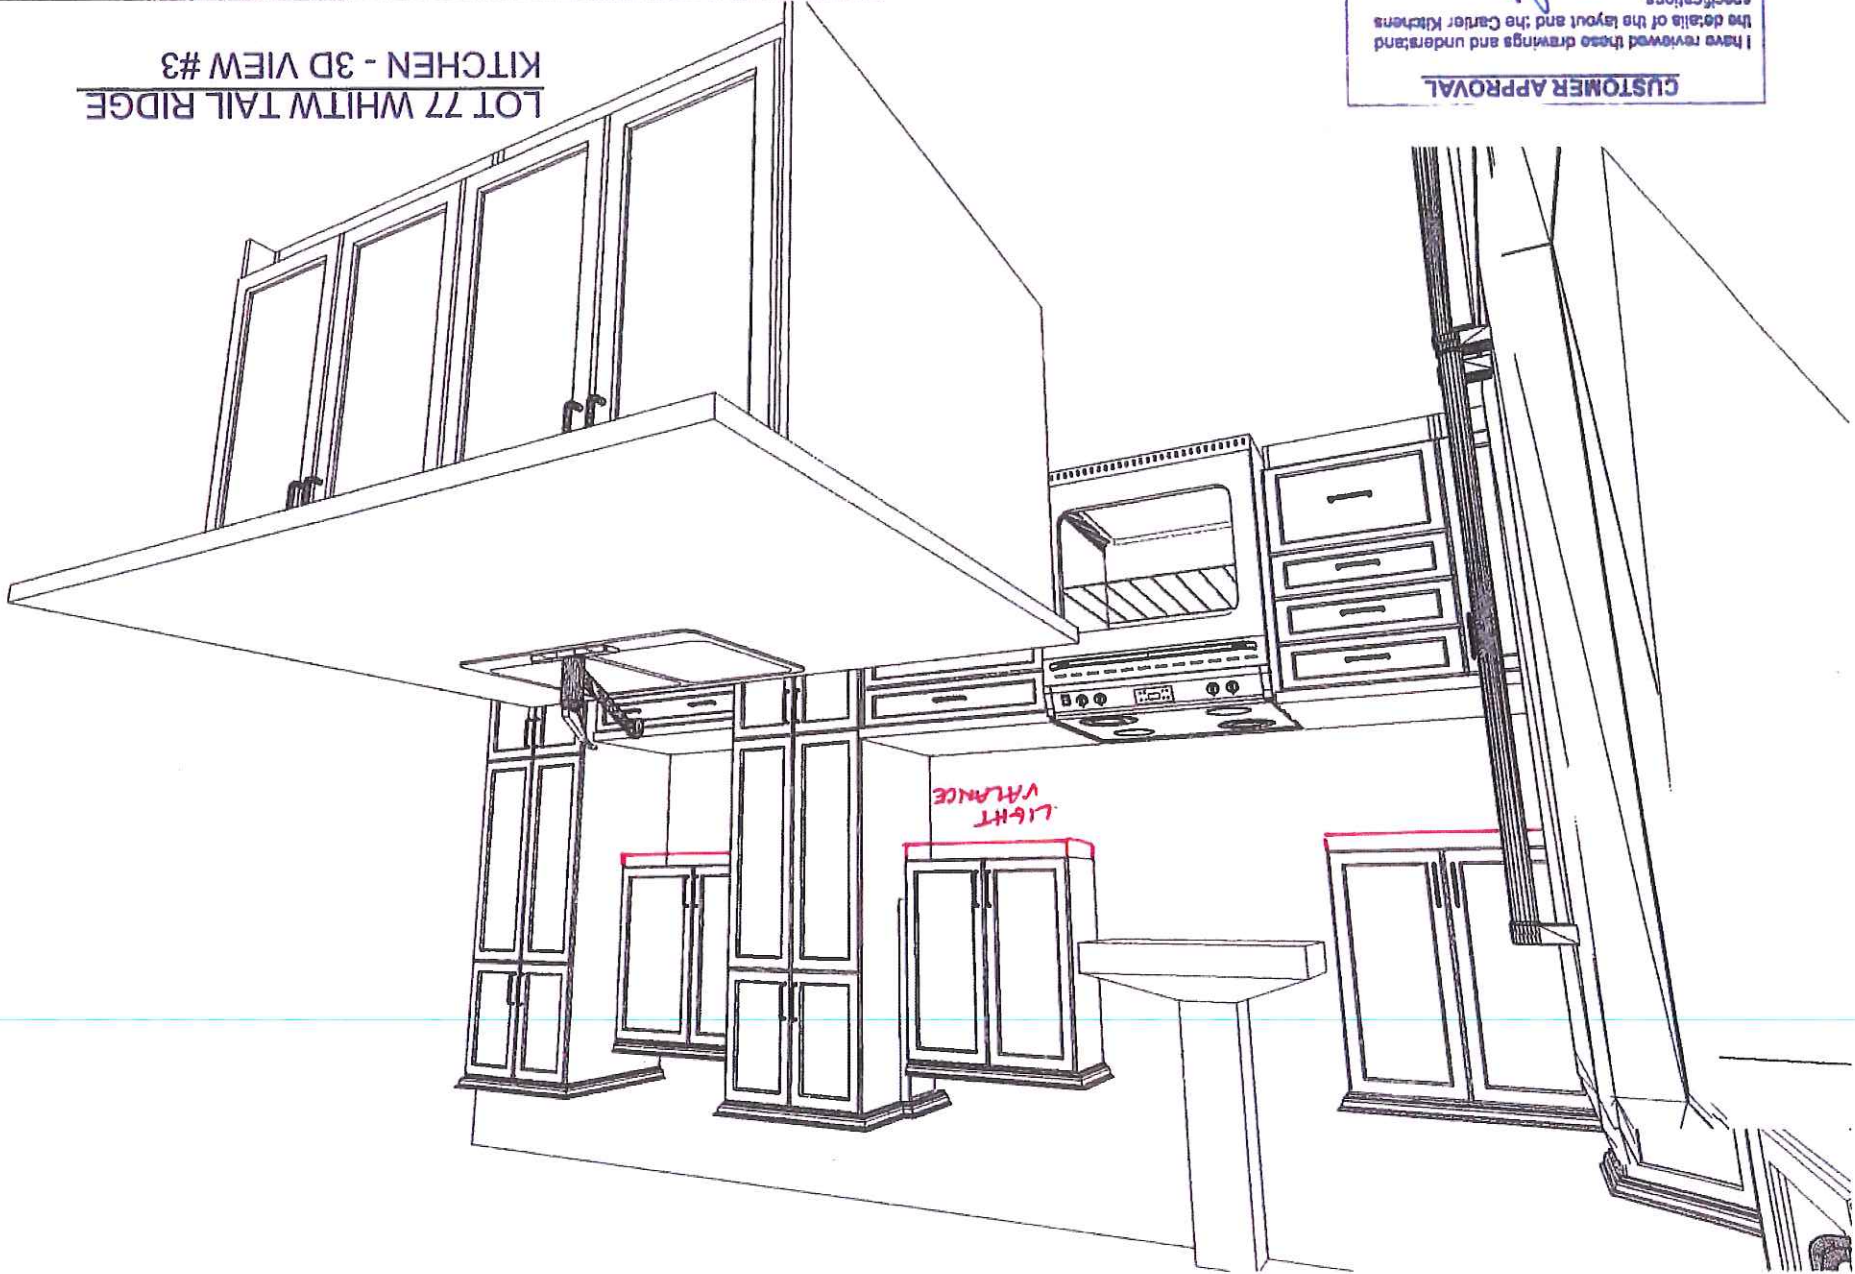

**LOT 77 WHITE TAIL RIDGE
KITCHEN - 3D VIEW #3**

Note: This drawing is an artistic interpretation of the general appearance of the design. It is not meant to be an exact rendition.

Drawn By: Lori D Saverio, B.I.D.
SPECTRUM KITCHENS INC.

2020 TECHNOLOGIES

Designed: 20/07/2015
Printed: 20/07/2015

CUSTOMER APPROVAL

I have reviewed these drawings and understand the details of the layout and the Carter Kitchens specifications.

Signature: 

Date: Aug. 31/15


Note: This drawing is an artistic interpretation of the general appearance of the design. It is not meant to be an exact rendition.

Drawn By: Lori D Saverio, B.I.D.
SPECTRUM KITCHENS INC

20/20 TECHNOLOGIES

Designed: 20/07/2015
Printed: 20/07/2015

LOT 77 WHITE TAIL RIDGE - FRIDGE WALL ELEVATION

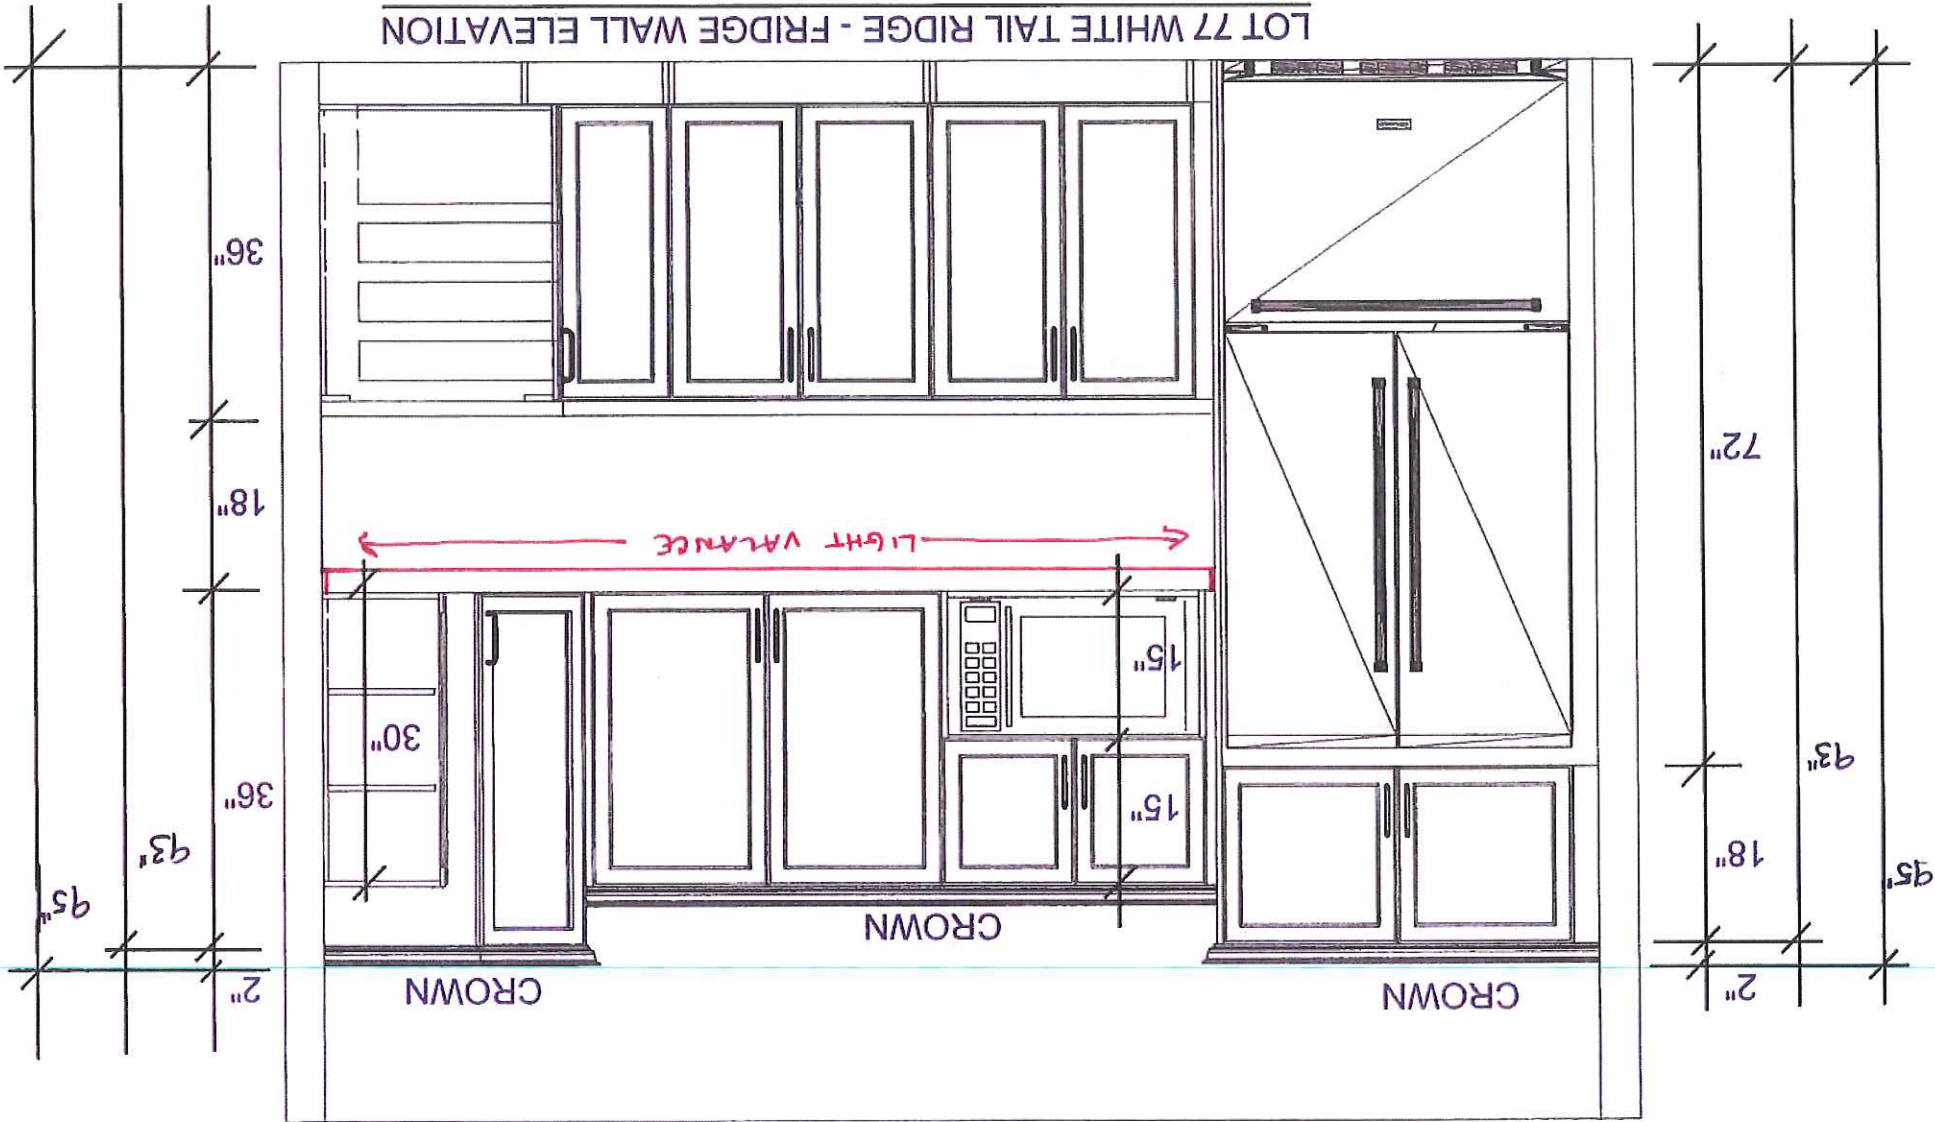


CUSTOMER APPROVAL

I have reviewed these drawings and understand the details of the layout and the Carter Kitchens specifications.

Signature: 

Date: Aug. 31/15

LOT 77 WHITE TAIL RIDGE - STOVE WALL ELEVATION

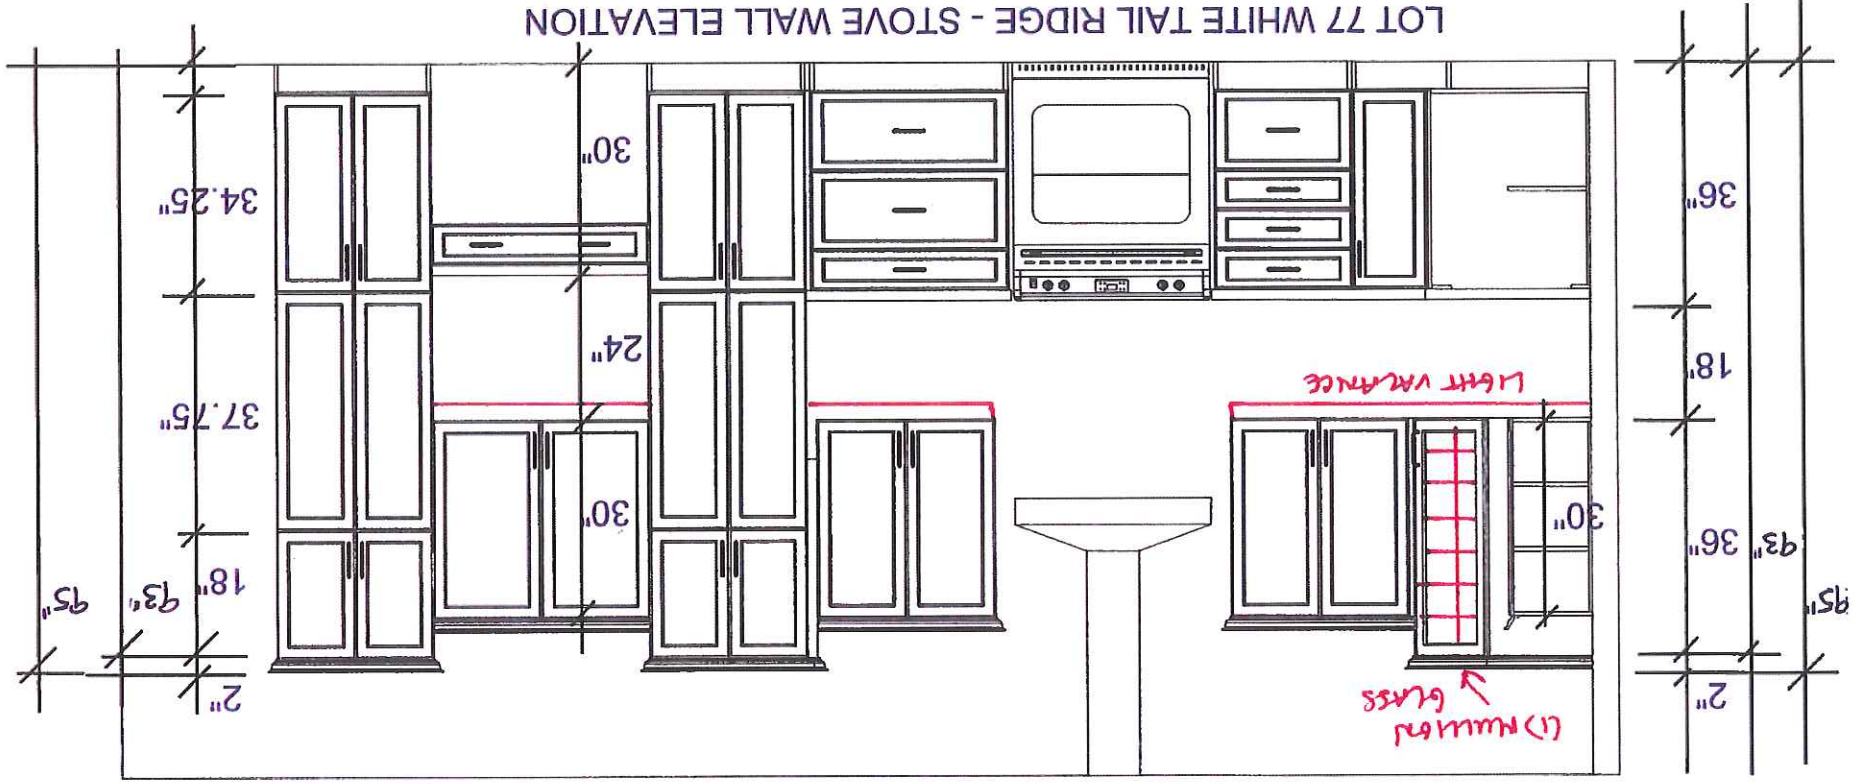

Note: This drawing is an artistic interpretation of the general appearance of the design. It is not meant to be an exact rendition.

Drawn By: Lori D. Saverio, B.I.D.
SPECTRUM KITCHENS INC.

20/20 TECHNOLOGIES

Designed: 20/07/2015
Printed: 20/07/2015