


15 3.5"DIA. ADJ. HSS ON
CONC. PAD FOOTING

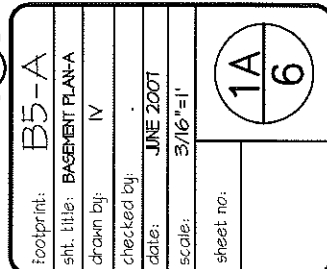

No.	Description	Date	By
3	ISSUED FOR BEP ONLY (TO SITE)	MAY15-14	SD
2	ISSUED FOR BEP ONLY	APR28-14	SD
1	ISSUED FOR PERMIT APPLICATION	MAR27-14	SD


B5-A EQUINOX

SITE: WHITE TAIL RIDGE

LOT NUMBER: 88
CIVIC ADDRESS: 56 WHITE TAIL DR

Viljoen
Architect
Inc.

300 A Wilson Avenue
North York, Ontario
M3H 1S8
TEL: (416) 630-2255
FAX: (416) 630-4782

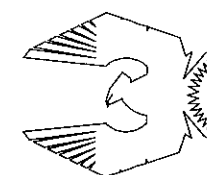

PHOENIX HOMES

LOFT

BASEMENT PLAN 'A'

LOFT

GROUND FLOOR PLAN 'A'

STUD WALL REINFORCEMENT FOR FUTURE
GRAB BARS IN MAIN BATHROOM (PG. C2)
REINFORCEMENT OF STUD WALLS SHALL BE INSTALLED
ADJACENT TO WATER CLOSETS AND SHOWER OR
BATHTUB IN MAIN BATHROOM. REFER TO DBC, 9.5.2.3,
3.8.3.6.(1)(d) & 3.8.3.13.(1)(i). AND DETAILS PROVIDED

ADD'L STEEL
MANDOOR C/W
LIGHT & SWITCH

ADD'L WINDOW
24'x48'

SHOWER STALL IN LIEU
OF STD. SEE SUMMARY

RELOCATED
DOOR

APPROVED RAISED HEEL ROOF
MONO TRUSSES @ 24" O.C.

APPROVED RAISED HEEL ROOF STEPPED BOTTOM
CHORD TRUSSES @ 24" O.C.

DOUBLE STUD WALL
ABOVE LEDGE

8"x8" STRUCT. COL.
ANCHORED TO 14"x14"
MASONRY PIER W/ GALV.
MTL. SHOE (TYP.)

INSET STEP

END TRUSS

END TRUSS


HATCHED AREA
DENOTES NEW
PANTRY, SEE
KITCHEN LAYOUT

WINDOW SHIFTED
TO REAR
(EQUIDISTANT)
TO ACCOM. FOR
NEW PANTRY

ISSUED FOR BLDG. ENV.
88

Viljoen
Architect
Inc.

300 A Wilson Avenue
North York, Ontario
M3H 1S8
TEL: (416) 630-2255
FAX: (416) 630-4792

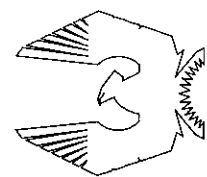

PHOENIX HOMES

SITE: WHITE TAIL RIDGE

LOT NUMBER:

CIVIC ADDRESS:
56 WHITE TAIL DR.


B5-A EQUINOX

Footprint:	B5-A
Site Title:	GROUND FLOOR PLAN-A
Drawn by:	IV
Checked by:	
Date:	JUNE 2001
Scale:	3/16"=1'
Sheet no:	2A/6

No.	Description	Date	By
3	ISSUED FOR BLDG. ENV.	MAY15-14	SD
2	ISSUED FOR BLDG. ENV.	APR28-14	SD
1	ISSUED FOR PERMIT APPLICATION	MAR27-14	SD

LOFT

LOFT PLAN 'A'

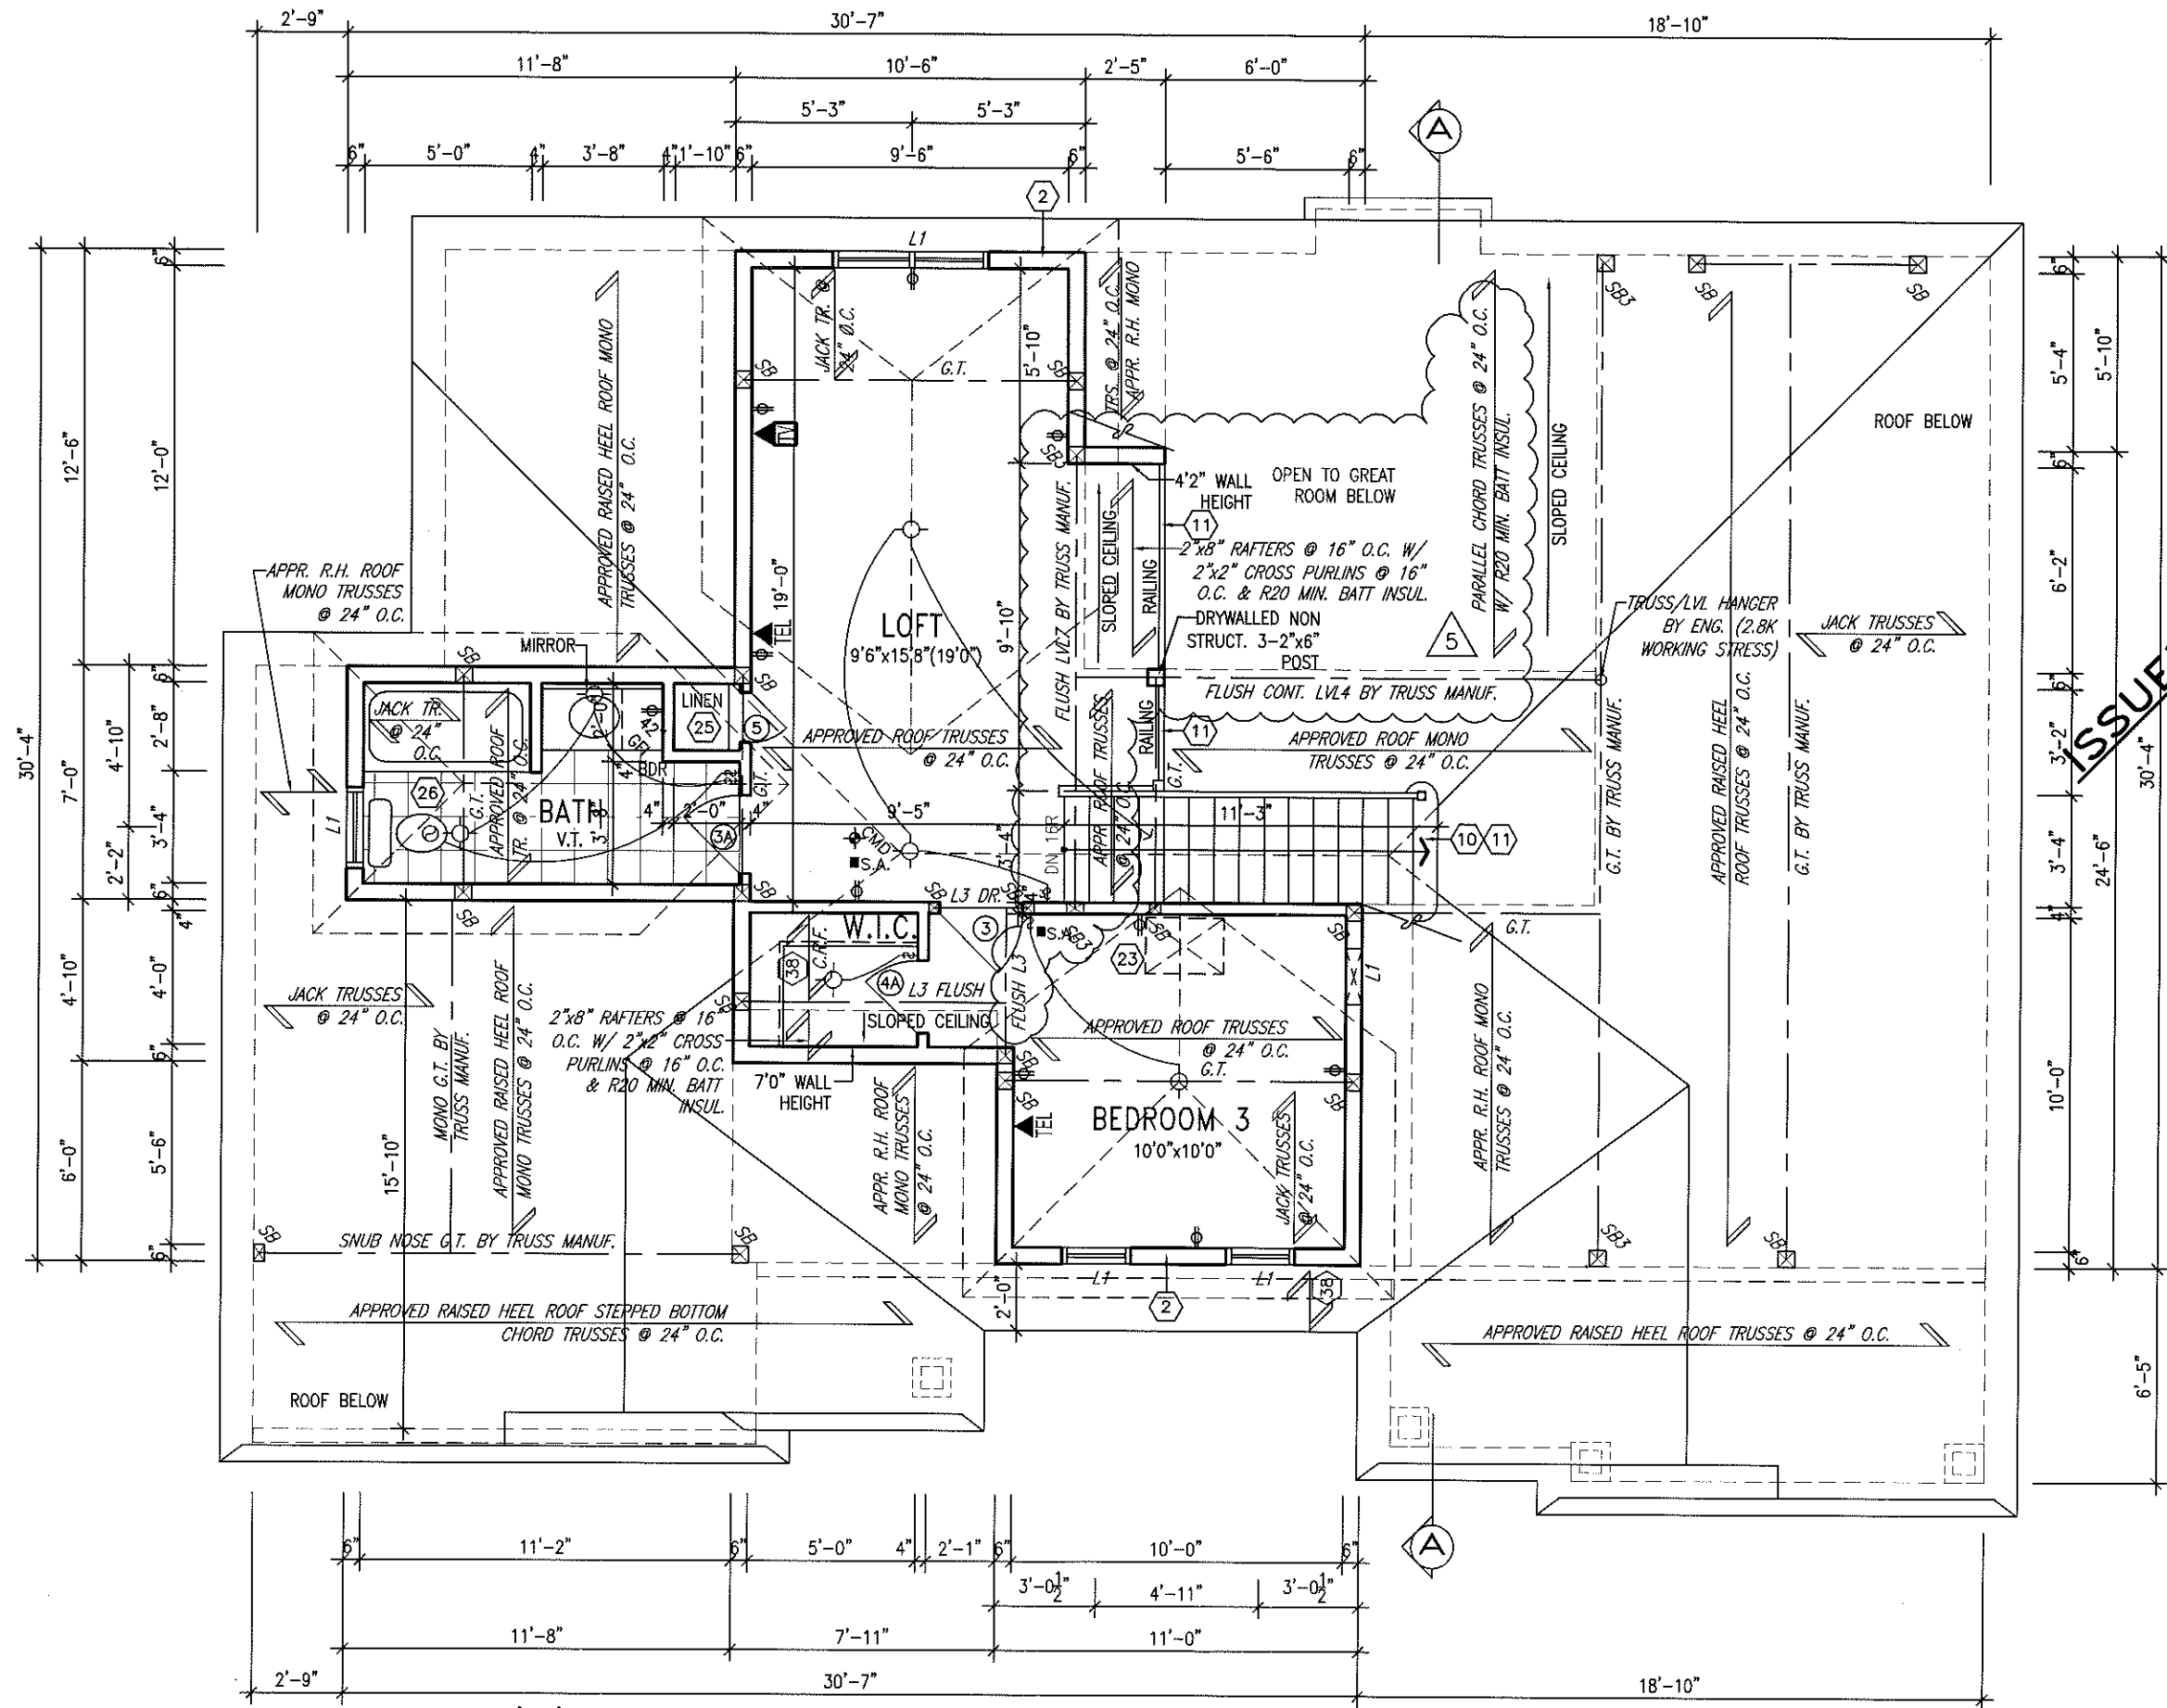


footprint: B5-A
sh. title: LOFT PLAN-A
drawn by: IV
checked by:
date: JUNE 2007
scale: 3/16"=1'
sheet no: 3A
6


No.	Description	Date	By
3	ISSUED FOR BEP ONLY (TO SITE)	MAY15-14	SD
2	ISSUED FOR BEP ONLY	APR28-14	SD
1	ISSUED FOR PERMIT APPLICATION	MAR27-14	SD

B5-A EQUINOX
SITE: WHITE TAIL RIDGE
LOT NUMBER: 88
CIVIC ADDRESS: 56 WHITE TAIL DR.

Viljoen Architect Inc.

300 A Wilson Avenue
North York, Ontario
M3H 1S8
TEL: (416) 630-2255
FAX: (416) 630-4782

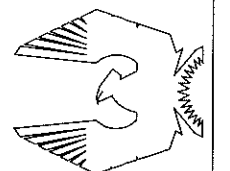
 **PHOENIX HOMES**

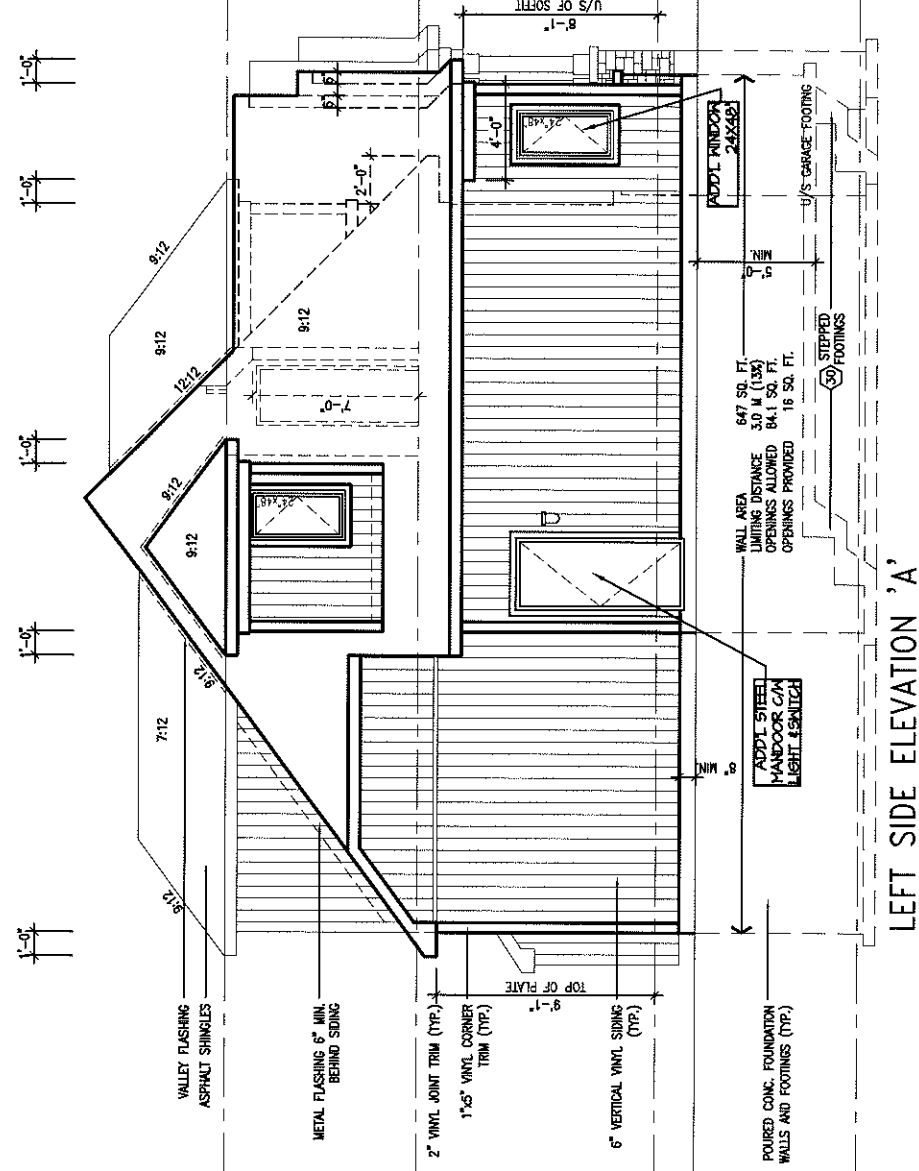

LEFT SIDE ELEVATION 'A'


NOTE: REFER TO FRONT ELEVATION FOR TYPICAL NOTE INFORMATION

ISSUED FOR BLDG. ENY.
DRAFT

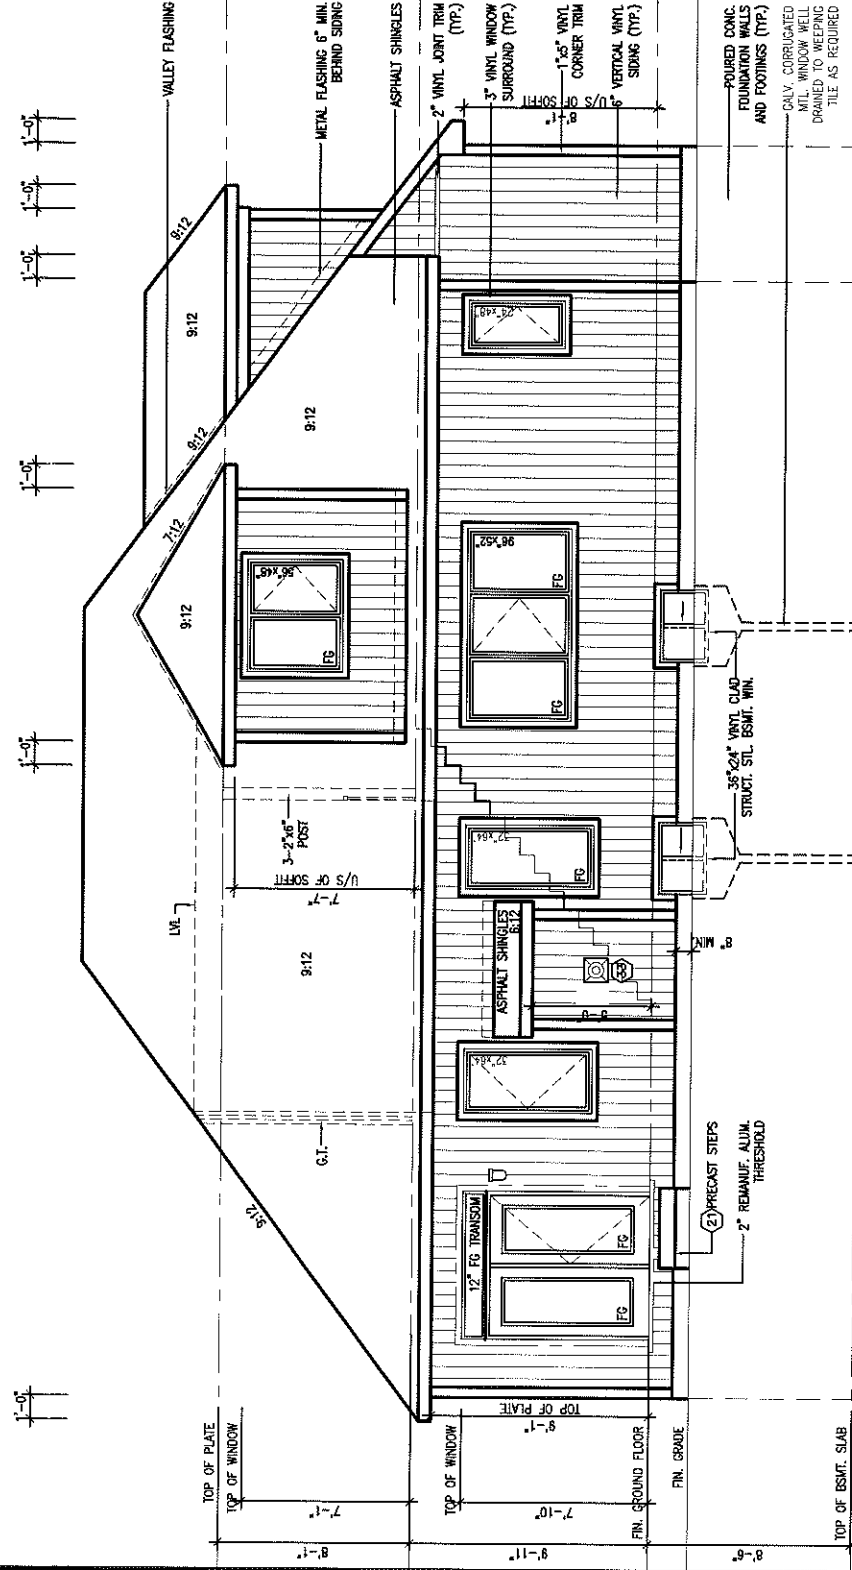

REAR ELEVATION 'A'

NOTE: REFER TO FRONT ELEVATION FOR TYPICAL NOTE INFORMATION

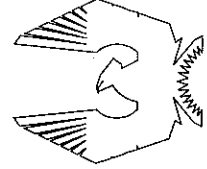

PHOENIX HOMES

Viljoen Architect Inc.

300 A. Wilson Avenue
North York, Ontario
M2H 1S8
TEL: (416) 630-2255
FAX: (416) 630-4782

B5-A EQUINOX


SITE: WHITE TAIL RIDGE

8888

LOT NUMBER:
CIVIC ADDRESS:
56 WHITE TAIL DR.

No.	Description	Date	By
3	ISSUED FOR BEP ONLY (TO SITE)	MAY15-14	SD
2	ISSUED FOR BEP ONLY	APR28-14	SD
1	ISSUED FOR PERMIT APPLICATION	MAR27-14	SD

footprint: B-5A	sh. title: ELEVATIONS-A
drawn by: IV	checked by:
date: JUNE 2007	scale: 1/8"=1'
sheet no: 5A	6

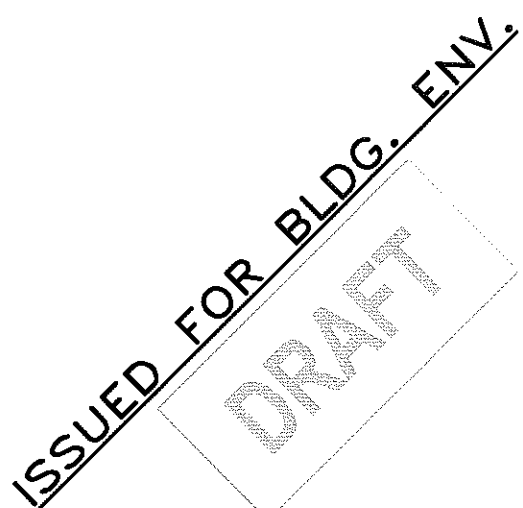

footprint: B5-LOFT	
shl. title: 95720N	
drawn by: IV	
checked by: .	
date: JUNE 2007	
scale: 3/16"=1"	
sheet no:	

[illegible]

B5-A EQUINOX


SITE: WHITE TAIL RIDGE

LOT NUMBER: 88

CIMC ADDRESS:
56 WHITE TAIL DR.

**Viljoen
Architect
Inc.**

300 A. Wilson Avenue
North York, Ontario
M3H 1S8
TEL: (416) 630-2255
FAX: (416) 630-4782

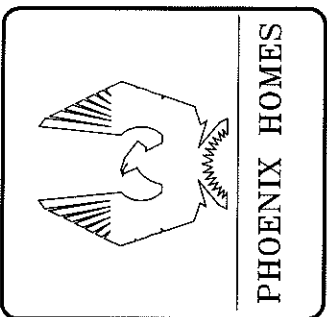

LOFT