



BASEMENT PLAN 'A'

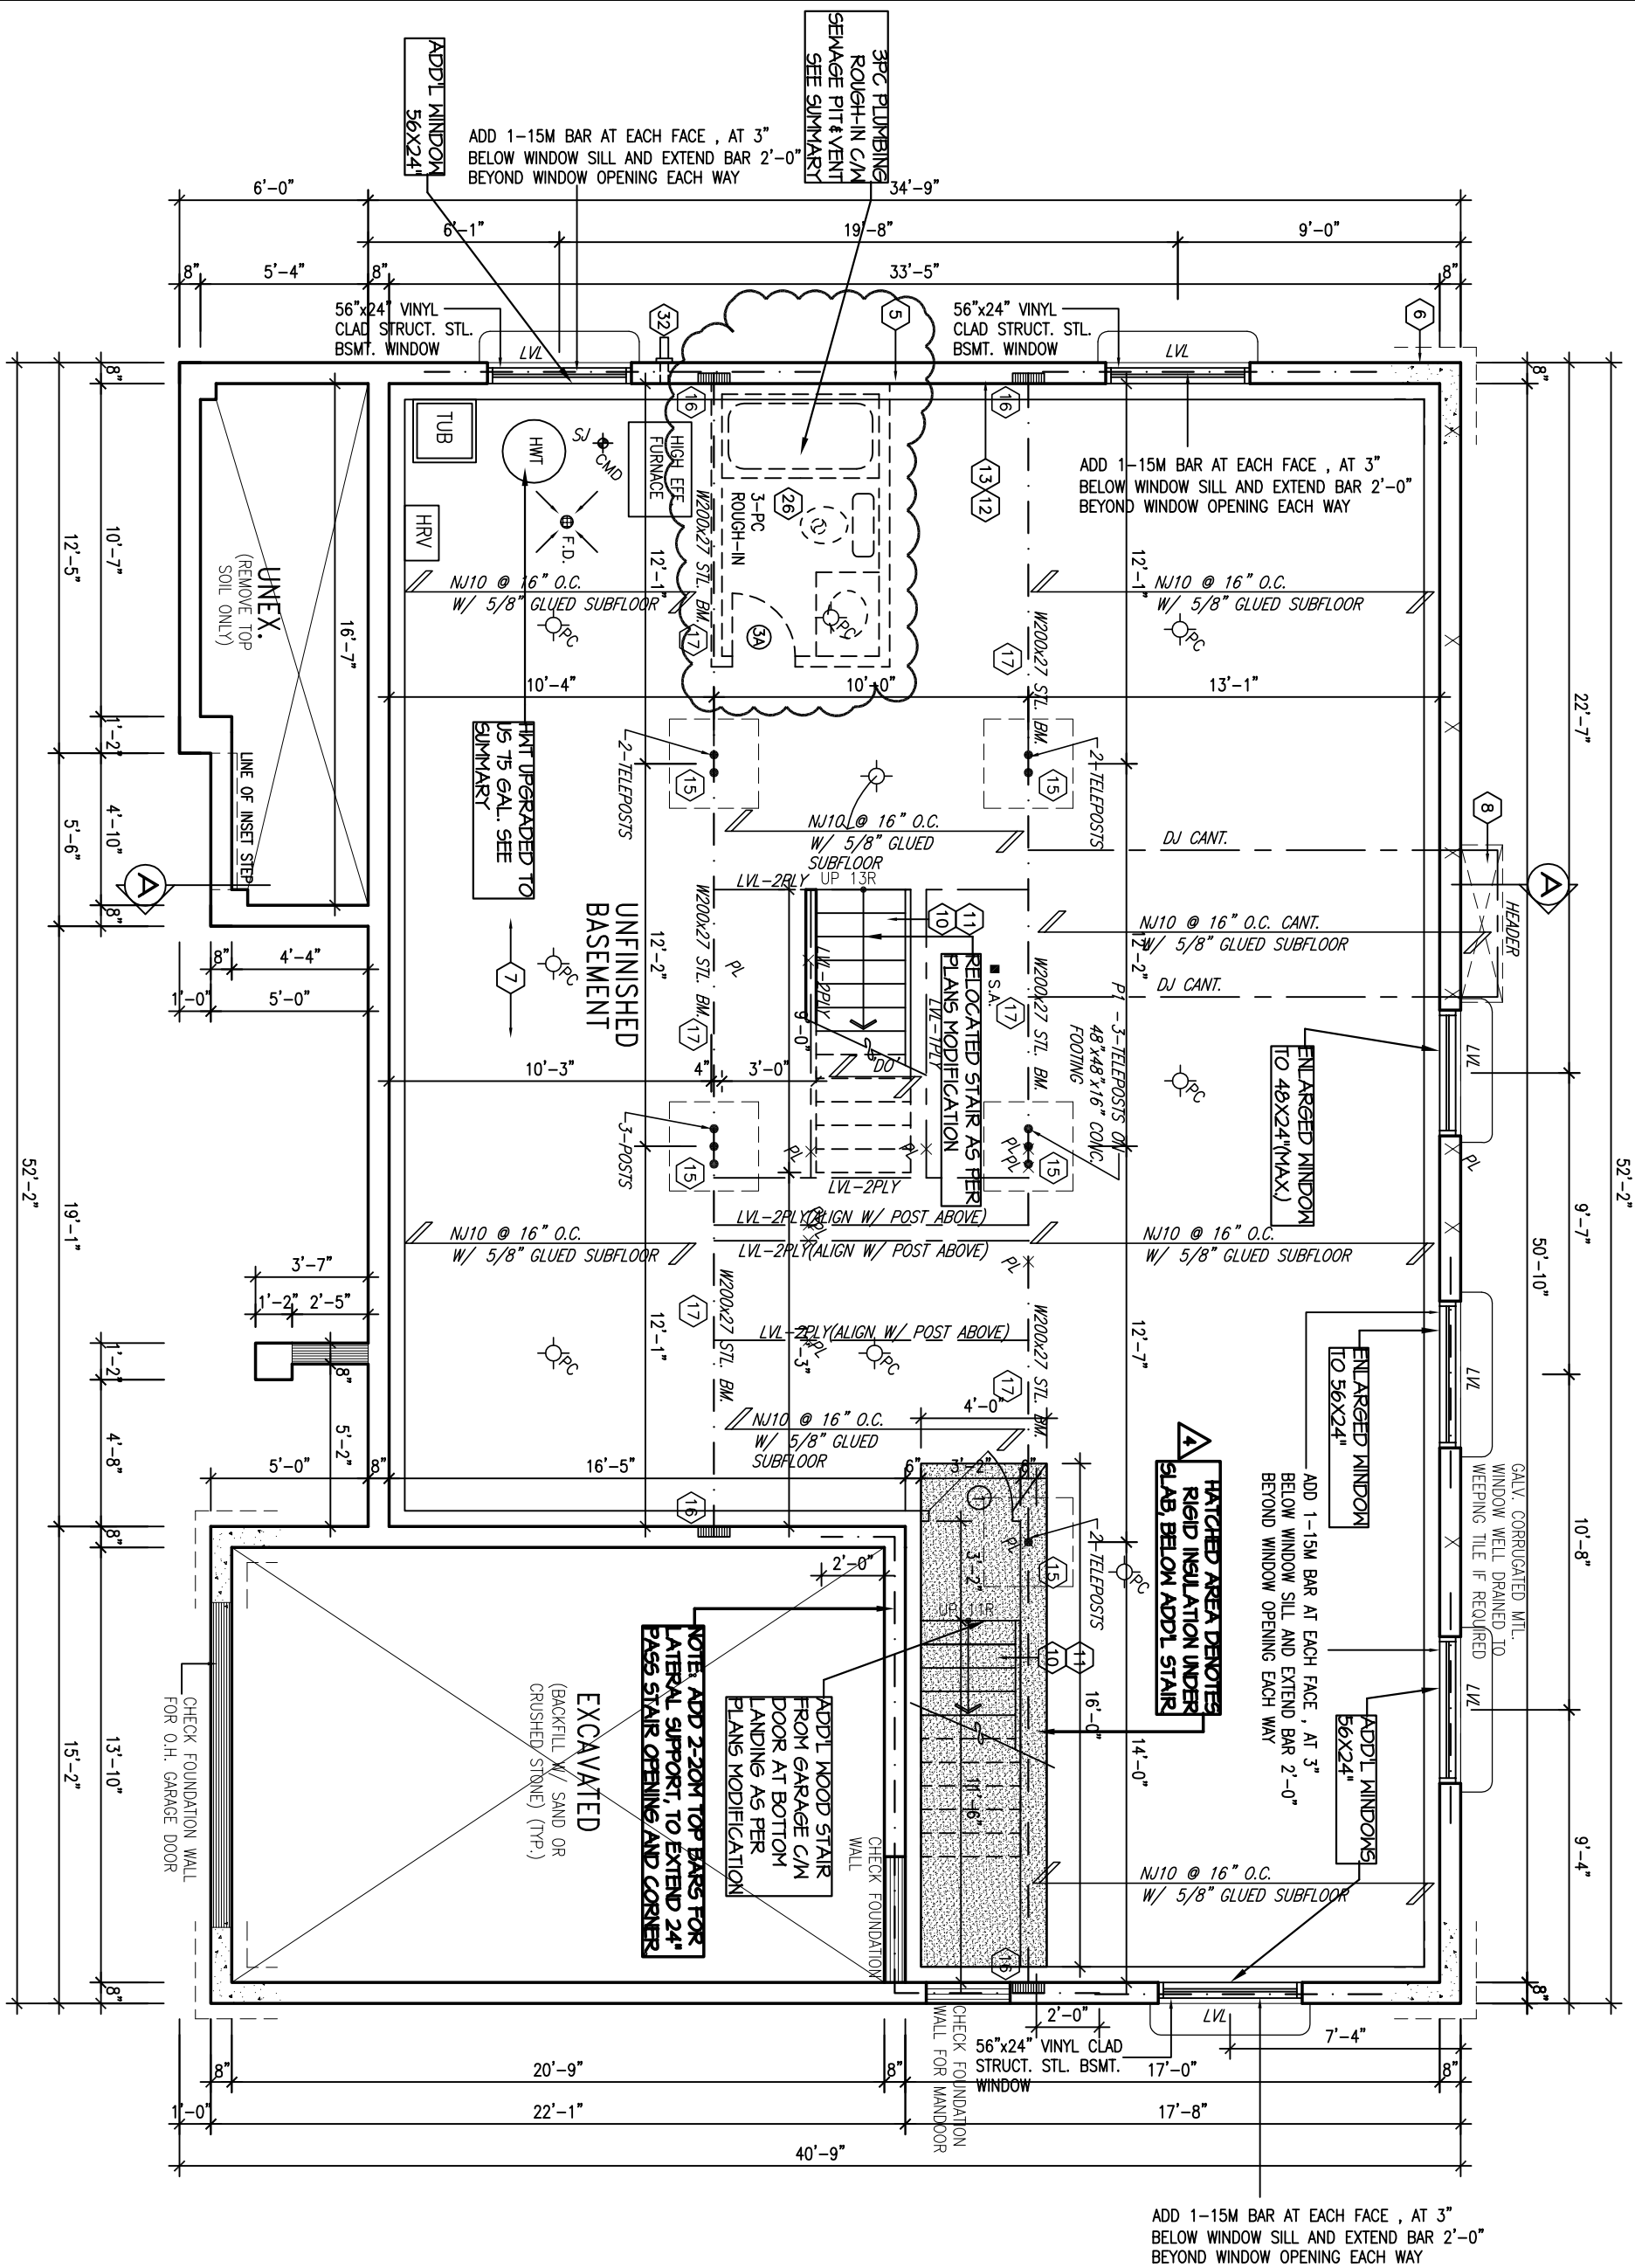

LOFT

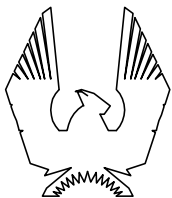

PHOENIX HOMES

Viljoen Architect Inc.

300 A Wilson Avenue
North York, Ontario
M3H 1S8
TEL: (416) 630-2255
FAX: (416) 630-4782

B5-A EQUINOX

SITE: WHITE TAIL RIDGE

LOT NUMBER:

97

CIVIC ADDRESS:
31 WHITE TAIL DR

8 REV. AS PER CONST. SUMMARY
7 REV. AS PER CONST. SUMMARY

OCT22-13 SD
OCT8-13 SD

6 REV. AS PER CONST. SUMMARY

SEP20-13 SD

5 REV. AS PER CONST. SUMMARY

SEP17-13 SD

4 ADDED RIGID INS. IN BASEMENT

AUG21-13 SD

3 REV. PER STRUCT. FRAMING REVIEW

JUL18-13 SD

2 FOR TRUSS & JOIST RE-DESIGN

JUNE26-13 SD

1 ISSUED FOR FOUNDATION ONLY

JUNE20-13 SD

No. Description
REVISIONS

Date By


footprint: B5-A
sht. title: BASEMENT PLAN-A
drawn by: IV
checked by:
date: JUNE 2007
scale: 3/16"=1'

sheet no:

1A
6

GROUND FLOOR PLAN 'A'

LOFT

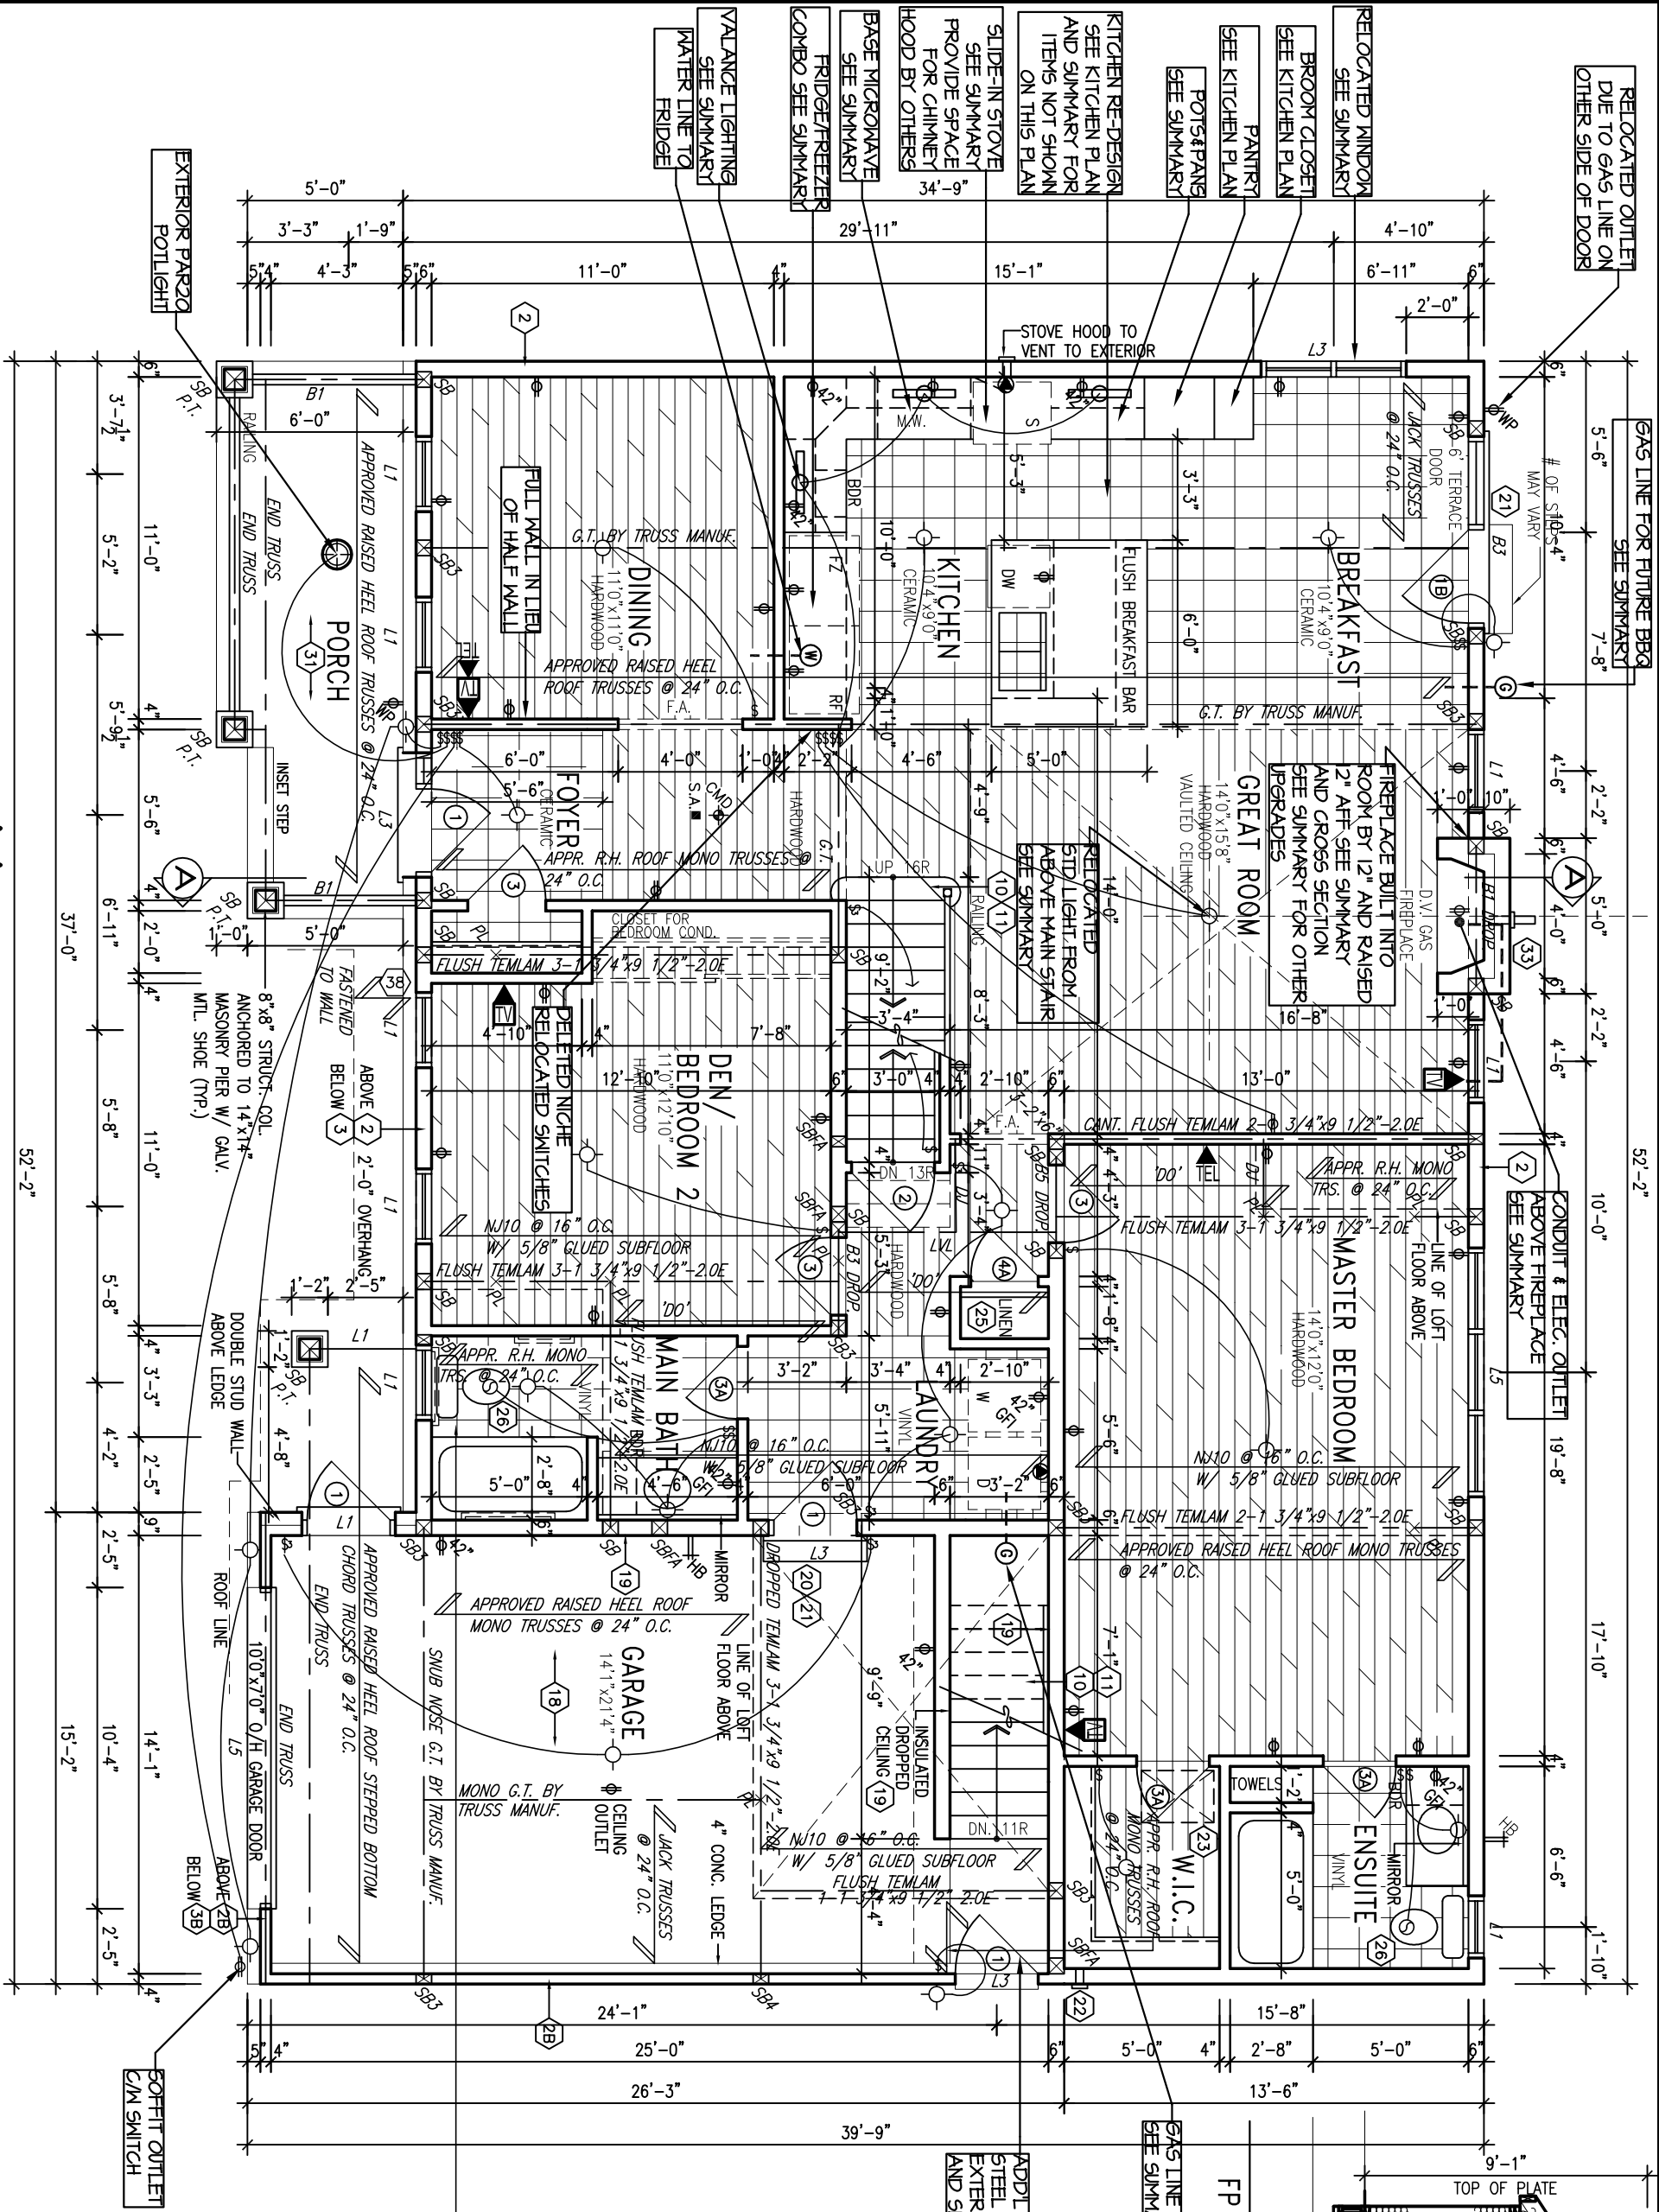


STUD WALL REINFORCEMENT FOR FUTURE GRAB BARS IN MAIN BATHROOM (PG. C2)
REINFORCEMENT OF STUD WALLS SHALL BE INSTALLED ADJACENT TO WATER CLOSETS AND SHOWER OR BATHTUB IN MAIN BATHROOM. REFER TO OBC, 9.5.2.3, 3.8.3.8.(1)(d) & 3.8.3.13.(1)(f), AND DETAILS PROVIDED

ADDL EXTERIOR STEEL DOOR C/M EXTERIOR LIGHT AND SWITCH

GAS LINE FOR DYER SEE SUMMARY

FP SECTION

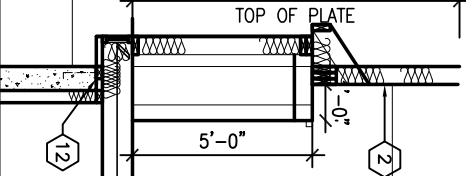

8 REV. AS PER CONST. SUMMARY
7 REV. AS PER CONST. SUMMARY

OCT22-13 SD
OCT8-13 SD

6	REV. AS PER CONST. SUMMARY	SEP20-13	SD
5	REV. AS PER CONST. SUMMARY	SEP17-13	SD
4	ADDED RIGID INS. IN BASEMENT	AUG21-13	SD
3	REV.PER STRUC'L FRAMING REVIEW	JUL18-13	SD
2	FOR TRUSS&JOIST RE-DESIGN	JUNE26-13	SD
1	ISSUED FOR FOUNDATION ONLY	JUNE20-13	SD
No. Description		Date	By
REVISIONS			

SEP20-13	SD
SEP17-13	SD
AUG21-13	SD
JUL18-13	SD
JUNE26-13	SD
JUNE20-13	SD

footprint:	B5-A
sht. title:	GROUND FLOOR PLAN-A
drawn by:	IV
checked by:	
date:	JUNE 2007
scale:	3/16"=1'
sheet no:	2A 6



Viljoen Architect Inc.

300 A Wilson Avenue
North York, Ontario
M3H 1S8
TEL: (416) 630-2255
FAX: (416) 630-4782

B5-A EQUINOX


SITE: WHITE TAIL RIDGE

LOT NUMBER:

97

CIVIC ADDRESS:
31 WHITE TAIL DR

LOFT

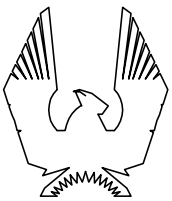

PHOENIX HOMES

Viljoen
Architect
Inc.

300 A Wilson Avenue
North York, Ontario
M3H 1S8
TEL: (416) 630-2255
FAX: (416) 630-4782

B5-A EQUINOX

SITE: WHITE TAIL RIDGE

LOT NUMBER:

97

CIVIC ADDRESS:
31 WHITE TAIL DR

8 REV. AS PER CONST. SUMMARY
7 REV. AS PER CONST. SUMMARY

OCT22-13 SD
OCT8-13 SD

6	REV. AS PER CONST. SUMMARY	SEP20-13	SD
5	REV. AS PER CONST. SUMMARY	SEP17-13	SD
4	ADDED RIGID INS. IN BASEMENT	AUG21-13	SD
3	REV.PER STRUC'L FRAMING REVIEW	JUL18-13	SD
2	FOR TRUSS&JOIST RE-DESIGN	JUNE26-13	SD
1	ISSUED FOR FOUNDATION ONLY	JUNE20-13	SD


No. Description
REVISIONS

Date By


footprint: B5-A
sht. title: LOFT PLAN-A
drawn by: IV
checked by:
date: JUNE 2007
scale: 3/16"=1'

sheet no:

3A
6

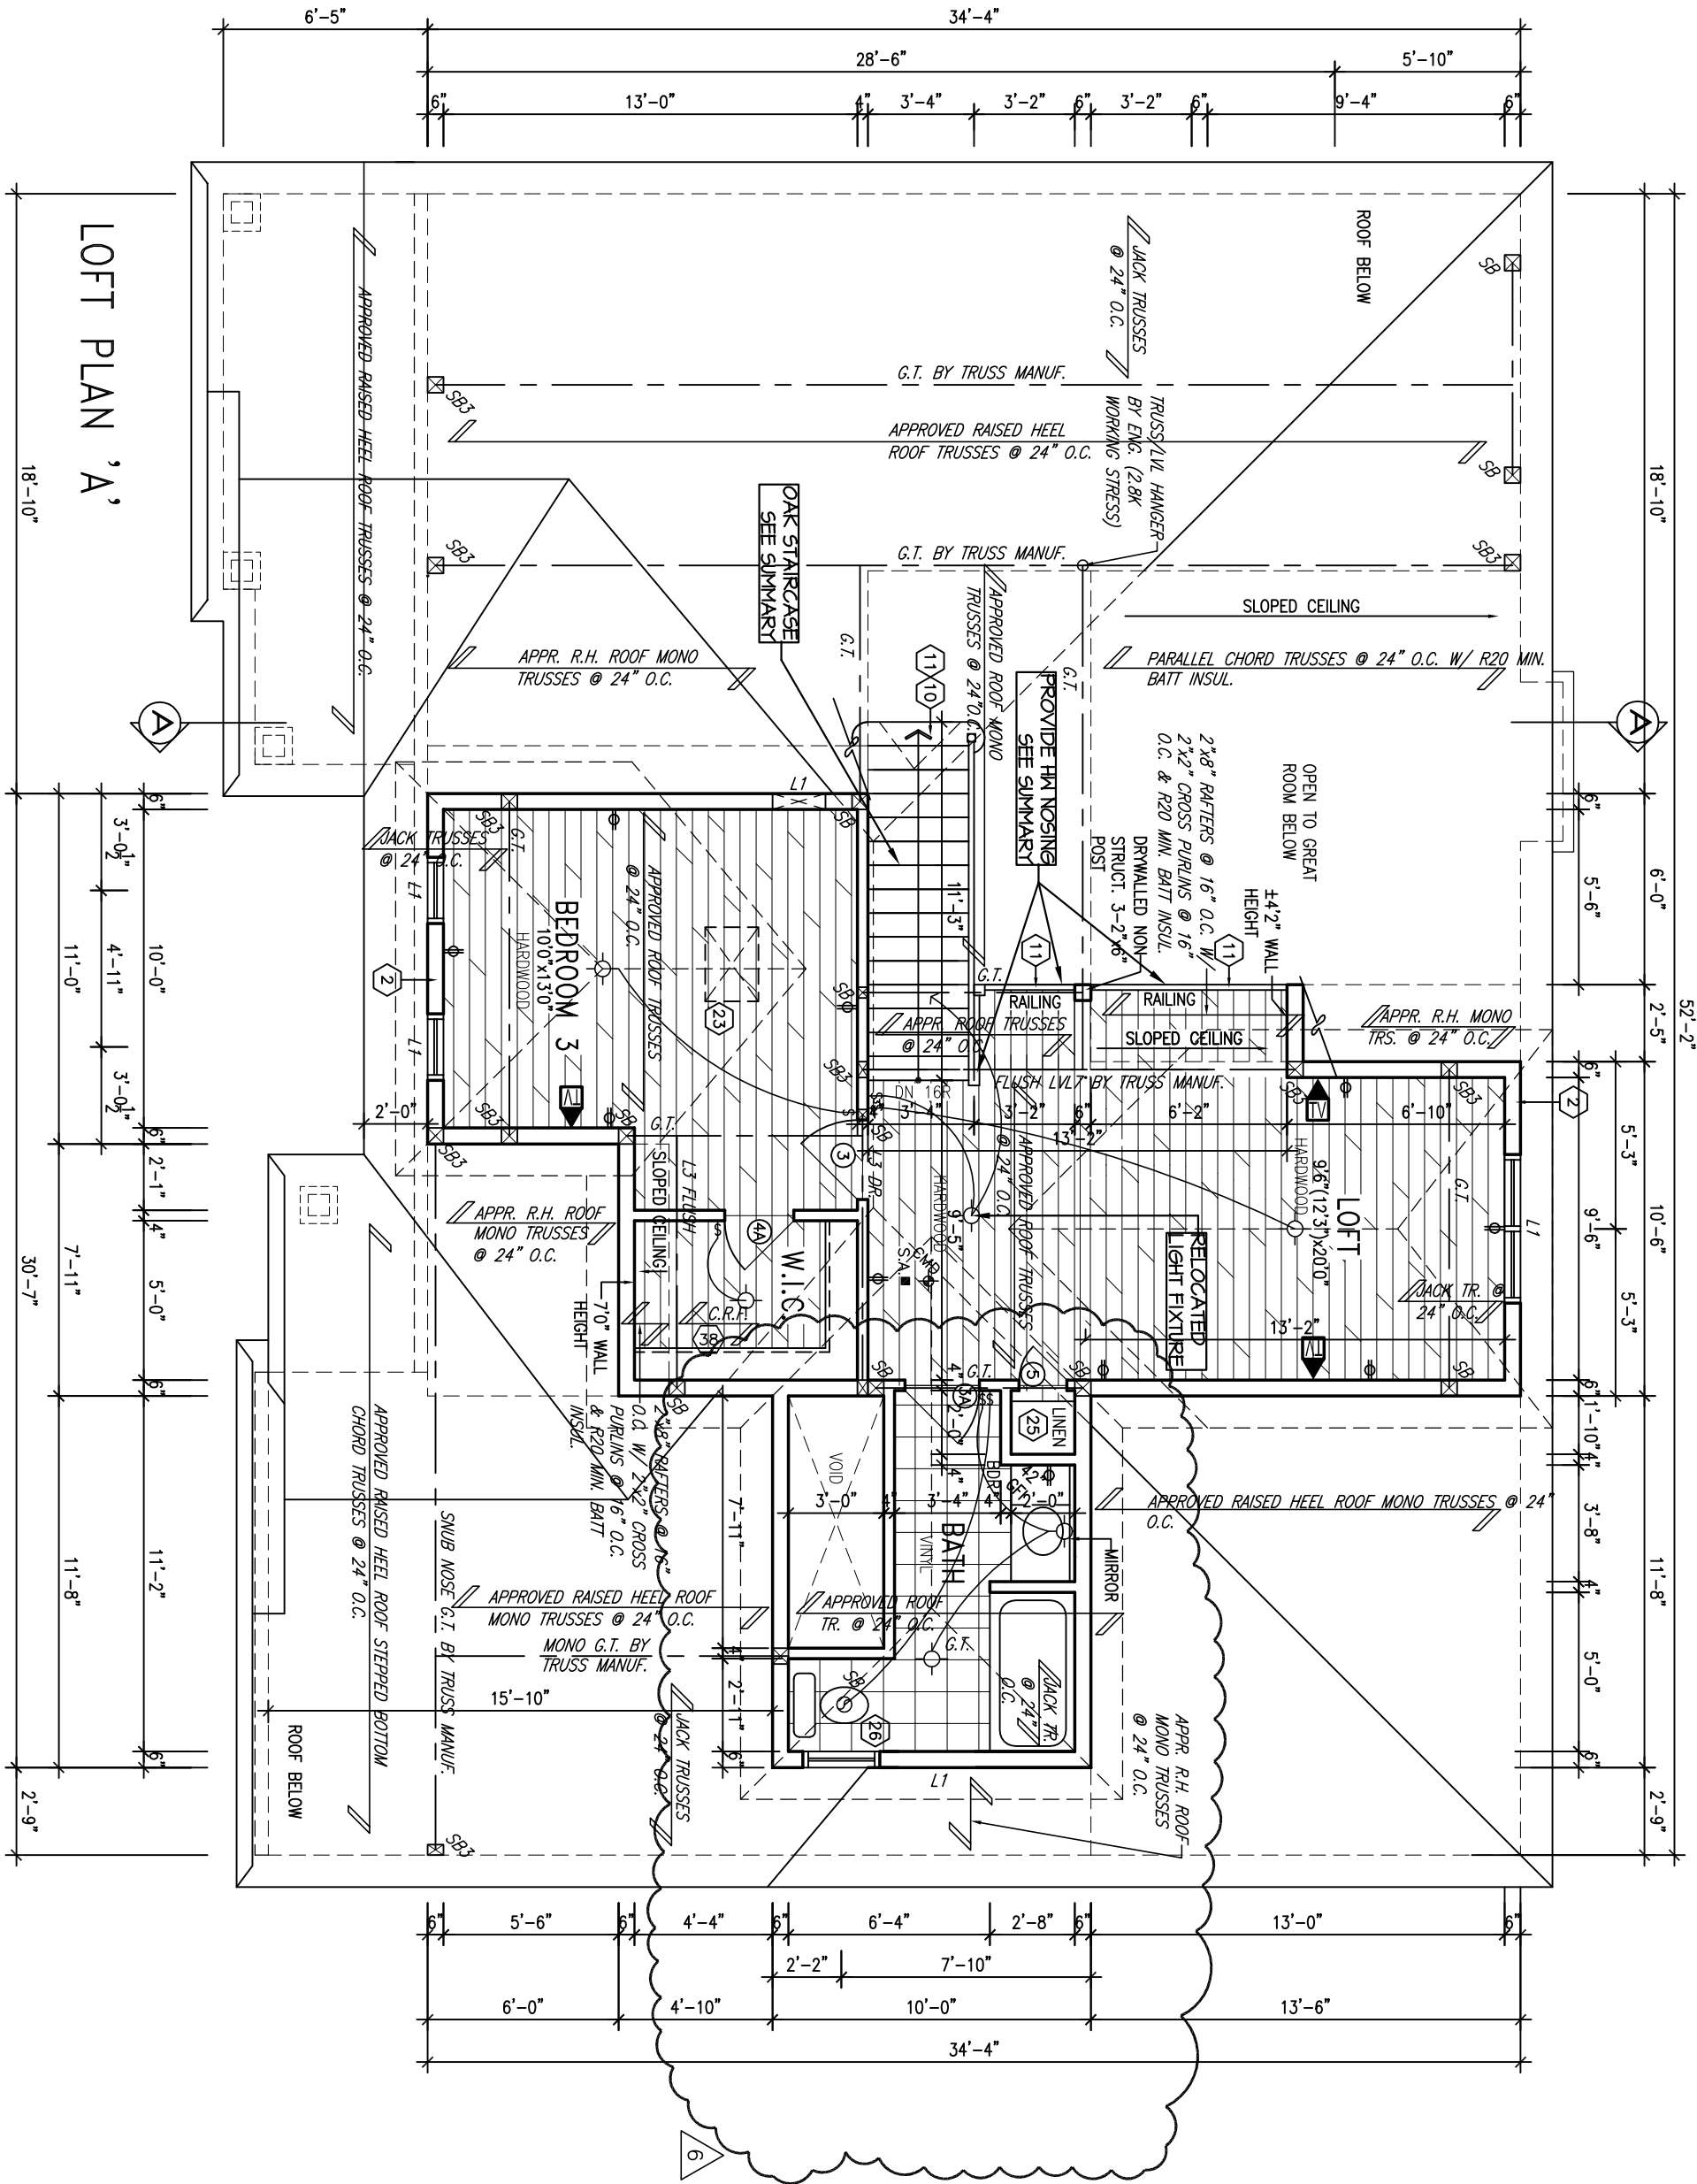


LOFT PLAN 'A'

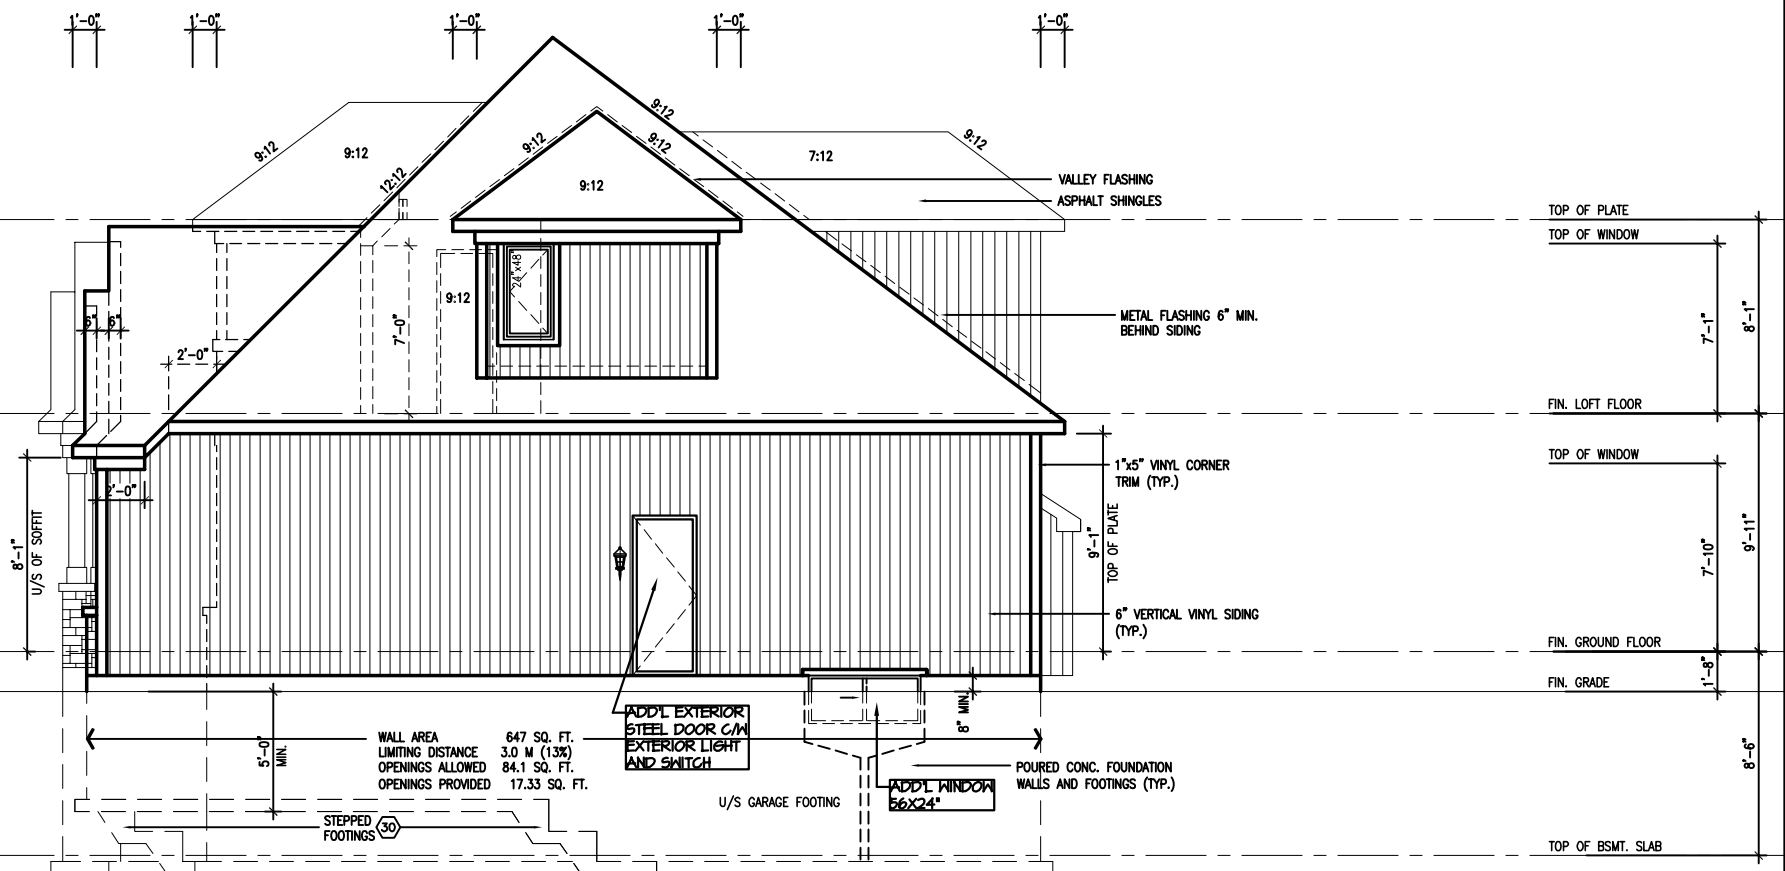

RIGHT SIDE ELEVATION 'A'

NOTE: REFER TO FRONT ELEVATION FOR TYPICAL NOTE INFORMATION

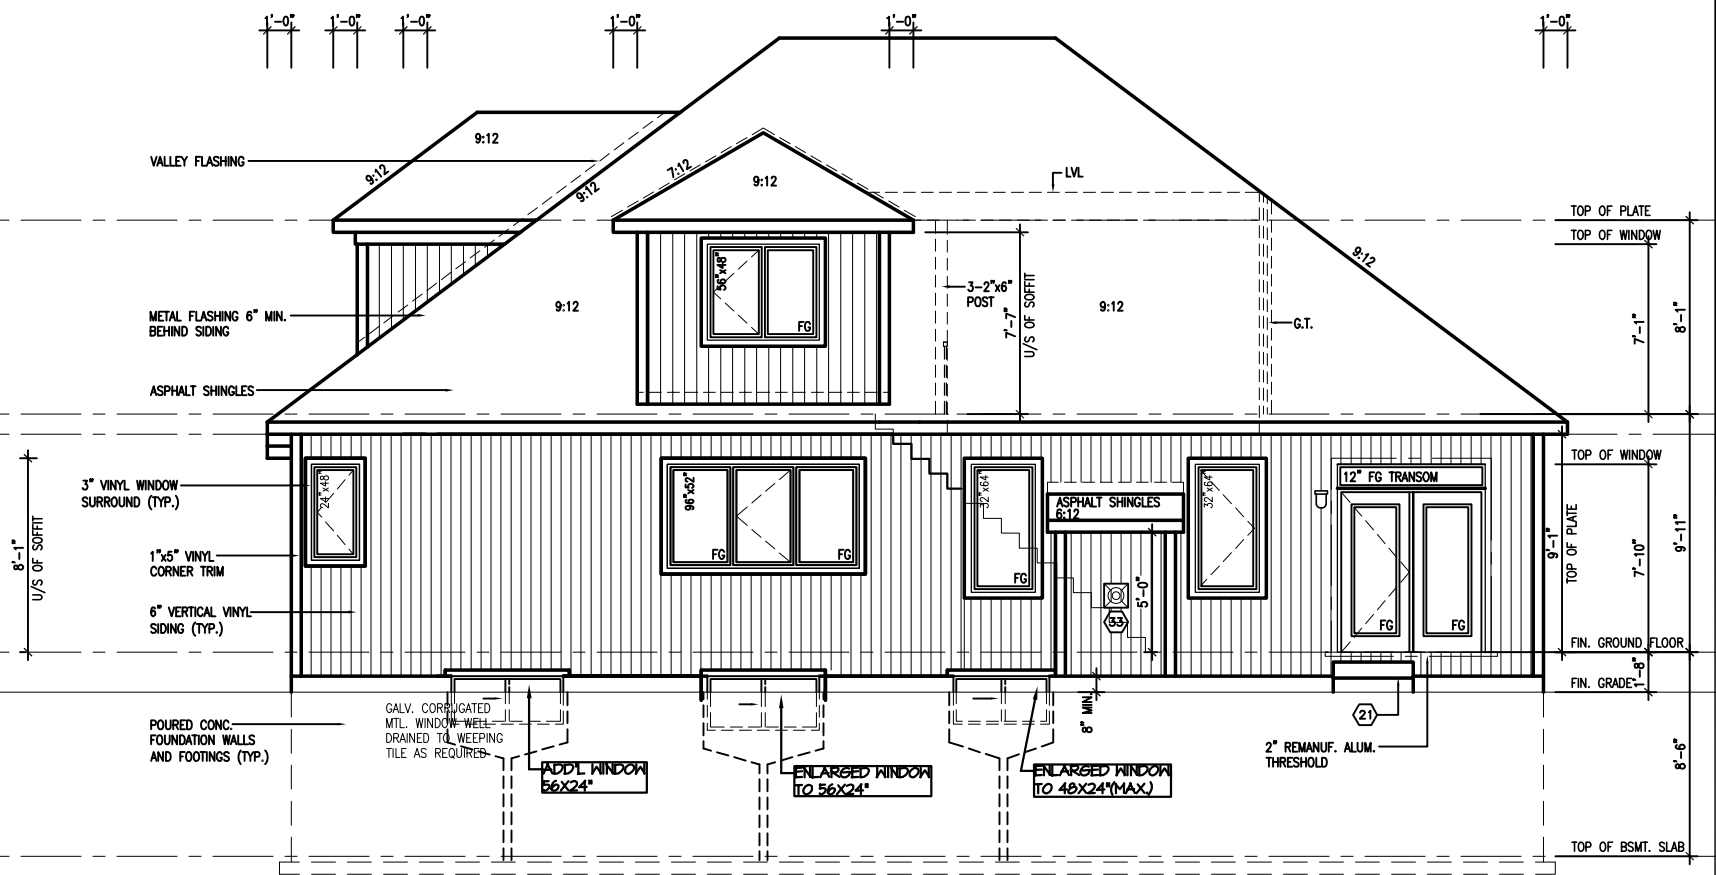

REAR ELEVATION 'A'

NOTE: REFER TO FRONT ELEVATION FOR TYPICAL NOTE INFORMATION

8 REV. AS PER CONST. SUMMARY
7 REV. AS PER CONST. SUMMARY

OCT22-13 SD
OCT8-13 SD

LOFT

B5-A EQUINOX

SITE: WHITE TAIL RIDGE

LOT NUMBER:

97

CIVIC ADDRESS:
31 WHITE TAIL DR


6 REV. AS PER CONST. SUMMARY
5 REV. AS PER CONST. SUMMARY
4 ADDED RIGID INS. IN BASEMENT
3 REV. PER STRUC'L FRAMING REVIEW
2 FOR TRUSS & JOIST RE-DESIGN
1 ISSUED FOR FOUNDATION ONLY

SEP20-13 SD
SEP17-13 SD
AUG21-13 SD
JUL18-13 SD
JUNE26-13 SD
JUNE20-13 SD

Footprint: B-5A
sht. title: ELEVATIONS-A
drawn by: IV
checked by: .
date: JUNE 2007
scale: 1/8"=1'

sheet no:

5A
6

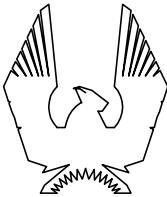


PHOENIX HOMES

Viljoen Architect Inc.

300 A Wilson Avenue
North York, Ontario
M3H 1S8
TEL: (416) 630-2255
FAX: (416) 630-4782

LOFT

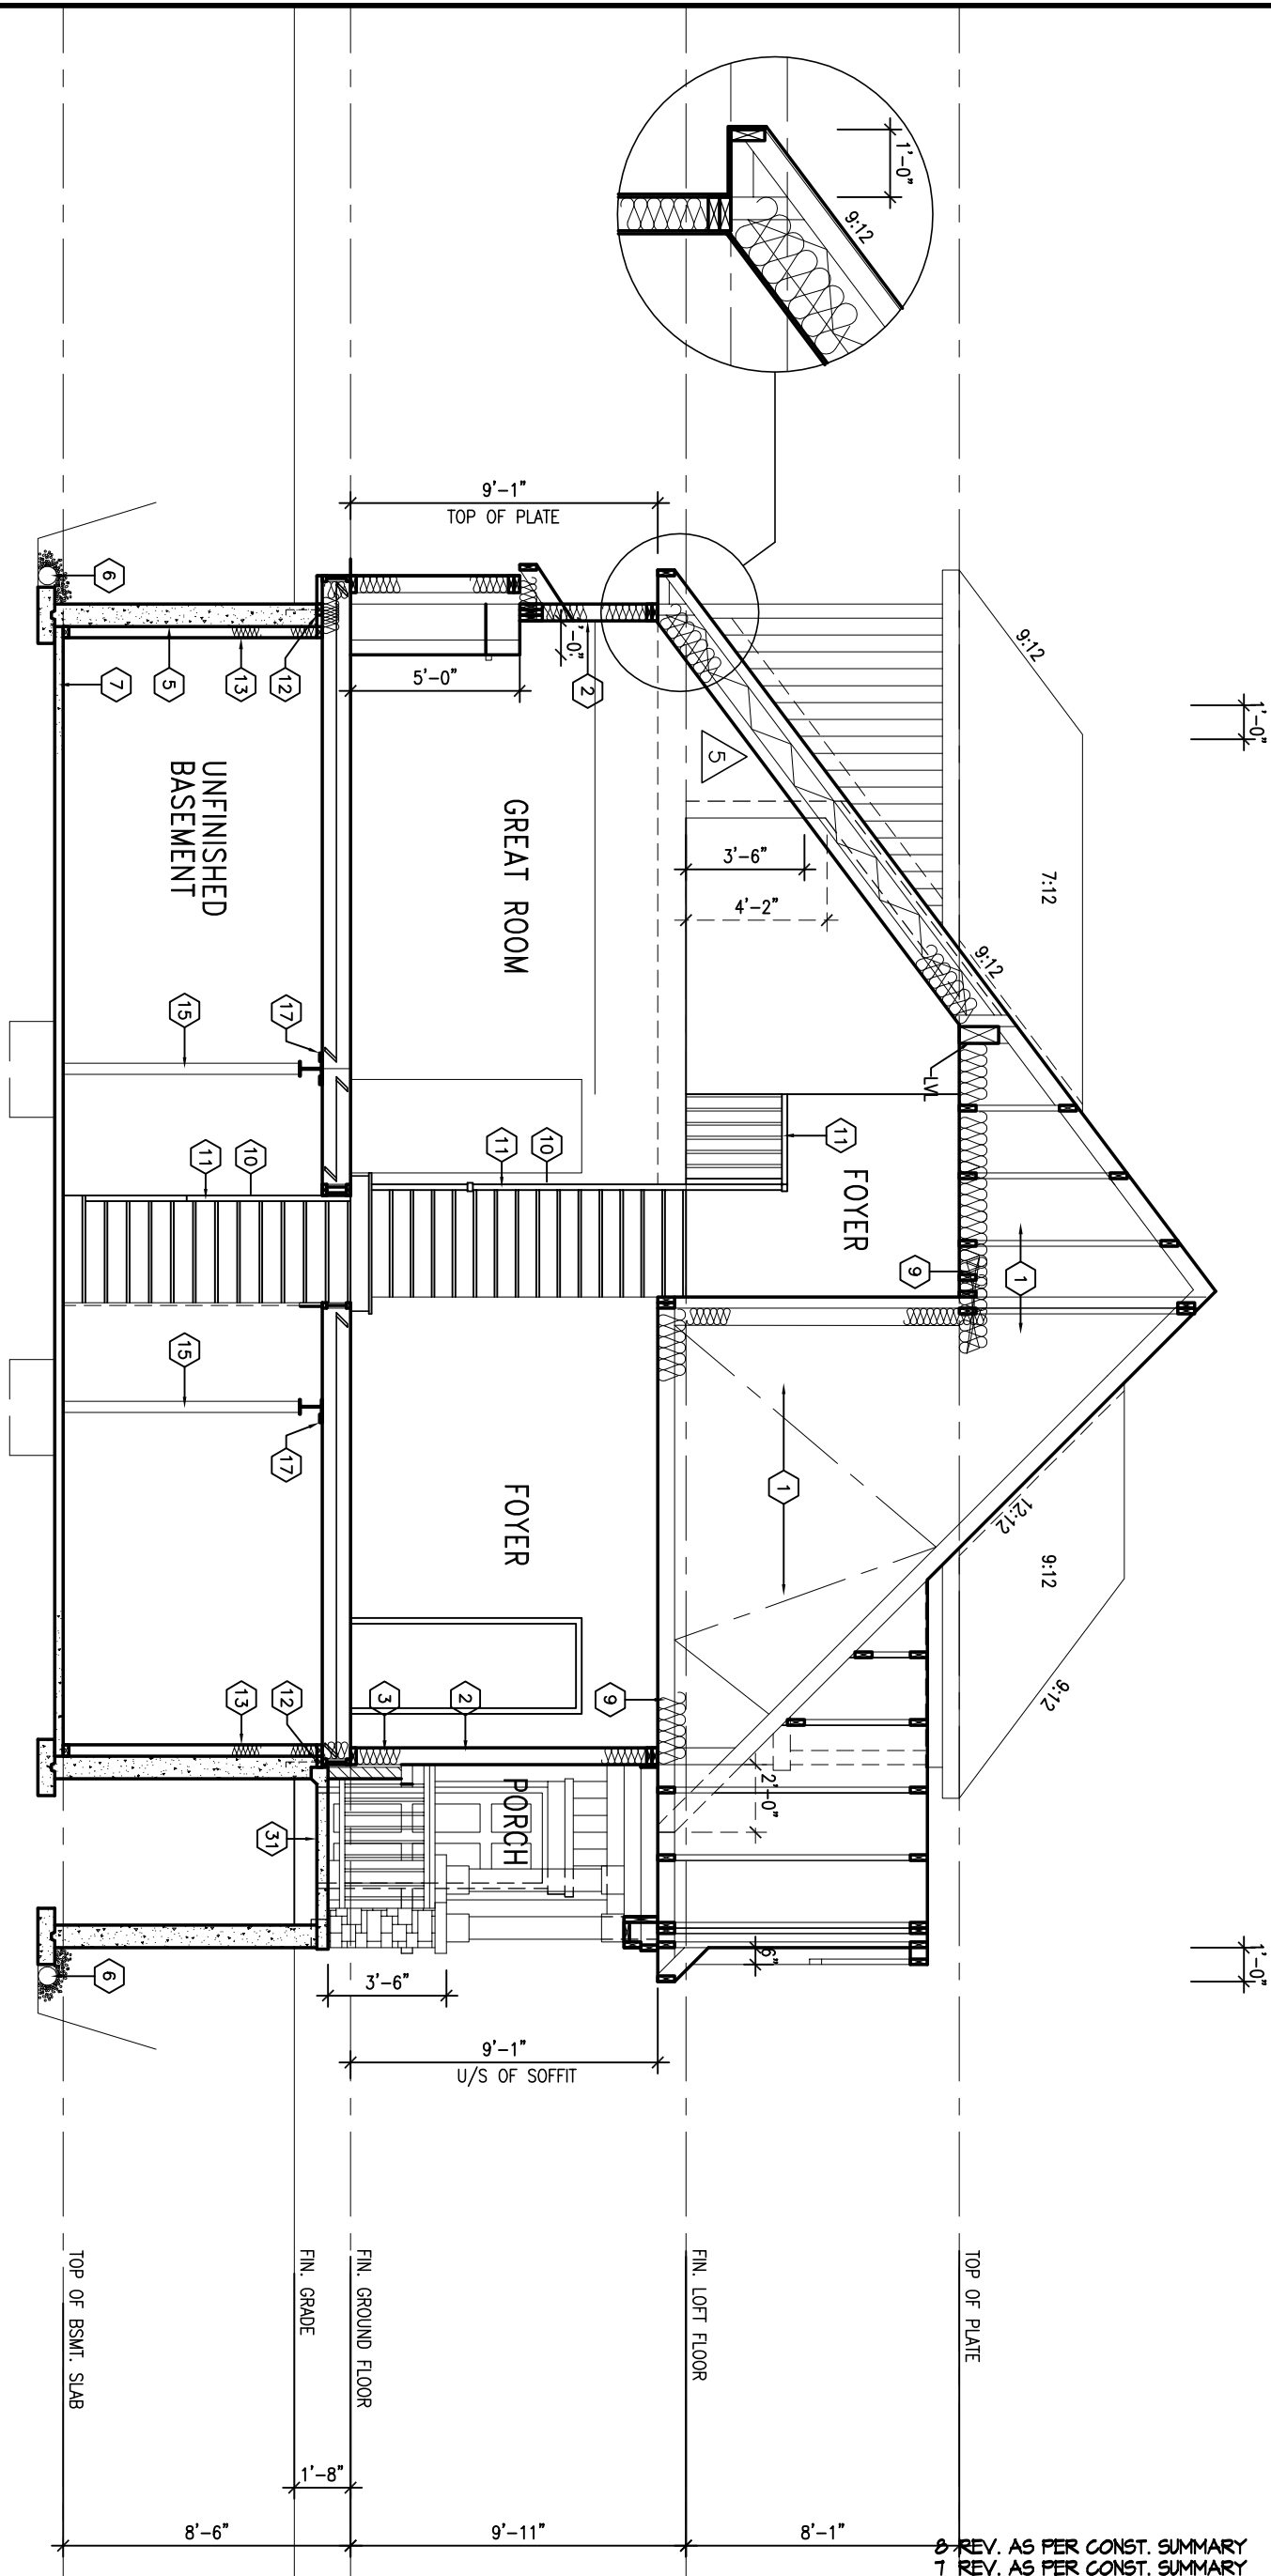

8	REV. AS PER CONST. SUMMARY	OCT22-13	SD
7	REV. AS PER CONST. SUMMARY	OCT8-13	SD

 PHOENIX HOMES	Viljoen Architect Inc. 300 A. Wilson Avenue North York, Ontario M3H 1S8 TEL: (416) 630-2255 FAX: (416) 630-4782	B5-A EQUINOX SITE: WHITE TAIL RIDGE LOT NUMBER: 97 CIVIC ADDRESS: 31 WHITE TAIL DR	<table border="1" style="width: 100%; border-collapse: collapse;"> <tr> <td style="width: 5%;">6</td> <td style="width: 75%;">REV. AS PER CONST. SUMMARY</td> <td style="width: 10%;">SEP20-13</td> <td style="width: 10%;">SD</td> </tr> <tr> <td>5</td> <td>REV. AS PER CONST. SUMMARY</td> <td>SEP17-13</td> <td>SD</td> </tr> <tr> <td>4</td> <td>ADDED RIGID INS. IN BASEMENT</td> <td>AUG21-13</td> <td>SD</td> </tr> <tr> <td>3</td> <td>REV.PER STRUC'L FRAMING REVIEW</td> <td>JUL18-13</td> <td>SD</td> </tr> <tr> <td>2</td> <td>FOR TRUSS&JOIST RE-DESIGN</td> <td>JUNE26-13</td> <td>SD</td> </tr> <tr> <td>1</td> <td>ISSUED FOR FOUNDATION ONLY</td> <td>JUNE20-13</td> <td>SD</td> </tr> <tr> <td colspan="2">No. Description</td> <td>Date</td> <td>By</td> </tr> <tr> <td colspan="2">REVISIONS</td> <td></td> <td></td> </tr> </table>	6	REV. AS PER CONST. SUMMARY	SEP20-13	SD	5	REV. AS PER CONST. SUMMARY	SEP17-13	SD	4	ADDED RIGID INS. IN BASEMENT	AUG21-13	SD	3	REV.PER STRUC'L FRAMING REVIEW	JUL18-13	SD	2	FOR TRUSS&JOIST RE-DESIGN	JUNE26-13	SD	1	ISSUED FOR FOUNDATION ONLY	JUNE20-13	SD	No. Description		Date	By	REVISIONS				footprint: B5-LOFT sht. title: SECTION drawn by: IV checked by: . date: JUNE 2007 scale: 3/16"=1' sheet no: 6 6
6	REV. AS PER CONST. SUMMARY	SEP20-13	SD																																	
5	REV. AS PER CONST. SUMMARY	SEP17-13	SD																																	
4	ADDED RIGID INS. IN BASEMENT	AUG21-13	SD																																	
3	REV.PER STRUC'L FRAMING REVIEW	JUL18-13	SD																																	
2	FOR TRUSS&JOIST RE-DESIGN	JUNE26-13	SD																																	
1	ISSUED FOR FOUNDATION ONLY	JUNE20-13	SD																																	
No. Description		Date	By																																	
REVISIONS																																				