

DCR PHOENIX HOMES

LOT #42

DIAMONDVIEW ESTATES

MODEL - RUTHERFORD (517)

ALTERNATE KITCHEN

MOUNTING HEIGHT - 96

42"H UPPERS INSTALLED @
18" ABOVE COUNTER

~~CROWN MOULDING~~

CABINETS-

HARDWARE -

STANDARD WHITE INTERIOR


STANDARD METAL DRAWER BOX

4 PCS - 5/8" KICK - FIN. BOTH ENDS

1 PCS - 90 DEG. CORNER MOULD

1 PCS - T-MOULD

5 PCS - FLAT MOULD

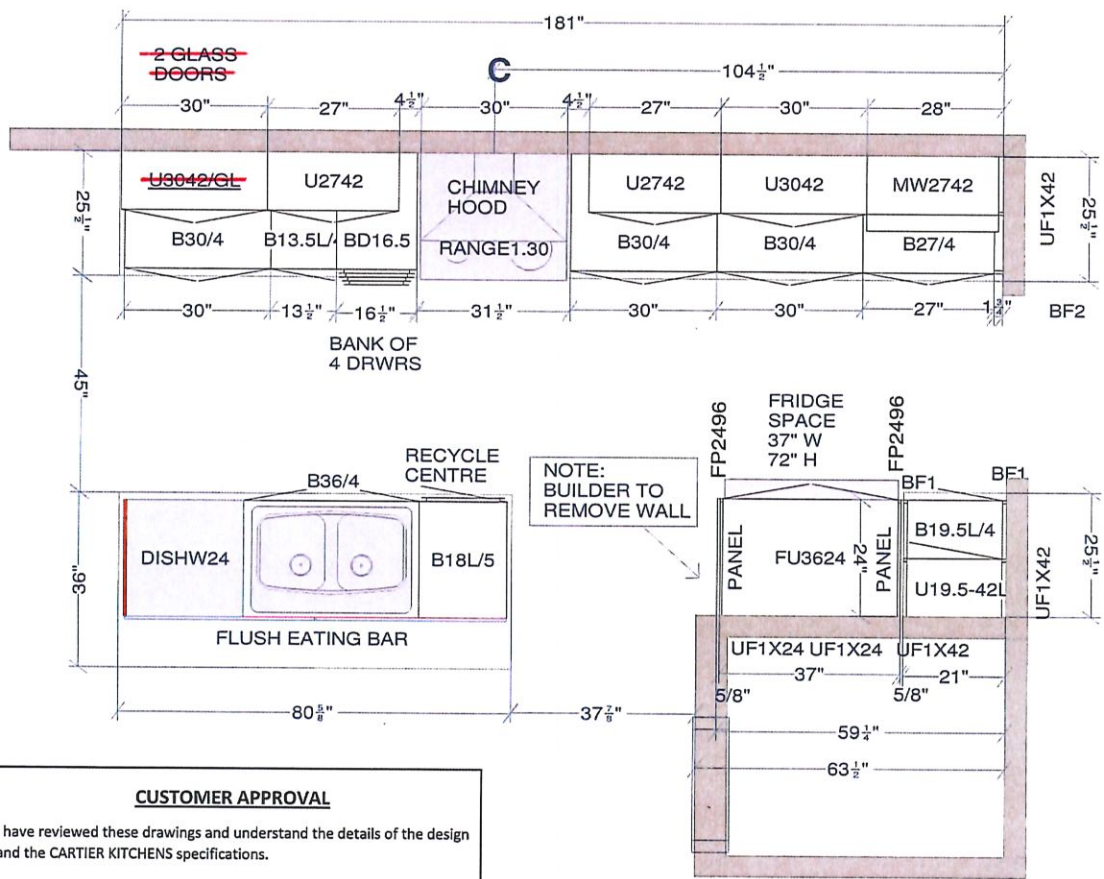

CUSTOMER APPROVAL

I have reviewed these drawings and understand the details of the design and the CARTIER KITCHENS specifications.

Signature _____

Date _____

All dimensions ,size designations
given are subject to verification on
job site and adjustment to fit job
conditions.

SPECTRUM KITCHEN and BATH
DESIGN



This is an original design and must
not be released or copied unless
applicable fee has been paid or job
order placed.

DRAWN BY: LORI DISAVERIO, B.I.D

Designed: 2020-01-21
Printed: 2020-01-21



KS HK

DCR #42 diamondview - Rutherford ALT Kitchen.kit


All

Drawing #: 1

No Scale.

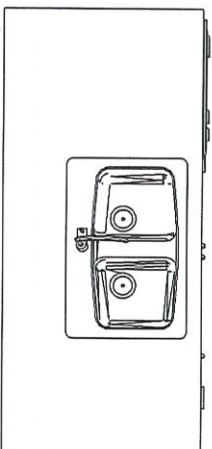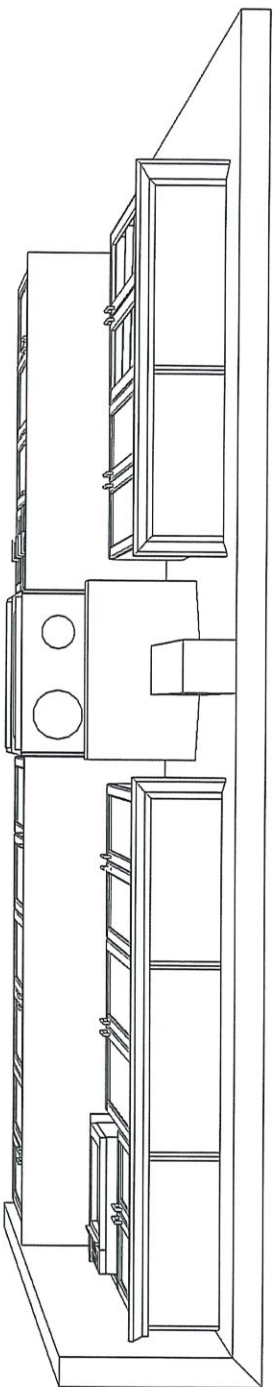

KITCHEN - TOP VIEW

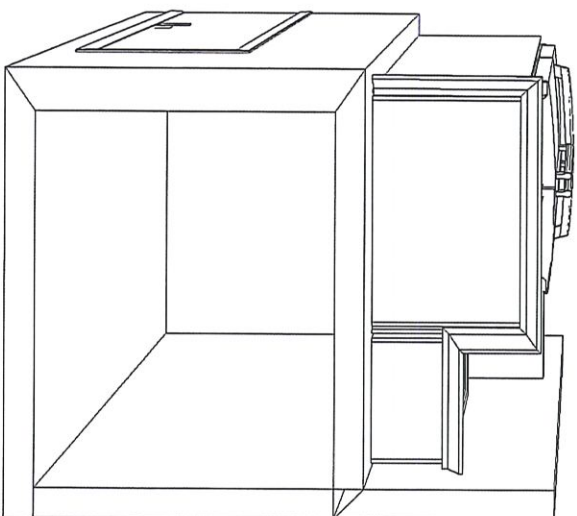

CUSTOMER APPROVAL

I have reviewed these drawings and understand the details of the design and the CARTIER KITCHENS specifications.

Signature

[Signature]

Date

07-12-2020

Note: This drawing is an artistic interpretation of the general appearance of the design. It is not meant to be an exact rendition.



Designed: 2020-01-21
Printed: 2020-01-21


SPECTRUM KITCHEN and BATH
DESIGN

DCR #42 diamondview - Rutherford ALT Kitchen.kit

All

Drawing #: 1



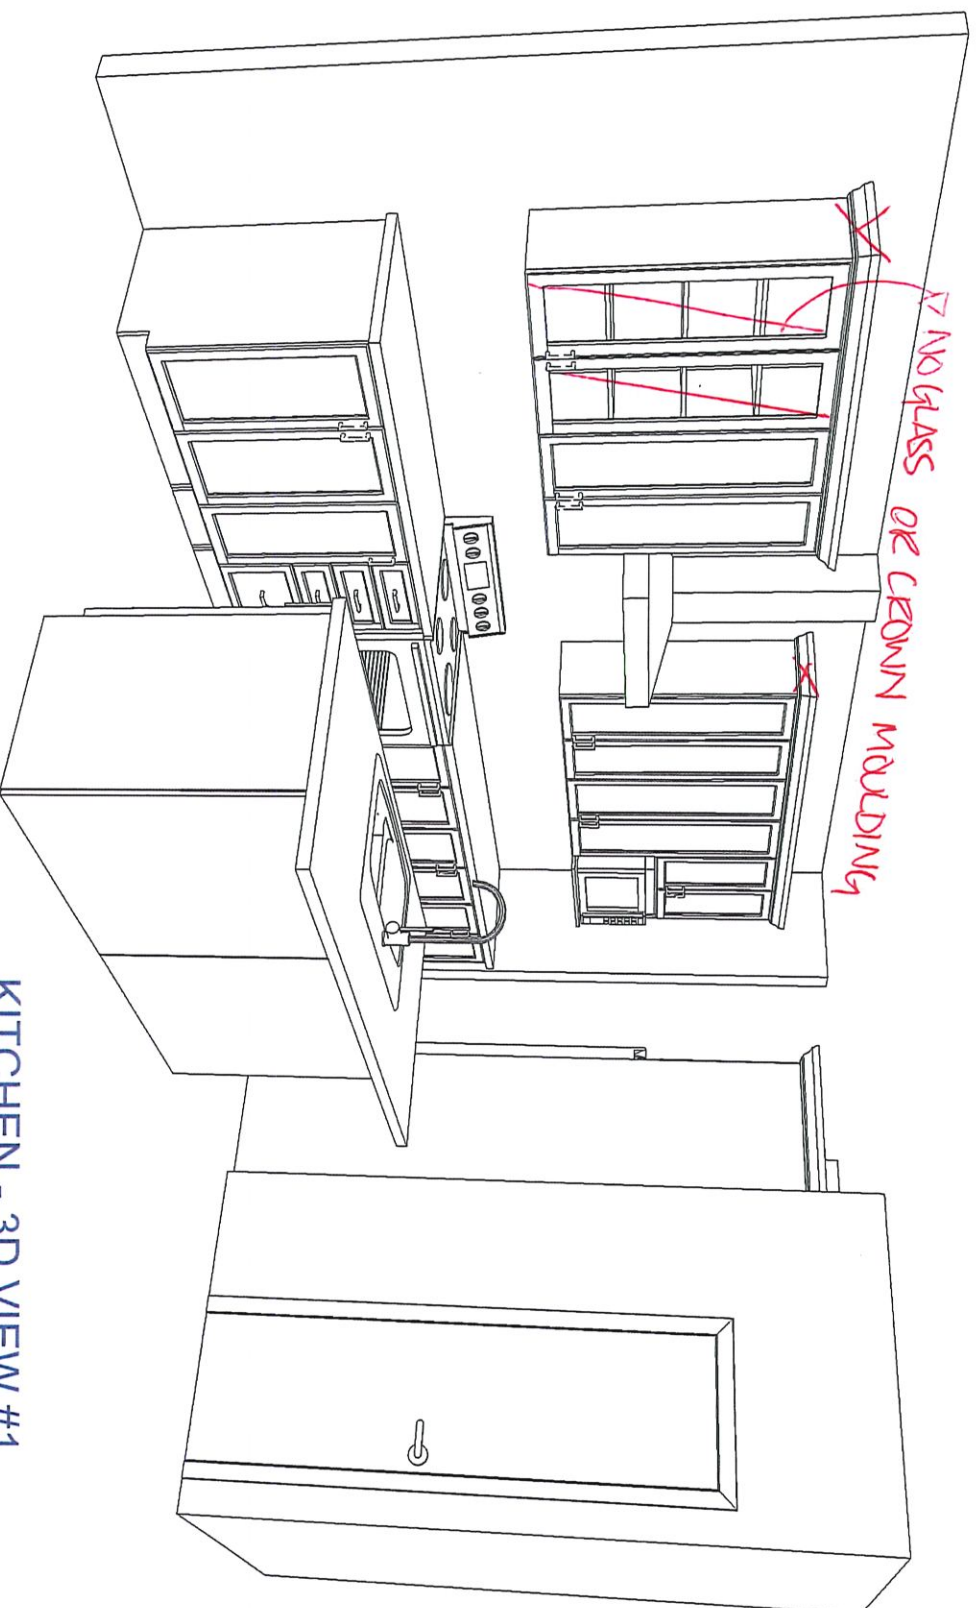

KITCHEN - 3D VIEW #1

CUSTOMER APPROVAL

I have reviewed these drawings and understand the details of the design and the CARTIER KITCHENS specifications.

Signature

[Signature]

Date

07-12-2020

Note: This drawing is an artistic interpretation of the general appearance of the design. It is not meant to be an exact rendition.

SPECTRUM KITCHEN and BATH DESIGN



Designed: 2020-01-21
Printed: 2020-01-21


KS

HK

DCR #42 diamondview - Rutherford ALT Kitchen.kit

All

Drawing #: 1

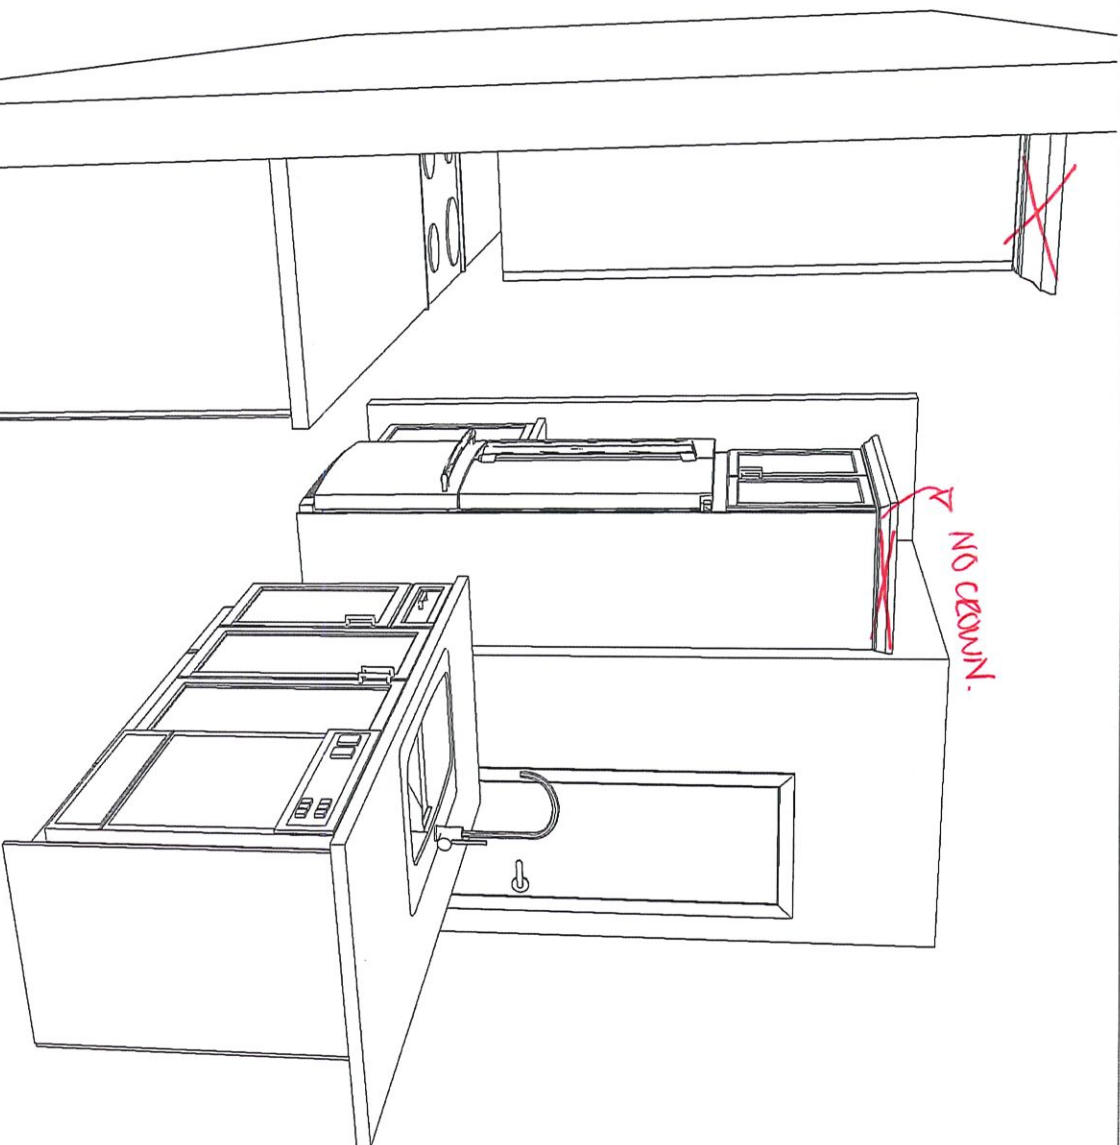

KITCHEN - 3D VIEW #1

CUSTOMER APPROVAL

I have reviewed these drawings and understand the details of the design and the CARTIER KITCHENS specifications.

Signature

[Signature]

[Signature]

Date

07-12-2020

Note: This drawing is an artistic interpretation of the general appearance of the design. It is not meant to be an exact rendition.

SPECTRUM KITCHEN and BATH

DESIGN



Designed: 2020-01-21
Printed: 2020-01-21


KS

HK

DCR #42 diamondview - Rutherford ALT Kitchen.kit

All

Drawing #: 1

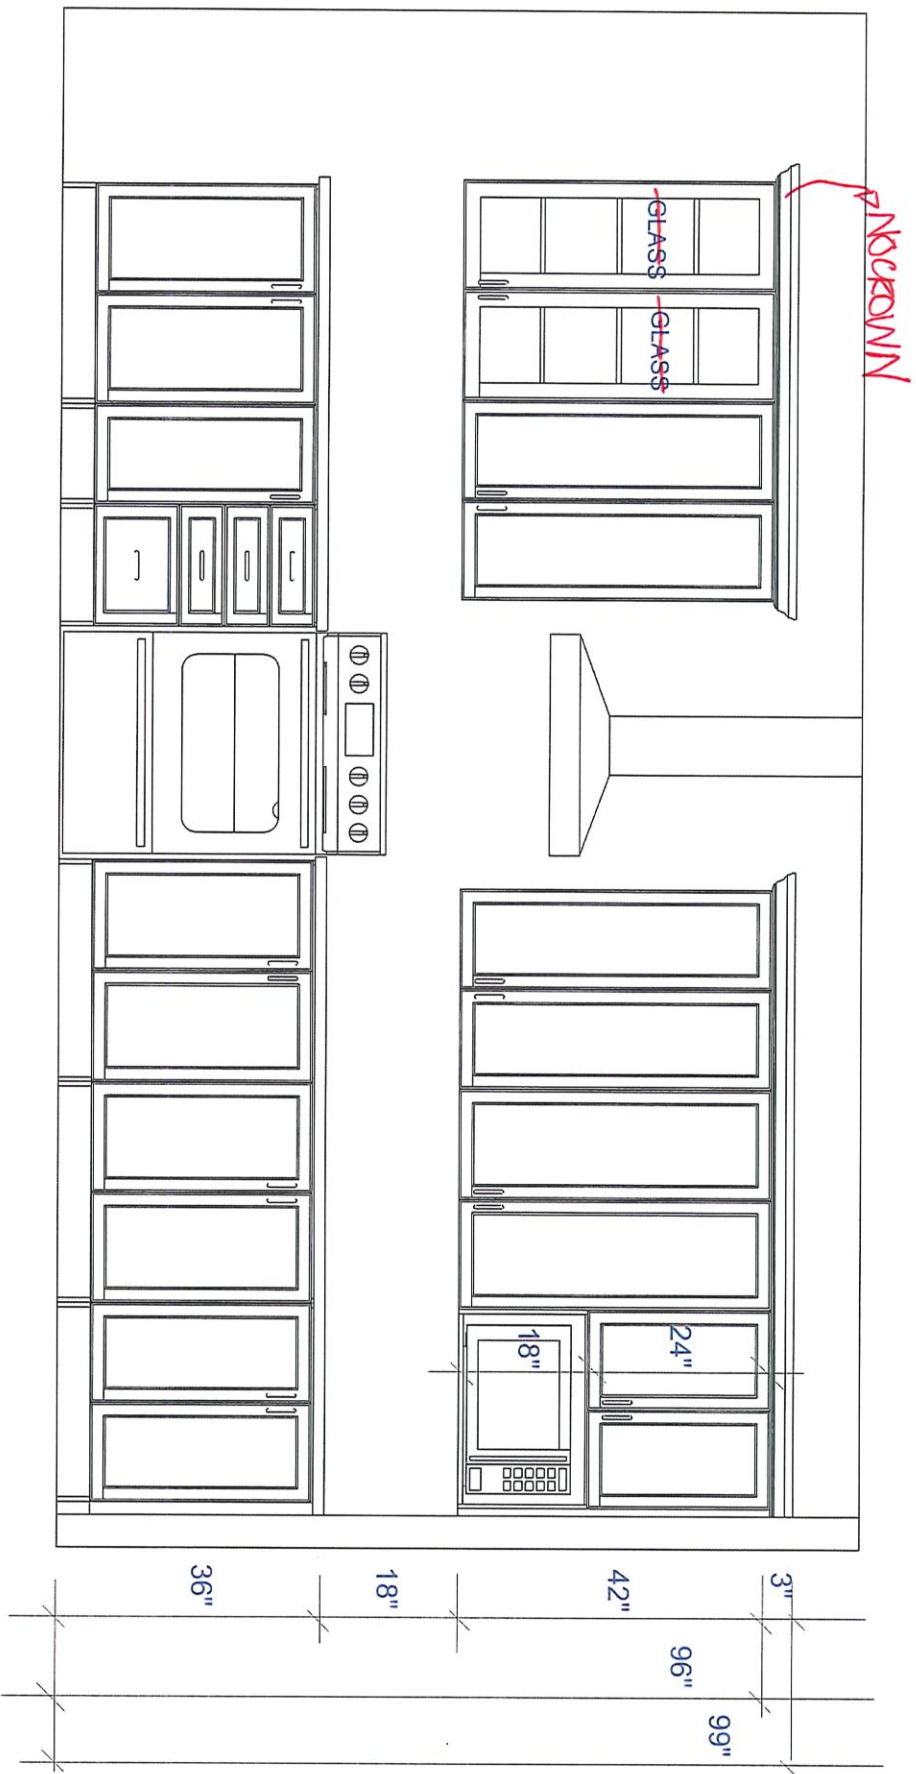

RANGE WALL ELEVATION

CUSTOMER APPROVAL

I have reviewed these drawings and understand the details of the design and the CARTIER KITCHENS specifications.

Signature

[Signature]

[Signature]

Date 07-12-2020

Note: This drawing is an artistic interpretation of the general appearance of the design. It is not meant to be an exact rendition.



Designed: 2020-01-21
Printed: 2020-01-21


KS HK

SPECTRUM KITCHEN and BATH
DESIGN

DCR #42 diamondview - Rutherford ALT Kitchen.kit

All

Drawing #: 1

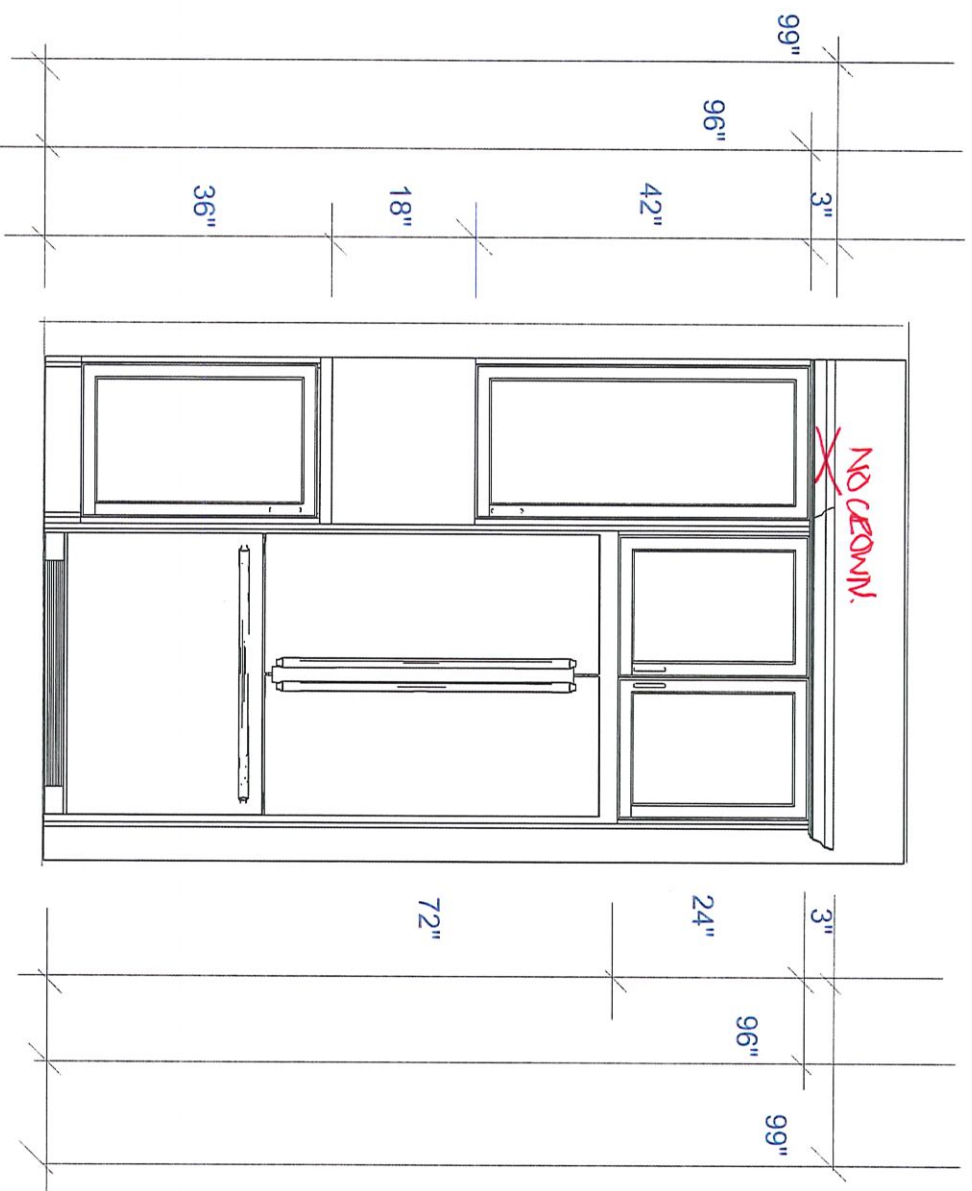

FRIDGE WALL ELEVATION

CUSTOMER APPROVAL

I have reviewed these drawings and understand the details of the design and the CARTIER KITCHENS specifications,

Signature

[Signature]

07-12-2020

Date

Note: This drawing is an artistic interpretation of the general appearance of the design. It is not meant to be an exact rendition.



Designed: 2020-01-21
Printed: 2020-01-21

SPECTRUM KITCHEN and BATH

DESIGN

DCR #42 diamondview - Rutherford ALT Kitchen.kit

All

KS

HK

Drawing #: 1