

PN BLK8 LOT 100

DCR PHOENIX HOMES

TOWNHOUSE 20-14 - COLBY

KITCHEN / VANITIES

MOUNTING HEIGHT: 84

LINE 1

HARDWARE - STD & 1st UPGRADE

STANDARD WHITE INTERIOR

METAL DRAWER BOX



6 PCS - 5/8" KICK - FIN. BOTH ENDS

8 PCS - LOOSE FILLER - 3 x 96


2 PCS - 90 DEG. CORNER MOULD

1 PCS - T-MOULD


6 PCS - FLAT MOULDING

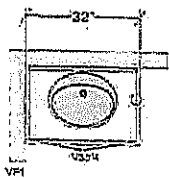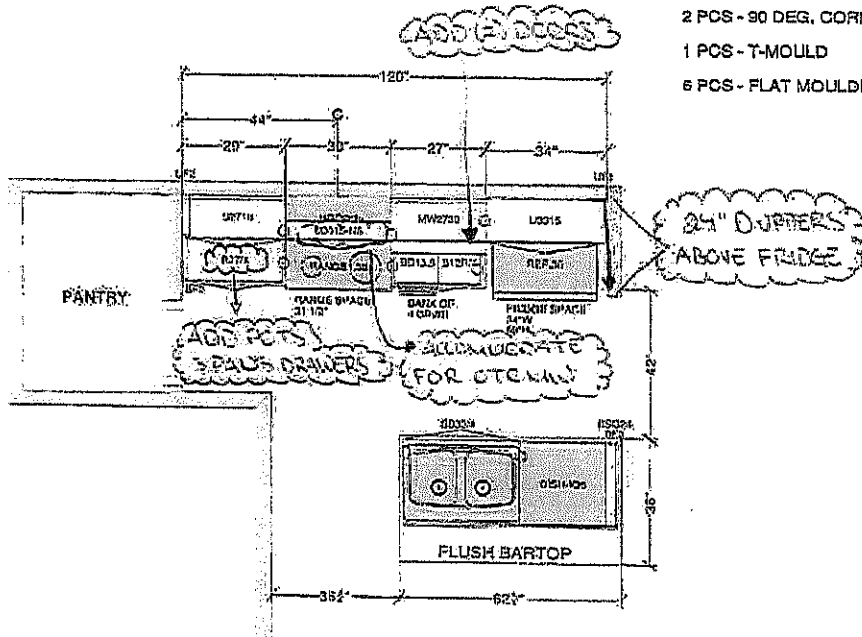

POWDER

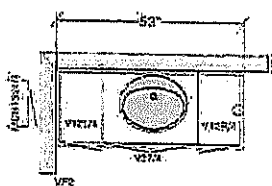


MAIN

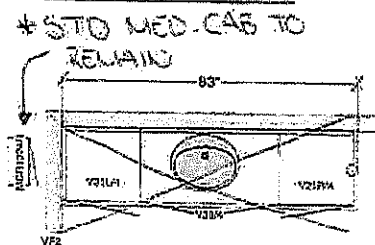

ENSUITE

→ACCOMMODATE FOR (2) SINKS

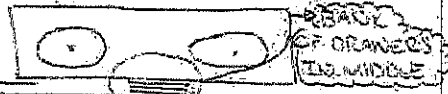

All dimensions size designations given are subject to verification on job site and adjustment to fit job conditions.

**SPECTRUM KITCHEN and BATH
DESIGN**

TH 20 - 14 - Colby - RIT 2500000

This is an original design and must not be released or copied unless applicable fee has been paid or job order placed.

DRAWN BY: LORI DISAVERIO, B.I.D.

Designed: 2018-02-28
Printed: 2018-03-01

Drawing #: 1 No Scale.

