


****NOTE****
ALL WINDOW LINTELS TO BE 2-2X10
W/ P2 POSTS ON EACH SIDE U.N.O.

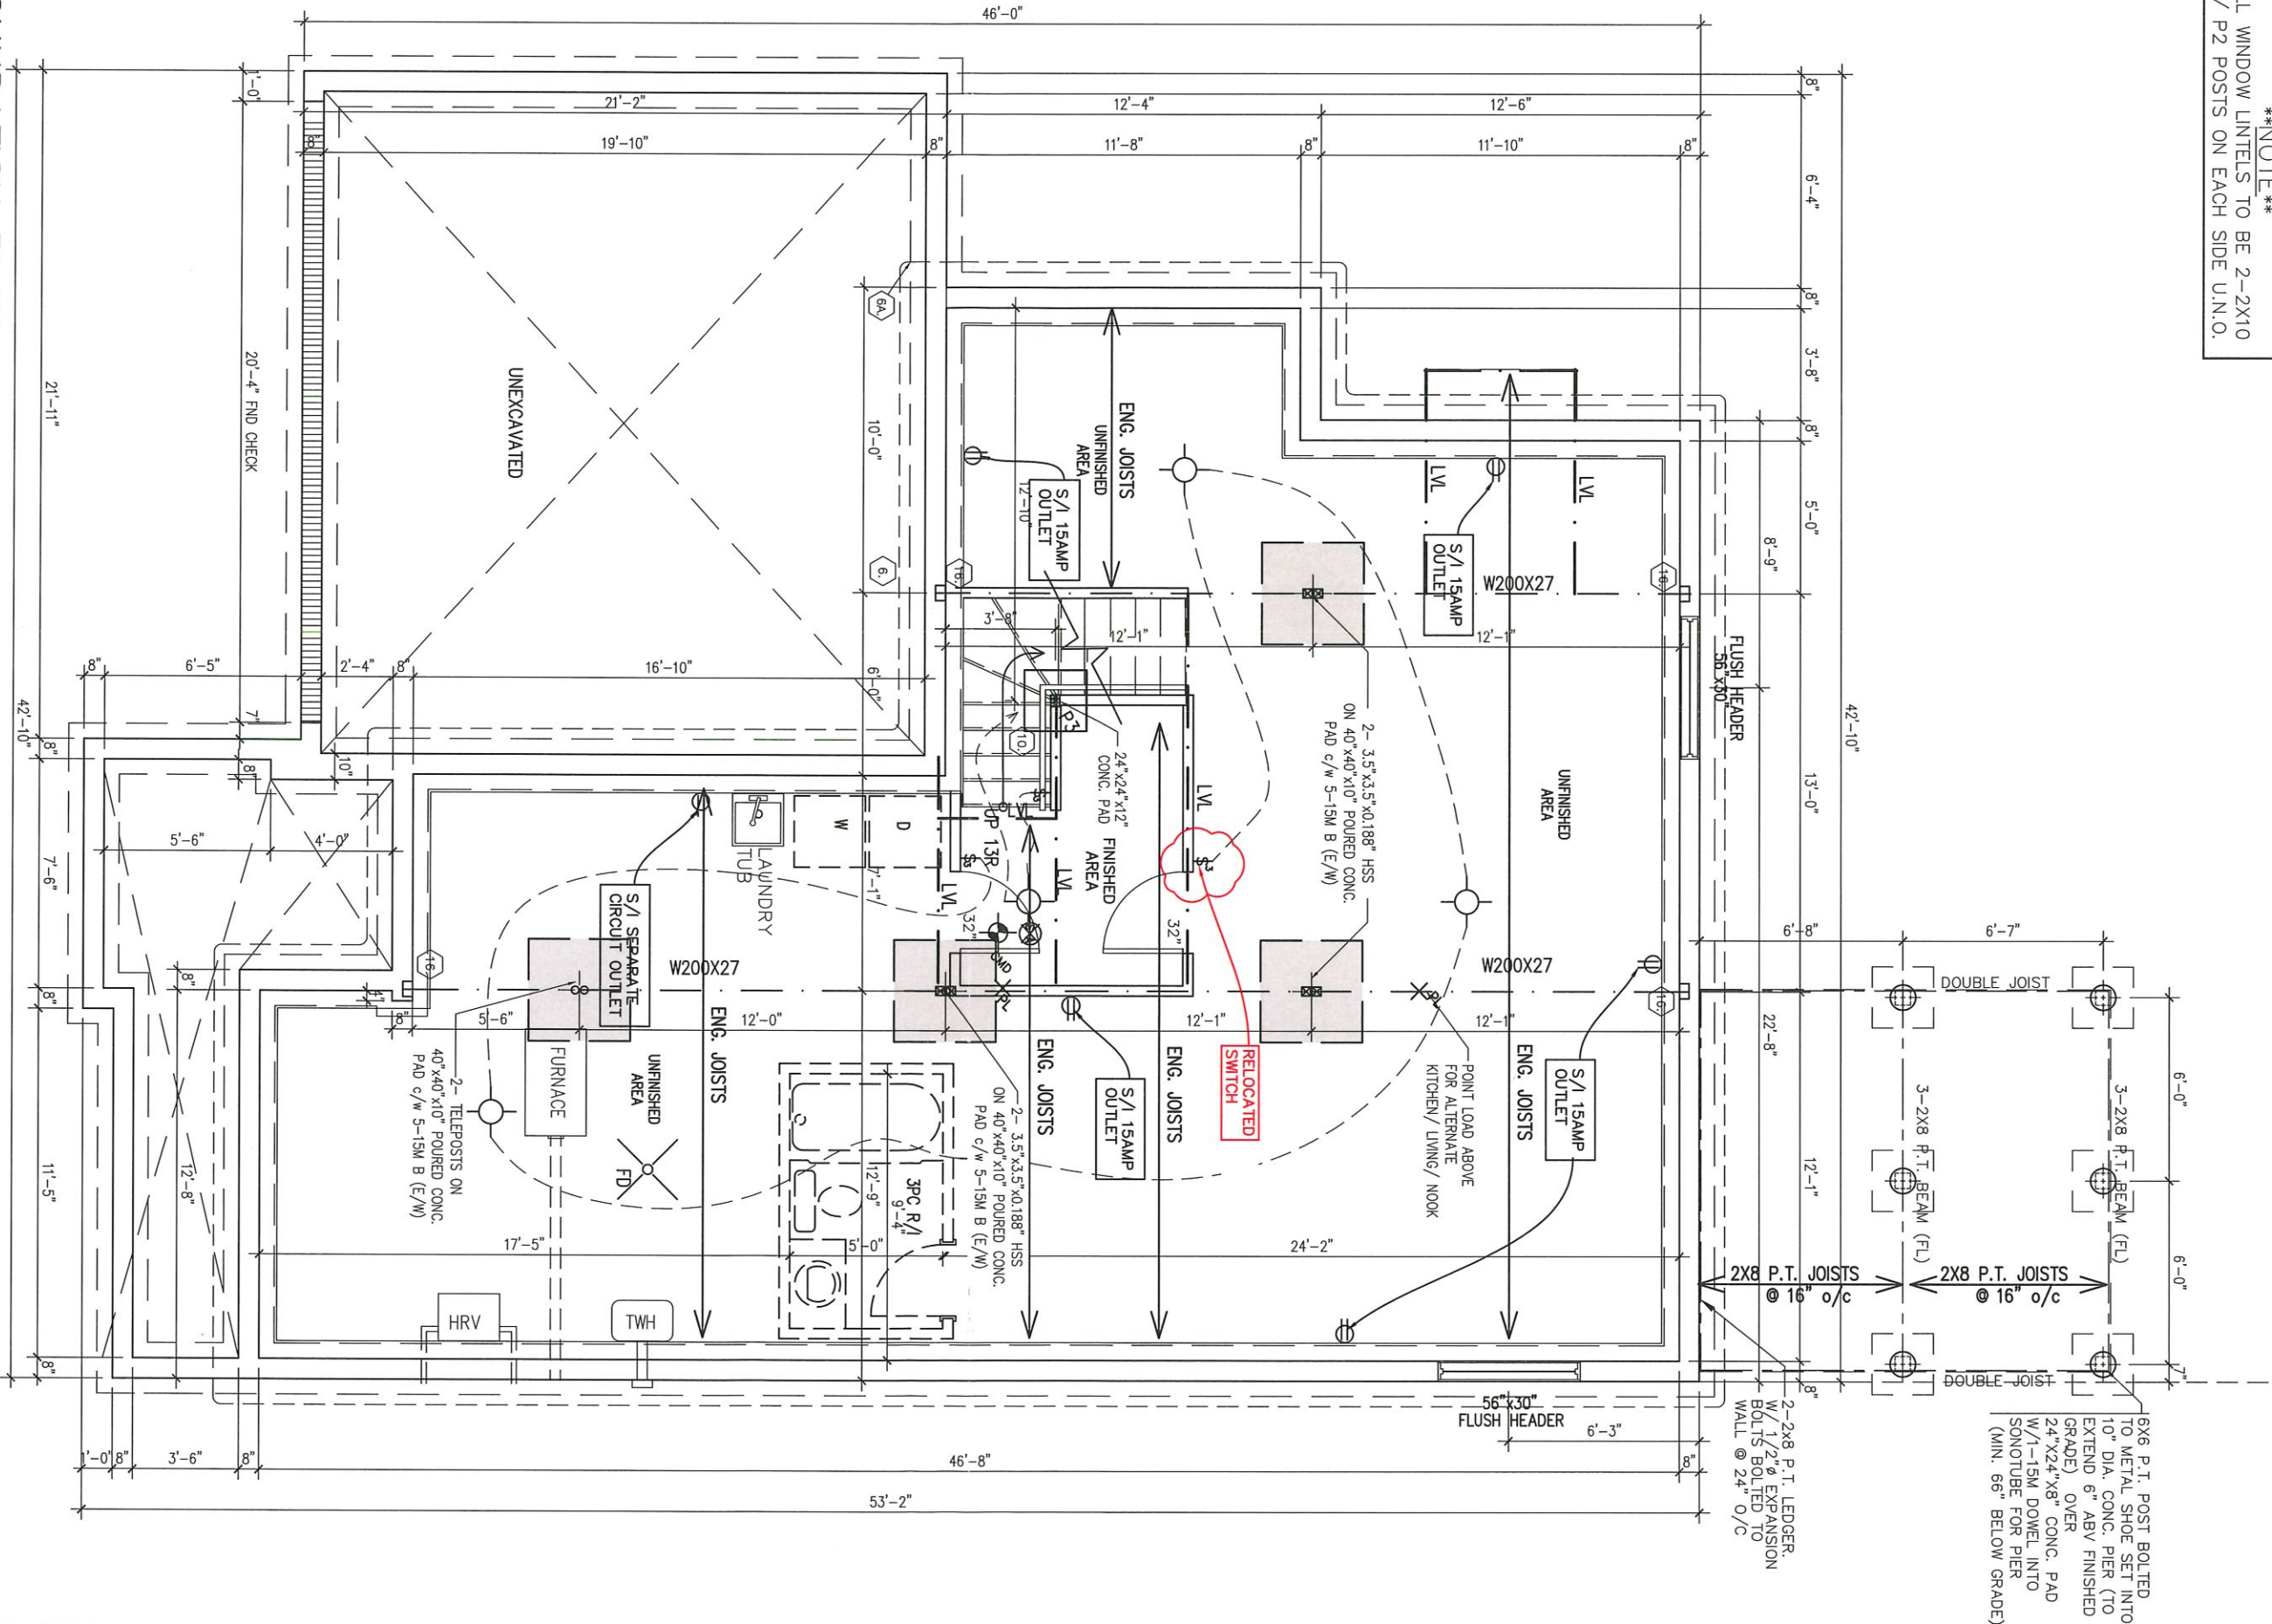

**FOUNDATION PLAN
ELEVATION D**

517-RUTHERFORD-2015

SITE: DIAMONDVIEW

LOT NUMBER:

CIVIC ADDRESS:
73 WINGOVER PVT

PHOENIX HOMES

23

11	REVISED LAUNDRY & BASEMENT ELECTRICAL	08/02/21	CB
10	CORRECTION TO FAMILY ROOM WINDOWS	18/01/21	SP
9	FOR STRUCTURAL REVIEW OF DECK	04/12/20	SP
8	FINAL BLACKLINES	20/11/20	SP
7	BEP FOR SITE	07/10/20	SP
6	ISSUED FOR LAYOUTS	09/09/20	SP
No. REVISIONS	Description	dd/mm/yy	By

footprint: 517

designed by: TL

dwn by: SP

date: NOV/15

scale: 3/16"=1'-0"


D.C.L.-175

sheet title: A1d


2 of 9

CONTRACTOR MUST VERIFY ALL DIMENSIONS ON THE JOB AND REPORT ANY DISCREPANCY TO DCR/PHOENIX BEFORE PROCEEDING WITH THE WORK.
ALL DRAWINGS AND SPECIFICATIONS ARE INSTRUMENTS OF SERVICE AND THE PROPERTY OF THE DCR/PHOENIX WHICH MUST BE RETURNED AT THE COMPLETION OF THE WORK. ALL DRAWINGS TO BE USED FOR CONSTRUCTION ONLY. AFTER BUILDING PERMIT HAS BEEN ISSUED.
DO NOT SCALE DRAWINGS. USE DIMENSIONS PROVIDED.

****NOTE****
ALL WINDOW LINTELS TO BE 2-2X10 W/ P2 POSTS ON EACH SIDE U.N.O.

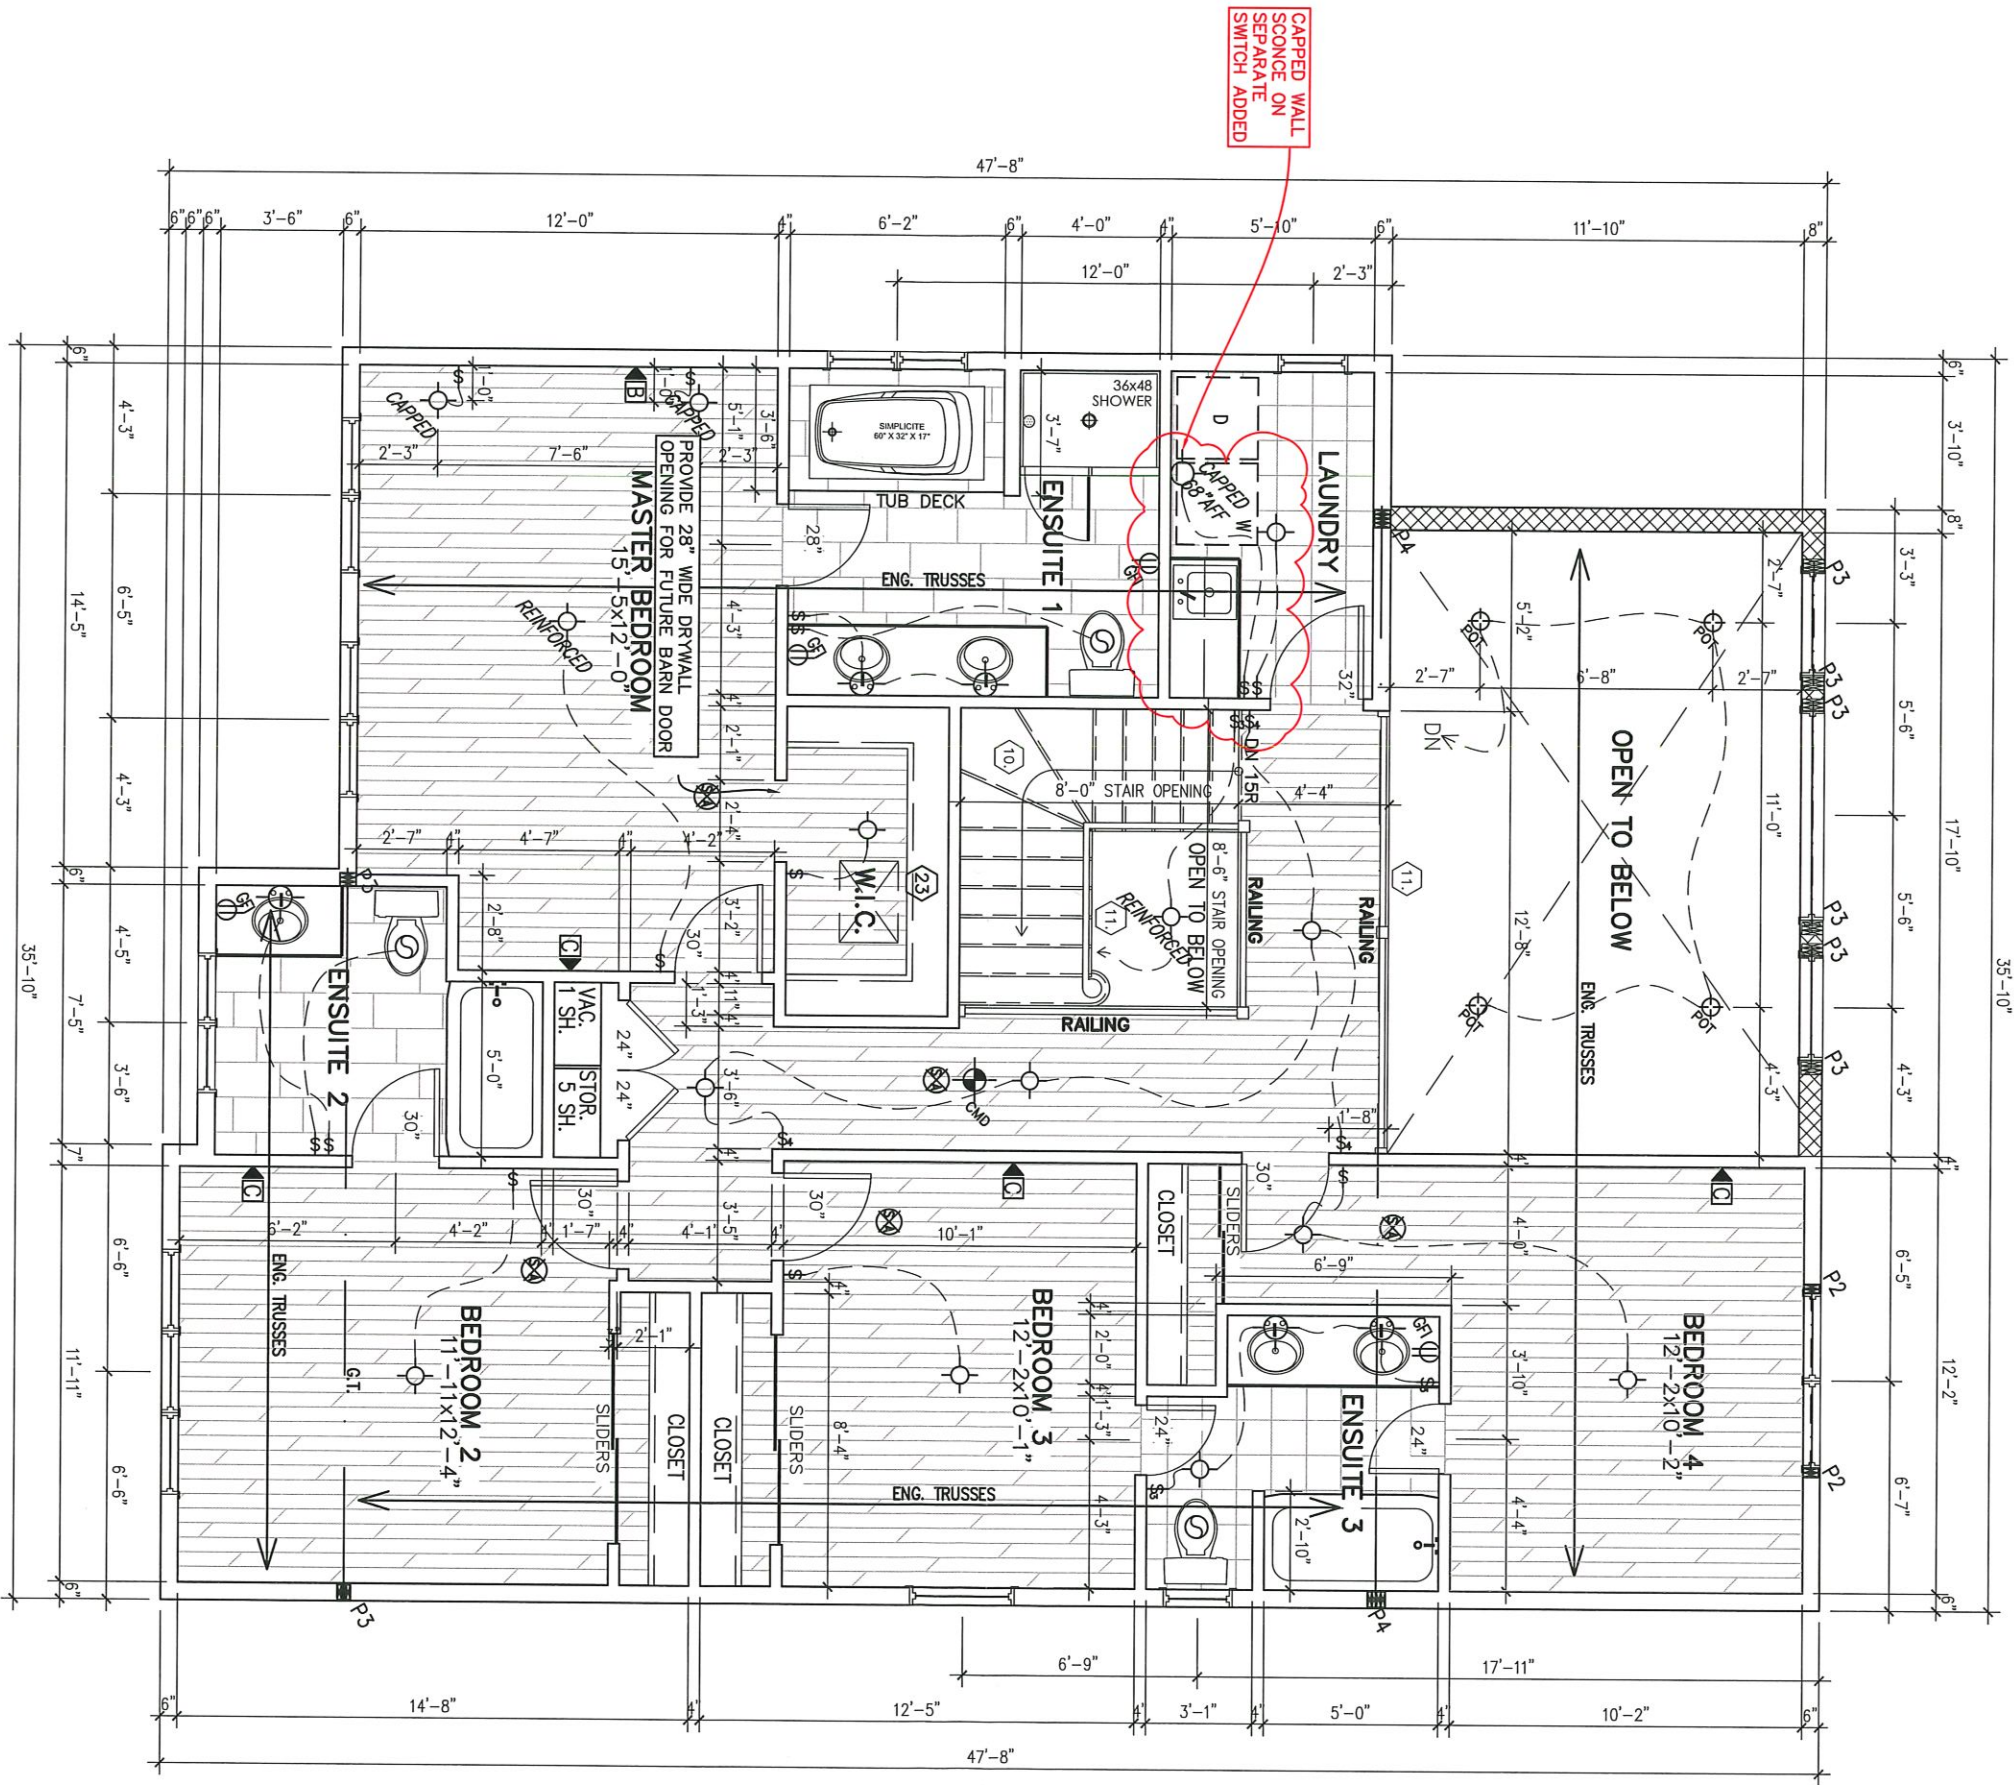

SECOND FLOOR PLAN ELEVATION D

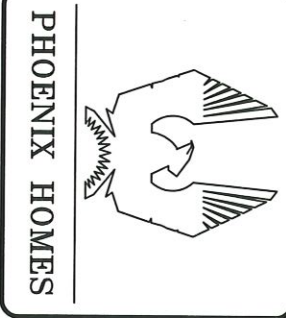

517-RUTHERFORD-2015

SITE: DIAMONDVIEW

LOT NUMBER: 23

CIVIC ADDRESS: 73 WINGOVER PVT

11	REVISED LAUNDRY & BASEMENT ELECTRICAL	08/02/21	CB
10	CORRECTION TO FAMILY ROOM WINDOWS	18/01/21	SP
9	FOR STRUCTURAL REVIEW OF DECK	04/12/20	SP
8	FINAL BLACKLINES	20/11/20	SP
7	BEP FOR SITE	07/10/20	SP
6	ISSUED FOR LAYOUTS	09/09/20	SP
REVISIONS			
No.	Description	dd/mm/yy	By

footprint: 517

designed by: TL

drawn by: SP

date: NOV/15

scale: 3/16"=1'-0"

D.C.L.-175

sheet 4 of 9