

DCR PHOENIX HOMES

LOT #38
PATHWAYS
MODEL - SARATOGA (43-5)


KITCHEN

MOUNTING HEIGHT - 96

CROWN MOULDING
LIGHT VALANCE

- CABINETS -
- HARDWARE -
- STANDARD WHITE INTERIOR
- METAL DRAWER BOX
- 4 PCS - 5/8" KICK - FIN. BOTH ENDS
- 5 PCS FLAT MOULDING
- 2 PCS - 90 DEG. CORNER MOULD
- 1 PCS - T-MOULD

REVISED: SEPT. 1 - 20

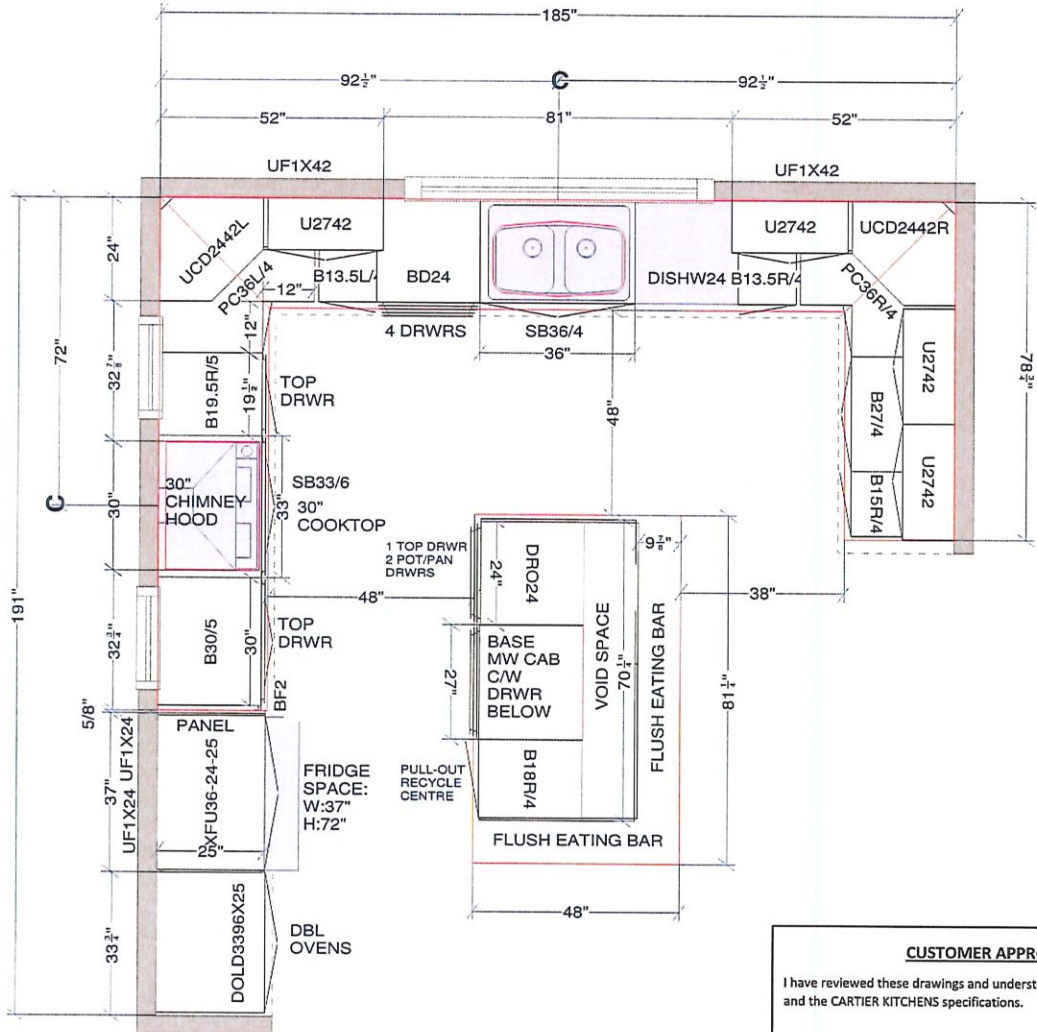


CUSTOMER APPROVAL
 I have reviewed these drawings and understand the details of the design and the CARTIER KITCHENS specifications.
 Signature _____
 Date _____

All dimensions size designations given are subject to verification on job site and adjustment to fit job conditions.
SPECTRUM KITCHEN and BATH DESIGN
 DCR#38-2.kit



This is an original design and must not be released or copied unless applicable fee has been paid or job order placed.
DRAWN BY: LORI DISAVERIO, B.I.D

Designed: 2020-09-01
 Printed: 2020-09-07

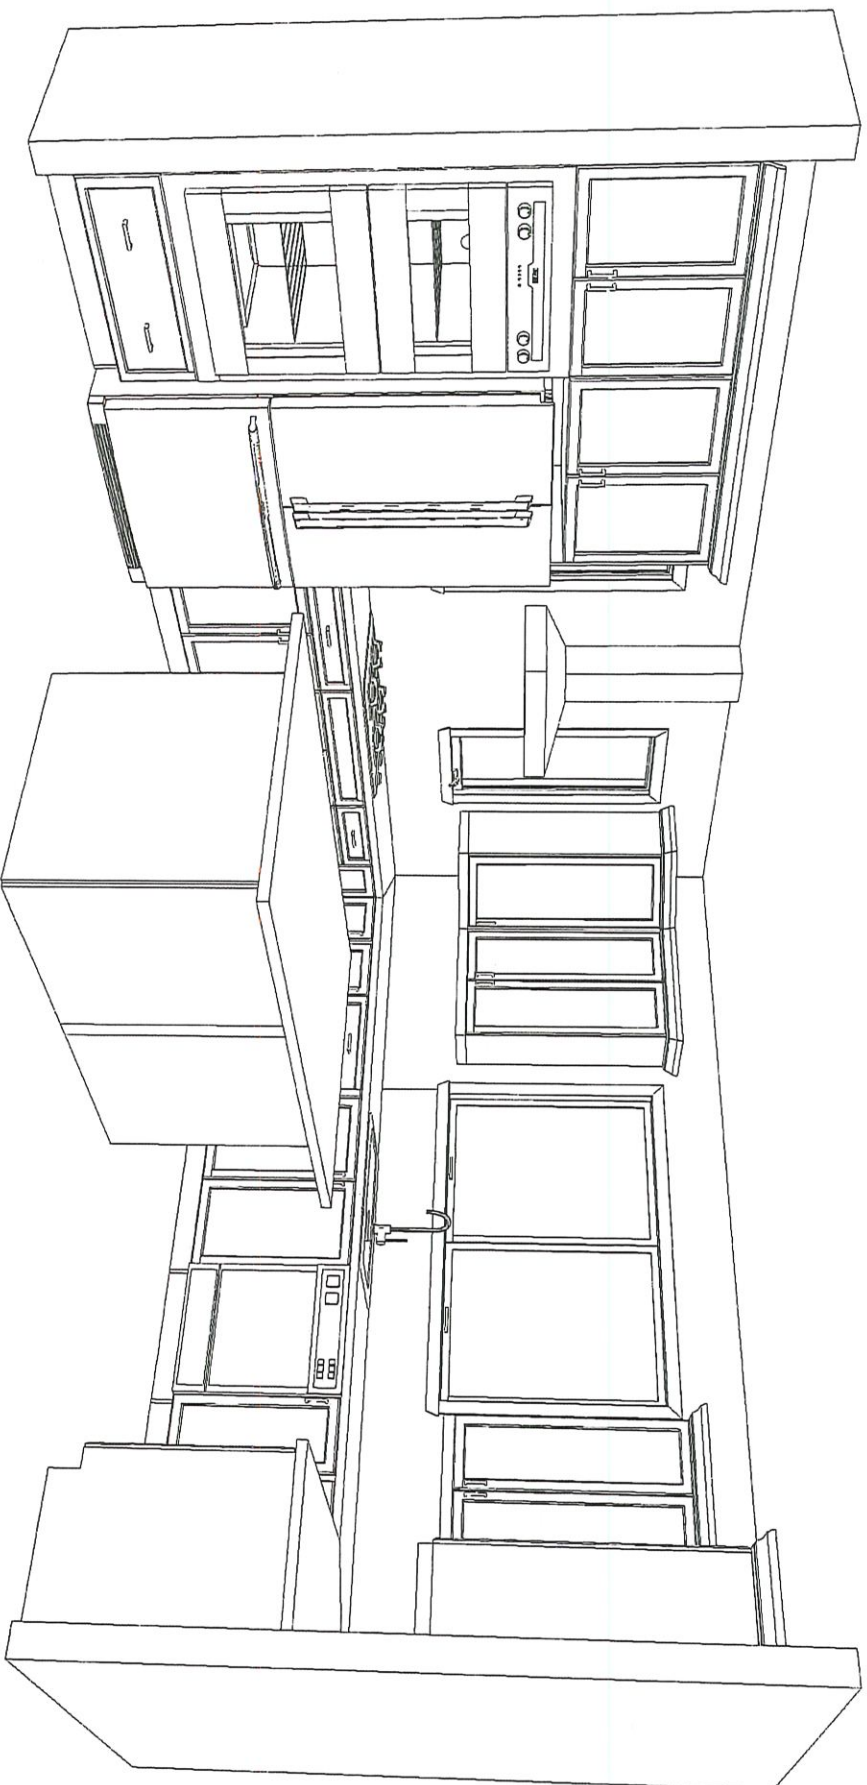

KITCHEN - 3D VIEW #1

CUSTOMER APPROVAL

I have reviewed these drawings and understand the details of the design and the CARTIER KITCHENS specifications.

Signature _____

Date _____

Note: This drawing is an artistic interpretation of the general appearance of the design. It is not meant to be an exact rendition.

SPECTRUM KITCHEN and BATH DESIGN

DCR #38 PWYS - Kitchen REVISED - Sept 1-20.kit


ALL

Drawing #: 1



Designed: 2020-09-01
Printed: 2020-09-01



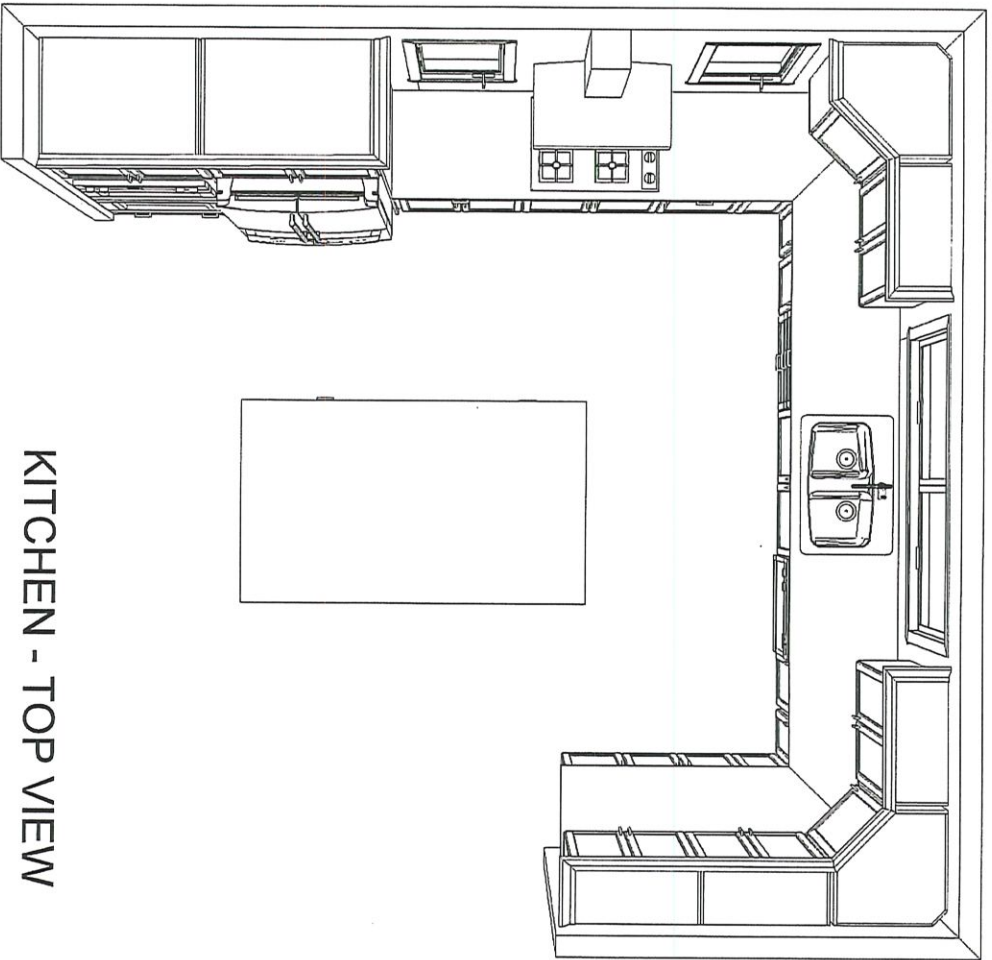

KITCHEN - TOP VIEW

CUSTOMER APPROVAL

I have reviewed these drawings and understand the details of the design and the CARTIER KITCHENS specifications.

Signature _____

Date _____

Note: This drawing is an artistic interpretation of the general appearance of the design. It is not meant to be an exact rendition.

SPECTRUM KITCHEN and BATH DESIGN




Designed: 2020-09-01
Printed: 2020-09-01



DCR #38 PWYS - Kitchen REVISED - Sept 1-20.kit

ALL

Drawing #: 1

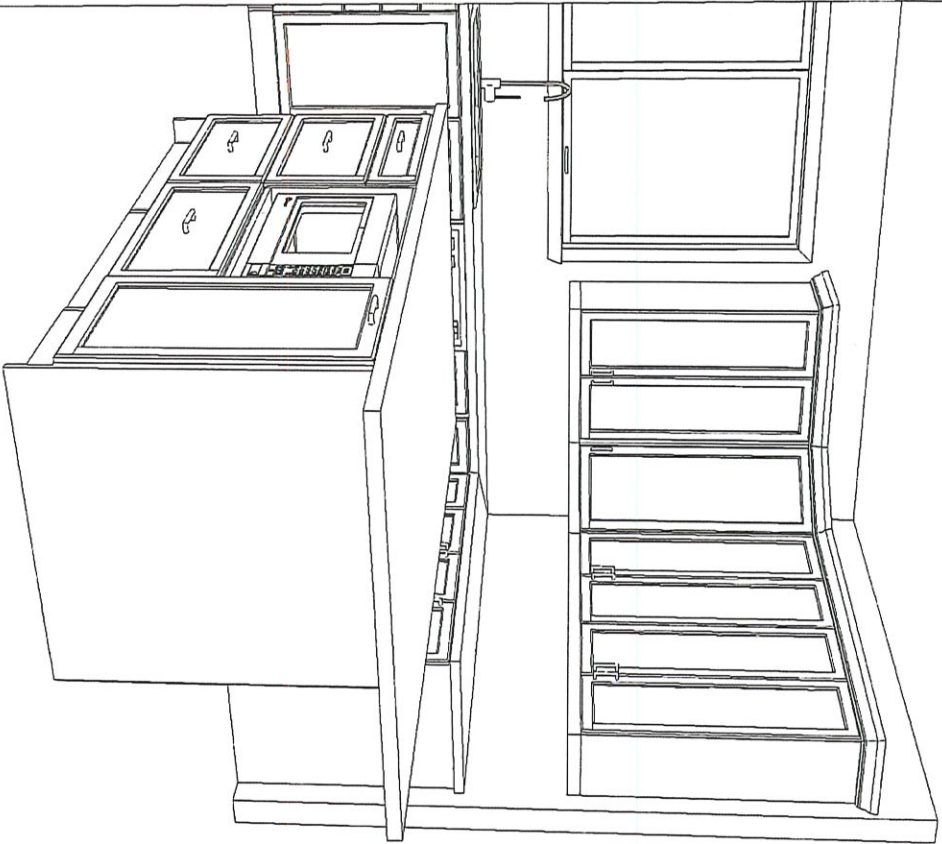

KITCHEN - 3D VIEW #2

CUSTOMER APPROVAL
 I have reviewed these drawings and understand the details of the design and the CARTIER KITCHENS specifications.

Signature _____

Date _____

Note: This drawing is an artistic interpretation of the general appearance of the design. It is not meant to be an exact rendition.

SPECTRUM KITCHEN and BATH DESIGN

DCR#38~2.kit



Designed: 2020-09-01
 Printed: 2020-09-07



All

Drawing #: 1



CUSTOMER APPROVAL

I have reviewed these drawings and understand the details of the design and the CARTIER KITCHENS specifications.

Signature _____

Date _____

KITCHEN - 3D VIEW #3

Note: This drawing is an artistic interpretation of the general appearance of the design. It is not meant to be an exact rendition.

SPECTRUM KITCHEN and BATH DESIGN




Designed: 2020-09-01
 Printed: 2020-09-01



DCR #38 PWYS - Kitchen REVISED - Sept 1-20.kti

All

Drawing #: 1

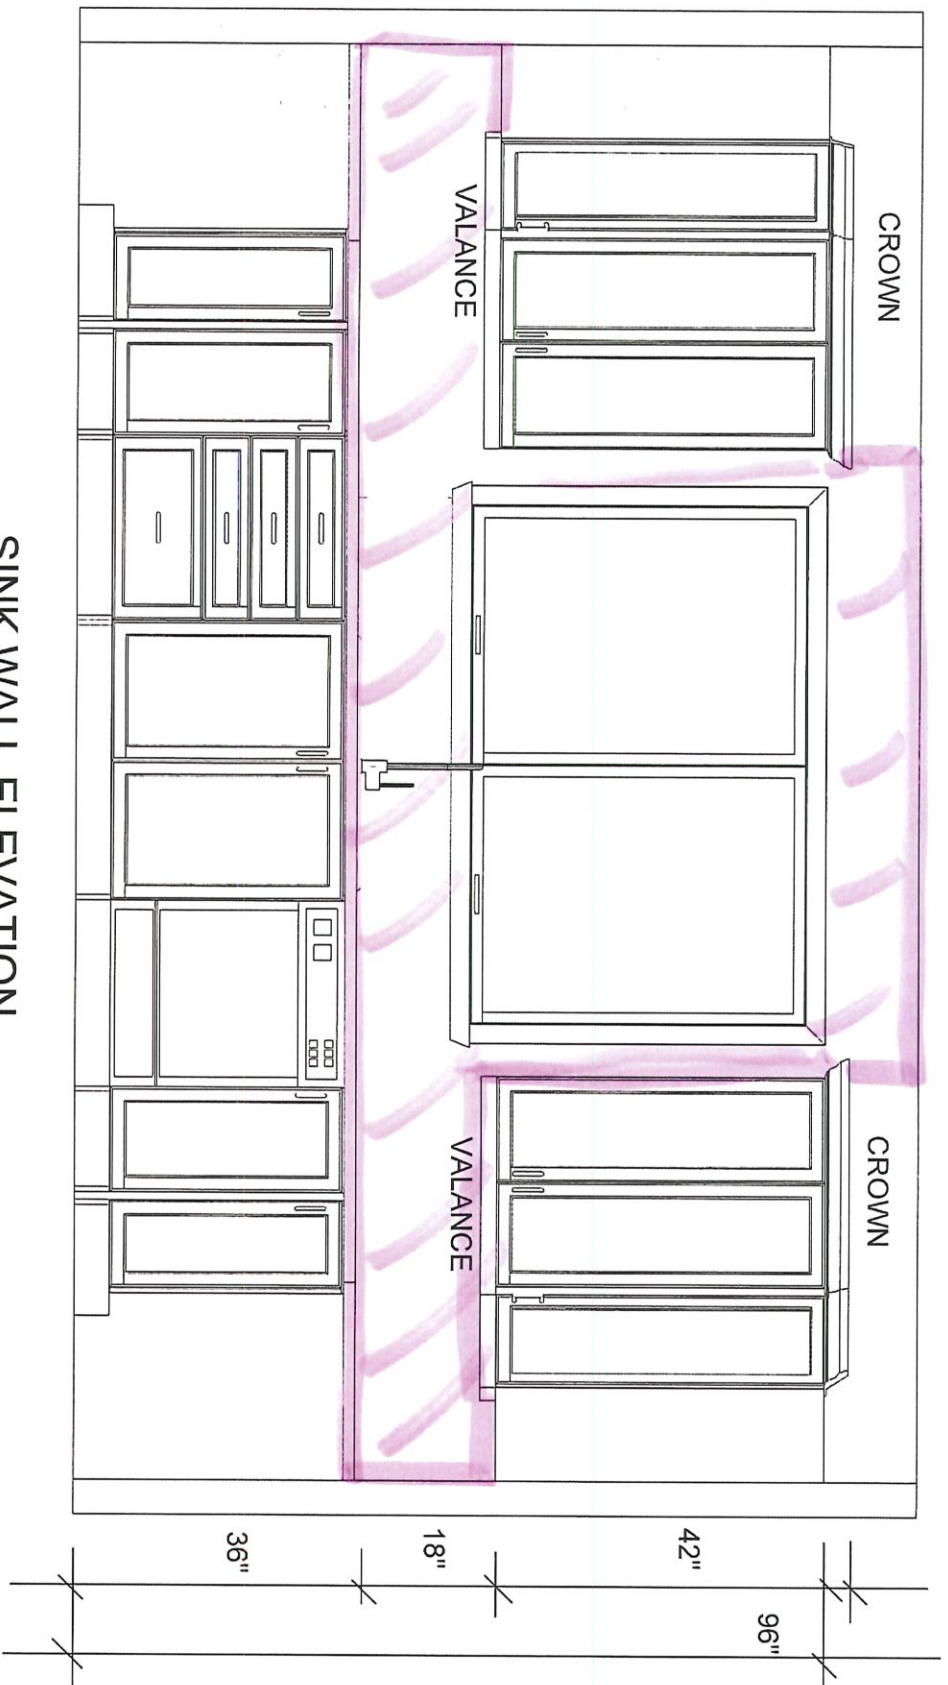

SINK WALL ELEVATION

** BACKSPLASH TO GO UP & AROUND WINDOW **

CUSTOMER APPROVAL

I have reviewed these drawings and understand the details of the design and the CARTIER KITCHENS specifications.

Signature _____

Date _____

Note: This drawing is an artistic interpretation of the general appearance of the design. It is not meant to be an exact rendition.

SPECTRUM KITCHEN and BATH DESIGN




Designed: 2020-09-01
Printed: 2020-09-01



DCR #38 PWYS - Kitchen REVISED - Sept 1-20.kit

ALL

Drawing #: 1

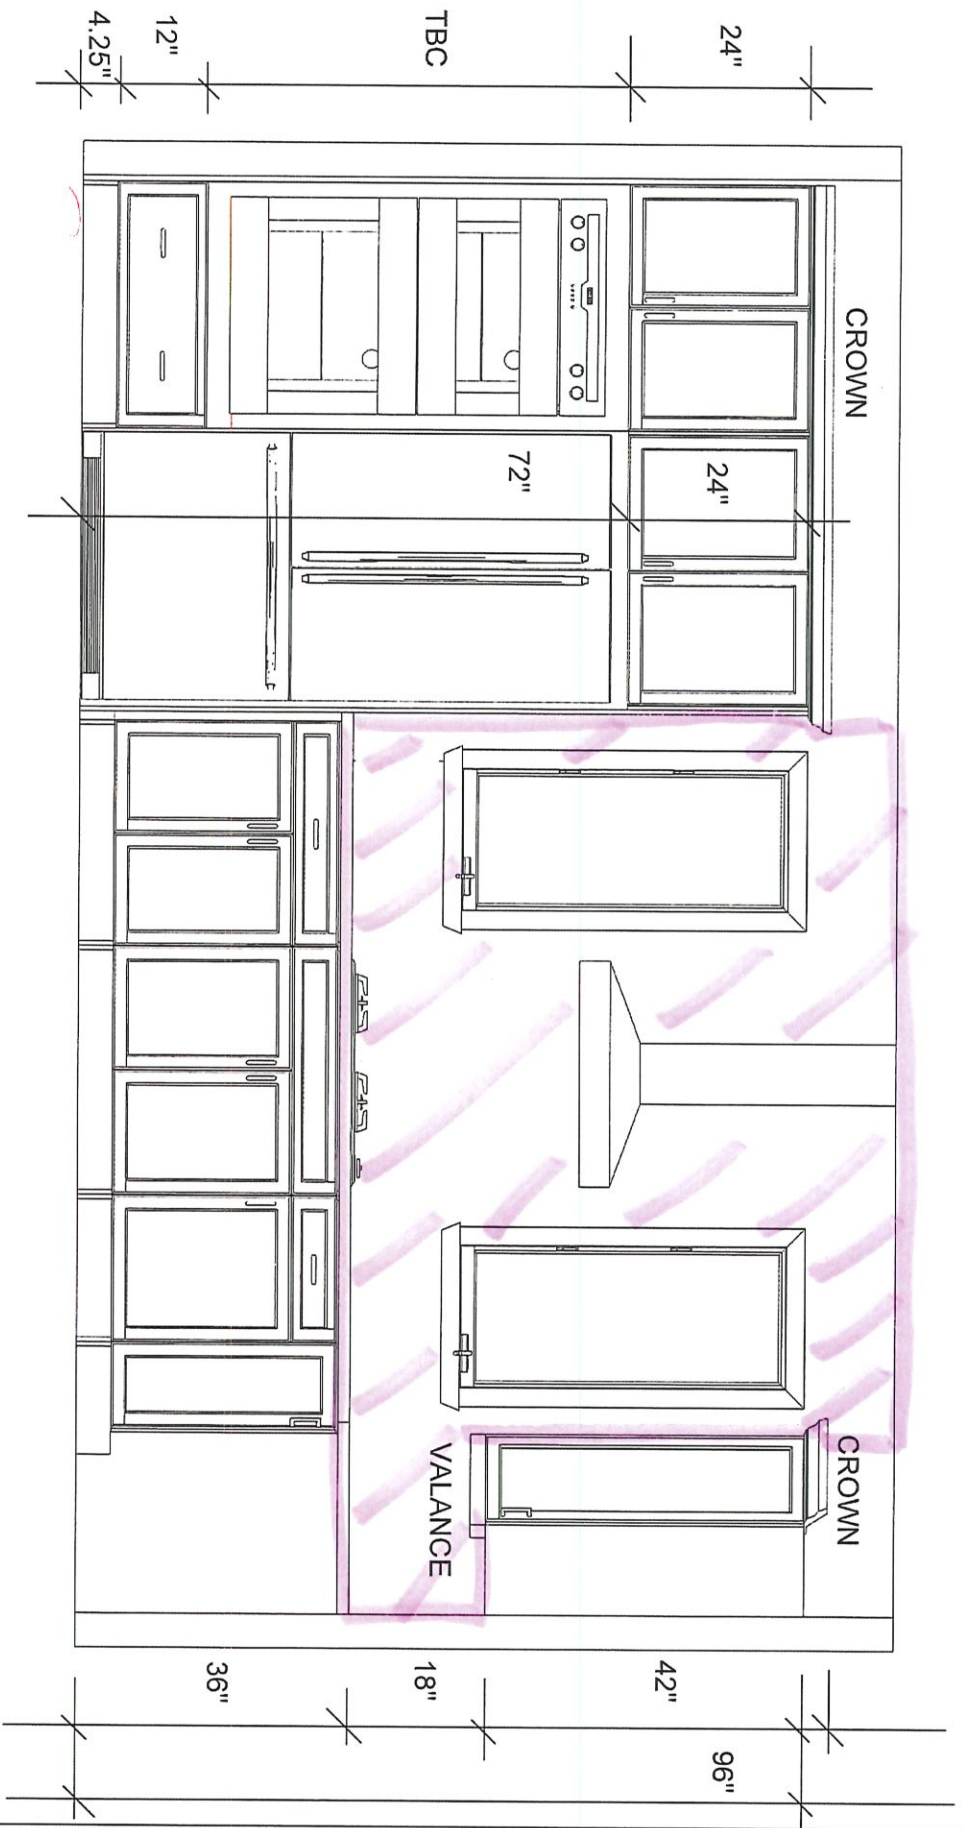

BACKSPASH TO GO UP + AROUND WINDOWS

OVEN / FRIDGE/ COOKTOP WALL ELEVATION

CUSTOMER APPROVAL

I have reviewed these drawings and understand the details of the design and the CARTIER KITCHENS specifications.

Signature _____

Date _____

Note: This drawing is an artistic interpretation of the general appearance of the design. It is not meant to be an exact rendition.

SPECTRUM KITCHEN and BATH DESIGN





Designed: 2020-09-01
Printed: 2020-09-01



DCR #38 PWYS - Kitchen REVISED - Sept 1-20.kit

ALL

Drawing #: 1

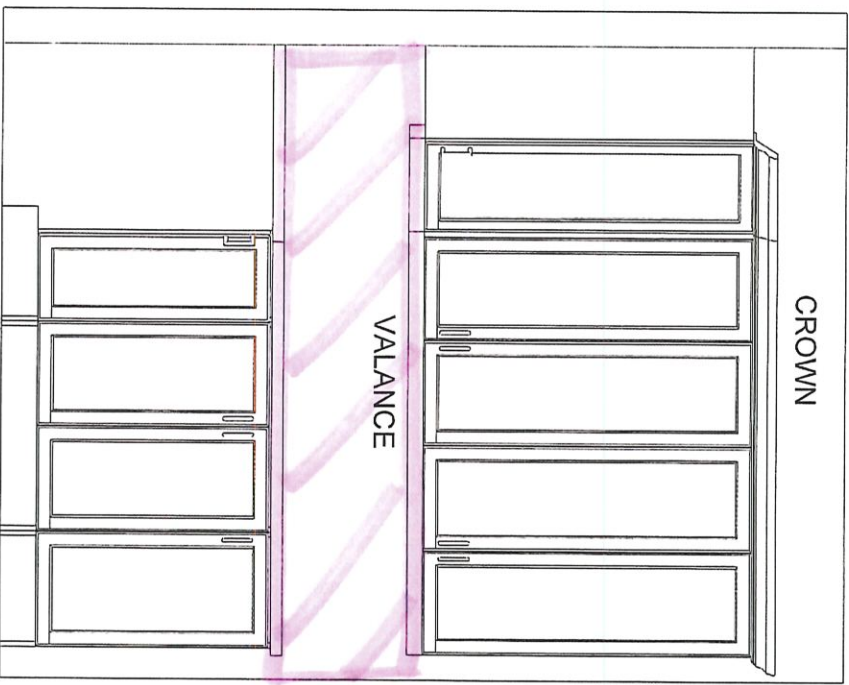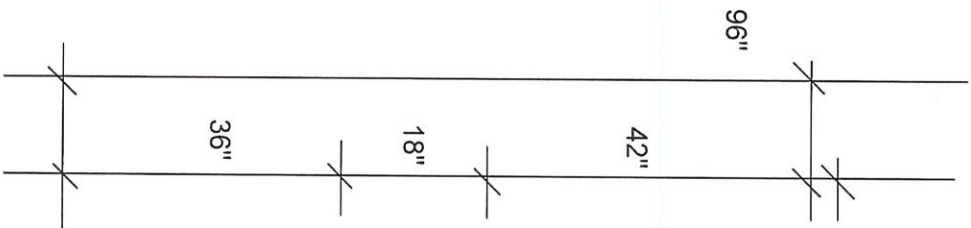

WALL 3 - ELEVATION

CUSTOMER APPROVAL

I have reviewed these drawings and understand the details of the design and the CARTIER KITCHENS specifications.

Signature _____

Date _____

Note: This drawing is an artistic interpretation of the general appearance of the design. It is not meant to be an exact rendition.

SPECTRUM KITCHEN and BATH DESIGN



Designed: 2020-09-01
Printed: 2020-09-01



DCR #38 PWYS - Kitchen REVISED - Sept 1-20.kti

ALL

Drawing #: 1