

LOT #25

DIAMONVIEW ESTATES



KITCHEN / VANITIES

42"H LIPPERS INSTALL


~~CROWN MOULDING~~ - C

~~LIGHT VALANCE~~ - CANFE


CABNETS-
HARDWARE -
STANDARD WHITE INTERIOR
STANDARD METAL DRAWER BOX
STANDARD HINGES
4 PCS - 5/8" KICK - FIN. BOTH END
1 PCS - 90 DEG. CORNER MOULD
1 PCS - T-MOULD
5 PCS - FLAT MOULD

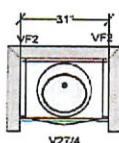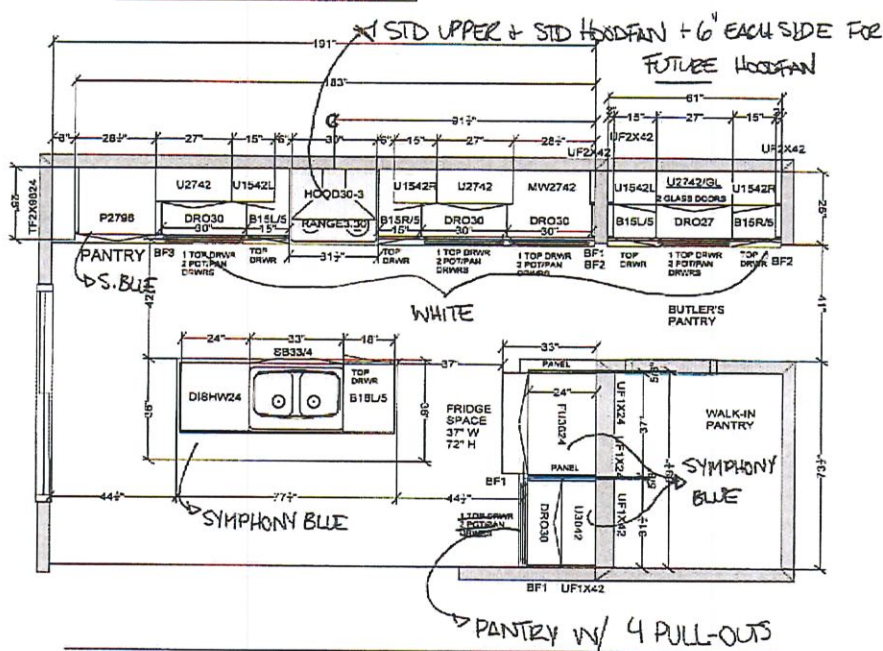

POWDER ROOM

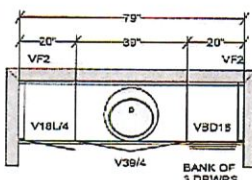

MAIN BATH

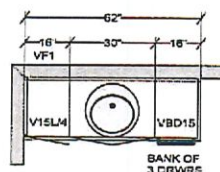**MASTER ENSUITE**

CUSTOMER APPROVAL

I have reviewed these drawings and understand the details of the design and the Carter 3 teacher's specifications

Signature _____

Date _____

All dimensions & size designations given are subject to verification on job site and adjustment to fit job conditions.



This is an original design and must not be released or copied unless applicable fee has been paid or job order placed.


Designed: 9/13/2020
Printed: 9/14/2020

RB PBF

DCR - #25 Diamondview - Madison (43-10)

All	
-----	--

Drawing #: 1	No Scale
--------------	----------

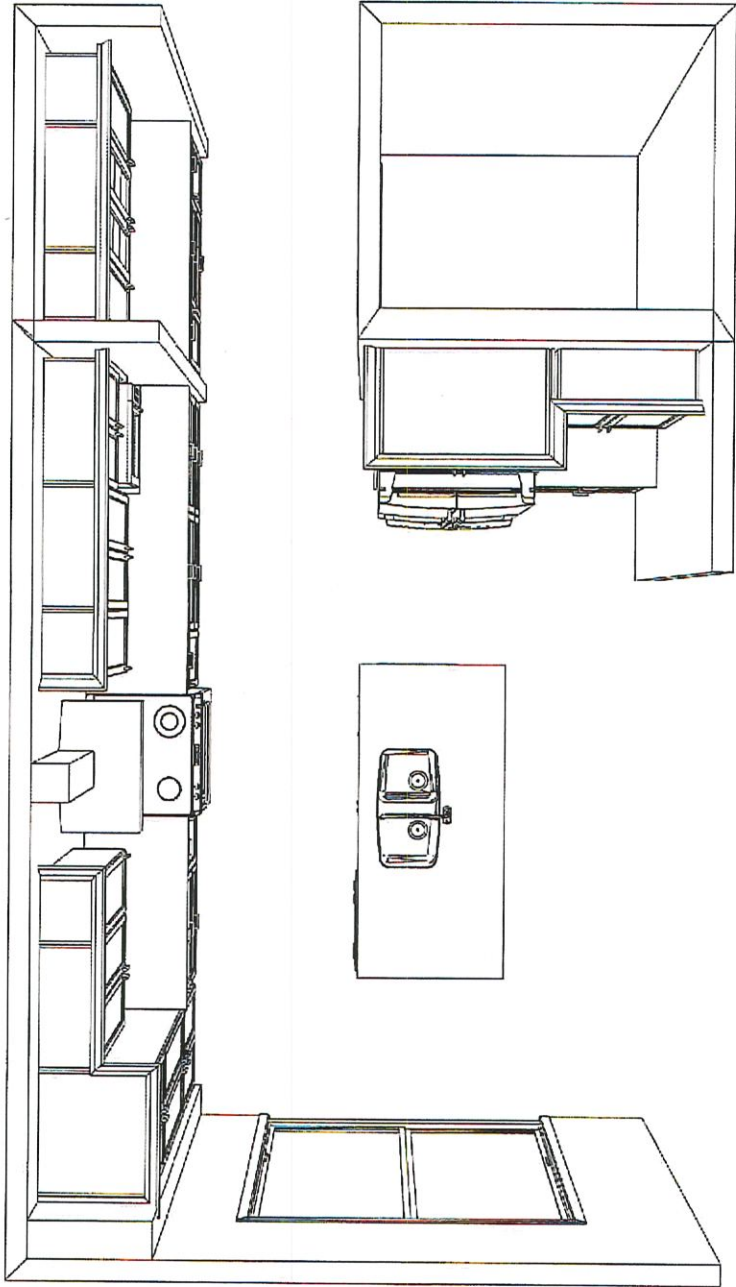

KITCHEN - TOP VIEW

CUSTOMER APPROVAL

I have reviewed these drawings and understand the details of the design and the Carter Kitchens specifications

Signature _____

Date _____


Note: This drawing is an artistic interpretation of the general appearance of the design. It is not meant to be an exact rendition.



Designed: 9/13/2020
Printed: 9/14/2020



DCR - #25 Diamondview - Madison (43-10) All Drawing #: 1

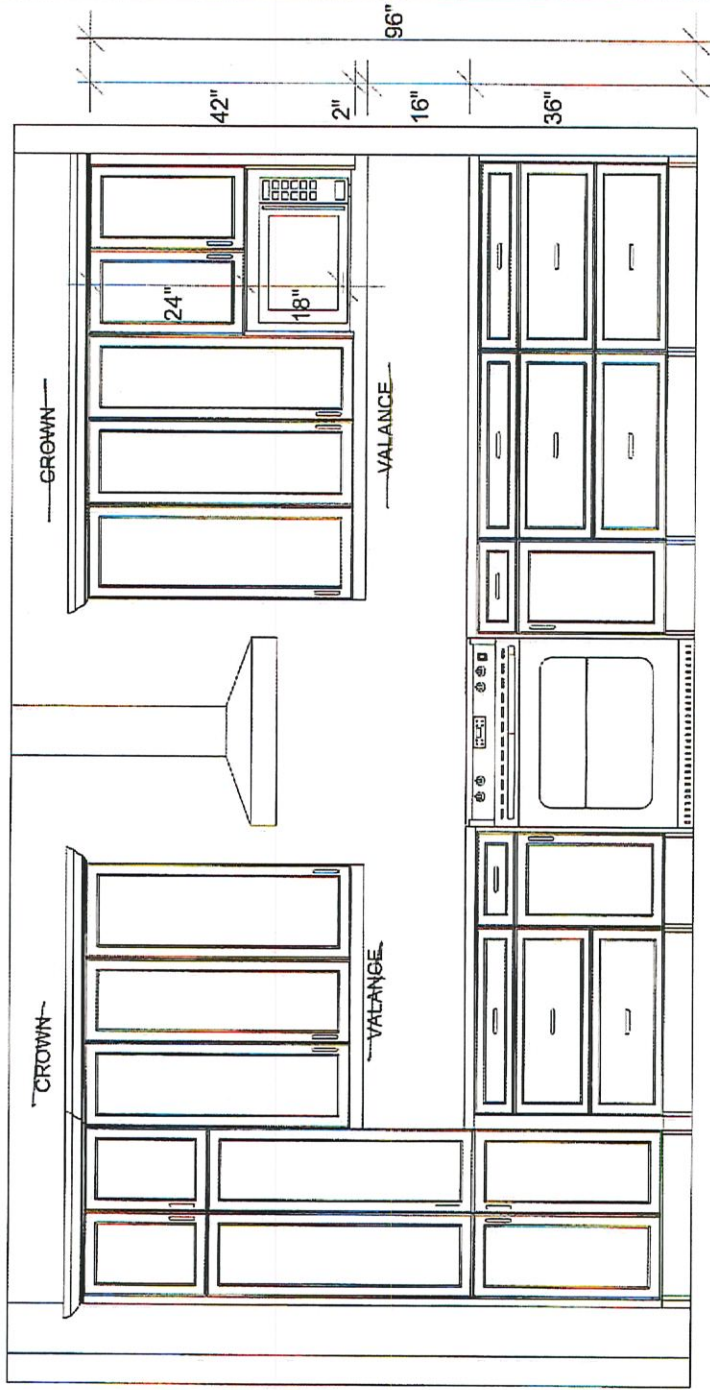

RANGE WALL ELEVATION

CUSTOMER APPROVAL

I have reviewed these drawings and understand the details of the design and the Carter Kitchens specifications

Signature _____

Date _____


Note: This drawing is an artistic interpretation of the general appearance of the design. It is not meant to be an exact rendition.



Designed: 9/13/2020
Printed: 9/14/2020

188
188

DCR - #25 Diamondview - Madison (43-10) All Drawing #: 1

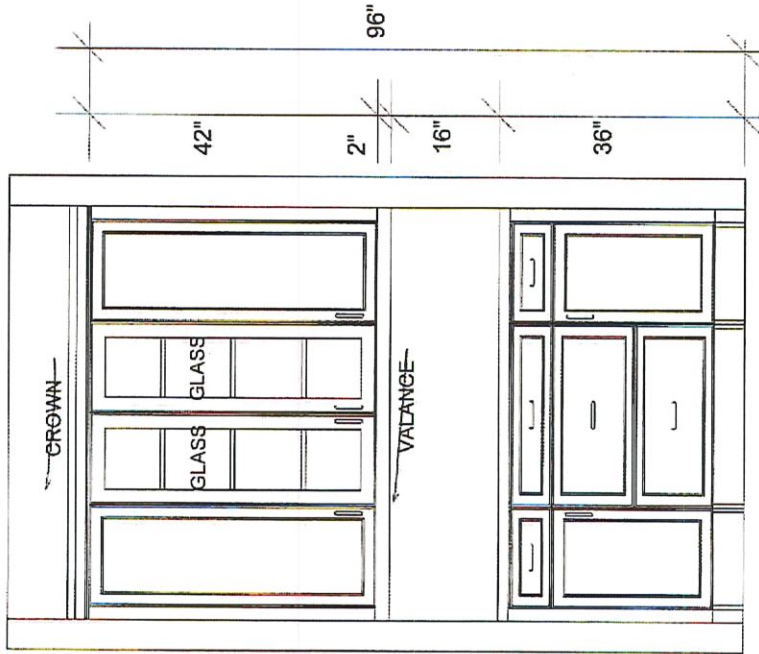

BUTLER'S PANTRY ELEVATION

CUSTOMER APPROVAL

I have reviewed these drawings and understand the details of the design and the Cartier Kitchens specifications

Signature _____

Date _____


Note: This drawing is an artistic interpretation of the general appearance of the design. It is not meant to be an exact rendition.

Designed: 9/13/2020
 Printed: 9/14/2020

DCR - #25 Diamondview - Madison (43-10)


All

Drawing #: 1

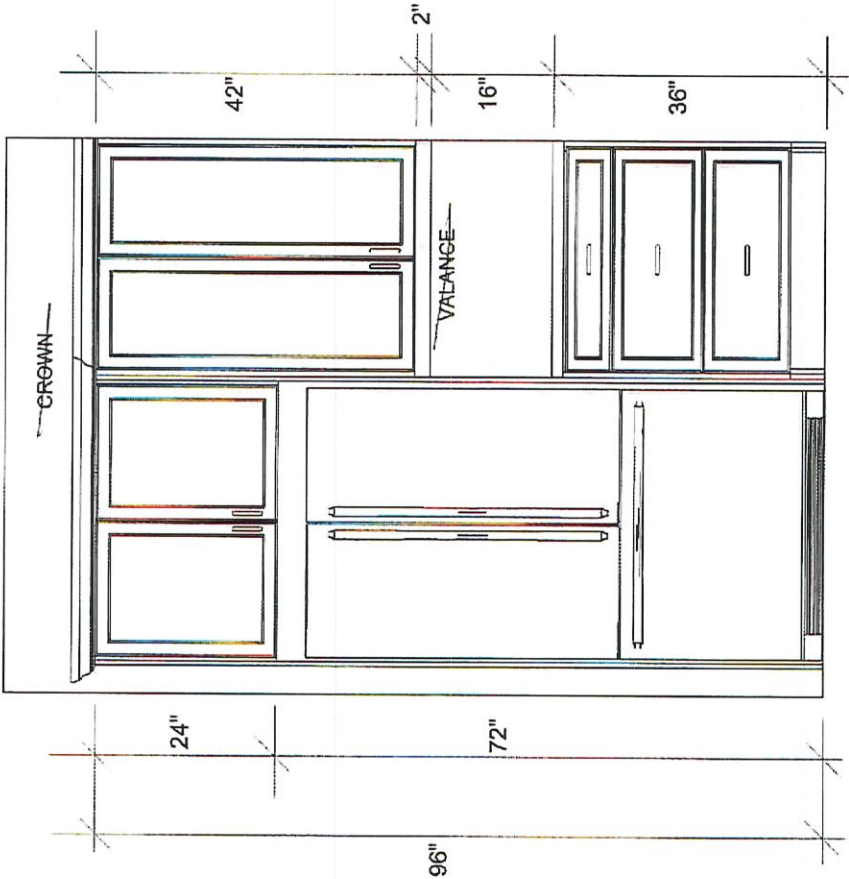


FRIDGE WALL ELEVATION

CUSTOMER APPROVAL I have reviewed these drawings and understand the details of the design and the Carlier Kitchens specifications Signature _____ Date _____	Note: This drawing is an artistic interpretation of the general appearance of the design. It is not meant to be an exact rendition.	SPECTRUM DESIGN & CONSTRUCTION	Designed: 9/13/2020 Printed: 9/14/2020 RF 48	DCR - #25 Diamondview - Madison (43-10) All Drawing #: 1
---	--	---	--	---

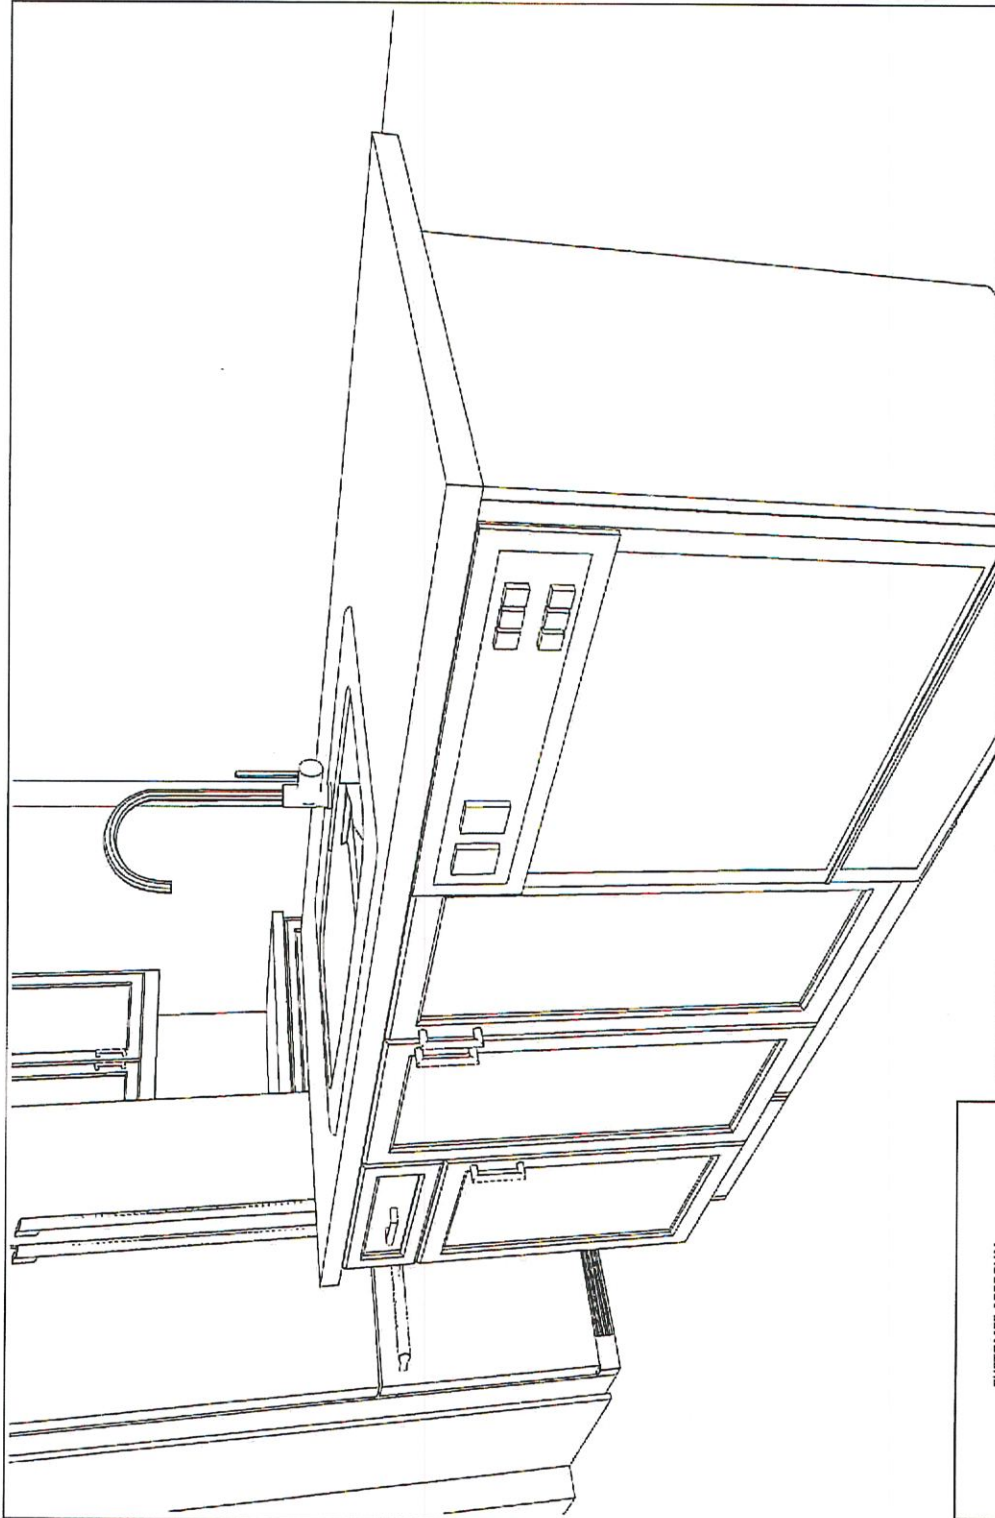


KITCHEN - 3D VIEW #3


CUSTOMER APPROVAL I have reviewed these drawings and understand the details of the design and the Cartier Kitchens specifications Signature _____ Date _____		Note: This drawing is an artistic interpretation of the general appearance of the design. It is not meant to be an exact rendition.		Designed: 9/13/2020 Printed: 9/14/2020	 
DCR - #25 Diamondview - Madison (43-10)					

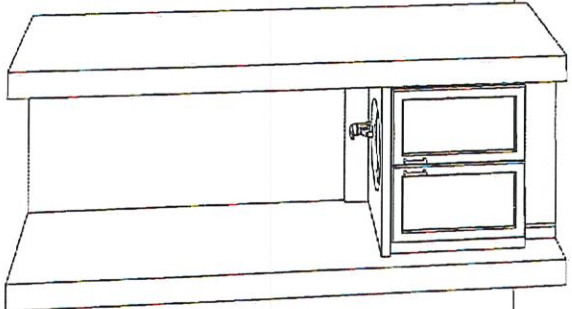

POWDER ROOM

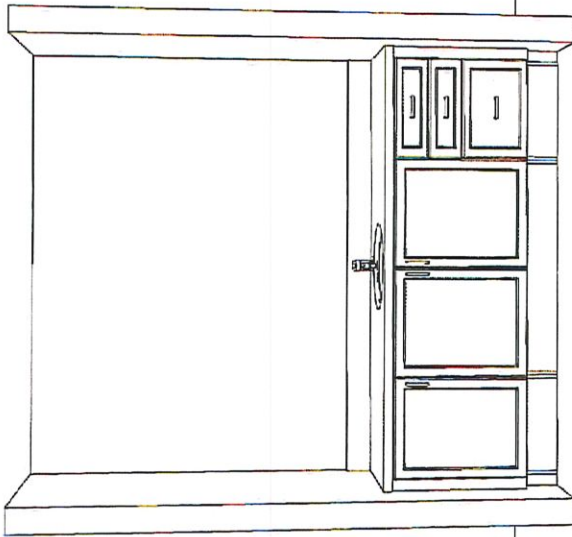

MAIN BATHROOM

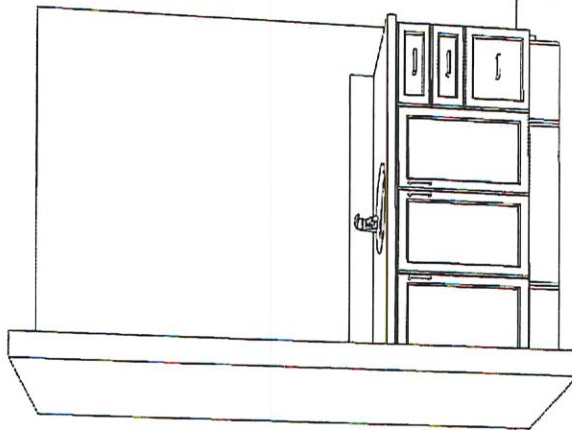

MASTER BATHROOM

CUSTOMER APPROVAL

I have reviewed these drawings and understand the details of the design and the Cartier Kitchens specifications

Signature _____

Date _____

Note: This drawing is an artistic interpretation of the general appearance of the design. It is not meant to be an exact rendition.		Designed: 9/13/2020	
		Printed: 9/14/2020	
DCR - #25 Diamondview - Madison (43-10)		All	Drawing #: 1