
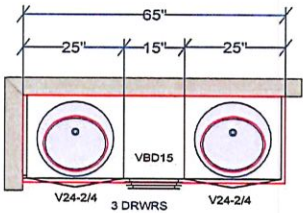


DCR PHOENIX HOMES


LOT #57
DIAMONDVIEW ESTATES
PINEHURST
KITCHEN / VANITIES

MOUNTING HT: 96"
+ 1" FILLER TO BULKHEAD
42"H UPPERS INSTALLED @
18" ABOVE COUNTER

CABINETS -
HARDWARE -
STD WHITE INTERIORS
METAL DRAWER BOX
4 PCS - 5/8" KICK
2 PCS - 90 DEG MOULD
1 PC - T MOULD

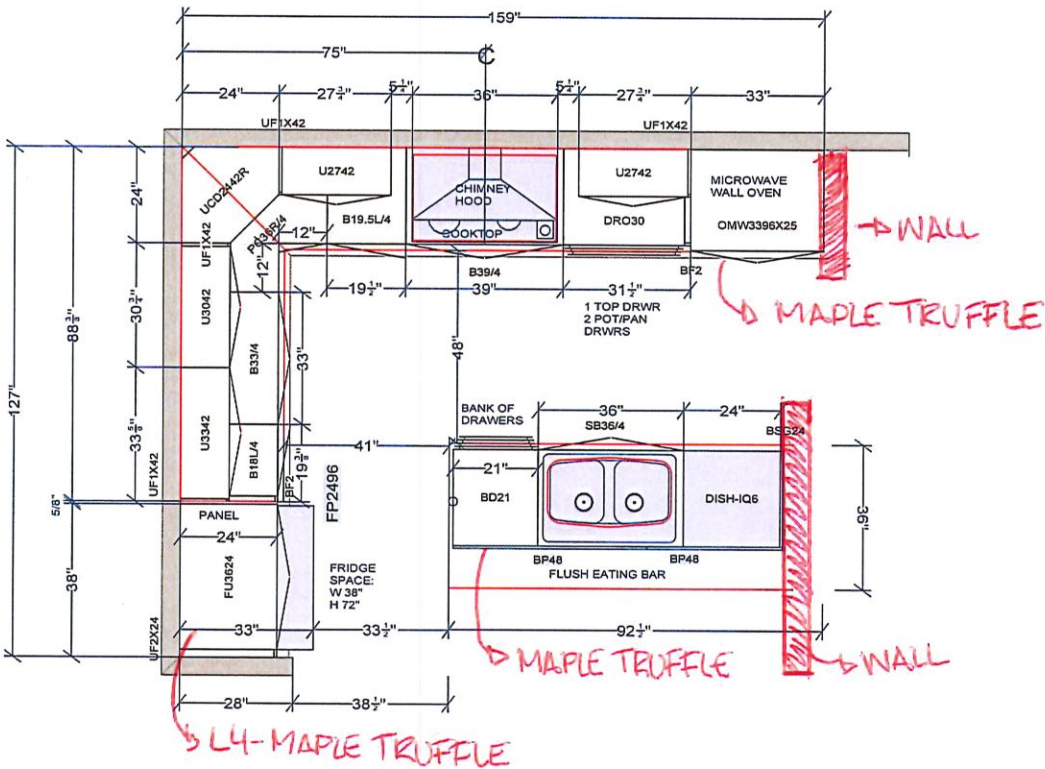


ENSUITE

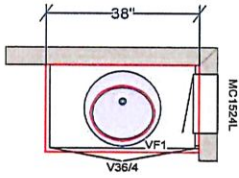


MAIN BATH

CUSTOMER APPROVAL I have reviewed these drawings and understand the details of the design and the Cartier Kitchens specifications Signature _____ Date _____	All dimensions size designations given are subject to verification on job site and adjustment to fit job conditions.	SPECTRUM KITCHEN & BATH DESIGN	This is an original design and must not be released or copied unless applicable fee has been paid or job order placed.	Designed: 8/31/2020 Printed: 9/1/2020 DS W.Y.
DCR #57 Diamondview Estates - Pinehurst				All Drawing #: 1 No Scale.

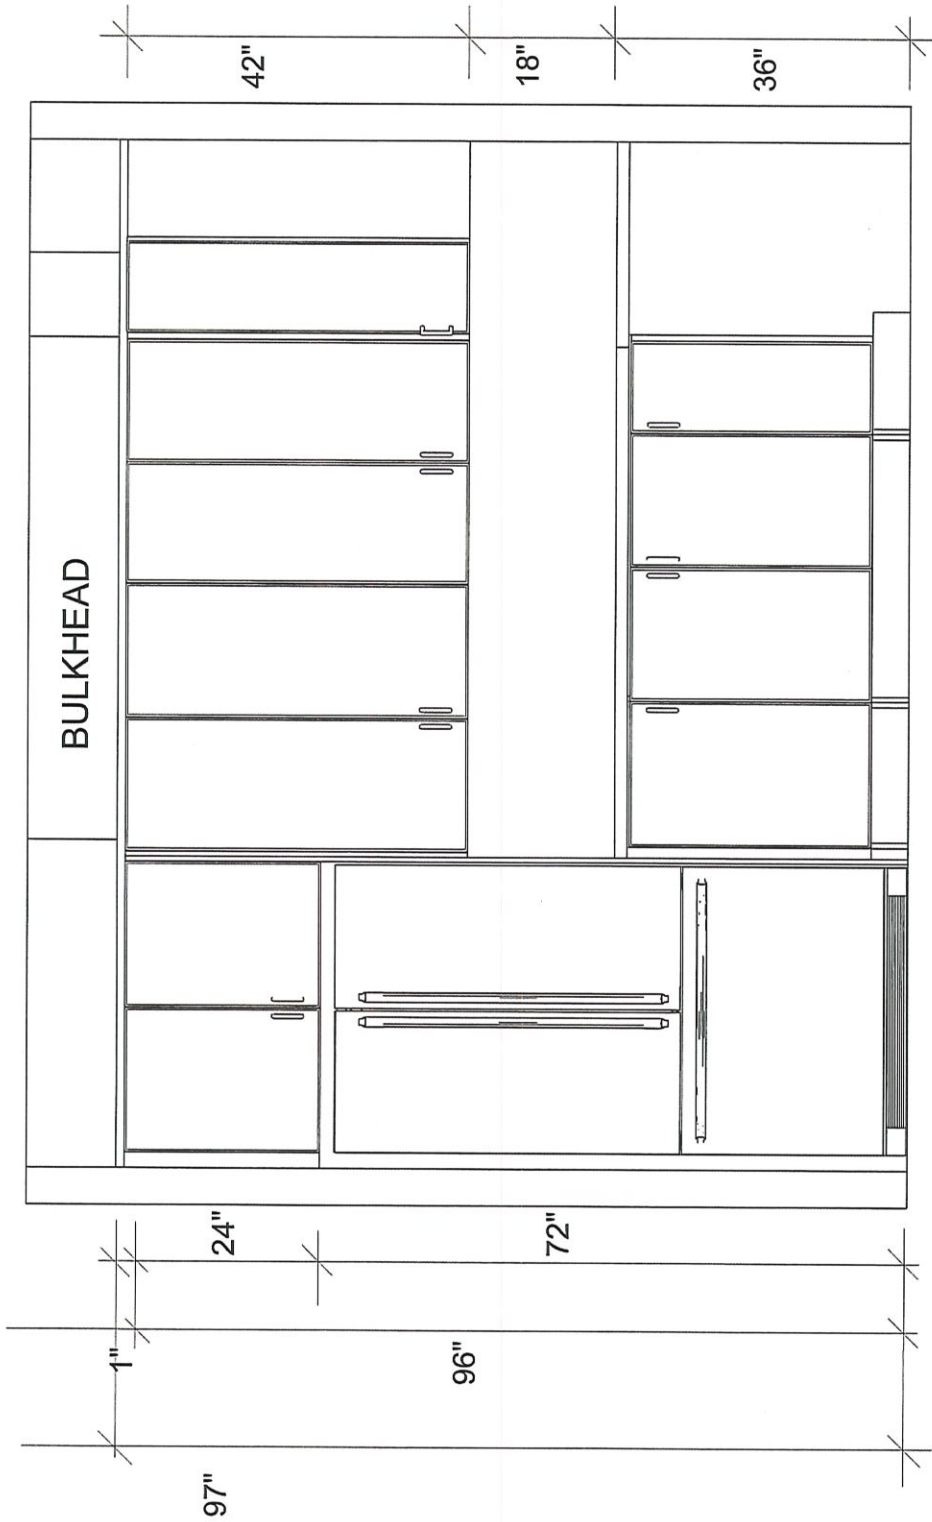

KITCHEN - FRIDGE ELEVATION

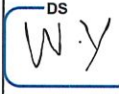
Note: This drawing is an artistic interpretation of the general appearance of the design. It is not meant to be an exact rendition.		Designed: 8/31/2020 Printed: 9/1/2020	
		DS	
DCR #57 Diamondview Estates - Pinehurst		All	Drawing #: 1

CUSTOMER APPROVAL

I have reviewed these drawings and understand the details of the design and the Cartier Kitchens specifications

Signature _____

Date _____

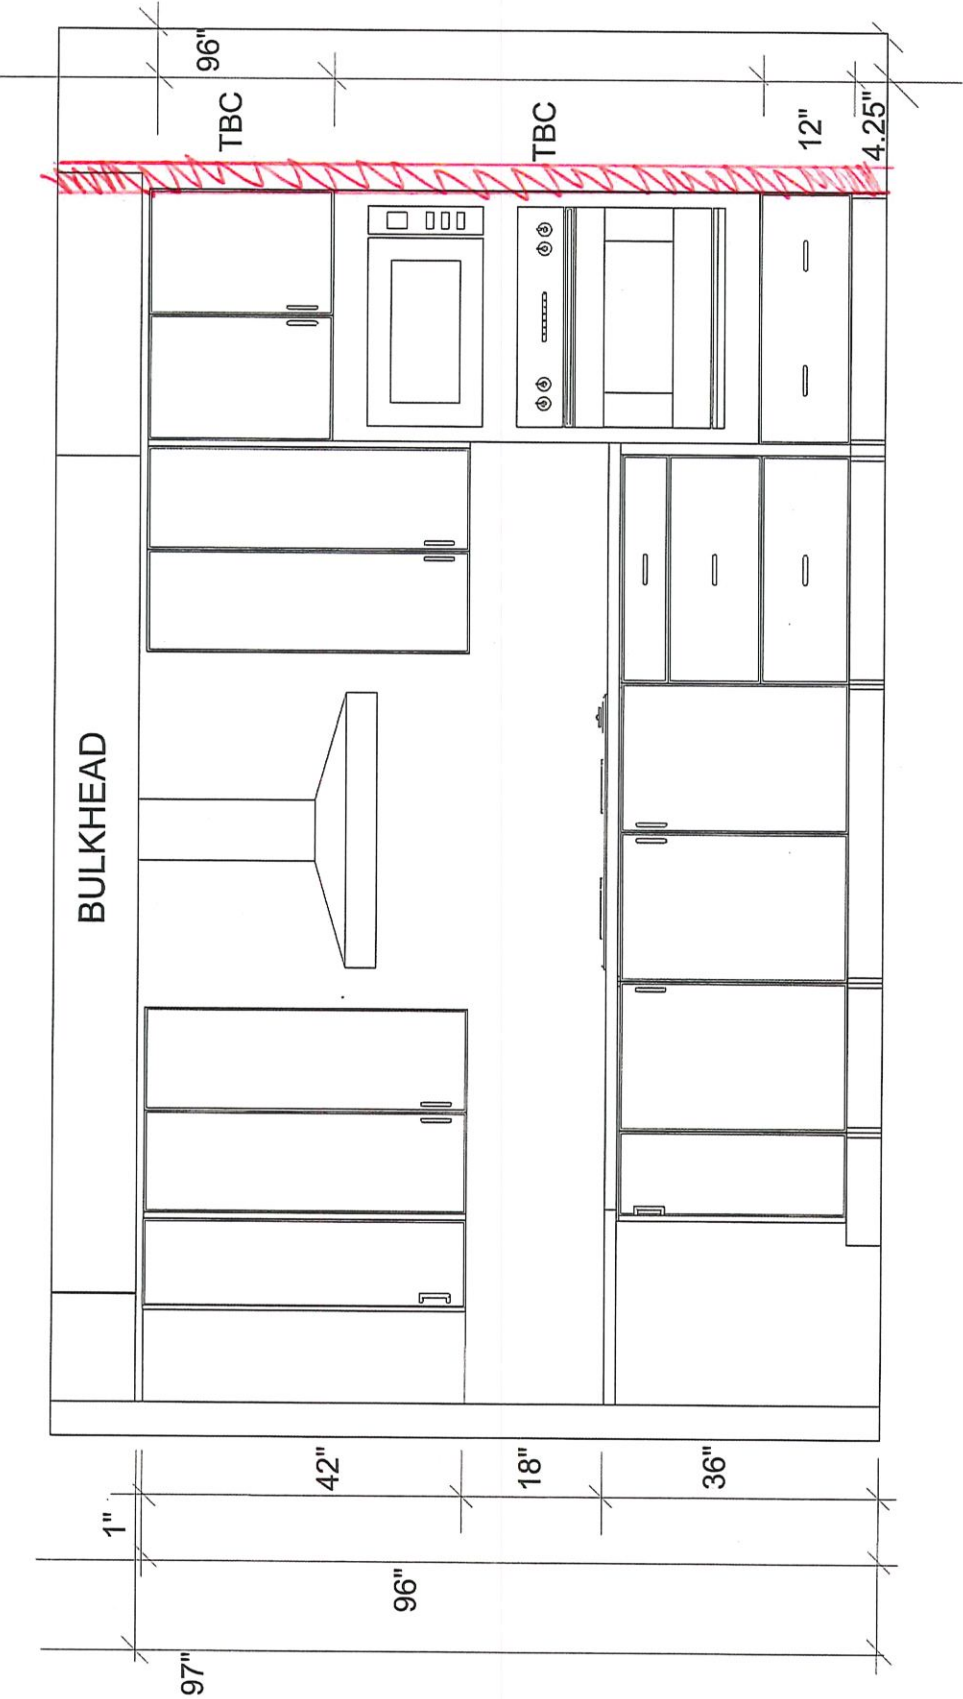

KITCHEN - COOKTOP / WALLOVEN ELEVATION

CUSTOMER APPROVAL

I have reviewed these drawings and understand the details of the design and the Cartier Kitchens specifications

Signature _____
Date _____

Note: This drawing is an artistic interpretation of the general appearance of the design. It is not meant to be an exact rendition.




Designed: 8/31/2020
Printed: 9/1/2020

W.DS

DCR #57 Diamondview Estates - Pinchurst

All

Drawing #: 1

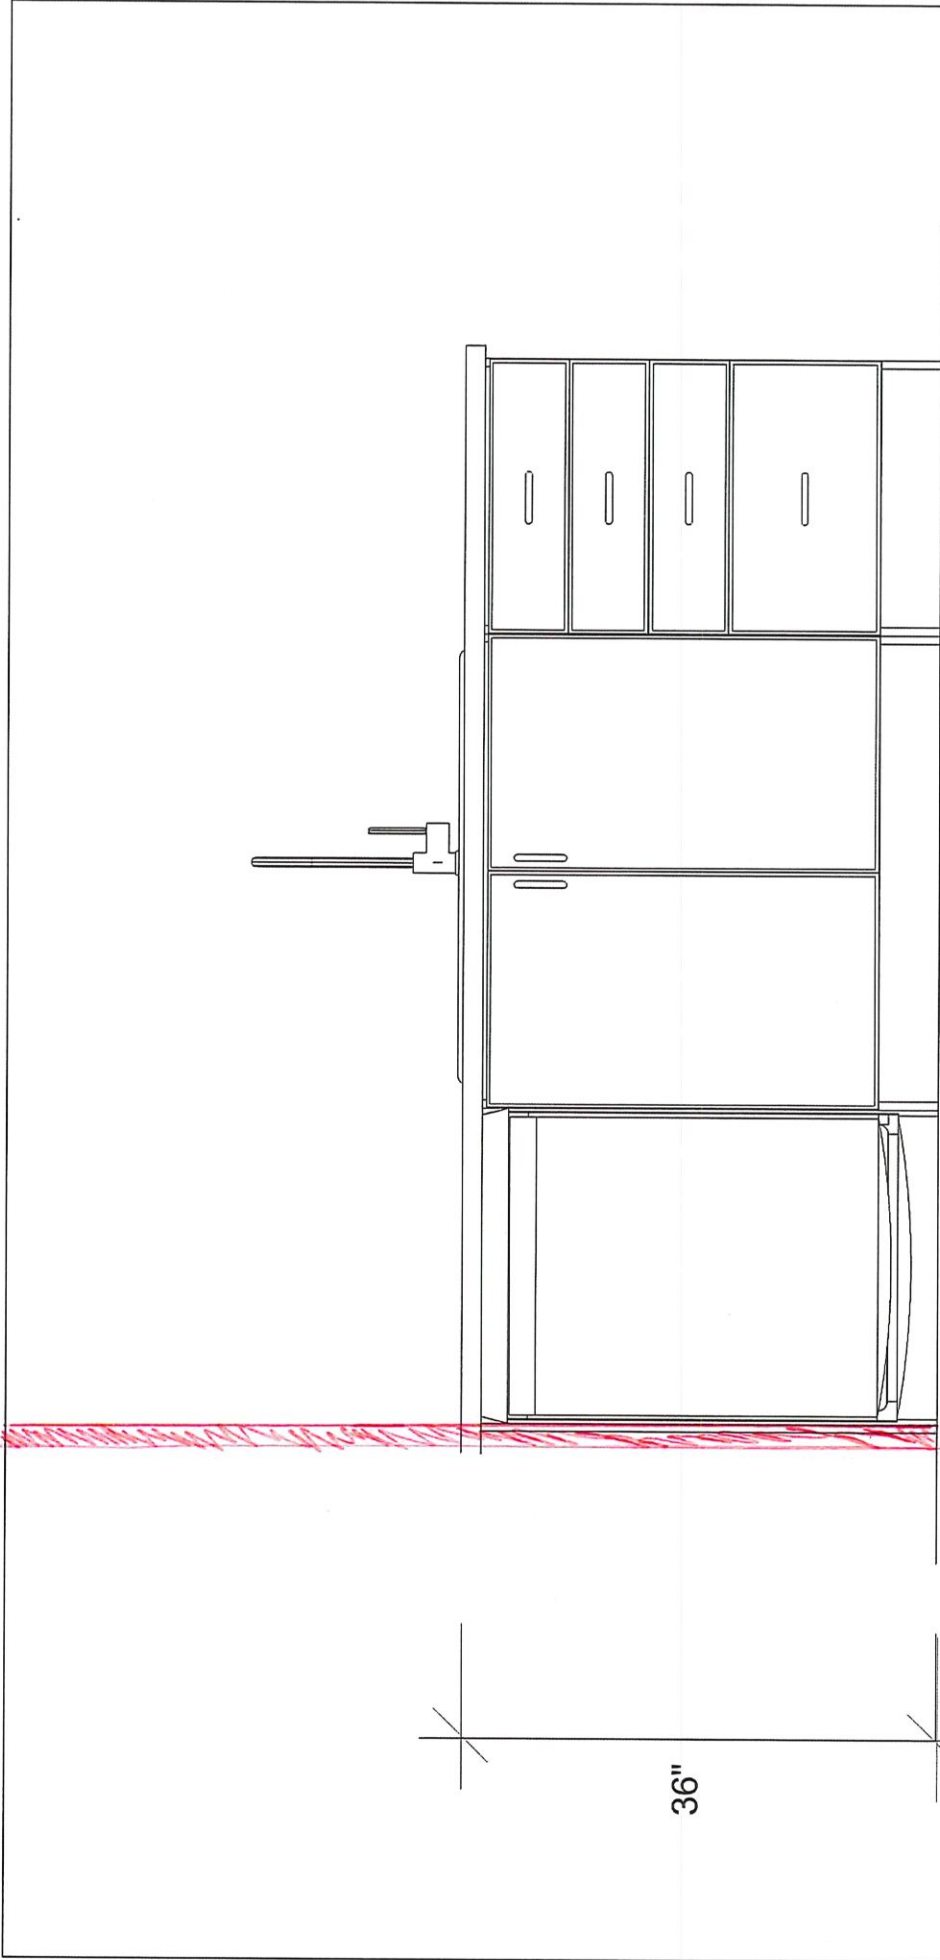

KITCHEN - ISLAND ELEVATION

CUSTOMER APPROVAL


I have reviewed these drawings and understand the details of the design and the Cartier Kitchens specifications

Signature _____
Date _____

Note: This drawing is an artistic interpretation of the general appearance of the design. It is not meant to be an exact rendition.



Designed: 9/1/2020
Printed: 9/1/2020

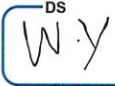

DCR #57 Diamondview Estates - Pinehurst

All



Drawing #: 1

DCR PHOENIX HOMES

B 24 - PINEHURST with LOFT
KITCHEN / VANITIES
MOUNTING HT: 84

- LINE -
HARDWARE -
STD WHITE INTERIORS
METAL DRAWER BOX
4 PCS - 5/8" KICK
2 PCS - LOOSE FILLER - 6 x 96
2 PCS - 90 DEG MOULD
1 PC - T MOULD

DV 57

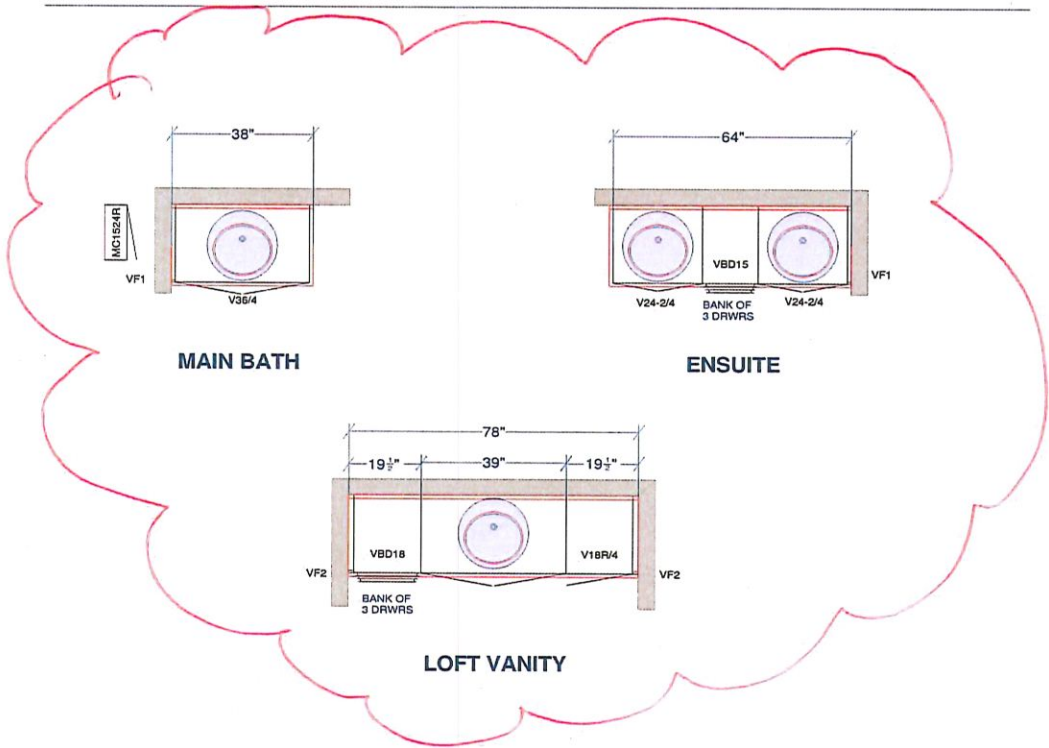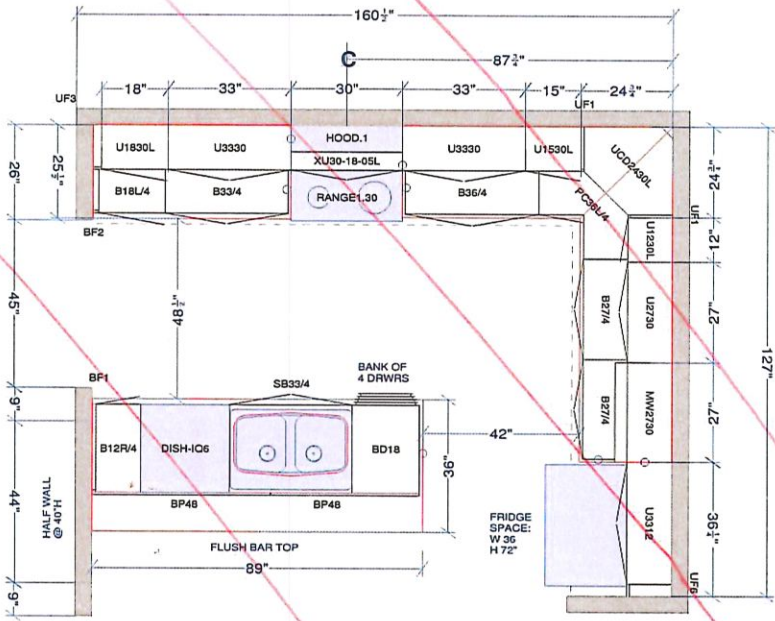

All dimensions size designations given are subject to verification on job site and adjustment to fit job conditions.



This is an original design and must not be released or copied unless applicable fee has been paid or job order placed.

Designed: 2018-03-27
Printed: 2018-03-27

DS
W.Y

Pinehurst with Loft.kit

All

Drawing #: 1 No Scale.