




Note: This drawing is an artistic interpretation of the general appearance of the design. It is not meant to be an exact rendition.

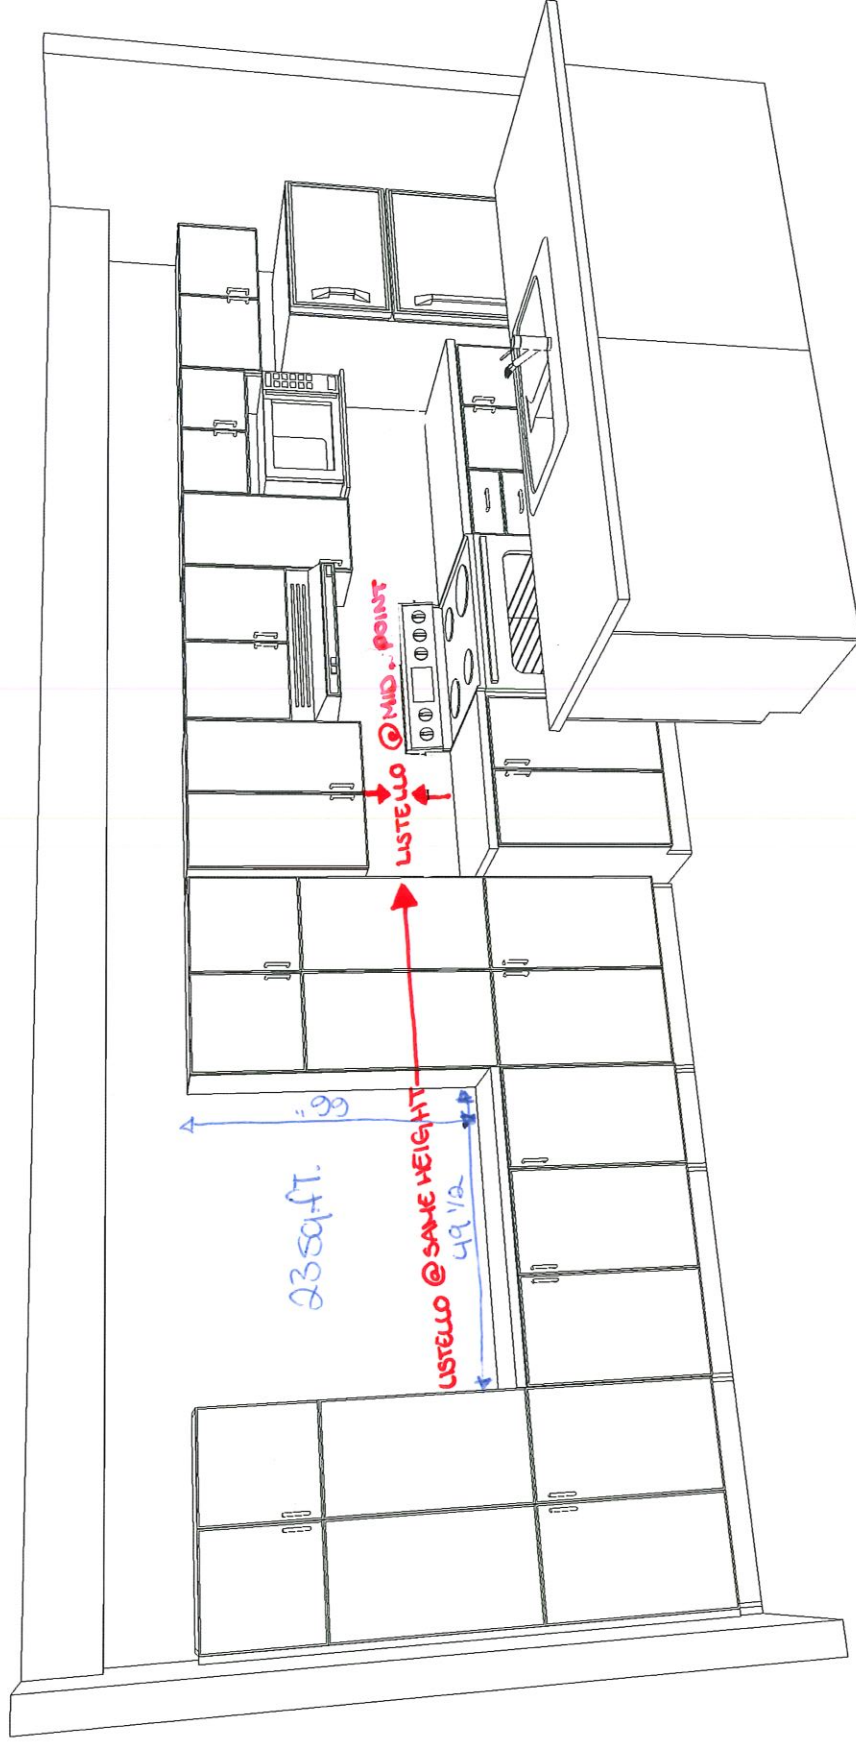

SPECTRUM KITCHEN and BATH DESIGN

DCR #9-105 PWYS TWNS - Stanwick KIT_VAN.kit All Drawing #: 1

Designed: 2020-09-15
Printed: 2020-09-15