

TF8 UNIT 330


DCR PHOENIX HOMES
TERRA FLATS

MODEL - TYPE E (UPPER FLOOR)

KITCHEN / VANITIES

MOUNTING HEIGHT - 84

- LINE 1
- HARDWARE - U1
 - STANDARD WHITE INTERIOR
 - METAL DRAWER BOX
 - 3 PCS - 5/8" KICK - FIN. BOTH ENDS
 - 2 PCS - LOOSE FILLER - 6 x 96
 - 2 PCS - 90 DEG. CORNER MOULD
 - 1 PCS - T-MOULDING
 - 4 PCS - FLAT MOULDING

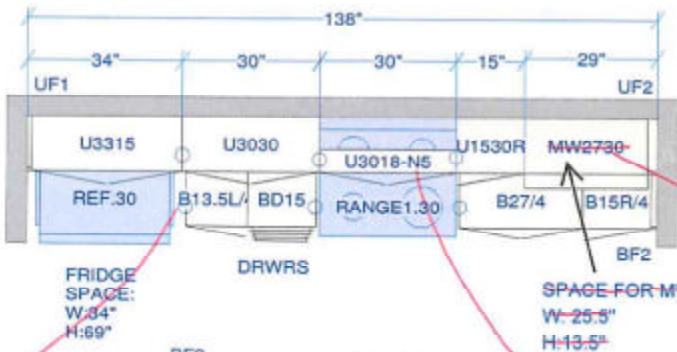


INSTALL
SIDE PANEL
BESIDE FRIDGE


DELETE STANDARD MC SPACE
AND REPLACE WITH 2 DOORS

INSTALL STANDARD HOODFAN
ACCOMMODATE CABINETRY FOR FUTURE
INSTALLATION OF OTR MICROWAVE

DS
JB

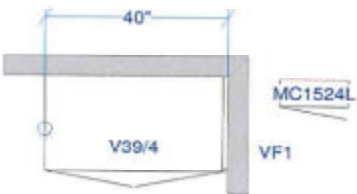

MAIN BATH

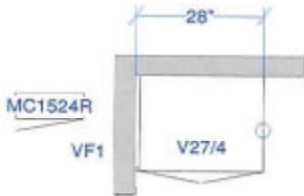

ENSUITE

All dimensions, size designations
given are subject to verification on
job site and adjustment to fit job
conditions.



This is an original design and must
not be released or copied unless
applicable fee has been paid or job
order placed.

Designed: 2017-04-04
Printed: 2017-04-07

TYPE E

All

Drawing #: 1 No Scale.