

DCR PHOENIX HOMES

LOT #26
WHITE TAIL RIDGE
MODEL - RUTHERFORD (517)
ALTERNATE KITCHEN
MOUNTING HEIGHT - 96

42"H UPPERS INSTALLED @
18" ABOVE COUNTER

- CABINETS-
HARDWARE -
STANDARD WHITE INTERIOR
STANDARD METAL DRAWER BOX
4 PCS - 5/8" KICK - FIN. BOTH ENDS
1 PCS - 90 DEG. CORNER MOULD
1 PCS - T-MOULD
5 PCS - FLAT MOULD


CUSTOMER APPROVAL

I have reviewed these drawings and understand the details of the design and the CARTIER KITCHENS specifications.

Signature _____

Date _____

LIGHT VALANCE

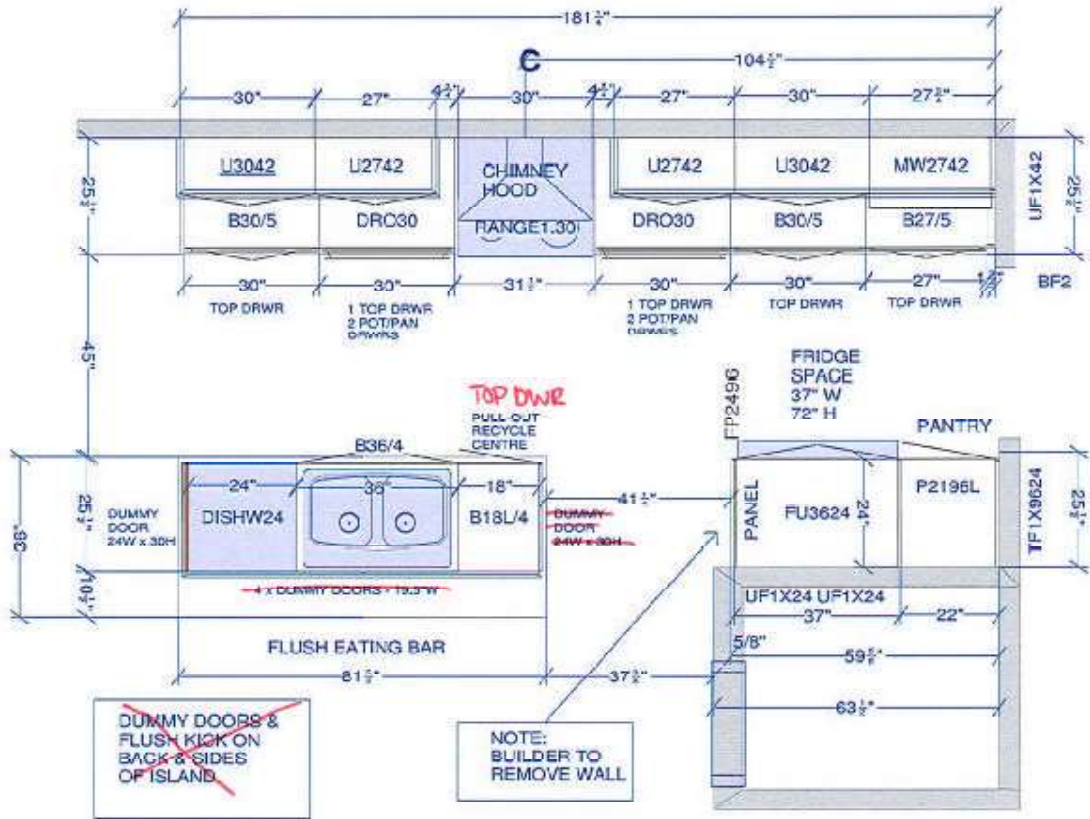

All dimensions, size designations given are subject to verification on job site and adjustment to fit job conditions.

SPECTRUM KITCHEN and BATH DESIGN



This is an original design and must not be released or copied unless applicable fee has been paid or job order placed.

DRAWN BY: LORI DISAVERIO, B.I.D.

Designed: 2020-12-10
Printed: 2020-12-10

DS
MJ

DCR #26 White Tail Ridge - Rutherford ALT Kitchen.kit

All



Drawing #: 1 No Scale.

DS


MJ

DS

MJ

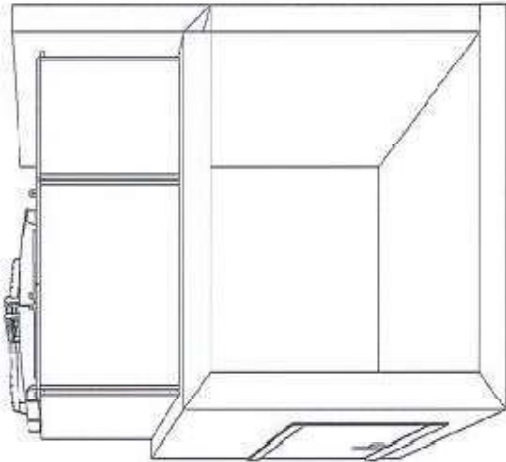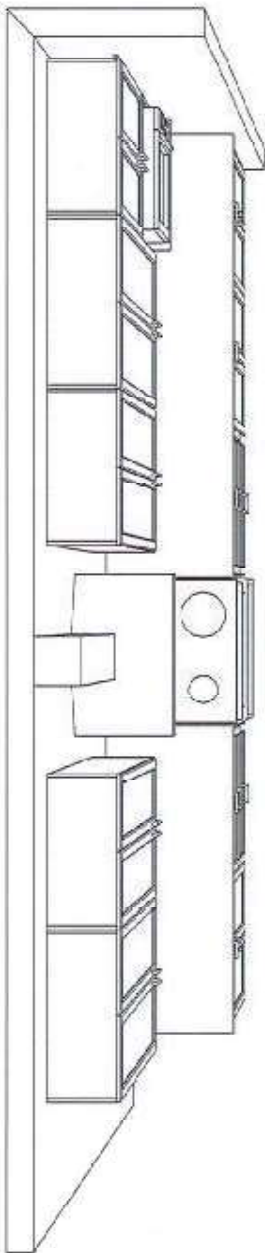

Note: This drawing is an artistic interpretation of the general appearance of the design. It is not meant to be an exact rendition. SPECTRUM KITCHEN and BATH DESIGN DCR #26 White Tail Ridge - Rutherford ALT		Designed: 2020-12-10 Printed: 2020-12-10	
		All	Drawing #: 1

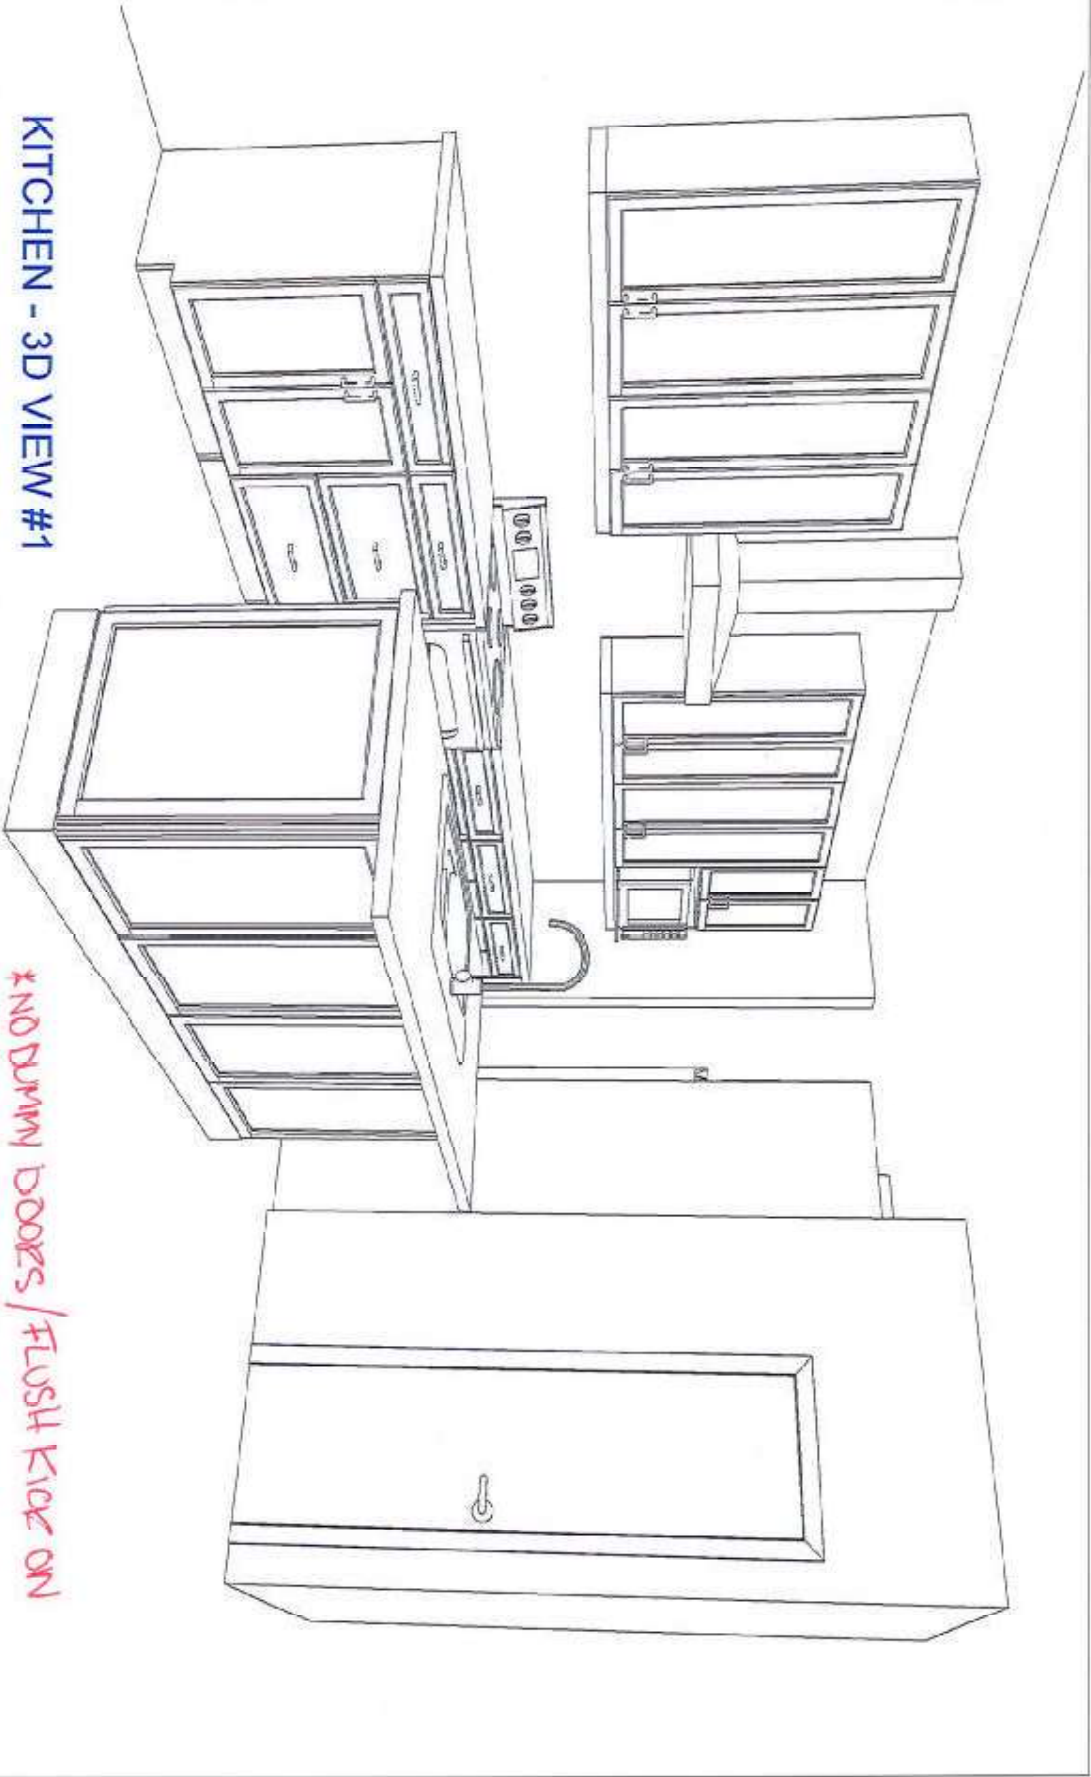

KITCHEN - 3D VIEW #1

CUSTOMER APPROVAL

I have reviewed these drawings and understand the details of the design and the CARTER KITCHENS specifications.

Signature _____

Date _____

NO DUMMY DOORS / FLUSH KICK ON ISLAND

Note: This drawing is an artistic interpretation of the general appearance of the design. It is not meant to be an exact rendition.

SPECTRUM KITCHEN and BATH DESIGN



Designed: 2020-12-10
Printed: 2020-12-10


DCR #26 White Tail Ridge - Rutherford ALT

ALL

Drawing #: 1

DS
MJ

DS
MJ

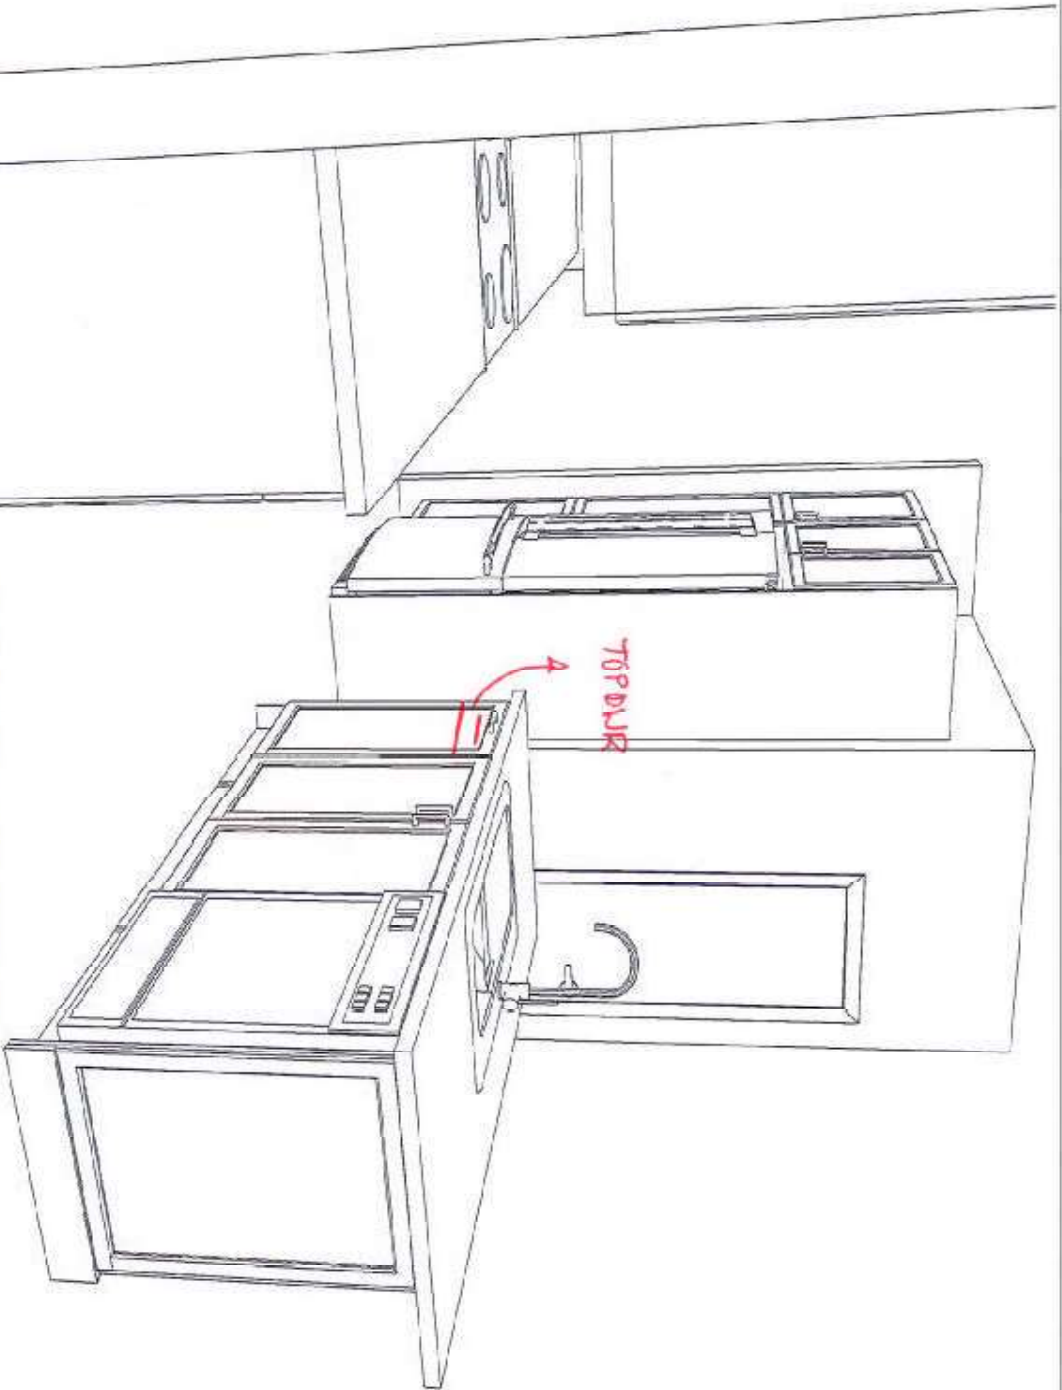

KITCHEN - 3D VIEW #2

I have reviewed these drawings and understand the details of the design and the CARTIER KITCHENS specifications.

Signature _____

Date _____

CUSTOMER APPROVAL

Note: This drawing is an artistic interpretation of the general appearance of the design. It is not meant to be an exact rendition.

SPECTRUM KITCHEN and BATH DESIGN

DCR #26 White Tail Ridge - Rutherford ALT



Designed: 2020-12-10
Printed: 2020-12-10

All

Drawing #: 1

DS
MJ

DS
MJ


KITCHEN - 3D VIEW #3

CUSTOMER APPROVAL

I have reviewed these drawings and understand the details of the design and the CARTIER KITCHENS specifications.

Signature _____

Date _____

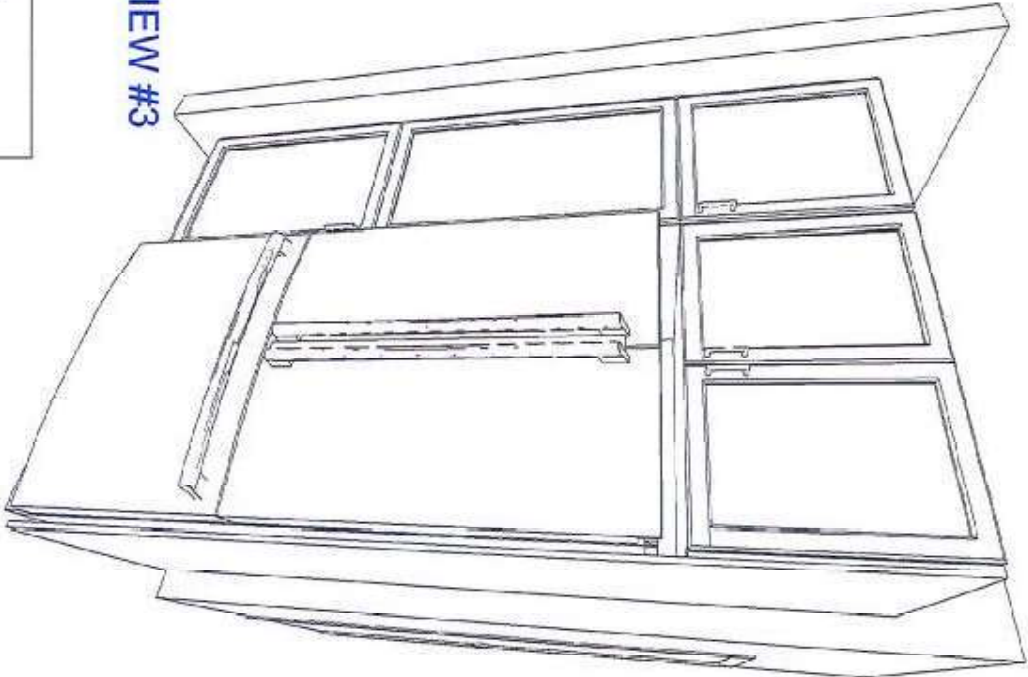

Note: This drawing is an artistic interpretation of the general appearance of the design. It is not meant to be an exact rendition.

SPECTRUM KITCHEN and BATH DESIGN



DCR #26 White Tail Ridge - Rutherford ALT


All

Drawing #: 1

Designed: 2020-12-10
Printed: 2020-12-10

DS
MJ

DS
MJ

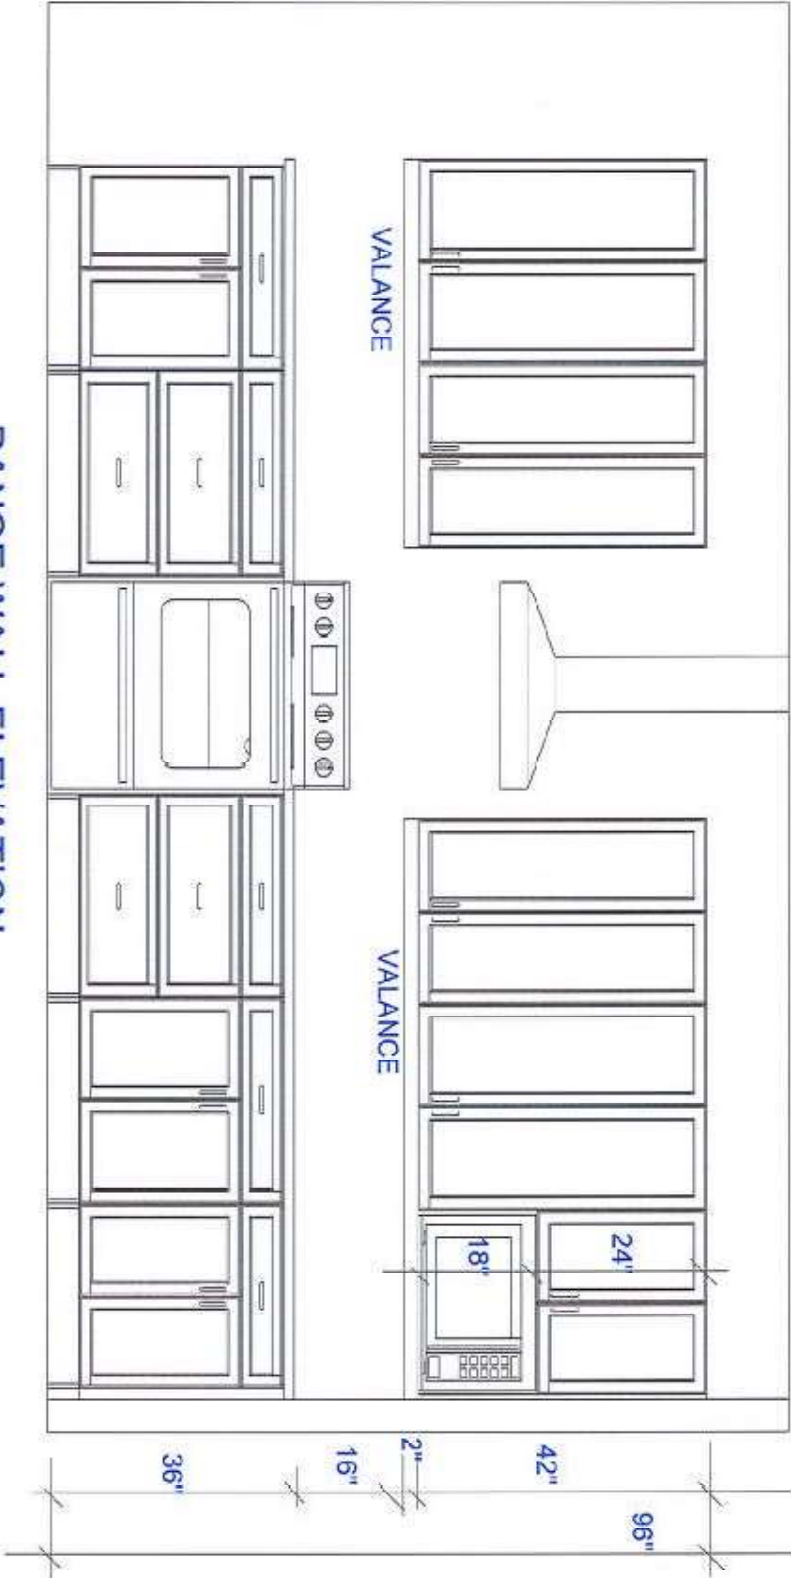

RANGE WALL ELEVATION

CUSTOMER APPROVAL

I have reviewed these drawings and understand the details of the design and the CARTIER KITCHENS specifications.

Signature _____

Date _____

Note: This drawing is an artistic interpretation of the general appearance of the design. It is not meant to be an exact rendition.

SPECTRUM KITCHEN and BATH DESIGN



Designed: 2020-12-10
Printed: 2020-12-10


DCR #26 White Tail Ridge - Rutherford ALT

All

Drawing #: 1

DS
MJ

DS
MJ

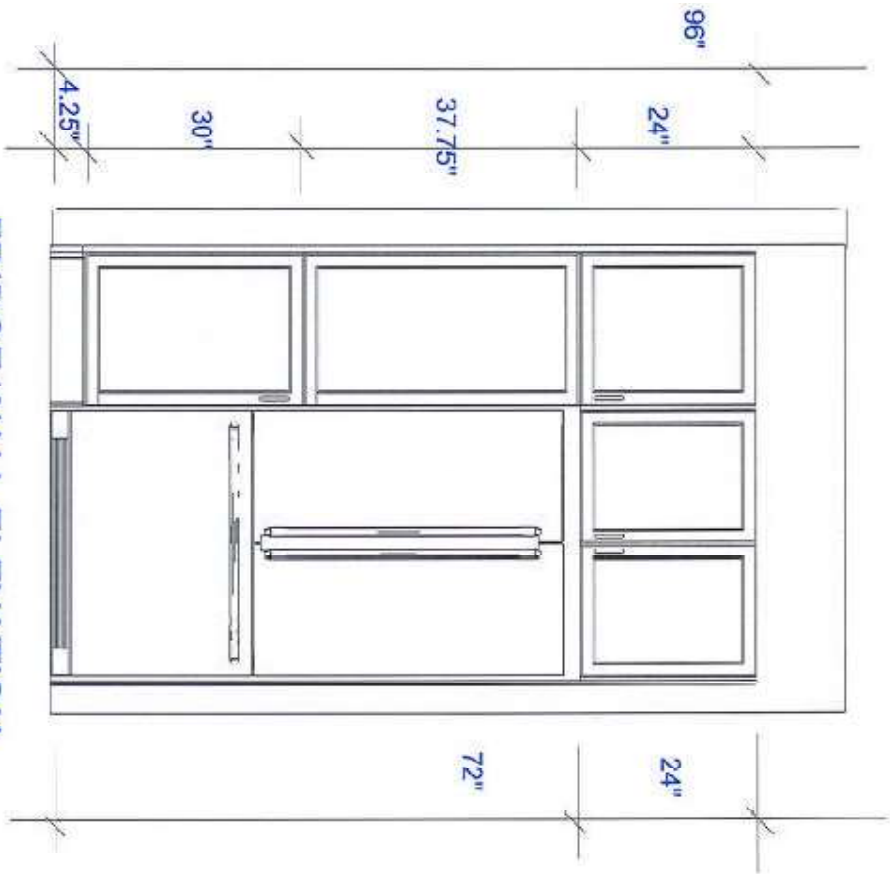

FRIDGE WALL ELEVATION

DS
MJ

CUSTOMER APPROVAL

I have reviewed these drawings and understand the details of the design and the CARTIER KITCHENS specifications.

Signature _____

Date _____

Note: This drawing is an artistic interpretation of the general appearance of the design. It is not meant to be an exact rendition.

SPECTRUM KITCHEN and BATH DESIGN



Designed: 2020-12-10
Printed: 2020-12-10

DCR #26 White Tail Ridge - Rutherford ALT

All

Drawing #: 1


DCR PHOENIX HOMES

MODEL - RUTHERFORD (517)


STANDARD VANITIES

MOUNTING HEIGHT - 84


- LINE -
- HARDWARE -
- STANDARD WHITE INTERIOR
- METAL DRAWER BOX
- 4 PCS - 5/8" KICK - FIN. BOTH ENDS
- 5 PCS - FLAT SHOE MOULD

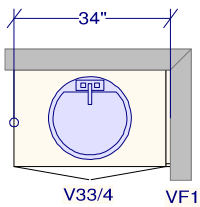


POWDER ROOM

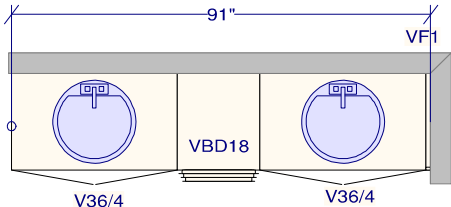


ENSUITE 1

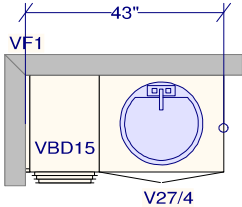

ENSUITE 2

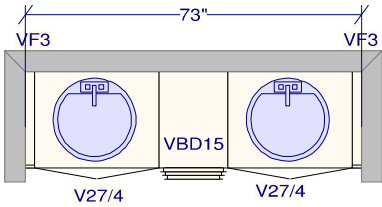


ENSUITE 3

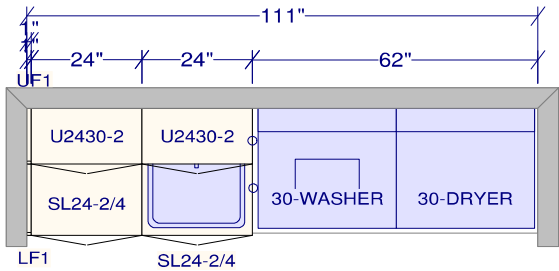

LAUNDRY ROOM

All dimensions _size designations given are subject to verification on job site and adjustment to fit job conditions.		Spectrum Kitchen _Bath Design 430 Hazeldean Rd. Unit 2 P:613-521-6966 F:613 521-1617 Drawn by: Mirian	Designed: 4/19/2016 Printed: 4/19/2016		
			DS MJ DS MJ		
517 Rutherford STD Vanities + Laundry			All	Drawing #: 1	No Scale.

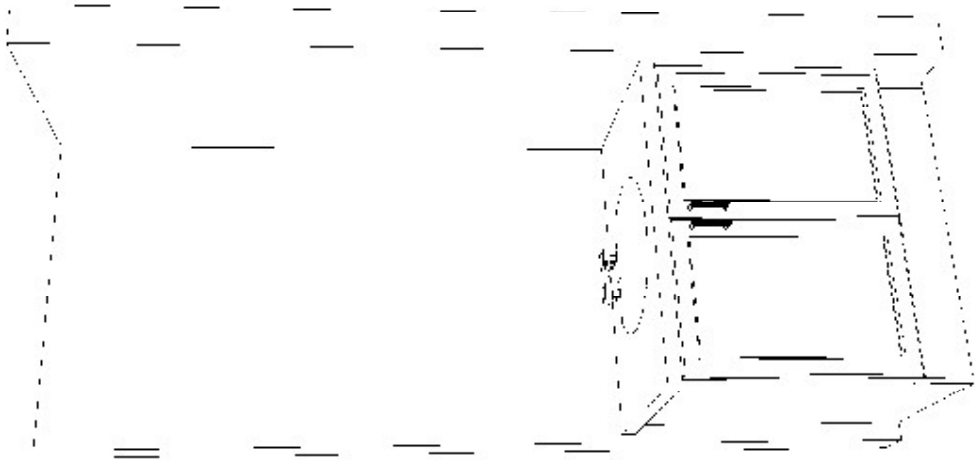

DCR PHOENIX 517 RUTHERFORD
POWDER ROOM

Note: This drawing is an artistic interpretation of the general appearance of the design. It is not meant to be an exact rendition.



Designed: 4/19/2016
Printed: 4/19/2016

All

517 Rutherford STD Vanities + Laundry

Drawing #: 1

DS
MJ


DS
MJ

DS

MJ


DS

MJ

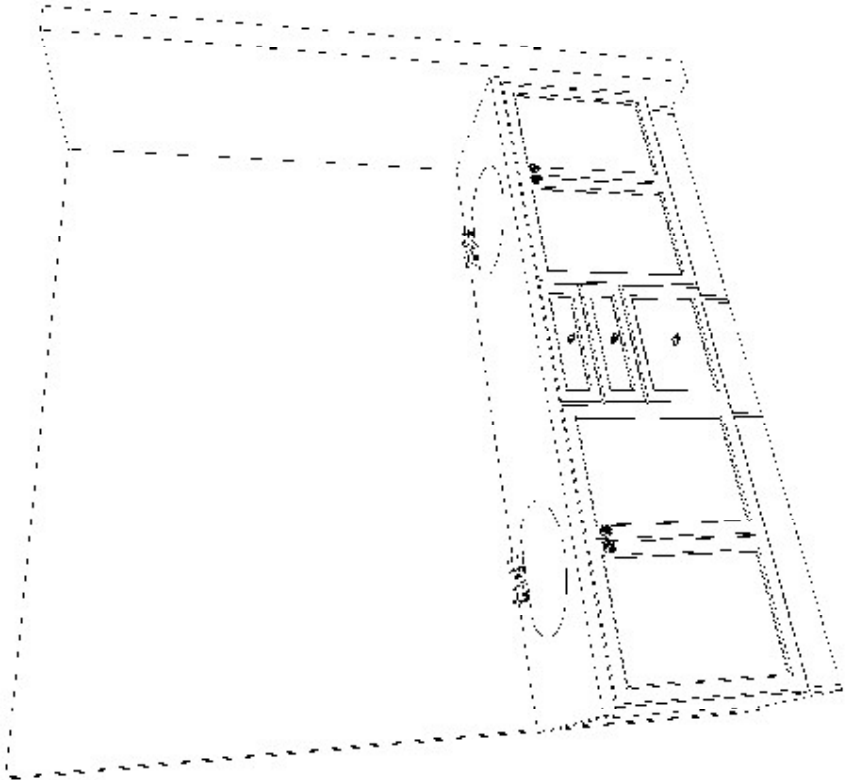

DCR PHEONIX - 517 RUTHERFORD STD
ENSUITE #1

Note: This drawing is an artistic interpretation of the general appearance of the design. It is not meant to be an exact rendition.	 	Designed: 4/19/2016 Printed: 4/19/2016	
		517 Rutherford STD Vanities + Laundry	
		All	Drawing #: 1

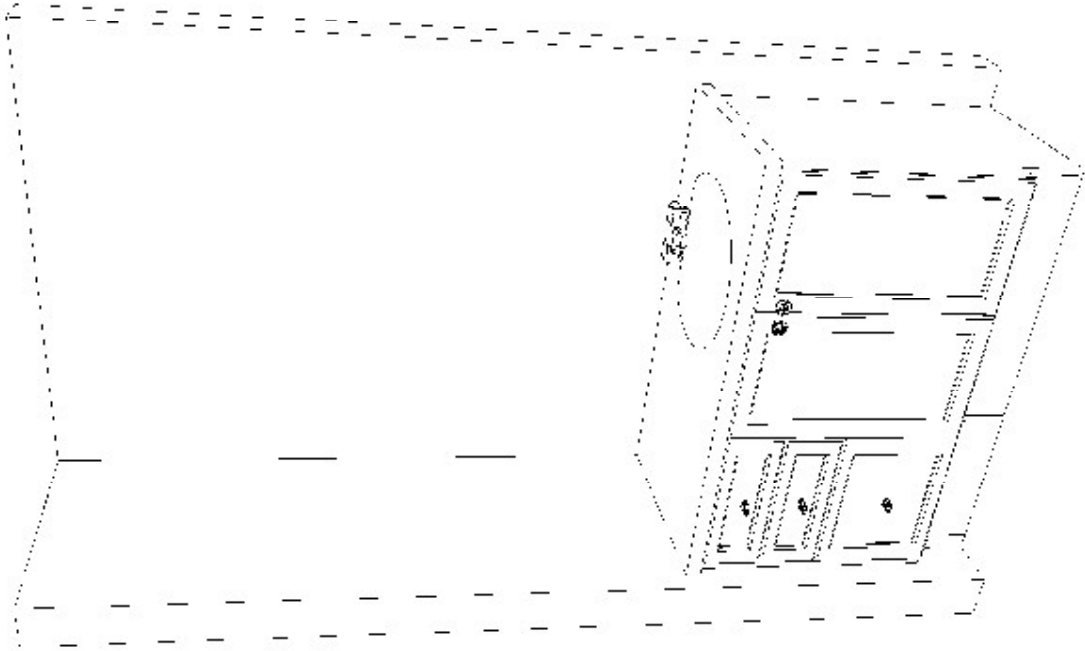

DCR PHOENIX 517 RUTHERFORD STD
ENSUITE #2

Note: This drawing is an artistic interpretation of the general appearance of the design. It is not meant to be an exact rendition.



Designed: 4/20/2016
Printed: 4/20/2016


517 Rutherford STD Vanities + Laundry

All

Drawing #: 1

DS
MJ

DS
MJ

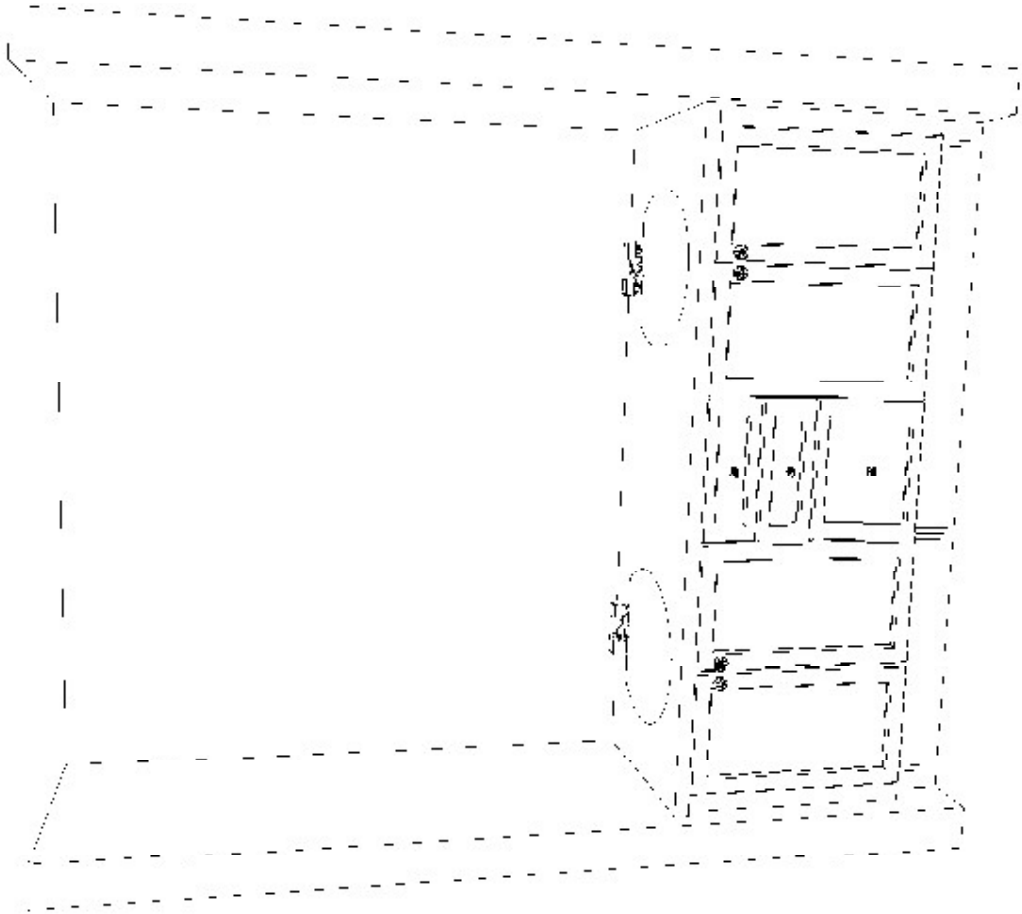

DCR PHOENIX 517 RUTHERFORD STD
ENSUITE #3

Note: This drawing is an artistic interpretation of the general appearance of the design. It is not meant to be an exact rendition.




Designed: 4/19/2016
Printed: 4/19/2016

517 Rutherford STD Vanities + Laundry

All

Drawing #: 1

DS MJ DS MJ

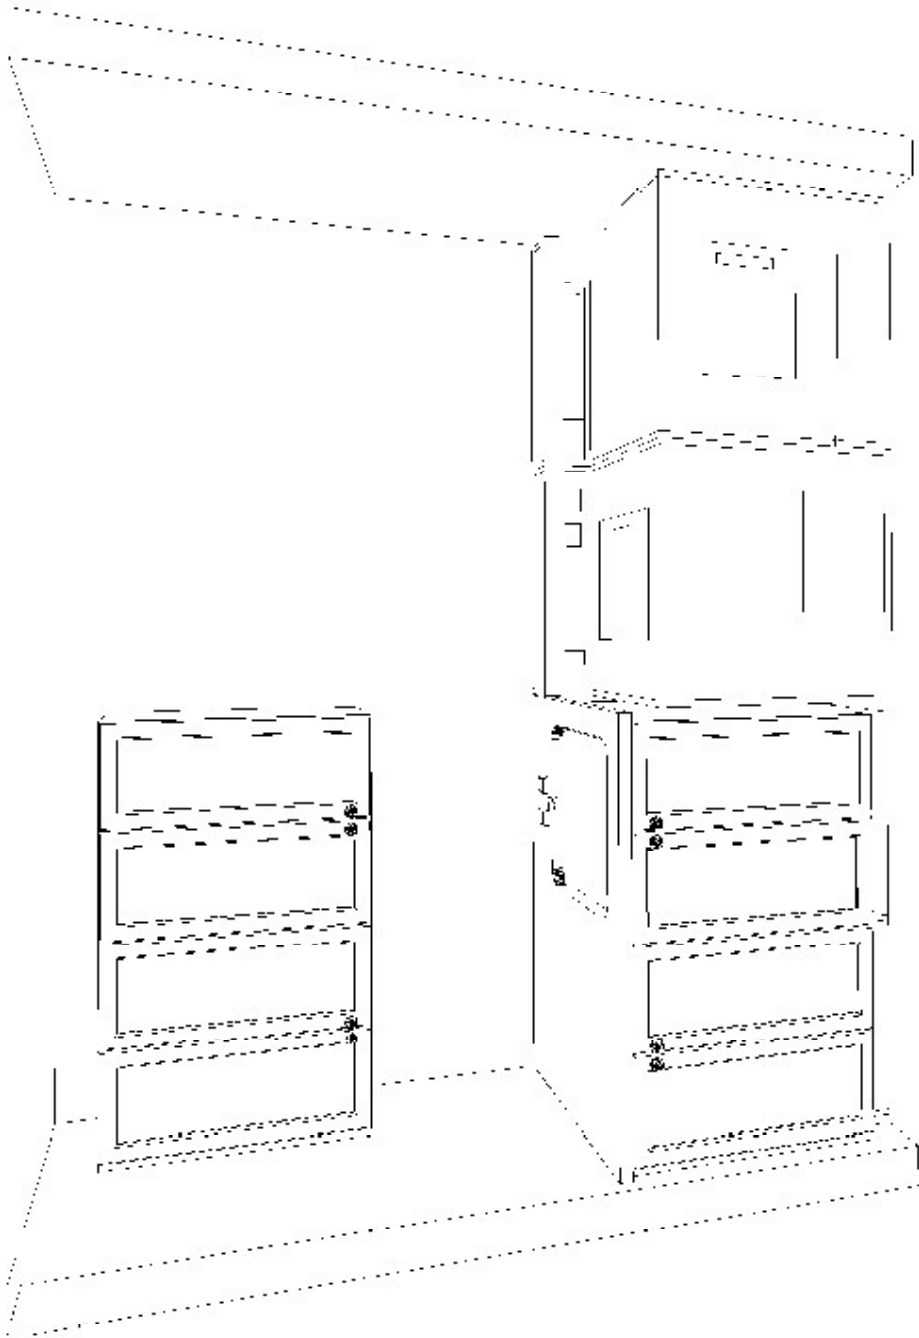

DCR PHOENIX 517 RUTHERFORD STD
LAUNDRY ROOM

Note: This drawing is an artistic interpretation of the general appearance of the design. It is not meant to be an exact rendition.



Designed: 4/19/2016
Printed: 4/19/2016

517 Rutherford STD Vanities + Laundry

All

Drawing #: 1

