

DCR PHOENIX HOMES

LOT #160

PATHWAYS

C10 - ROSEMERE (RIGHT)

VANITIES


CABINETS -

HARDWARE -


KICK: 1-PCS.

STANDARD WHITE INTERIOR


METAL DRWR BOXES

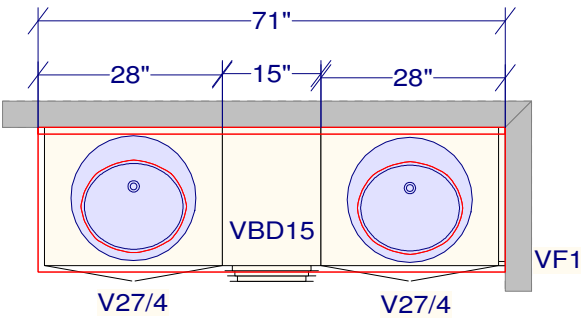

ENSUITE

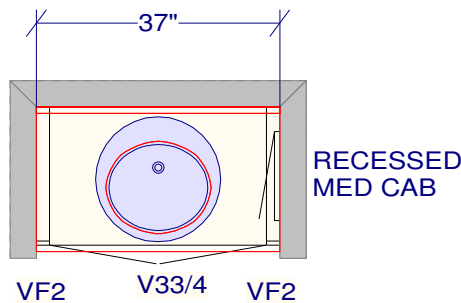

MAIN

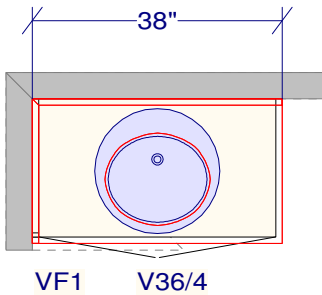

POWDER

NOTE; VANITY INCREASED BY 6"
& 2ND SINK ADDED

CUSTOMER APPROVAL

I have reviewed these drawings and understand the details of the design
and the CARTIER KITCHENS specifications.

Signature _____

Date _____

All dimensions & size designations
given are subject to verification on
job site and adjustment to fit job
conditions.

SPECTRUM KITCHEN and BATH
DESIGN



This is an original design and must
not be released or copied unless
applicable fee has been paid or job
order placed.

DRAWN BY: LORI DISAVERIO, B.I.D

Designed: 2020-11-29
Printed: 2020-11-29