

DCR PHOENIX HOMES

LOT #160

PATHWAYS

MODEL: C10 - ROSEMERE

CHEF'S KITCHEN

MOUNTING HT:96

**42"H UPPERS @
18" ABOVE COUNTER**

~~CROWN MOULDING~~

CABINETS -

HARDWARE -

STANDARD WHITE INTERIOR

STANDARD HINGES


STD METAL DRAWERS

1 - PC. 90 DEG. CORNER MOULD.

2 - PCS. T-MOULD

5/8" OE KICK

FLAT SHOE MOULDING

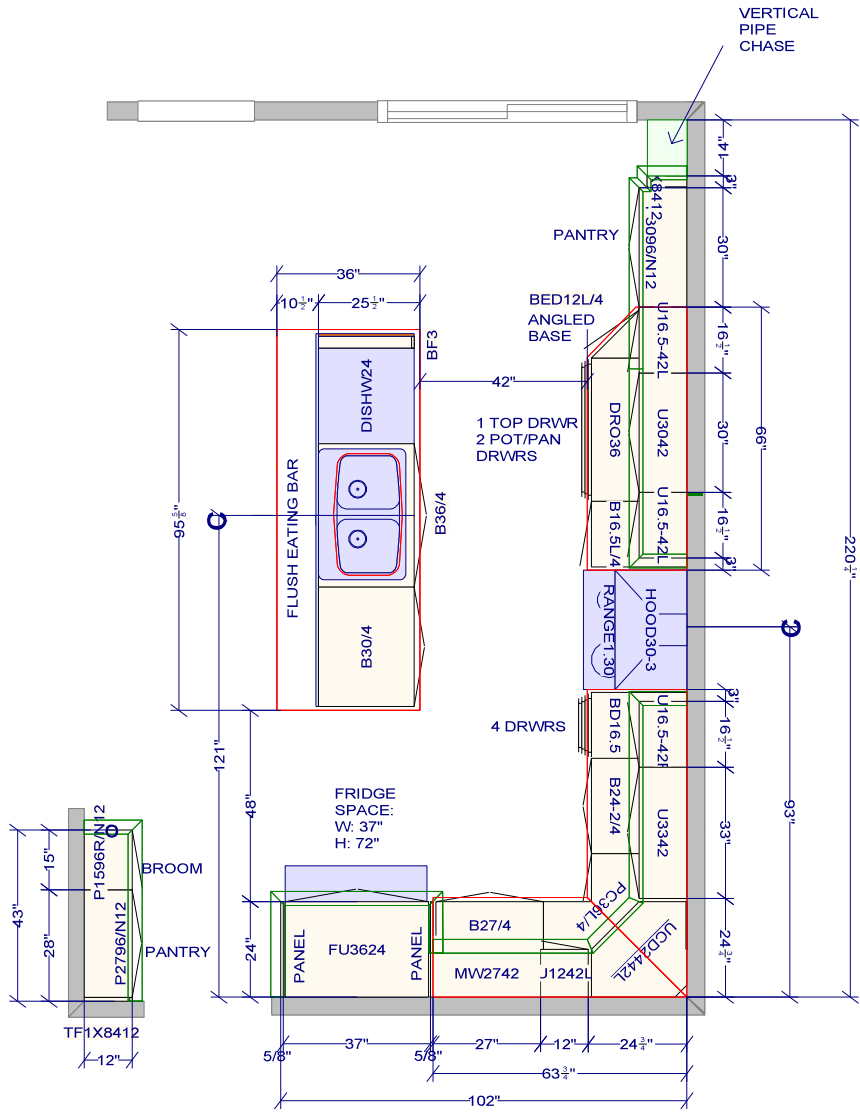

CUSTOMER APPROVAL

I have reviewed these drawings and understand the details of the design and the Cartier Kitchens specifications

Signature _____

Date _____

Date _____

All dimensions _size designations given are subject to verification on job site and adjustment to fit job conditions.



This is an original design and must not be released or copied unless applicable fee has been paid or job order placed.


Designed: 11/29/2020
Printed: 11/30/2020

DS
R D

DCR #160 Pathways -ROSEMERE - CHEF'S KITCHEN

A11

Drawing #: 1	No Scale.
--------------	-----------

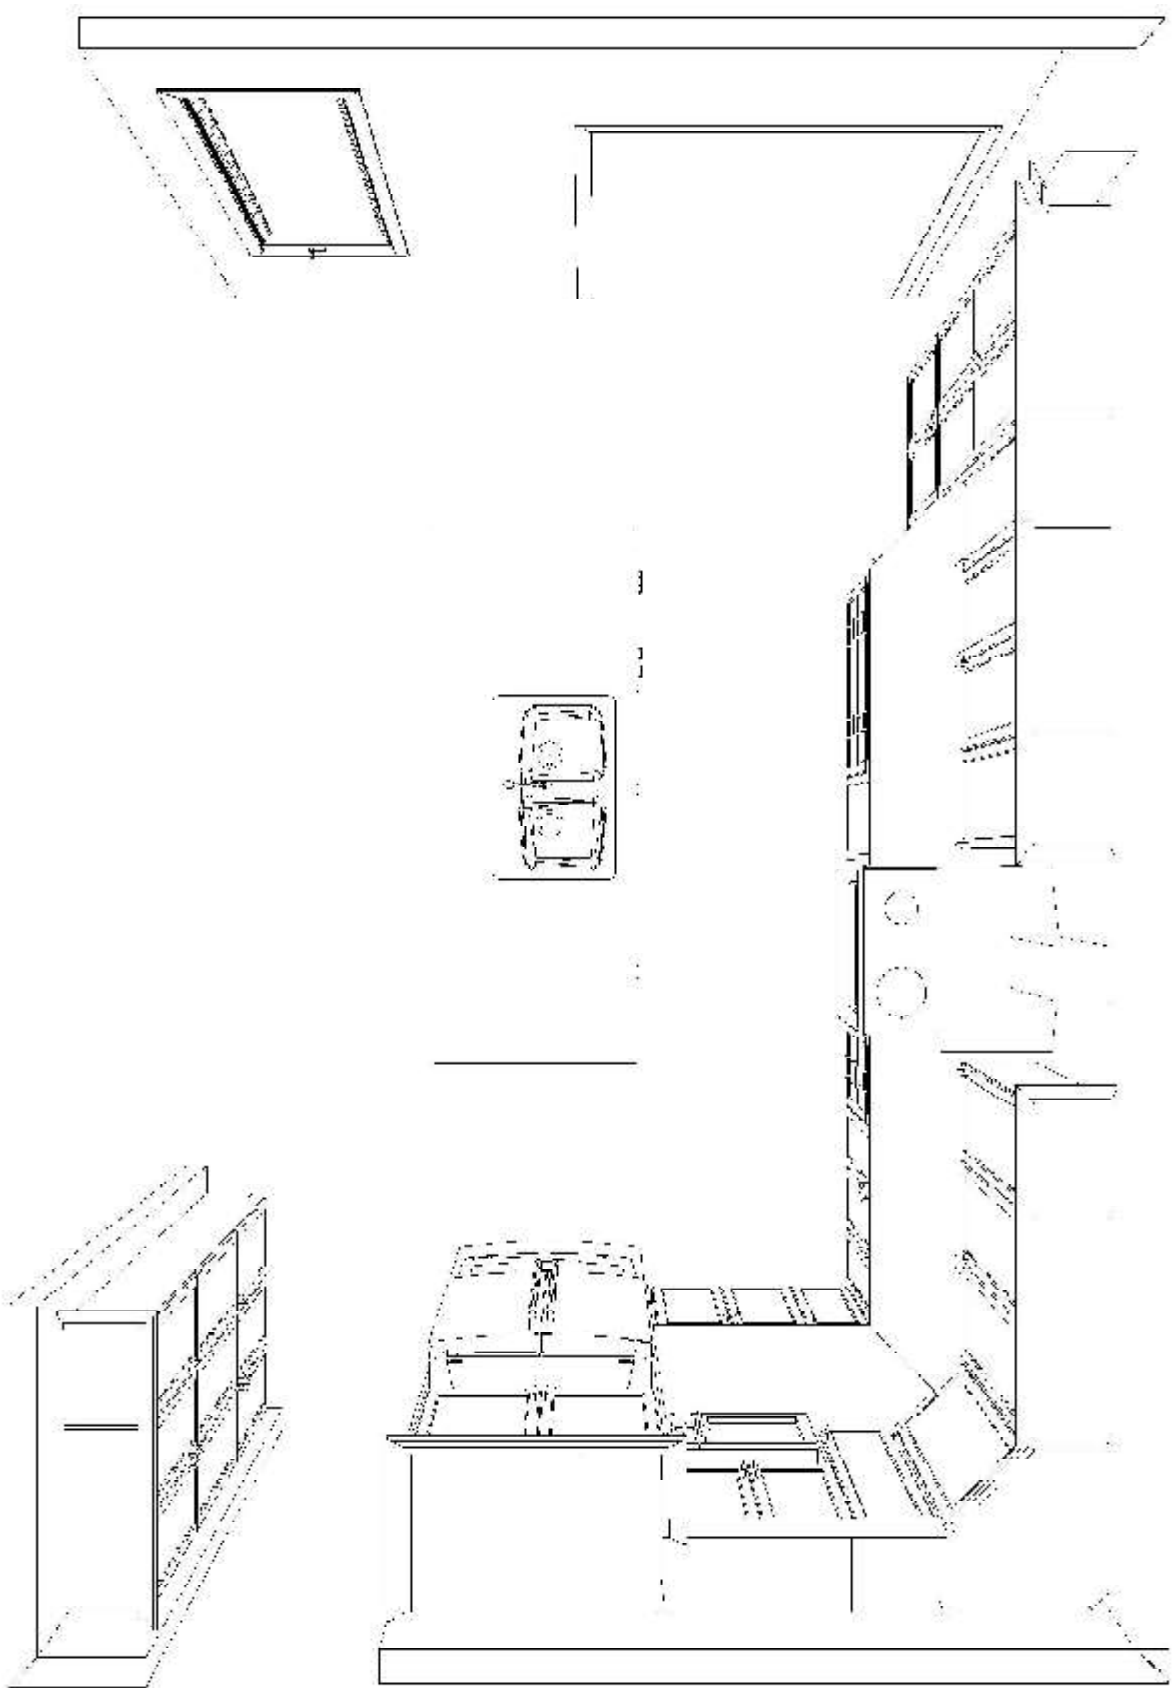

KITCHEN - TOP VIEW

Note: This drawing is an artistic interpretation of the general appearance of the design. It is not meant to be an exact rendition.



Designed: 11/29/2020
Printed: 11/30/2020

DS
R.D.

DCR #160 Pathways -ROSEMERE - CHEF'S


All

Drawing #: 1

CUSTOMER APPROVAL

I have reviewed these drawings and understand the details of the design and the Cartier Kitchens specifications

Signature _____
Date _____

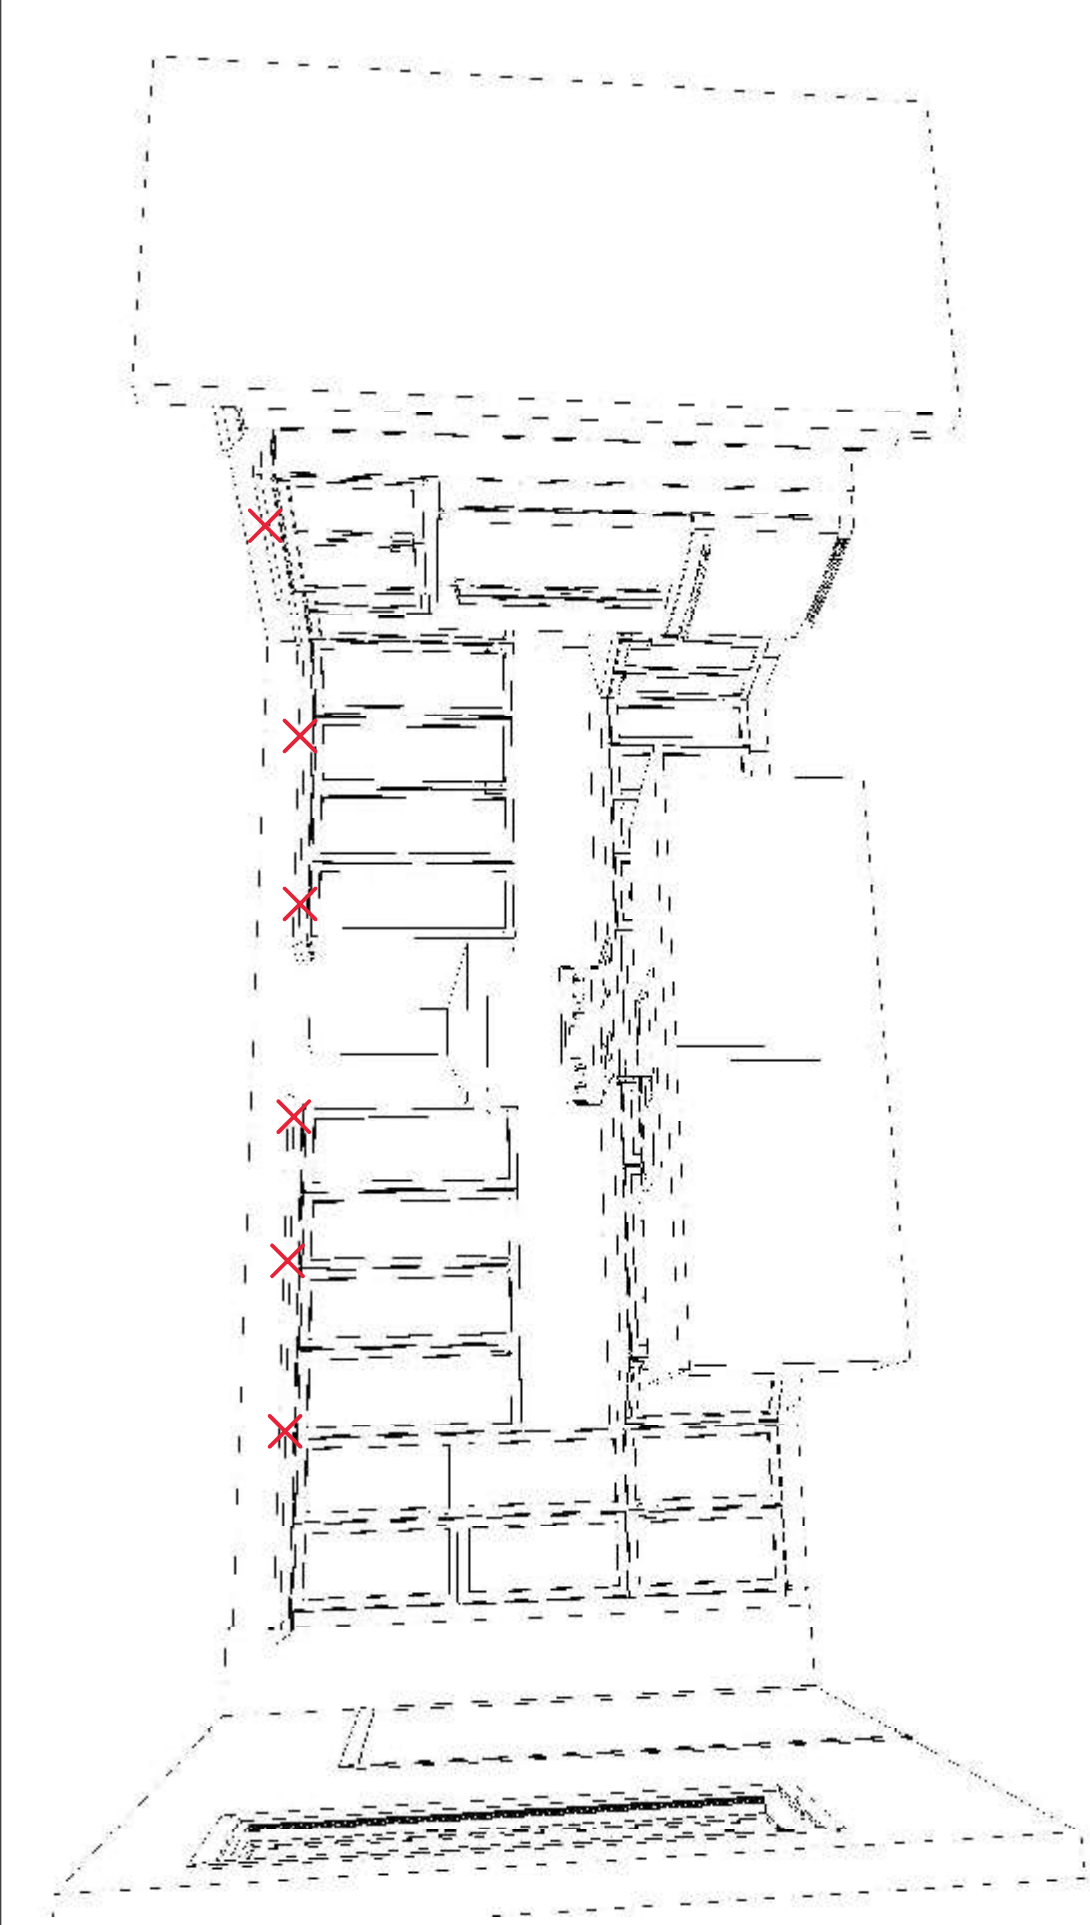


KITCHEN - 3D VIEW #1


Note: This drawing is an artistic interpretation of the general appearance of the design. It is not meant to be an exact rendition.		Designed: 11/29/2020 Printed: 11/30/2020	
		DCR #160 Pathways - ROSEMERIE - CHEF'S	Drawing #: 1

CUSTOMER APPROVAL

I have reviewed these drawings and understand the details of the design and the Cartier Kitchens specifications

Signature _____
Date _____

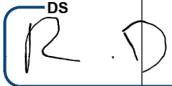DS

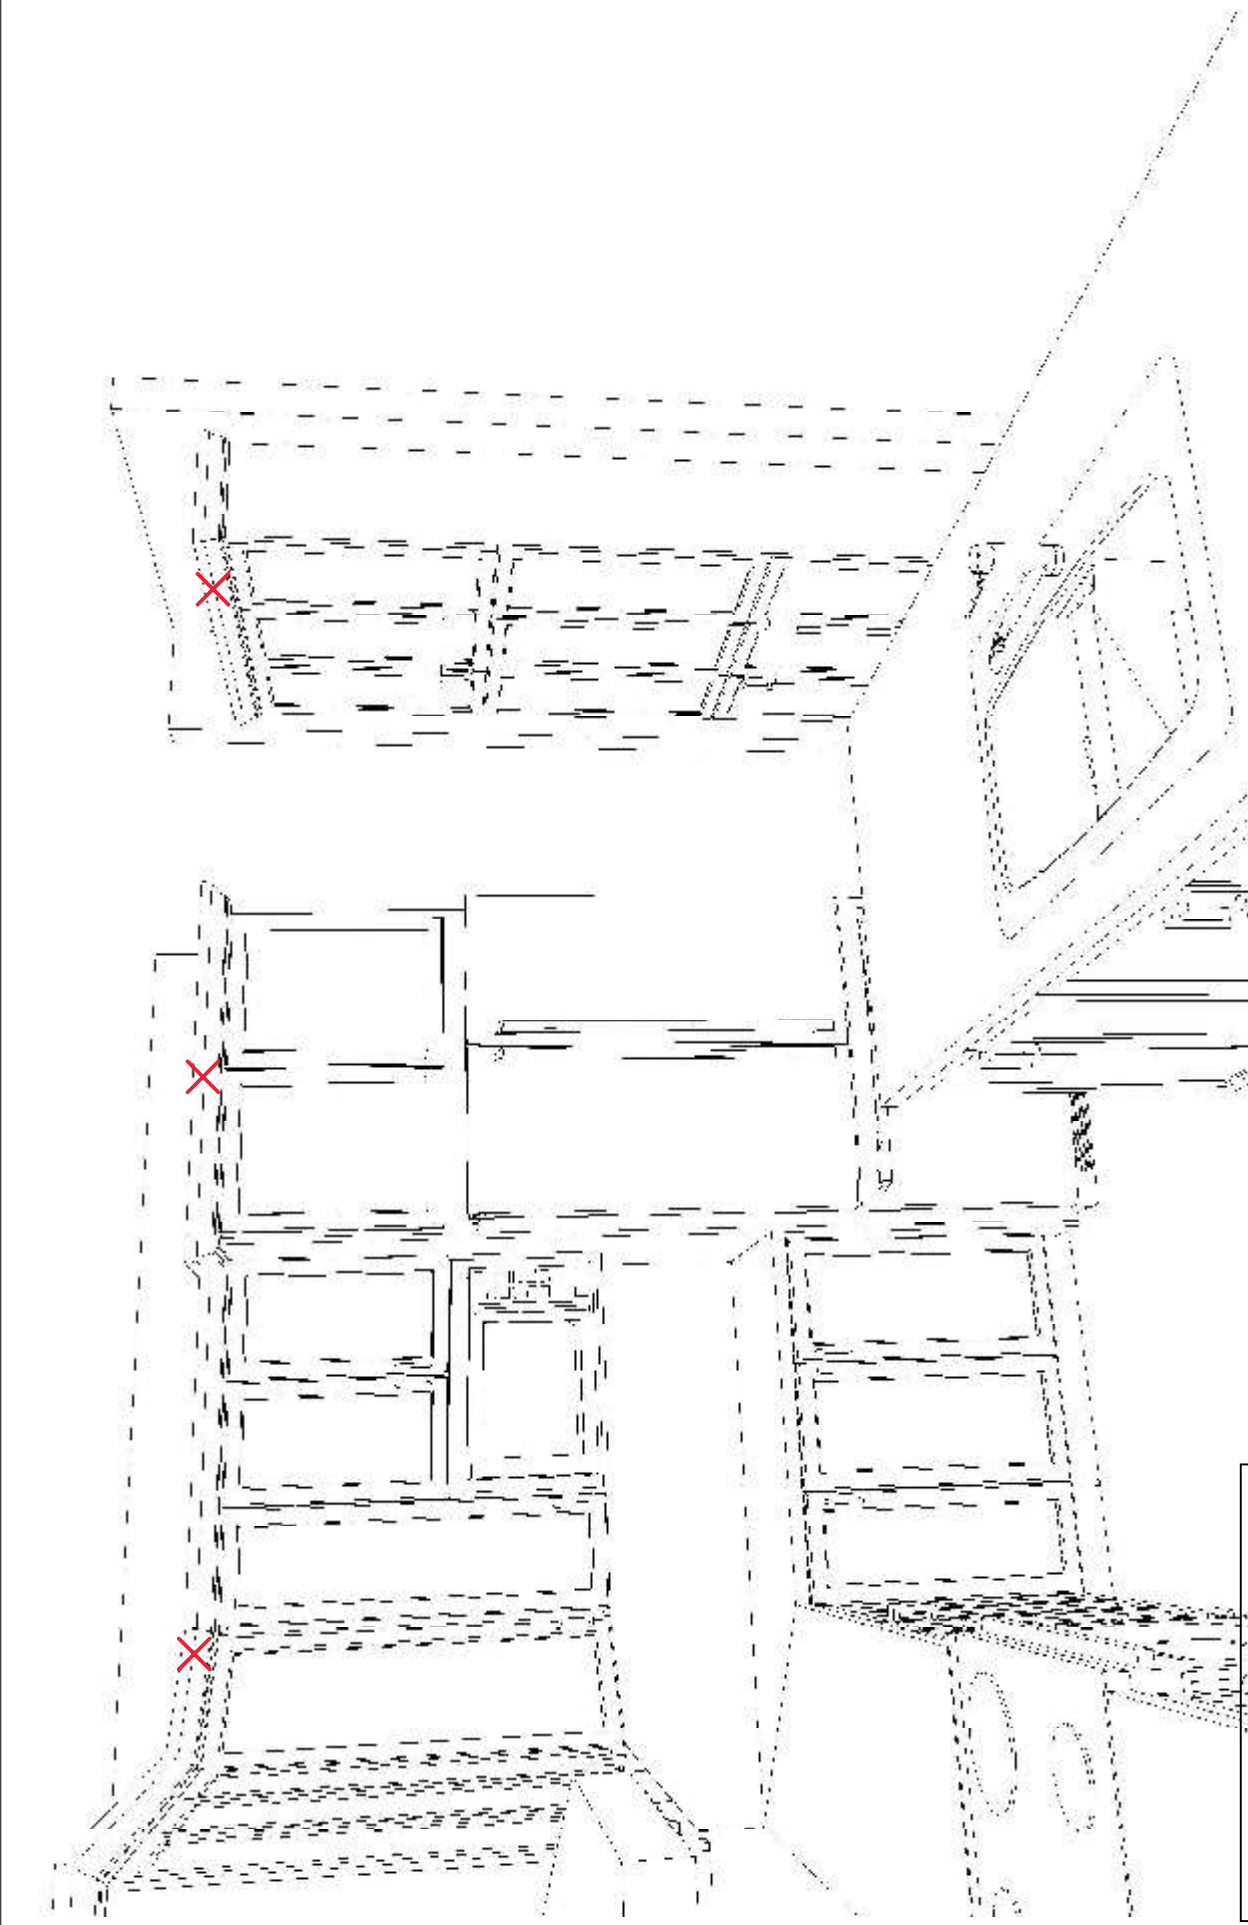


KITCHEN - 3D VIEW #2

Note: This drawing is an artistic interpretation of the general appearance of the design. It is not meant to be an exact rendition.		Designed: 11/29/2020 Printed: 11/30/2020	
		DCR #160 Pathways - ROSEMERE - CHEF'S	Drawing #: 1

CUSTOMER APPROVAL


I have reviewed these drawings and understand the details of the design and the Cartier Kitchens specifications

Signature _____

Date _____


DS

R.D.

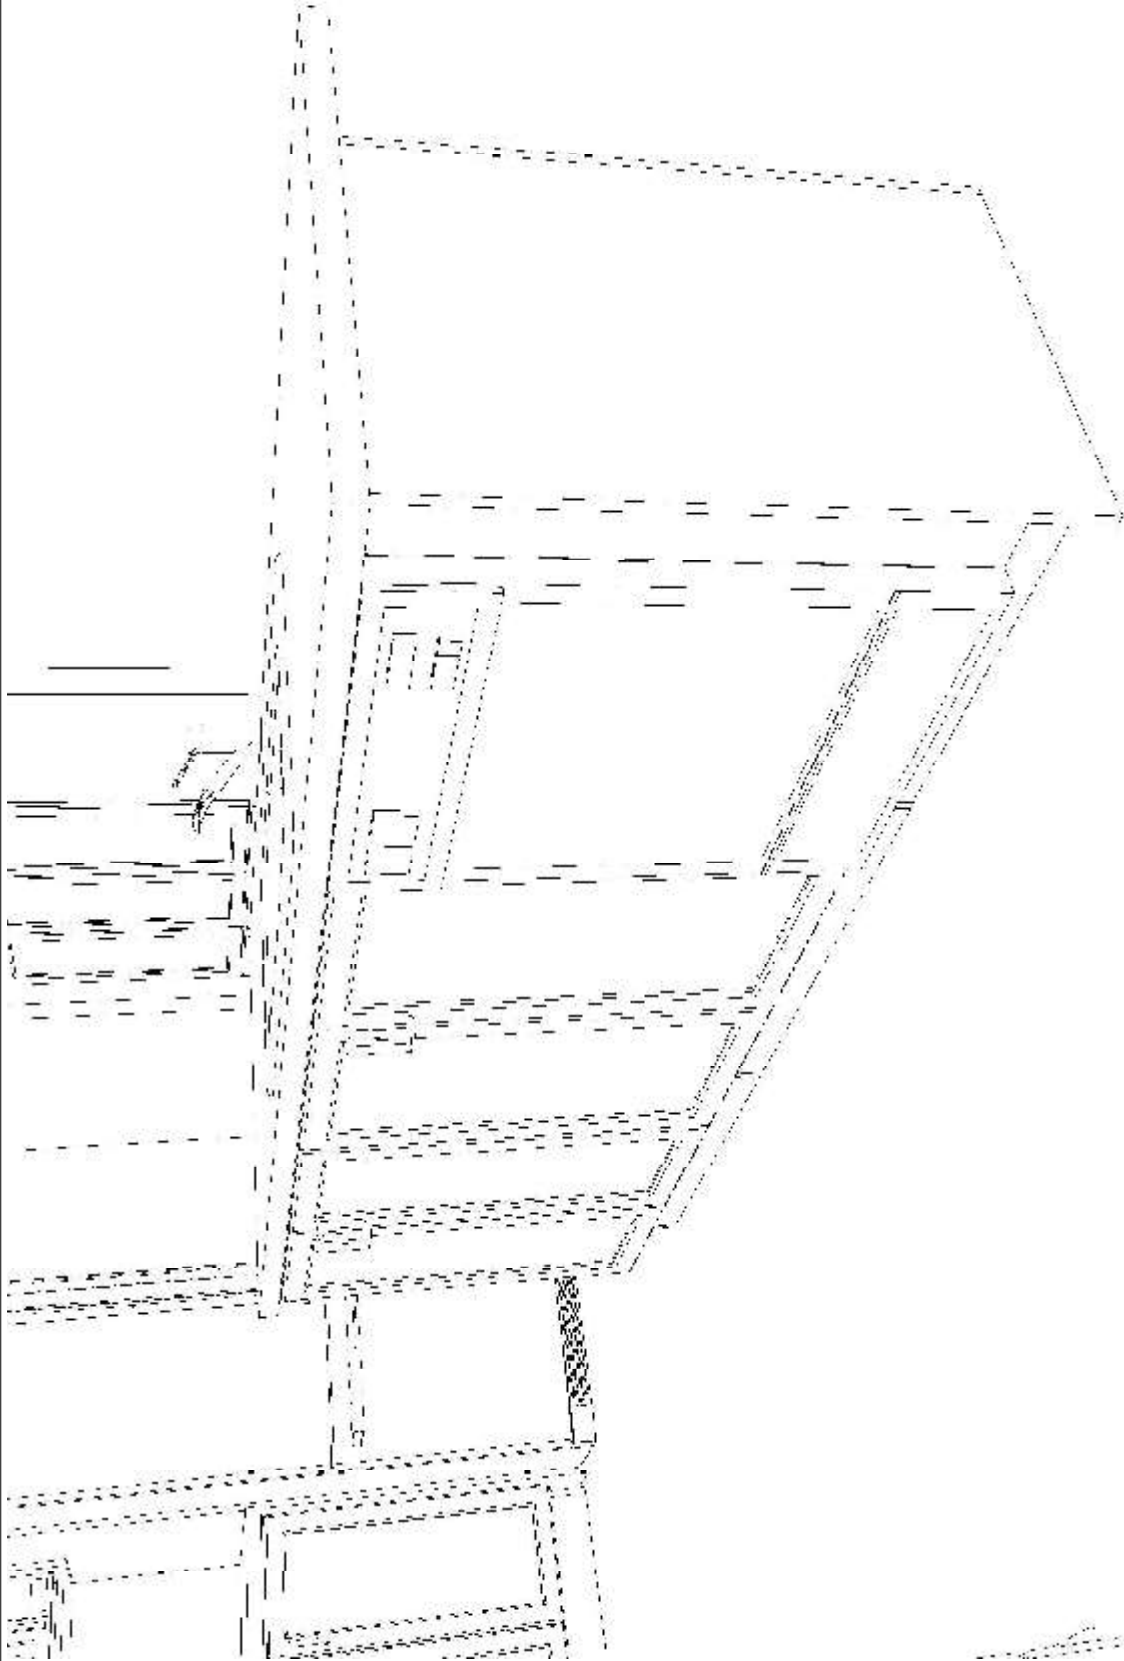

KITCHEN - 3D VIEW #3

Note: This drawing is an artistic interpretation of the general appearance of the design. It is not meant to be an exact rendition.		Designed: 11/29/2020 Printed: 11/30/2020	
		DCR #160 Pathways - ROSEMERIE - CHEF'S	Drawing #: 1

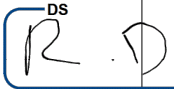
 DS

CUSTOMER APPROVAL

I have reviewed these drawings and understand the details of the design and the Cartier Kitchens specifications

Signature _____


Date _____

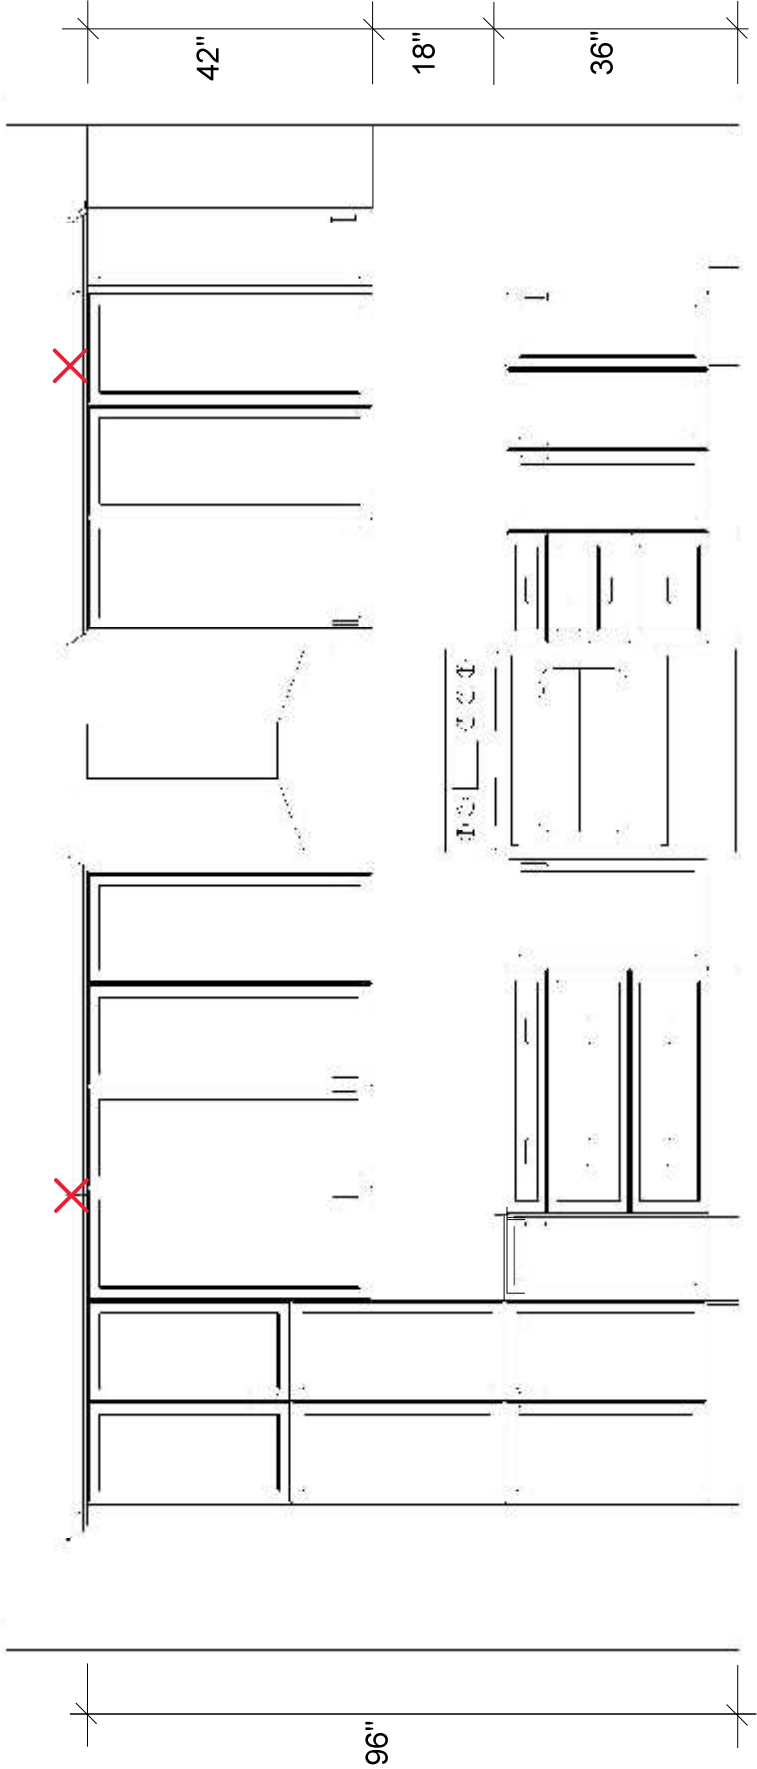

RANGE WALL ELEVATION


CUSTOMER APPROVAL I have reviewed these drawings and understand the details of the design and the Cartier Kitchens specifications Signature _____ Date _____		Designed: 11/29/2020 Printed: 11/30/2020	
		DCR #160 Pathways - ROSEMERIE - CHEF'S	Drawing #: 1

DS
R.D.

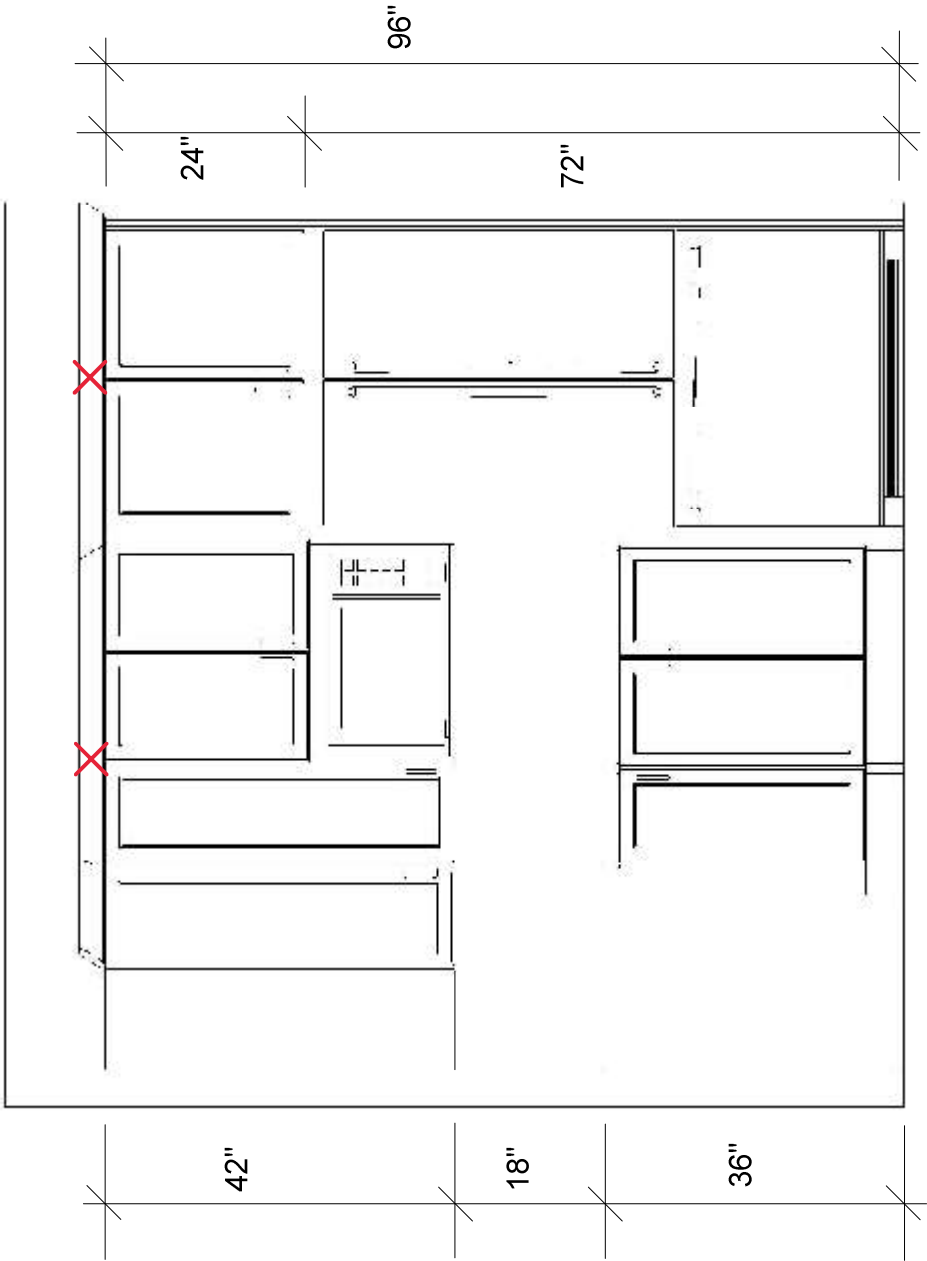

FRIDGE WALL ELEVATION

CUSTOMER APPROVAL I have reviewed these drawings and understand the details of the design and the Cartier Kitchens specifications Signature _____ Date _____		Designed: 11/29/2020 Printed: 11/30/2020	
		DCR #160 Pathways - ROSEMERE - CHEF'S	All
		Drawing #: 1	

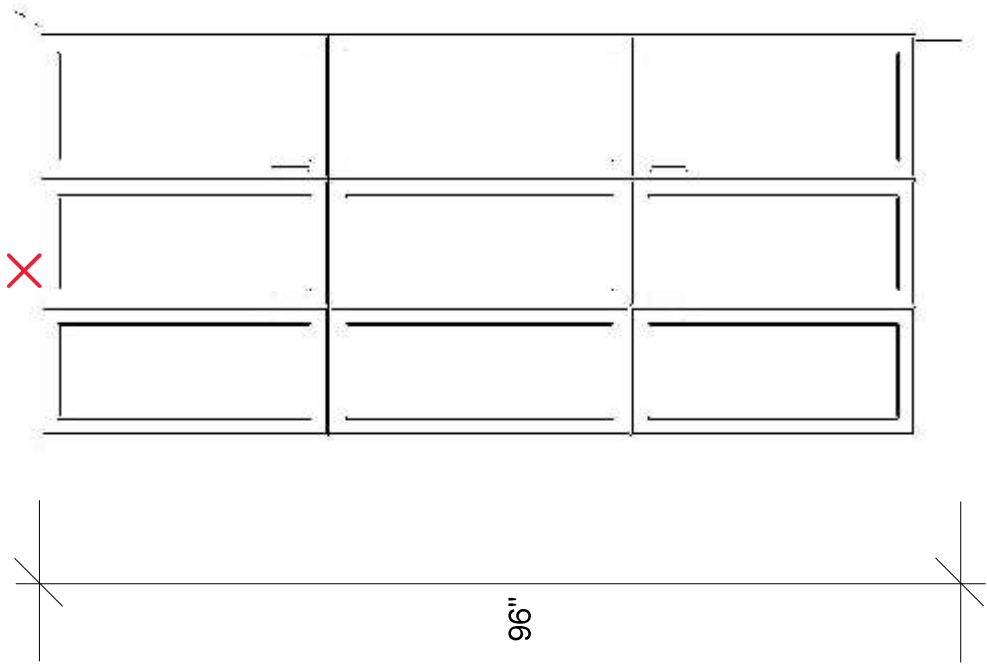

PANTRY WALL ELEVATION

Note: This drawing is an artistic interpretation of the general appearance of the design. It is not meant to be an exact rendition.		Designed: 11/29/2020 Printed: 11/30/2020	
		DCR #160 Pathways - ROSEMERIE - CHEF'S	Drawing #: 1

CUSTOMER APPROVAL

I have reviewed these drawings and understand the details of the design and the Cartier Kitchens specifications

Signature _____

Date _____

ds

R

D