

DCR PHOENIX HOMES


LOT #43
DIAMONDVIEW ESTATES - PHASE 2
NEWINGTON
OPTIONAL CHEF'S KITCHEN
(GARAGE LEFT)

MOUNTING HEIGHT: 96

PLUS 1" (APPROX.) FILLER TO BULKHEAD

NOTE: CUSTOM BULKHEAD BY BUILDER TO FOLLOW LINE OF UPPER CABINETS AND EXTEND APPROX. 2" PAST UPPER CABINETS

- CABINETS -
HARDWARE -
STANDARD WHITE INTERIOR
METAL DRAWER BOX
3 PCS - 5/8" KICK - FIN. BOTH ENDS
2 PCS - 90 DEG. CORNER MOULD
1 PCS - T-MOULD
5 PCS - FLAT MOULDING

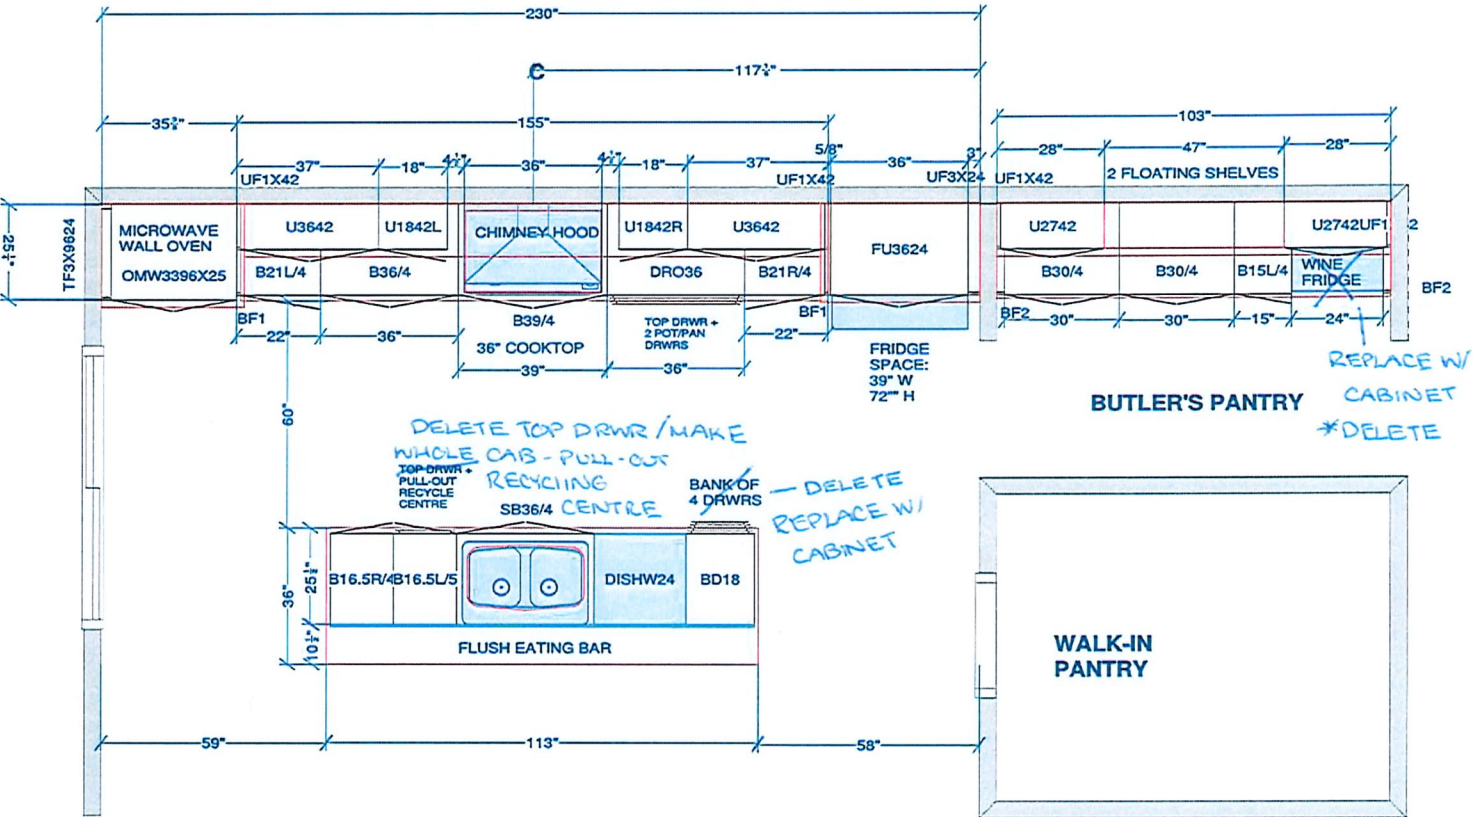

CUSTOMER APPROVAL

I have reviewed these drawings and understand the details of the design and the CARTIER KITCHENS specifications.

Signature _____

Date _____

All dimensions & size designations given are subject to verification on job site and adjustment to fit job conditions.

SPECTRUM KITCHEN and BATH DESIGN

DCR #43 Diamondview 2 - Newington Chef's Kitchen.kit

This is an original design and must not be released or copied unless applicable fee has been paid or job order placed.


DRAWN BY: LORI DISAVERIO, B.I.D

Designed: 2021-05-14
Printed: 2021-05-18


Drawing #: 1 No Scale.

DS DS
AJOT


VANITIES

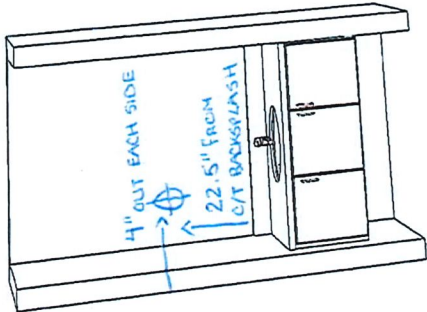


POWDER ROOM
FLOATING VANITY
@ 12" A.F.F.

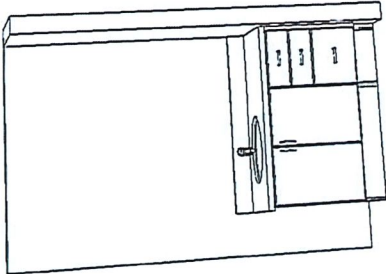


IN-LAW SUITE
ENSUITE VANITY

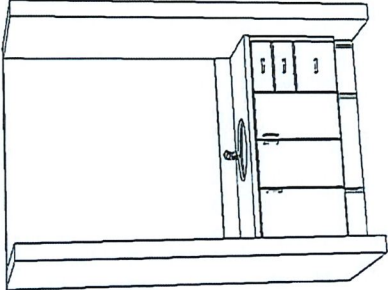

MAIN BATH VANITY

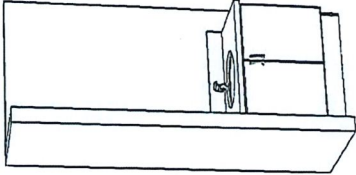

BRM 4 ENUITE
VANITY

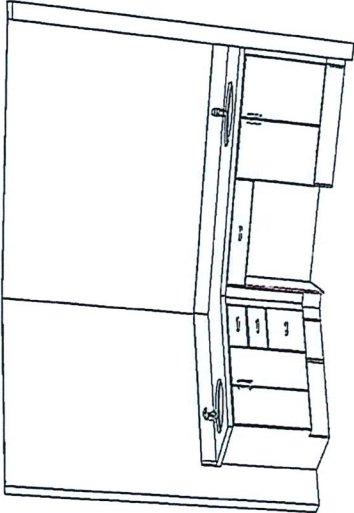

MASTER ENSUITE
VANITY

DS
AJ
DS
OT

CUSTOMER APPROVAL

I have reviewed these drawings and understand the details of the design and the CARTIER KITCHENS specifications.

Signature _____

Date _____

Note: This drawing is an artistic interpretation of the general appearance of the design. It is not meant to be an exact rendition.

SPECTRUM KITCHEN and BATH DESIGN


43 DV2 - NEWINGTON - VANITIES - 4 bdrm.kit



Designed: 2021-05-18
Printed: 2021-05-18

All

Drawing #: 1

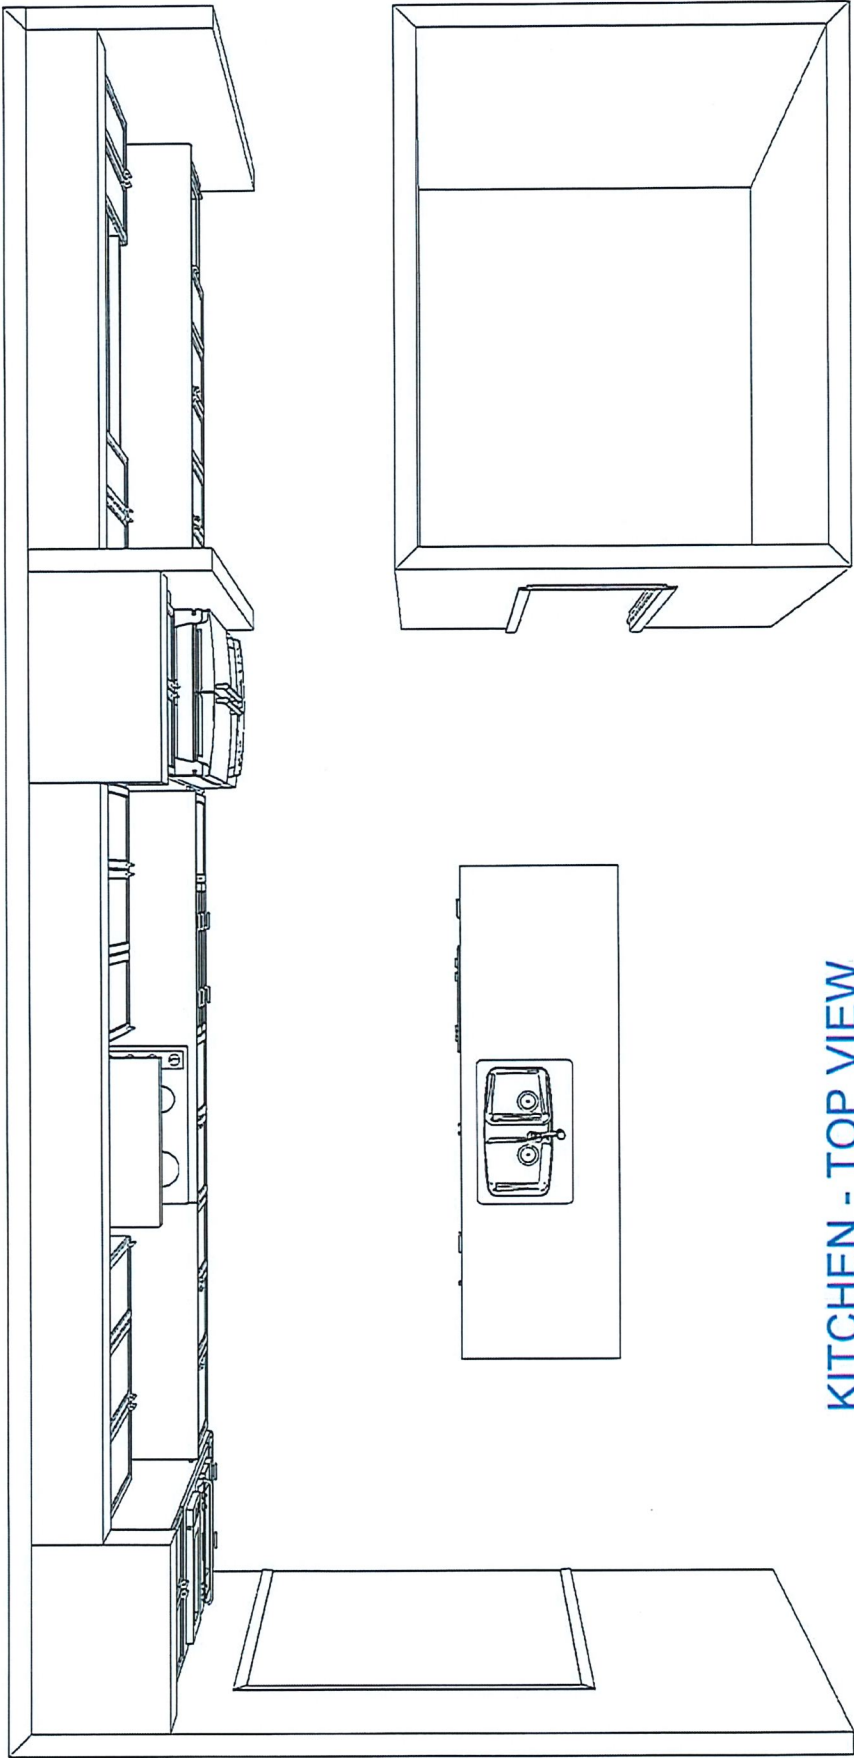

KITCHEN - TOP VIEW

CUSTOMER APPROVAL

I have reviewed these drawings and understand the details of the design and the CARTIER KITCHENS specifications.

Signature _____

Date _____

Note: This drawing is an artistic interpretation of the general appearance of the design. It is not meant to be an exact rendition.




Designed: 2021-05-14
Printed: 2021-05-18

SPECTRUM KITCHEN and BATH DESIGN

DCR #43 Diamondview 2 - Newington Chef's

All

Drawing #: 1

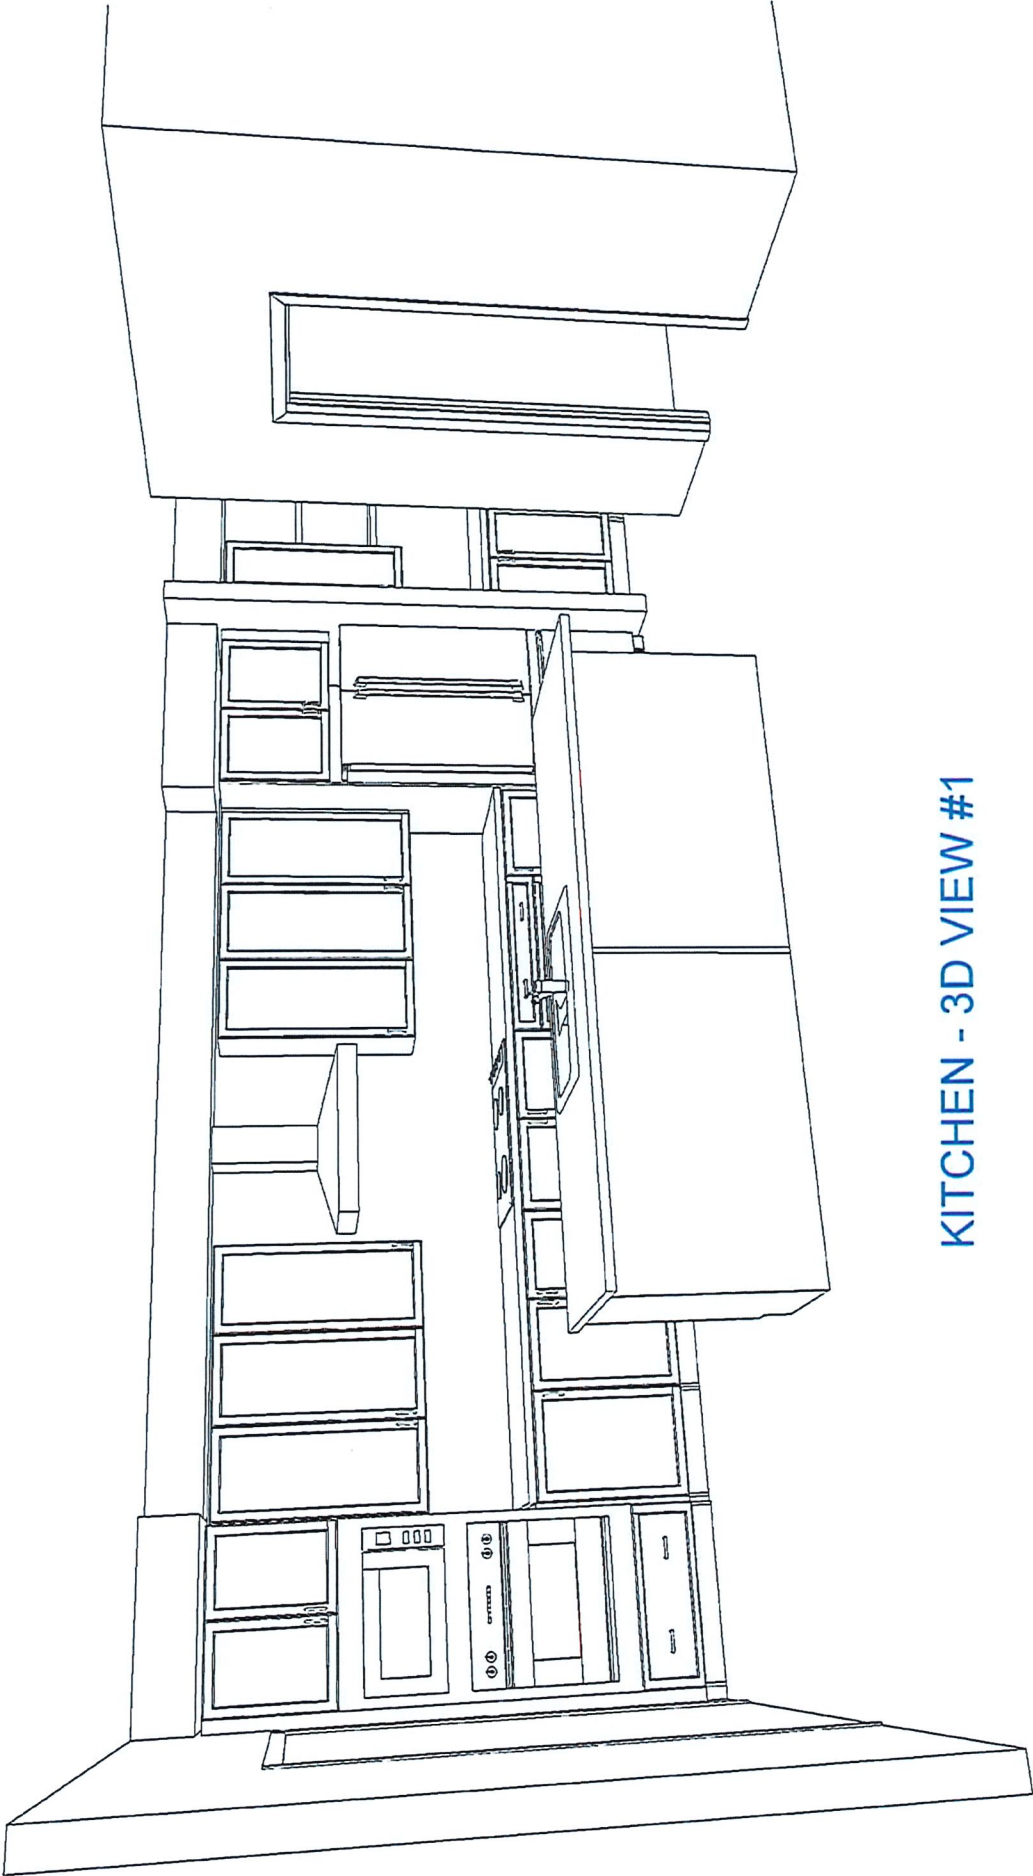

KITCHEN - 3D VIEW #1


CUSTOMER APPROVAL

I have reviewed these drawings and understand the details of the design and the CARTIER KITCHENS specifications.

Signature _____

Date _____

Note: This drawing is an artistic interpretation of the general appearance of the design. It is not meant to be an exact rendition.		Designed: 2021-05-14 Printed: 2021-05-18	
		SPECTRUM KITCHEN and BATH DESIGN	
DCR #43 Diamondview 2 - Newington Chef's		All	Drawing #: 1

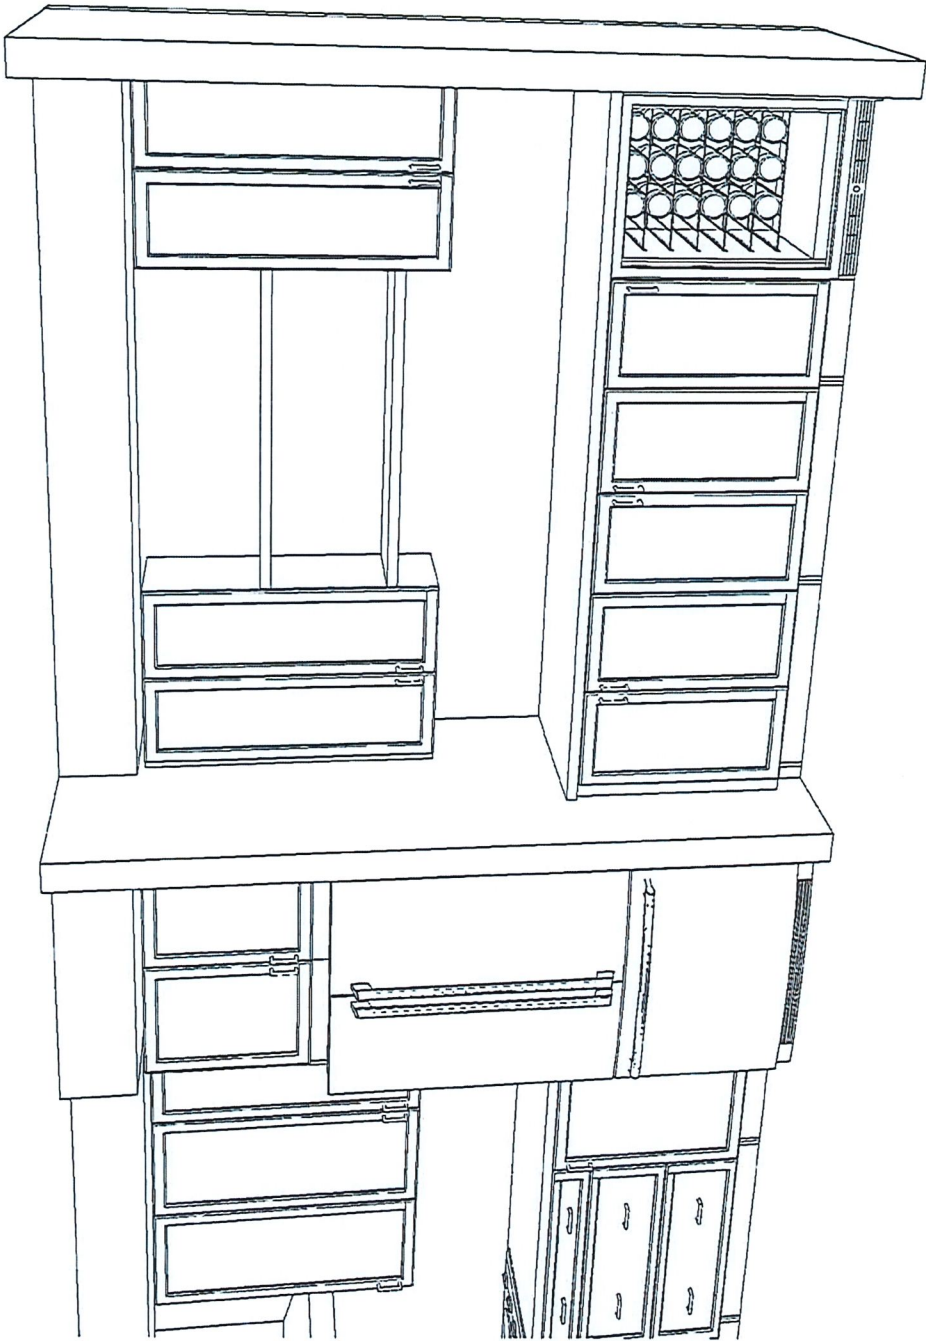

3D VIEW #2 - BUTLER'S PANTRY


CUSTOMER APPROVAL

I have reviewed these drawings and understand the details of the design and the CARTIER KITCHENS specifications.

Signature _____

Date _____

Note: This drawing is an artistic interpretation of the general appearance of the design. It is not meant to be an exact rendition.		Designed: 2021-05-14 Printed: 2021-05-14	
SPECTRUM KITCHEN and BATH DESIGN			
DCR #43 Diamondview 2 - Newington Chef's		All	Drawing #: 1

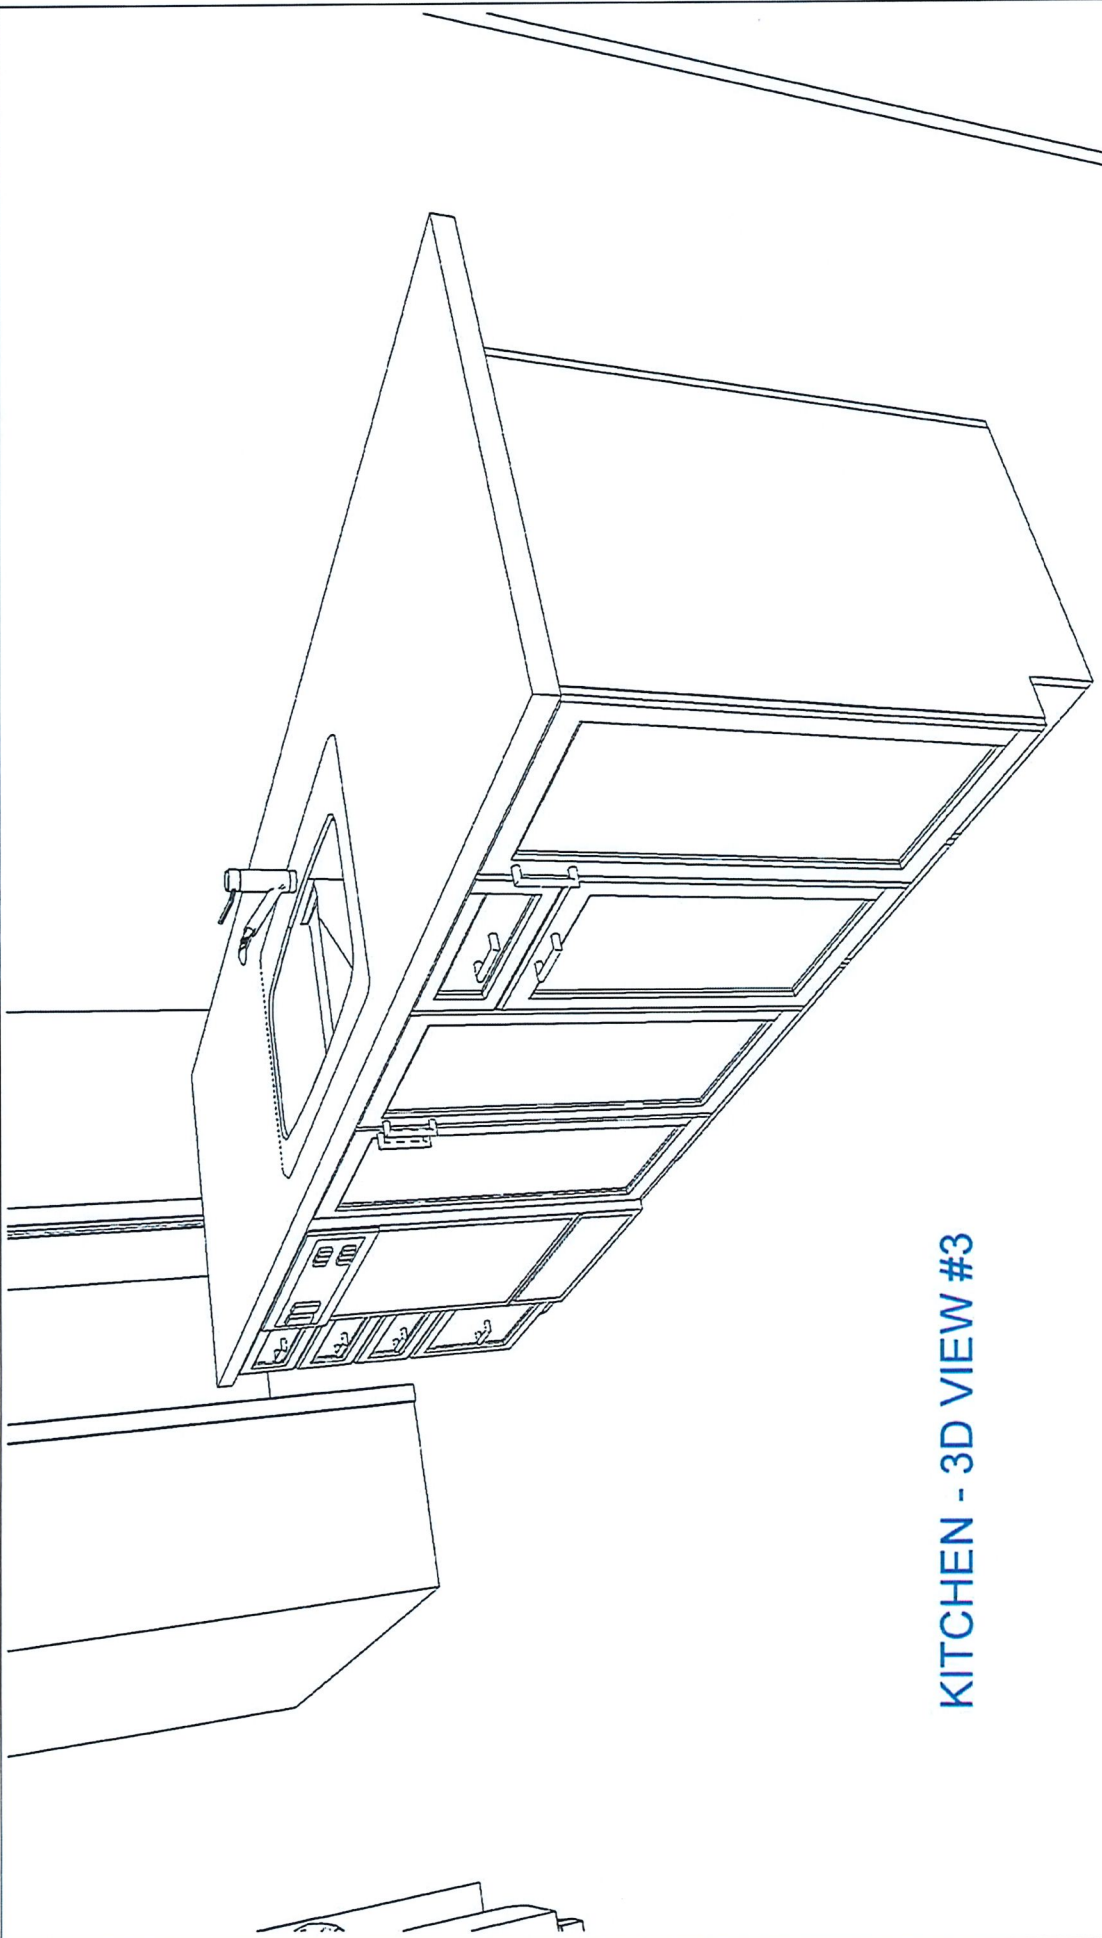

KITCHEN - 3D VIEW #3

CUSTOMER APPROVAL

I have reviewed these drawings and understand the details of the design and the CARTIER KITCHENS specifications.

Signature_____

Date_____

Note: This drawing is an artistic interpretation of the general appearance of the design. It is not meant to be an exact rendition.

SPECTRUM KITCHEN and BATH DESIGN


DCR #43 Diamondview 2 - Newington Chef's



Designed: 2021-05-14
Printed: 2021-05-18

All

Drawing #: 1

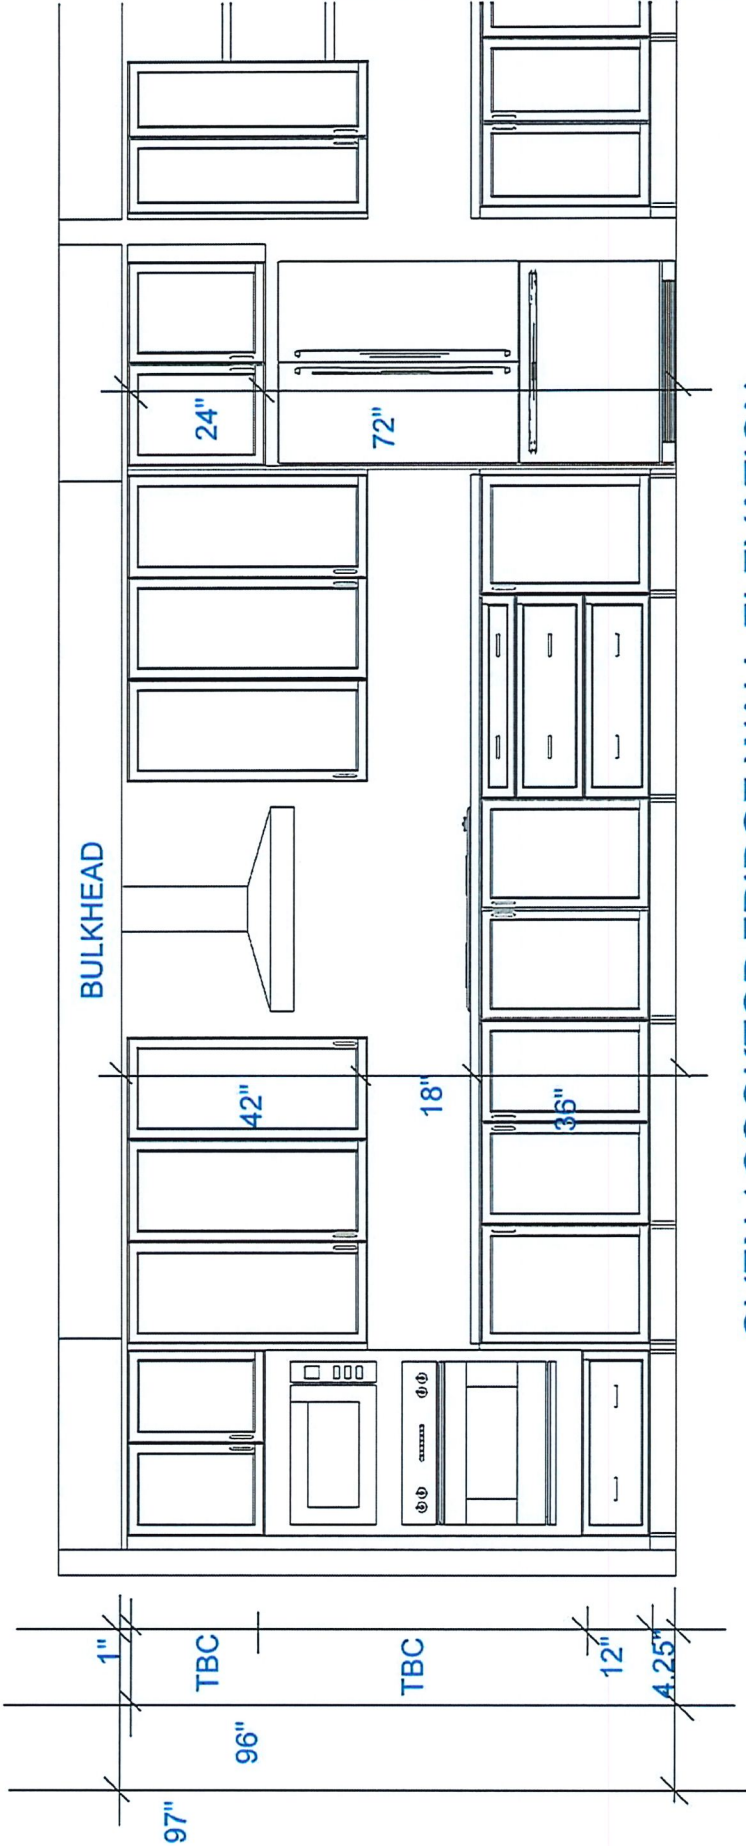

CUSTOMER APPROVAL

I have reviewed these drawings and understand the details of the design and the CARTIER KITCHENS specifications.

Signature _____

Date _____

Note: This drawing is an artistic interpretation of the general appearance of the design. It is not meant to be an exact rendition.




SPECTRUM KITCHEN and BATH DESIGN

DCR #43 Diamondview 2 - Newington Chef's

All

Drawing #: 1

Designed: 2021-05-14
Printed: 2021-05-14

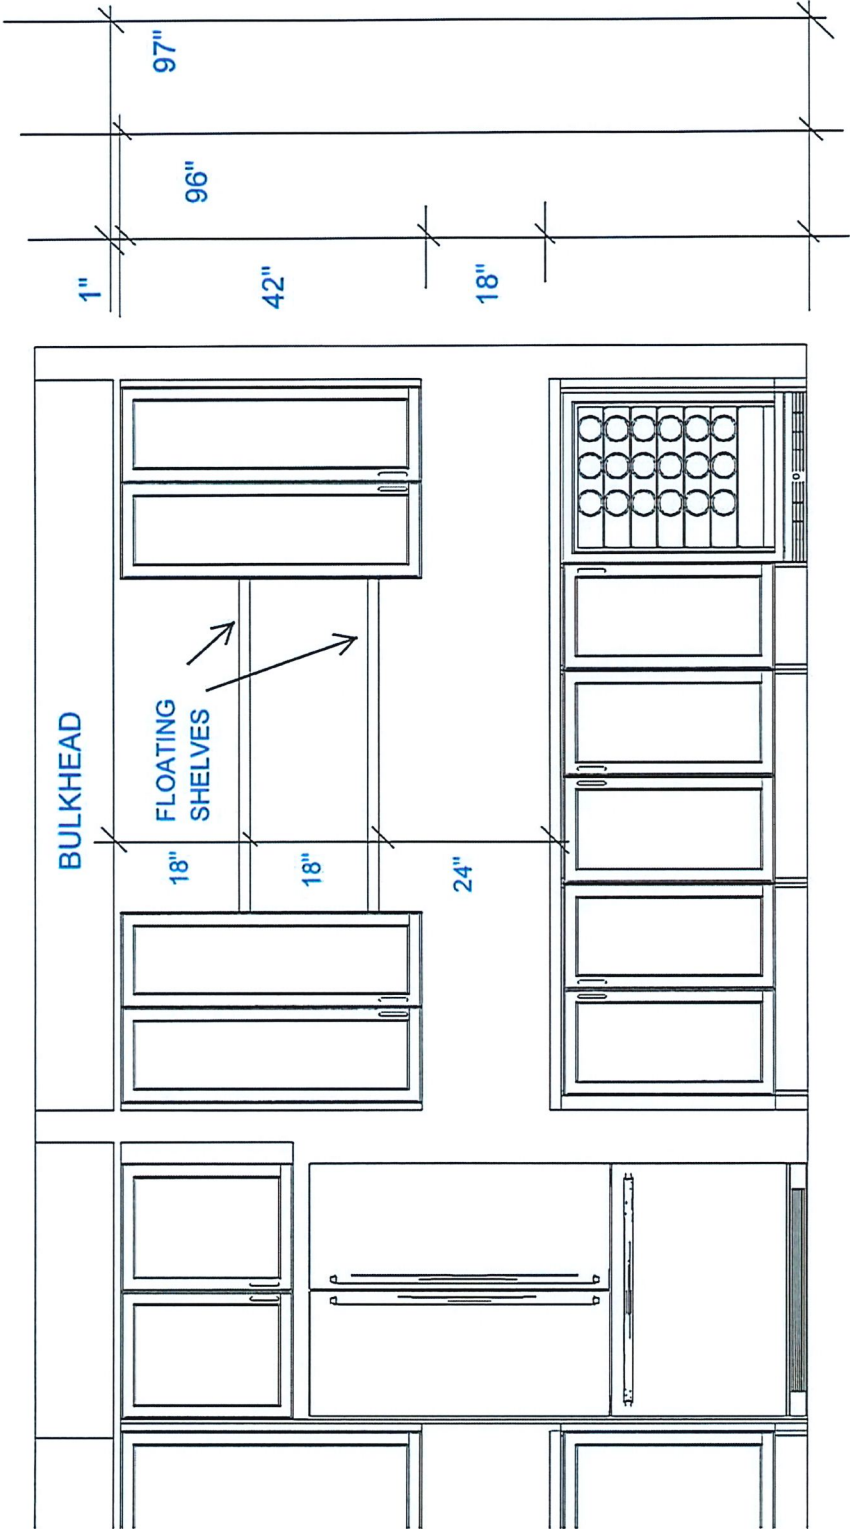

BUTLER'S PANTRY ELEVATION

CUSTOMER APPROVAL

I have reviewed these drawings and understand the details of the design and the CARTIER KITCHENS specifications.

Signature _____


Date _____

Note: This drawing is an artistic interpretation of the general appearance of the design. It is not meant to be an exact rendition.		Designed: 2021-05-14 Printed: 2021-05-14	
SPECTRUM KITCHEN and BATH DESIGN		All	Drawing #: 1
DCR #43 Diamondview 2 - Newington Chef's			


DCR PHOENIX HOMES

LOT #43
DIAMONDDVIEW ESTATES 2
NEWINGTON - 4 BDRM
VANITIES


- CABINETS -
HARDWARE -
STANDARD WHITE INTERIOR
METAL DRAWER BOX
6 PCS - 5/8" KICK - FIN. BOTH ENDS
6 PCS - FLAT MOULDING

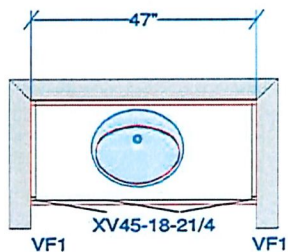

POWDER ROOM

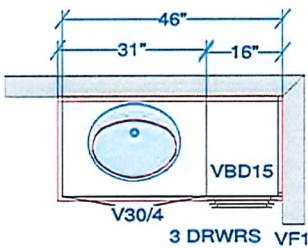


IN LAW - ENSUITE

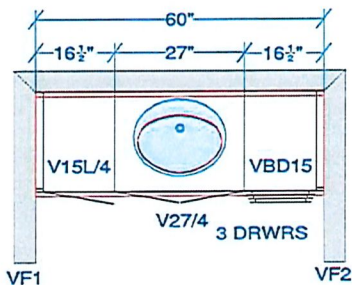

MAIN


FLOATING VANITY @ 12" A.F.F.

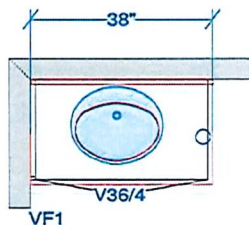

ENSUITE BEDROOM 4



SURFACE MOUNT
MED. CAB
INSTALL ABOVE
TOILET @ 48" A.F.F

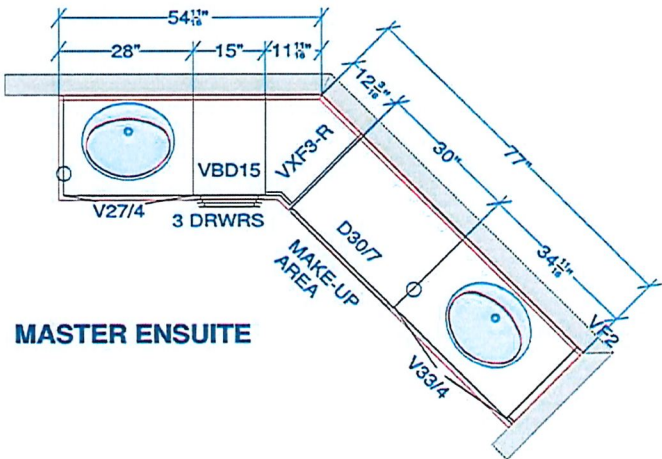

MASTER ENSUITE

CUSTOMER APPROVAL

I have reviewed these drawings and understand the details of the design and the CARTIER KITCHENS specifications.

Signature _____

Date _____

All dimensions ,size designations
given are subject to verification on
job site and adjustment to fit job
conditions.

SPECTRUM KITCHEN and BATH
DESIGN



This is an original design and must
not be released or copied unless
applicable fee has been paid or job
order placed.

DRAWN BY: LORI DISAVERIO, B.I.D

Designed: 2021-05-18
Printed: 2021-05-18

43 DV2 - NEWINGTON - VANITIES - 4 bdrm.kit

All

Drawing #: 1 No Scale.