


City of Ottawa
Building Services Branch

REVIEWED
By *bordagedo* at 1:12 pm, Apr 15, 2021


Building Code Reviewed

[Signature]
Signature


D. BORDAGE

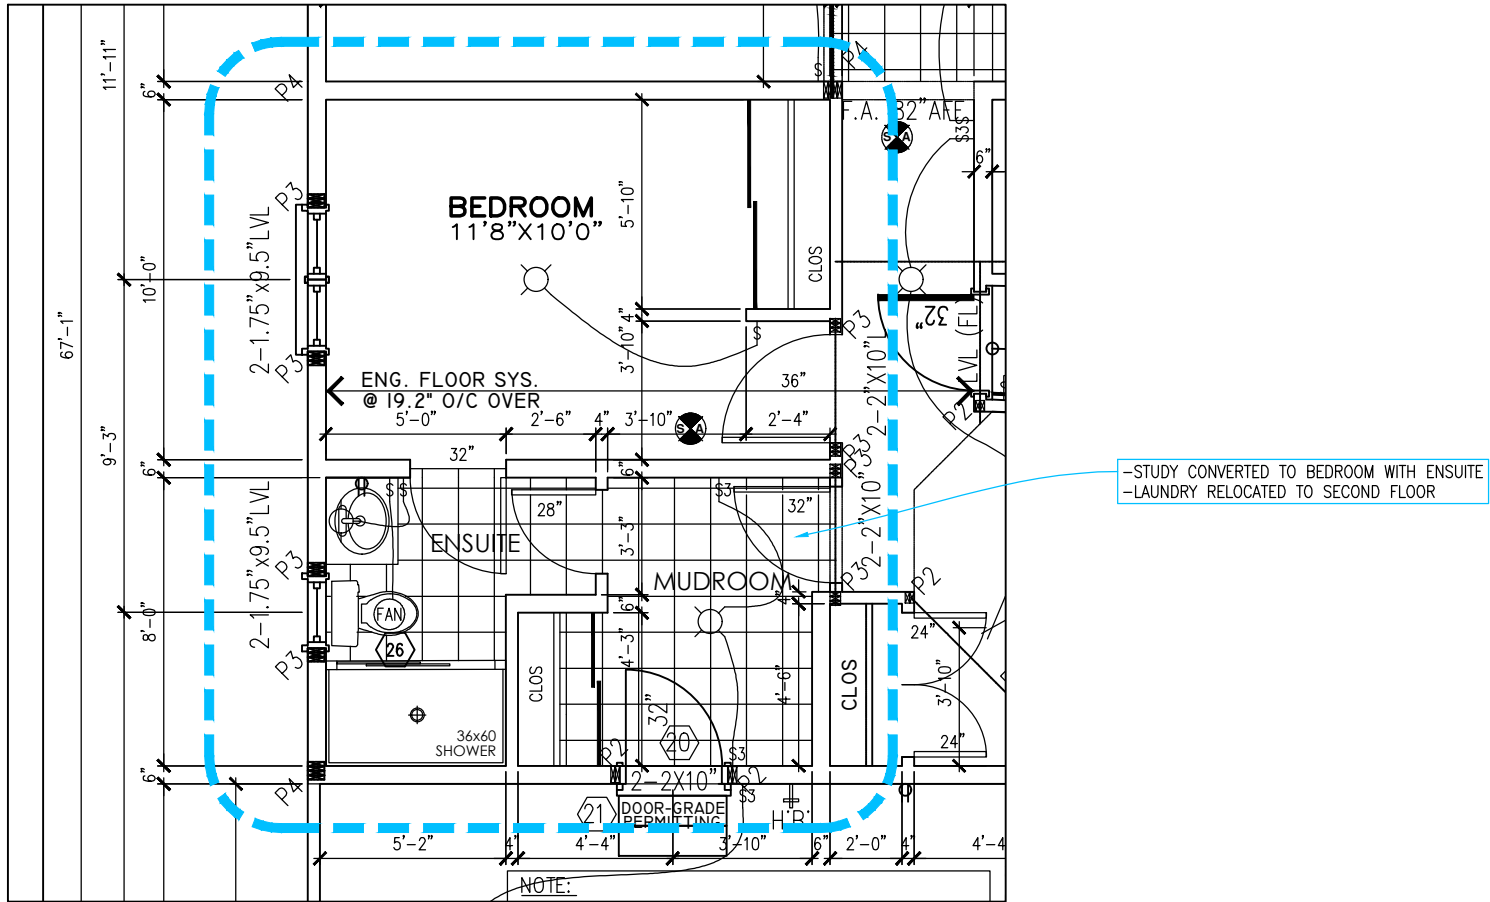

1 PARTIAL GROUND FLOOR PLAN
1 scale: 3/16"=1'-0"

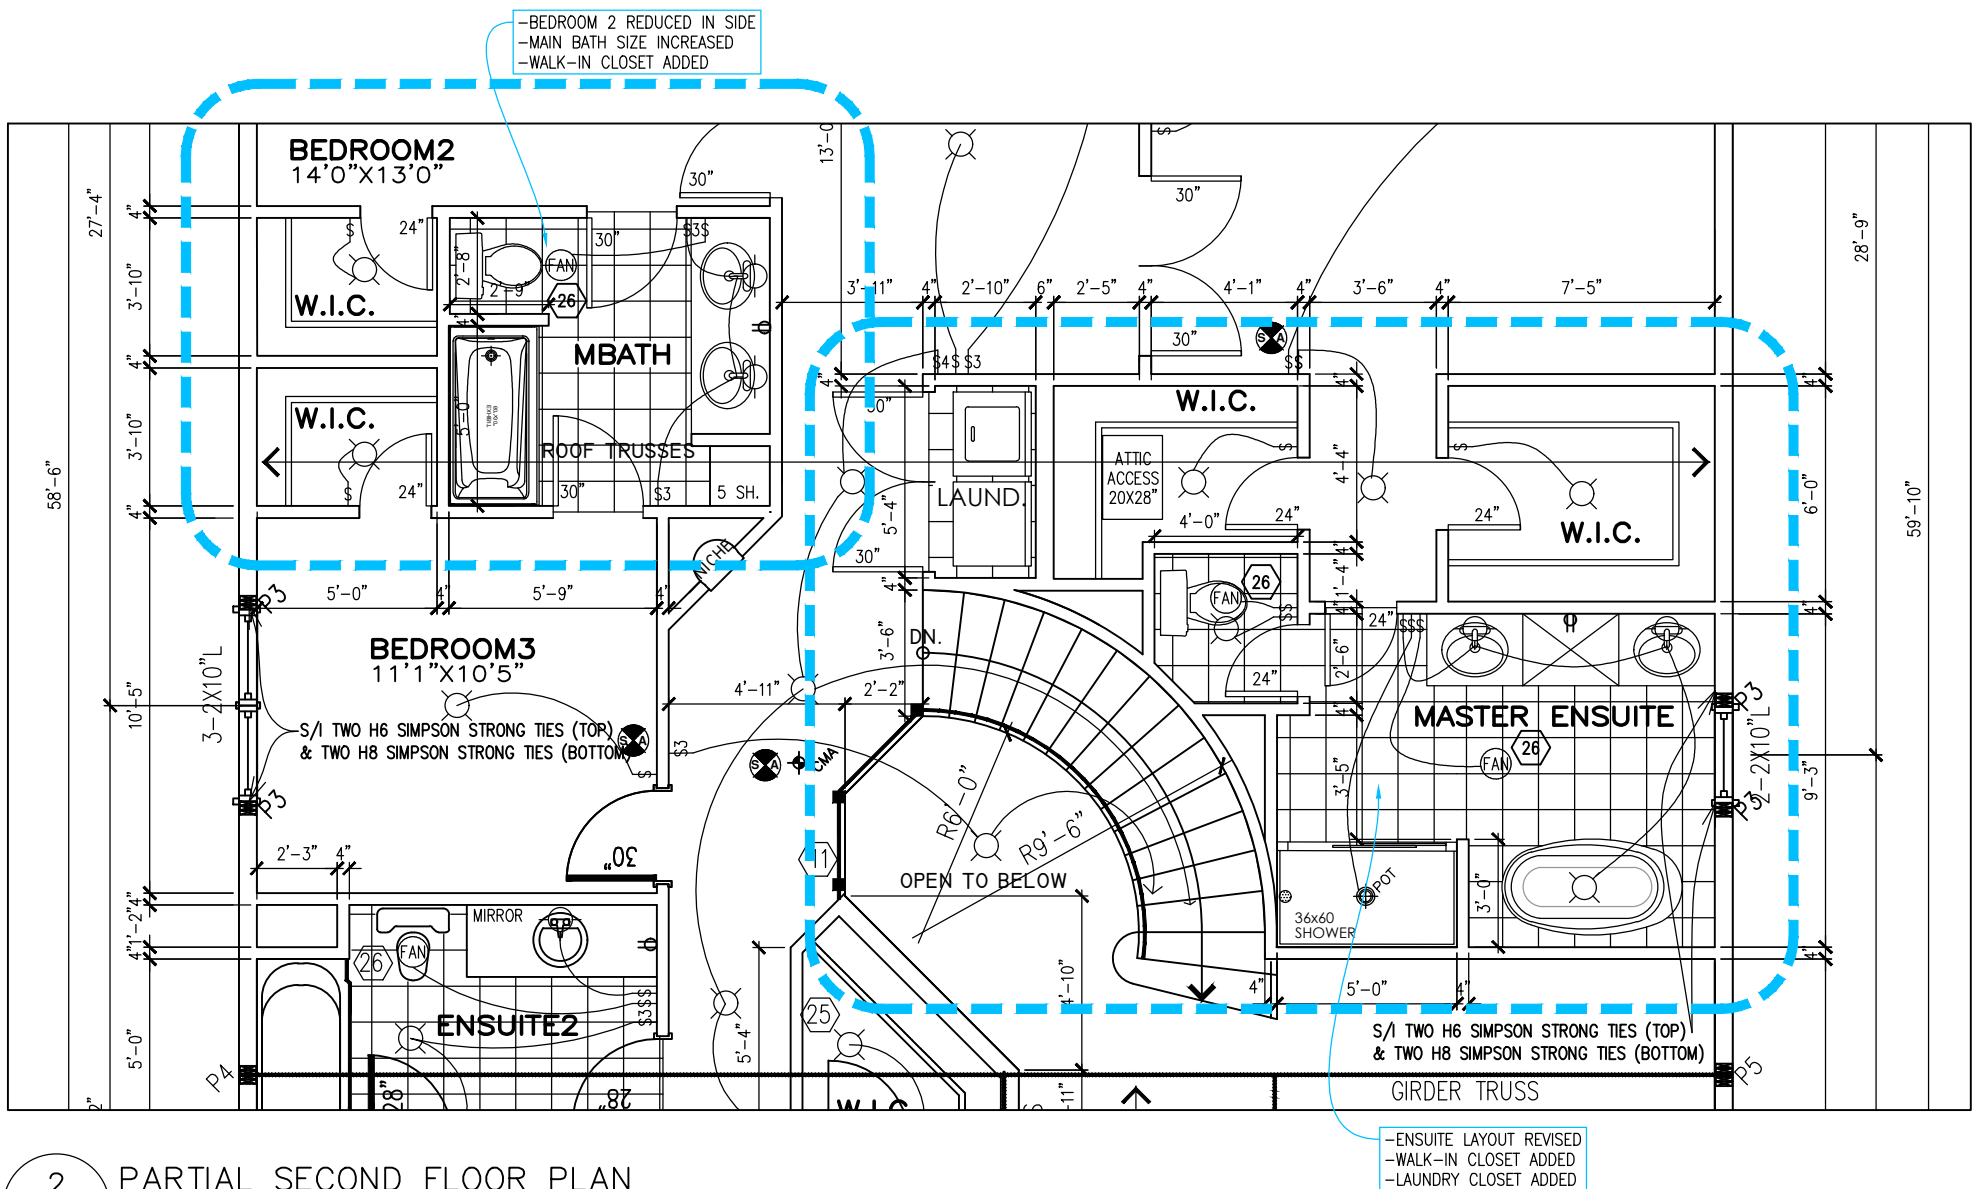

2 PARTIAL SECOND FLOOR PLAN
1 scale: 3/16"=1'-0"

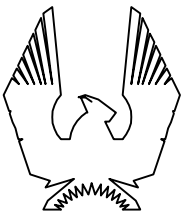

ANNAPOLIS-2018-M

SITE: PATHWAYS

LOT NUMBER:

CIVIC ADDRESS:
172 MINIKAN STREET

153

1	GRND FLOOR BED, REV ENSUITE, REV MAIN BATH	26/03/21	CB
No.	Description	dd/mm/yy	By
REVISIONS			

footprint:	509
drawn by:	T.L.
date:	DEC. 2012
scale:	3/16"=1'-0"

sheet no:	