

DCR PHOENIX HOMES


LOT 164
PATHWAYS
MELBOURNE 4 BED

KITCHEN
MOUNTING HEIGHT = 96


42" H UPPERS
@ 18 ABOVE COUNTER
~~FILL TO CEILING WITH~~
~~1" MOULDING, FURRING PANEL~~
~~& CEILING CROWN~~
~~LIGHT VALANCE~~

LINE 3 - SOHO MDF - ANTHRACITE - RANGE WALL & ISLAND
LINE 4 - SOHO MAPLE - TRUFFLE - FRIDGE WALL
HARDWARE - TBC (BRUSHED BRASS)
STANDARD WHITE INTERIORS
SOFT CLOSE DRAWERS
SOFT CLOSE DOORS
6 PCS - 5/8 KICK FIN, BOTH SIDES
1 PCS - T-MOULD
1 PCS - 90 DEG. CORNER MOULD
8 PCS - FLAT MOULD

* DIMENSIONS & LAYOUT SUBJECT TO
CHANGE DUE TO SITE CONDITIONS W/O
NOTICE *

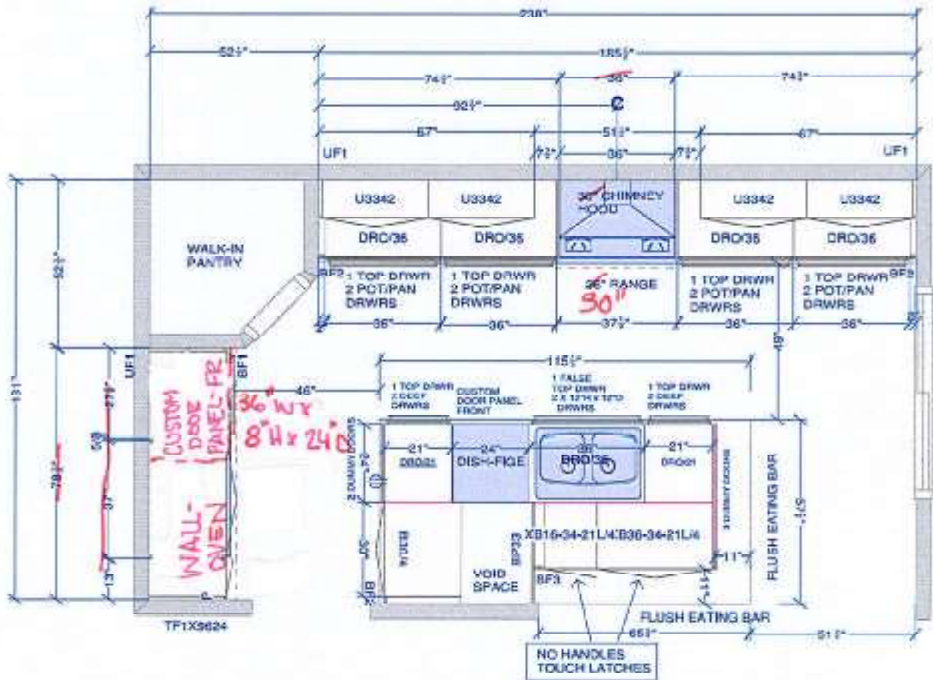

VANITIES - 4 BDRM

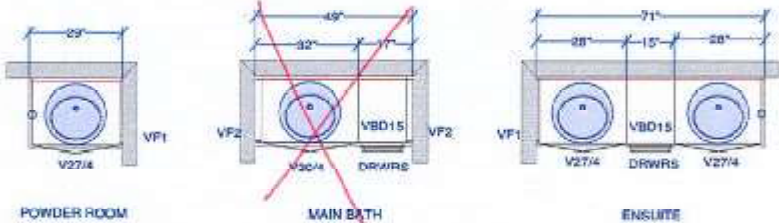

* MAIN BATH VANITY APPROX - 6' - 2" WIDE W/ (2) BANK OF DWRS *

CUSTOMER APPROVAL I have reviewed these drawings and understand the details of the design and the CARTIER KITCHENS specifications. Signature _____ Date _____	All dimensions, size designations given are subject to verification on job site and adjustment to fit job conditions.	This is an original design and must not be released or copied unless applicable fee has been paid or job order placed.	Designed: 2018-08-16 Printed: 2018-08-16
	SPECTRUM KITCHEN and BATH DESIGN	DRAWN BY: LORI DISAVERIO, B.I.D	DS Bl DS Ma
	PATHWAYS - MODEL HOME 2.kit	All	Drawing #: 1