



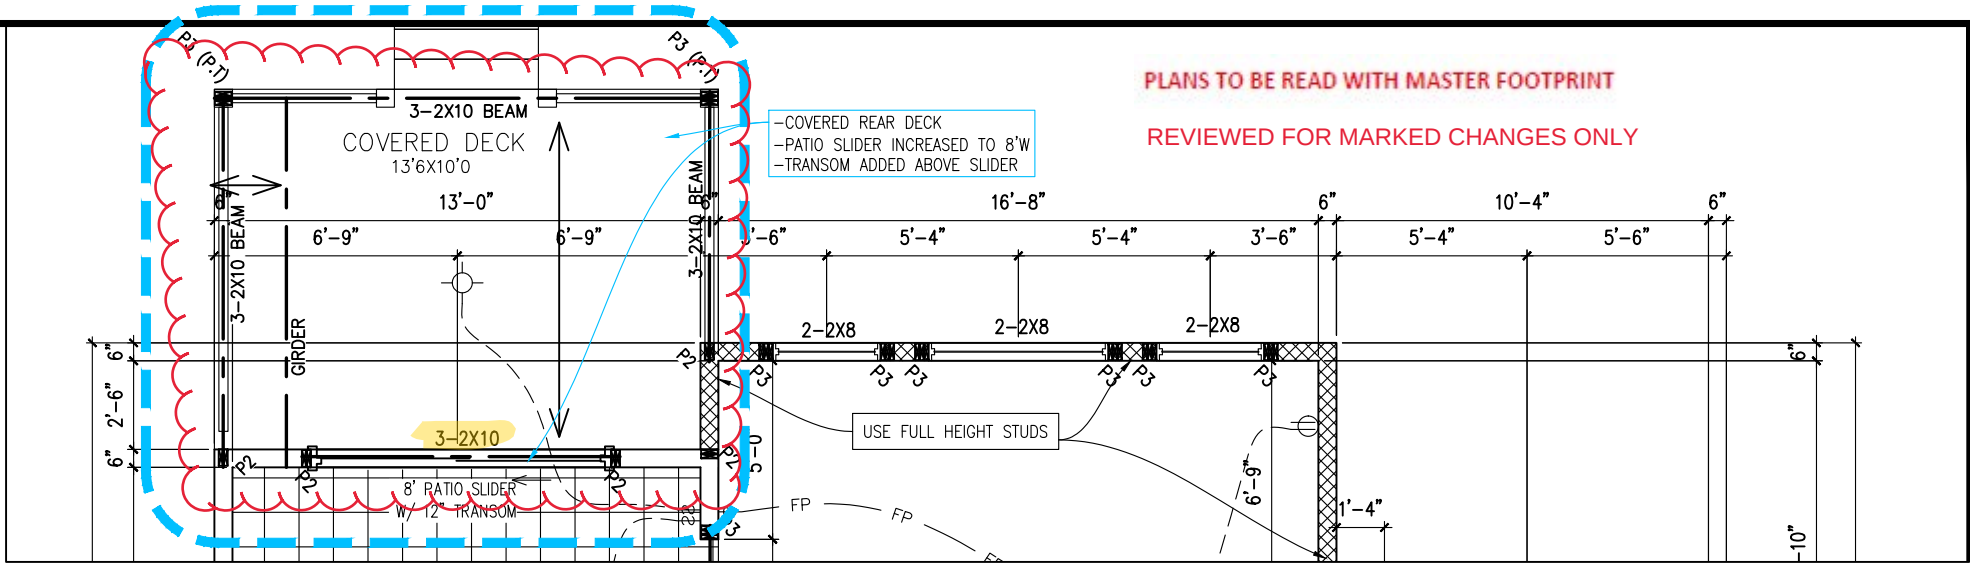


1 PARTIAL GROUND FLOOR PLAN

2 scale: 3/16"=1'-0"

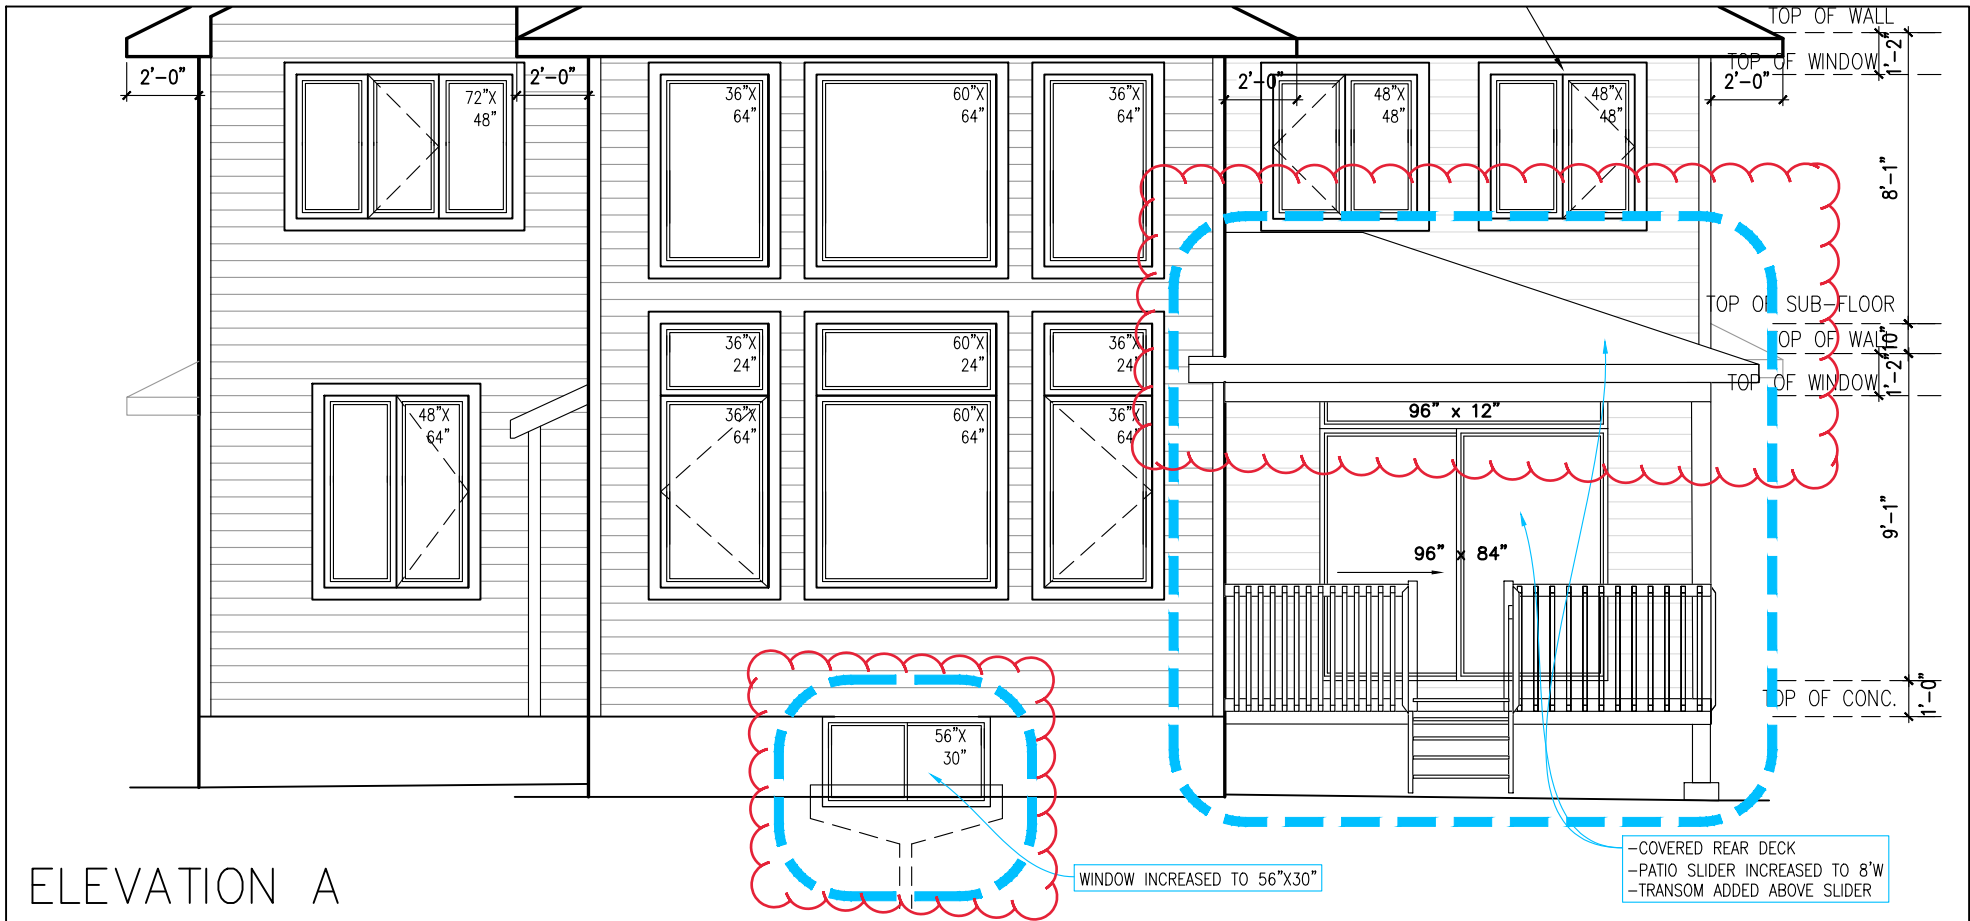

2 PARTIAL REAR ELEVATION

2 scale: 3/16"=1'-0"

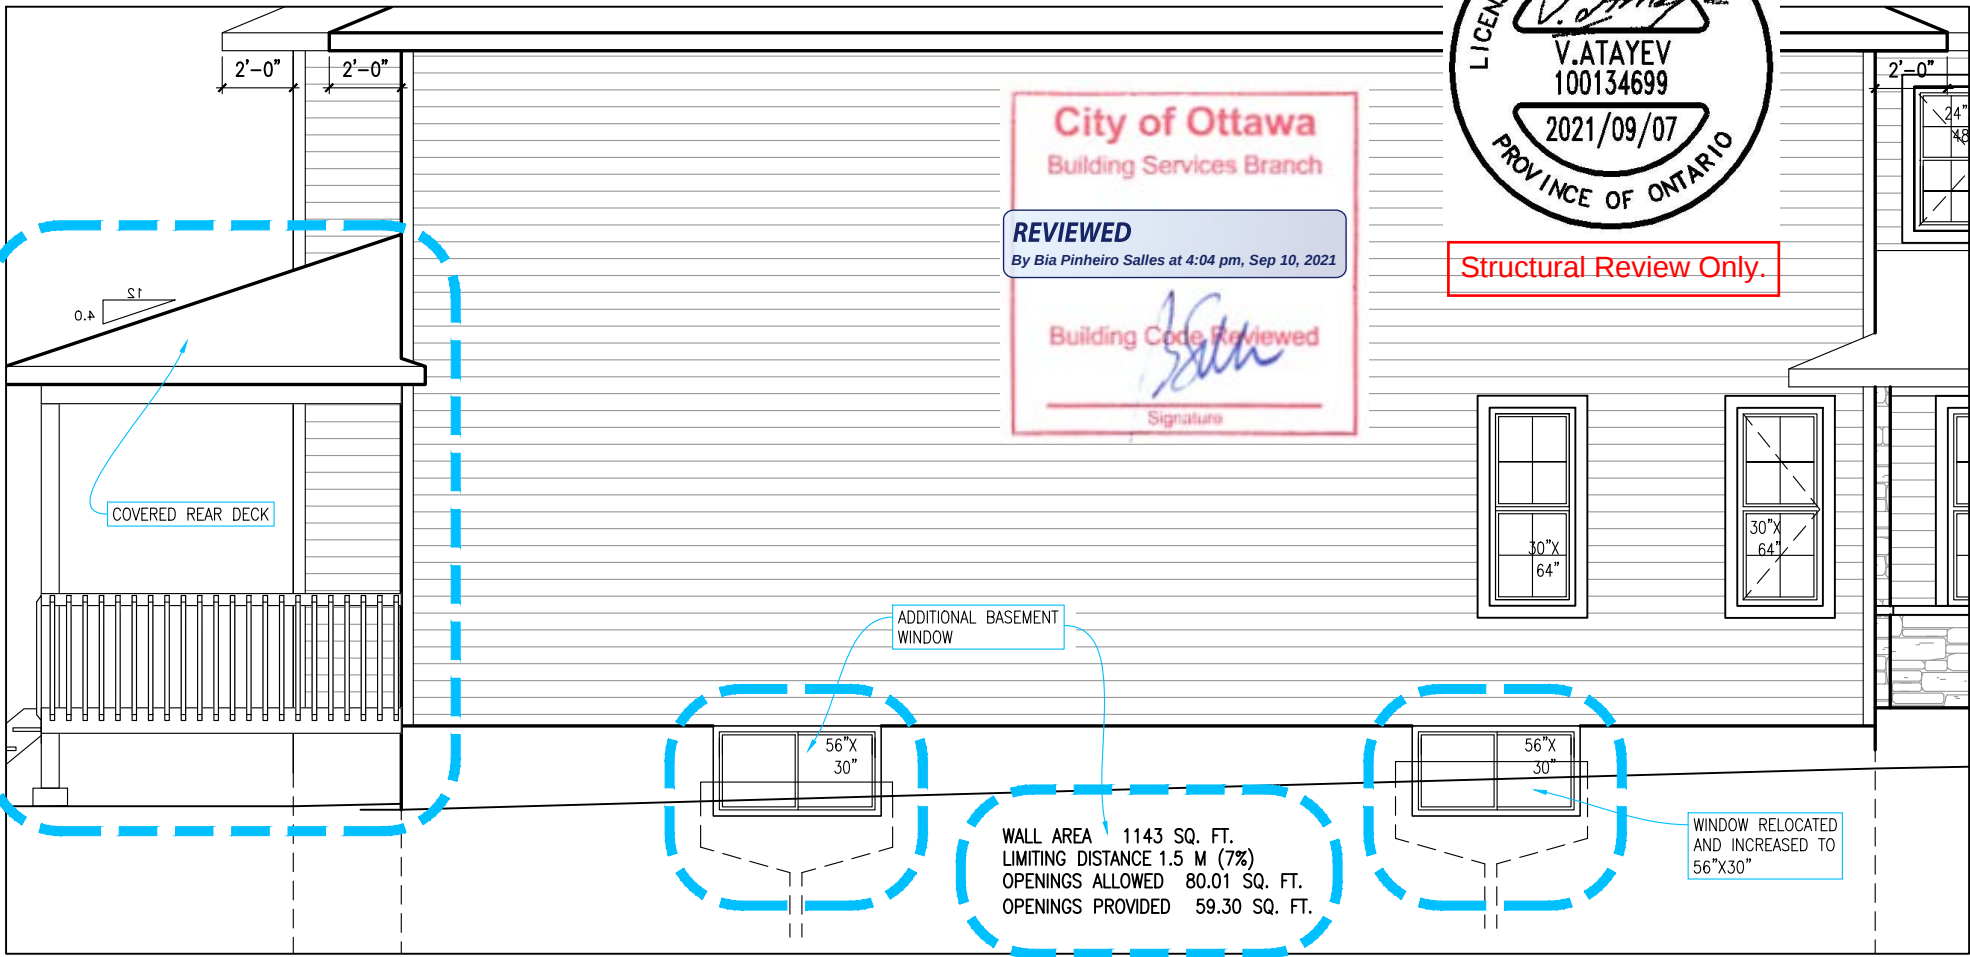

3 PARTIAL LEFT ELEVATION

2 scale: 3/16"=1'-0"

PHOENIX HOMES

NEWINGTON — 2018

SITE: DIAMONDVIEW PH 2

LOT NUMBER: 44

CIVIC ADDRESS:
1942 CESSNA PRIVATE

2	ENGINEER MARKUPS APPLIED	XX/XX/XX	CB
1	BSMT WINDOW REVISIONS AND COVERED DECK	25/08/21	CB
No.	Description	dd/mm/yy	By
REVISIONS			

footprint: 518

drawn by: SP

date: JUN 12/16

scale: 3/16"=1'-0"

sheet no: 2