

DCR PHOENIX HOMES

LOT #116
PATHWAYS

MODEL - WINCHESTER (43-4) - RIGHT
KITCHEN
MOUNTING HEIGHT - 96

39" UPPERS 21" ABOVE COUNTER
LIGHT VALANCE
CROWN MOULDING


- CABINETS -
HARDWARE -
STANDARD WHITE INTERIOR
METAL DRAWER BOX
4 PCS - 5/8" KICK - FIN. BOTH ENDS
5 PCS - FLAT MOULDING
2 PCS - 90 DEG. CORNER MOULD
1 PCS - T-MOULD

CUSTOMER APPROVAL


I have reviewed these drawings and understand the details of the design and the CARTIER KITCHENS specifications.

Signature _____


Date _____

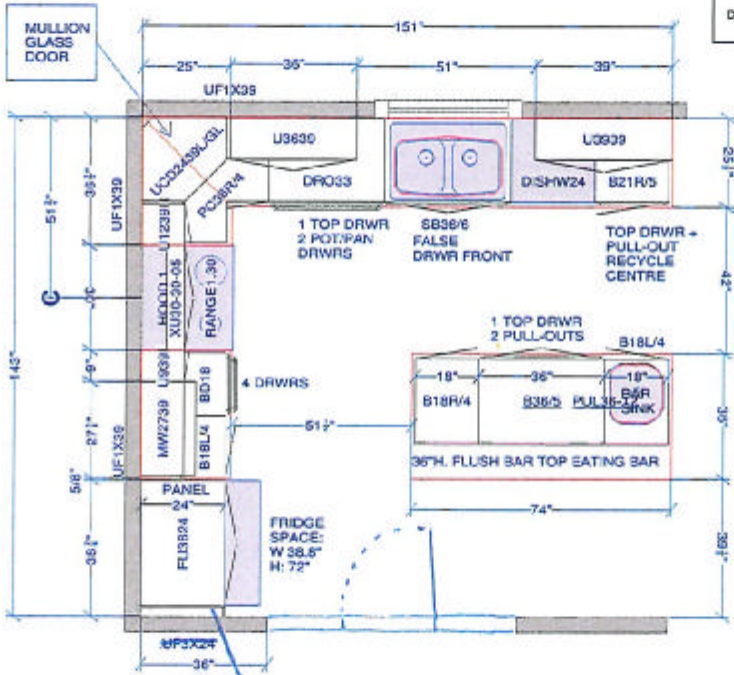

4" FILLER TO ACCOMMODATE FOR
FRENCH DOOR FRIDGE

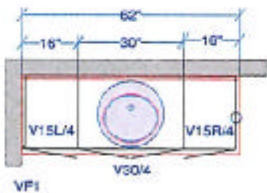


POWDER

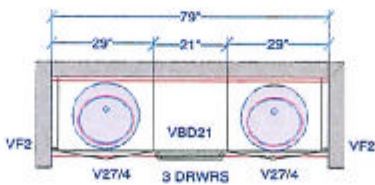

MAIN BATH

2ND SINK ADDED

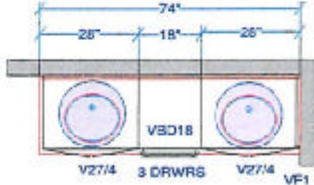

ENSUITE

LENGTH INCREASED BY 6"
2ND SINK ADDED

All dimensions ,size designations
given are subject to verification on
job site and adjustment to fit job
conditions.

SPECTRUM KITCHEN and BATH
DESIGN

DCR #116 Pathways - 43-4 Winchester - RIGHT Jdt



This is an original design and must
not be released or copied unless
applicable fee has been paid or job
order placed.


DRAWN BY: LORI DISAVERIO, B.I.D

Designed: 2020-11-15
Printed: 2020-11-15

All Drawing #: 1 No Scale.

DS
RH

DS
RH

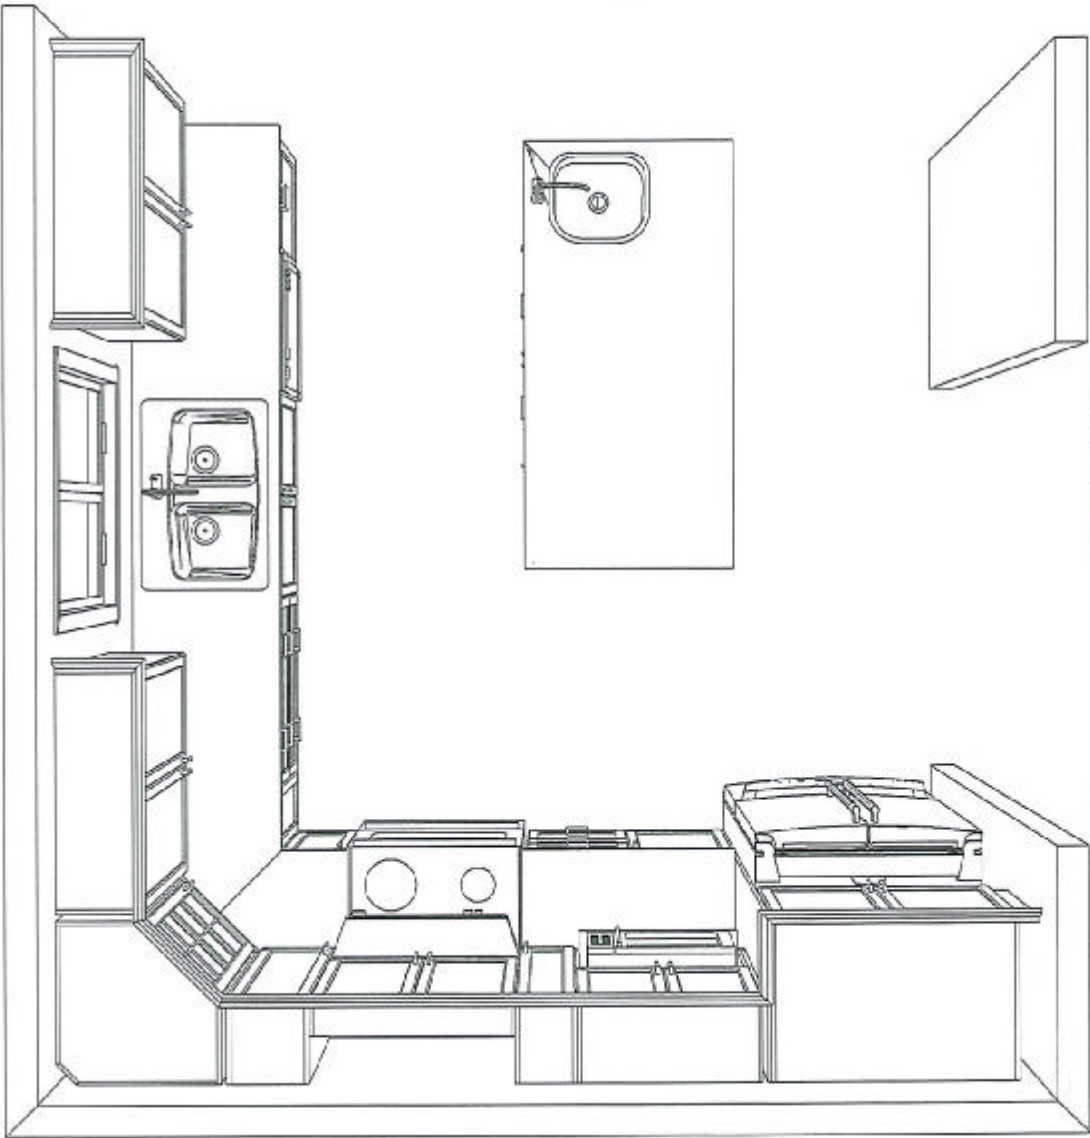

KITCHEN - TOP VIEW

CUSTOMER APPROVAL


I have reviewed these drawings and understand the details of the design and the CARTIER KITCHENS specifications.

Signature _____

Date _____

	Designed: 2020-11-15 Printed: 2020-11-15	All	Drawing #: 1
	Note: This drawing is an artistic interpretation of the general appearance of the design. It is not meant to be an exact rendition.		
SPECTRUM KITCHEN and BATH DESIGN		DCR #116 Pathways - 43-4 Winchester - RIGHT .kit	

DS
RH

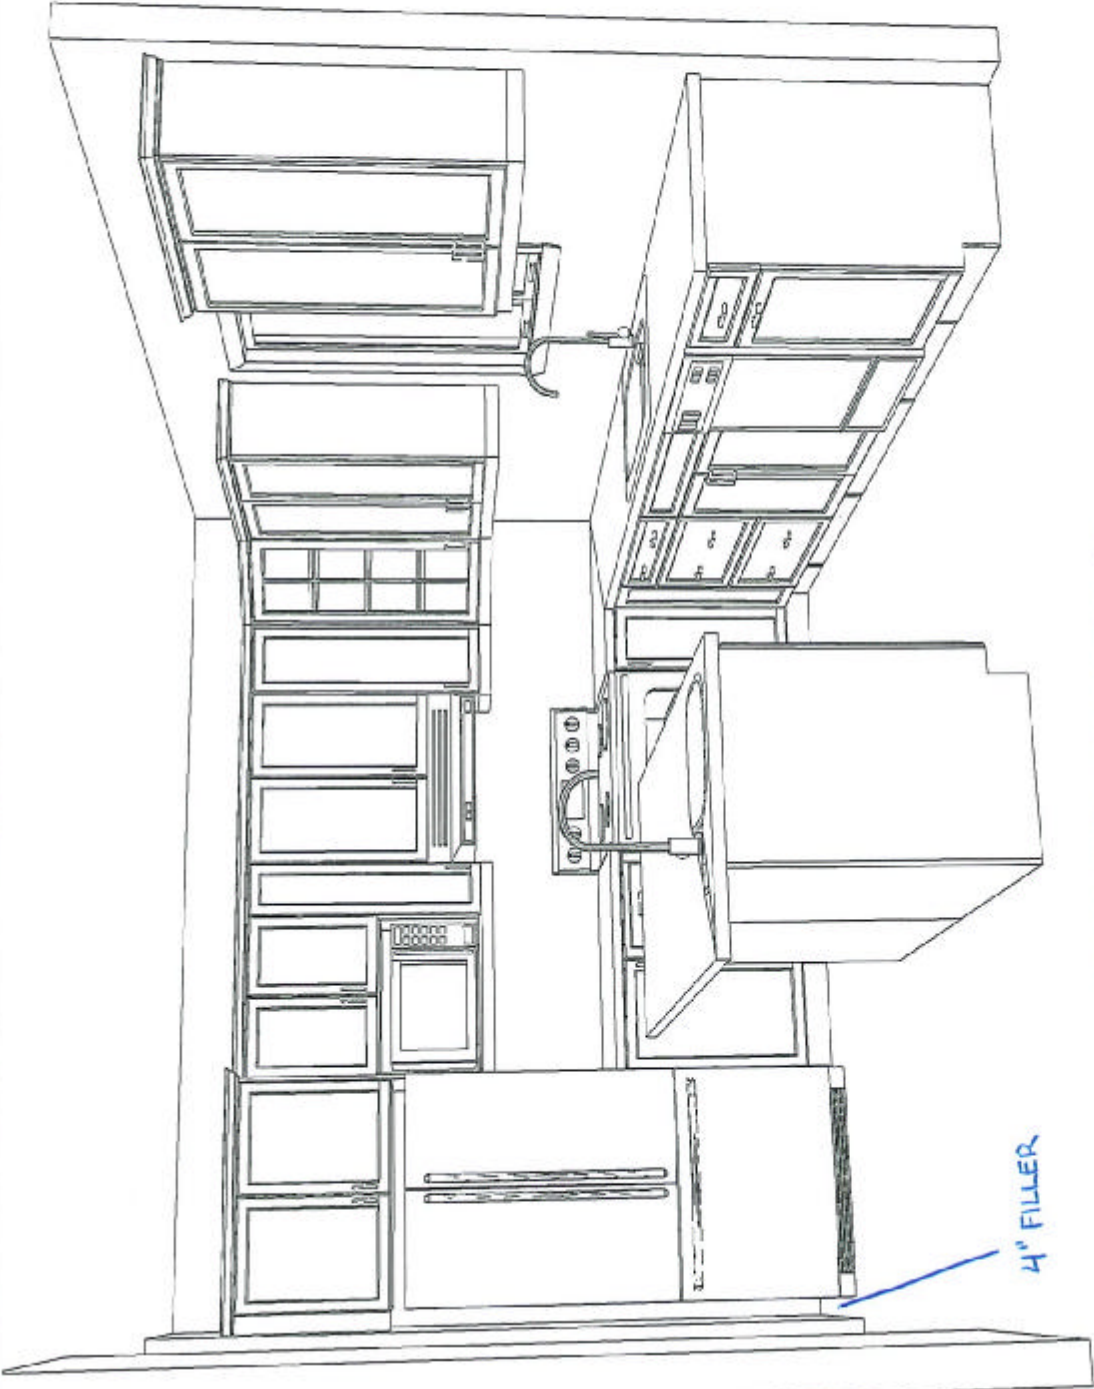

KITCHEN - 3D VIEW #1

CUSTOMER APPROVAL

I have reviewed these drawings and understand the details of the design and the CARTIER KITCHENS specifications.

Signature _____

Date _____


Note: This drawing is an artistic interpretation of the general appearance of the design. It is not meant to be an exact rendition.




SPECTRUM KITCHEN and BATH DESIGN

DCR #1116 Pathways - 43-4 Winchester - RIGIIT .kit All Drawing #: 1

DS
RH

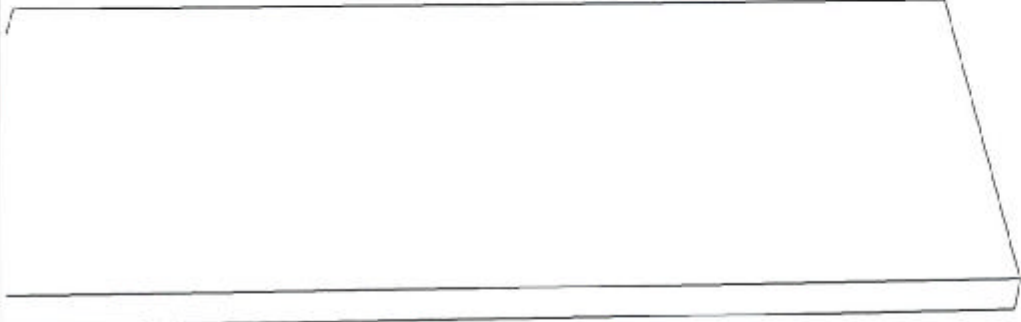

KITCHEN - 3D VIEW #2

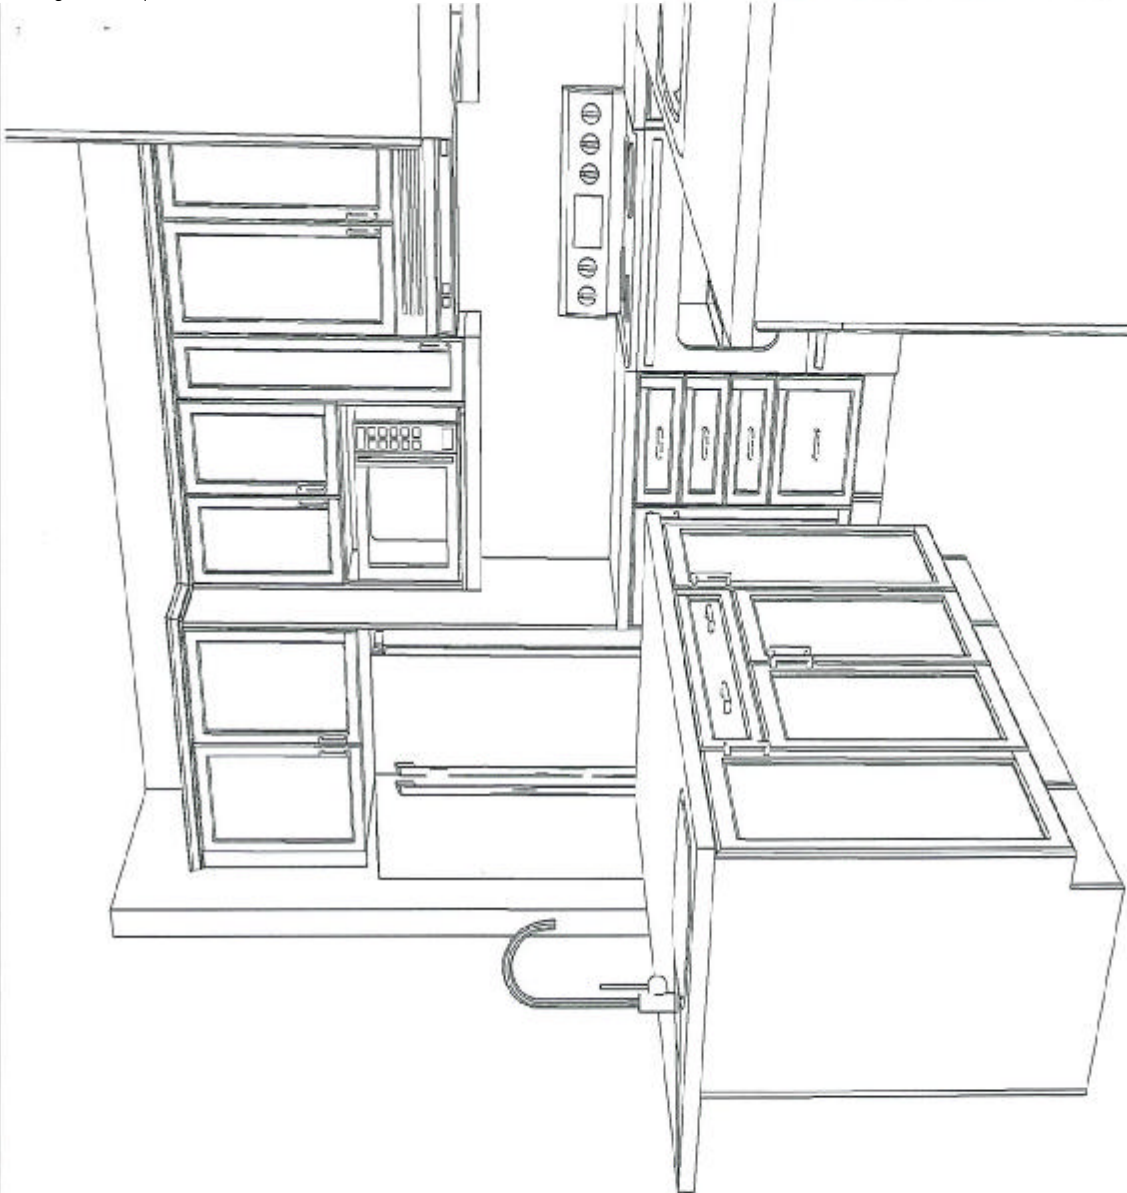

Designed: 2020-11-15
Printed: 2020-11-15



Note: This drawing is an artistic interpretation of the general appearance of the design. It is not meant to be an exact rendition.

SPECTRUM KITCHEN and BATH DESIGN

DCR #116 Pathways - 43-4 Winchester - RIGHT .kit All Drawing #: 1


CUSTOMER APPROVAL

I have reviewed these drawings and understand the details of the design and the CARTIER KITCHENS specifications.

Signature _____

Date _____

DS
RH

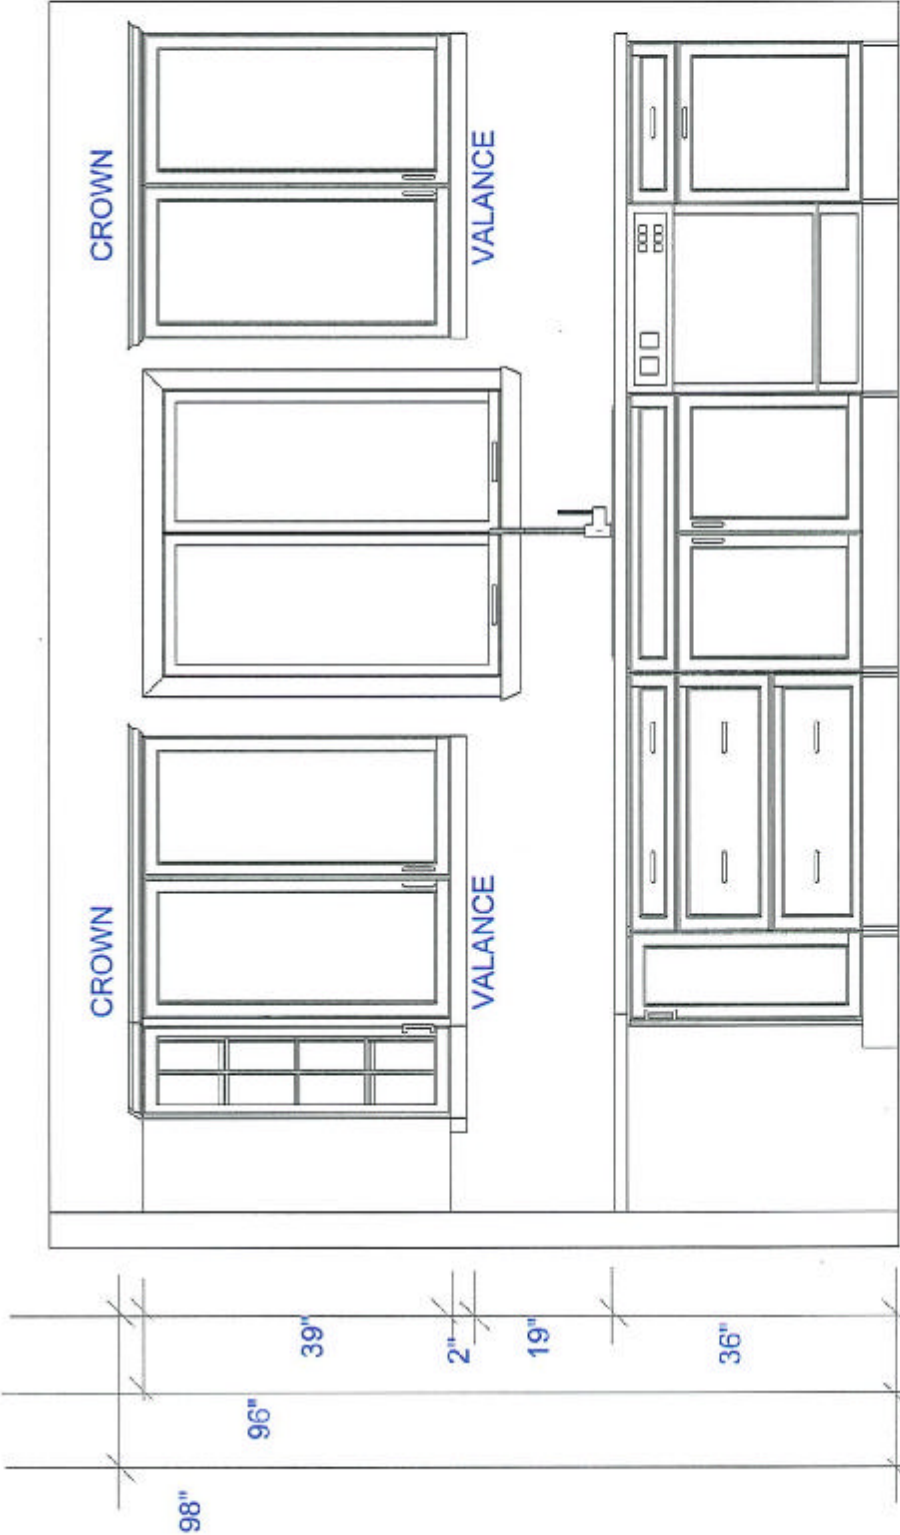

SINK WALL ELEVATION

CUSTOMER APPROVAL

I have reviewed these drawings and understand the details of the design and the CARTIER KITCHENS specifications.

Signature _____

Date _____

Note: This drawing is an artistic interpretation of the general appearance of the design. It is not meant to be an exact rendition.




SPECTRUM KITCHEN and BATH DESIGN

DCR #116 Pathways - 43-4 Winchester - RIGHT .kit

All

Drawing #: 1

Designed: 2020-11-15
Printed: 2020-11-15

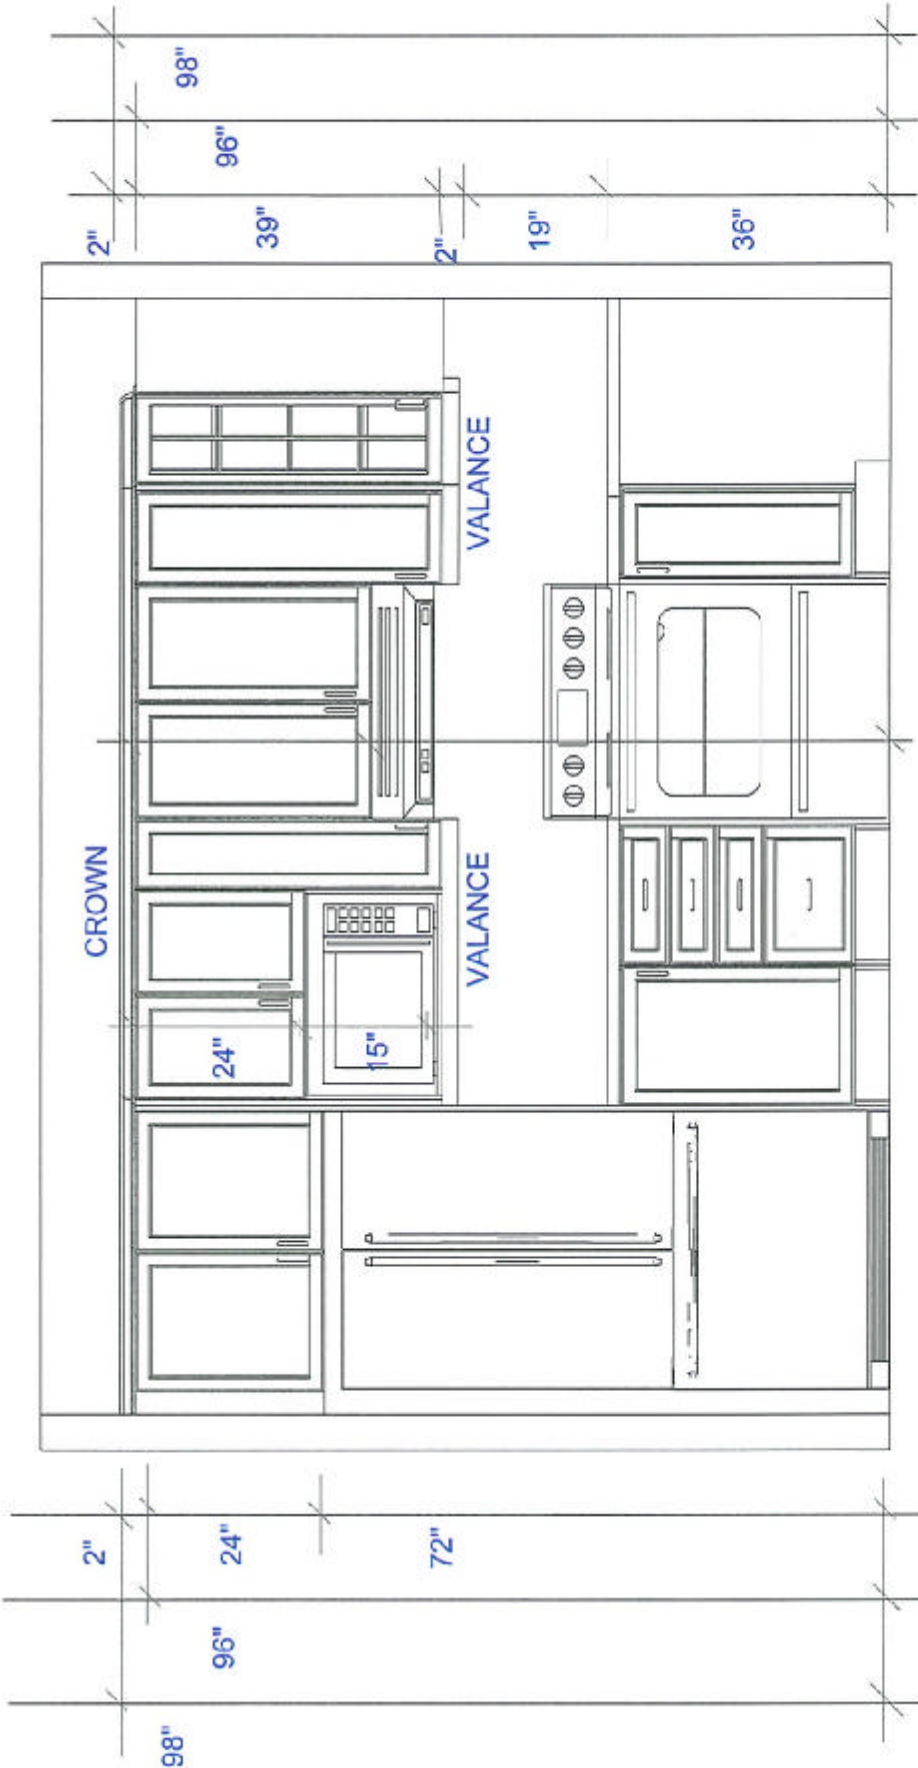

FRIDGE / RANGE WALL ELEVATION

CUSTOMER APPROVAL


I have reviewed these drawings and understand the details of the design and the CARTIER KITCHENS specifications.

Signature _____


Date _____

Note: This drawing is an artistic interpretation of the general appearance of the design. It is not meant to be an exact rendition.		Designed: 2020-11-15 Printed: 2020-11-15	
SPECTRUM KITCHEN and BATH DESIGN		All	Drawing #: 1
DCR #116 Pathways - 43-4 Winchester - RIGHT .kit			


DS
RH

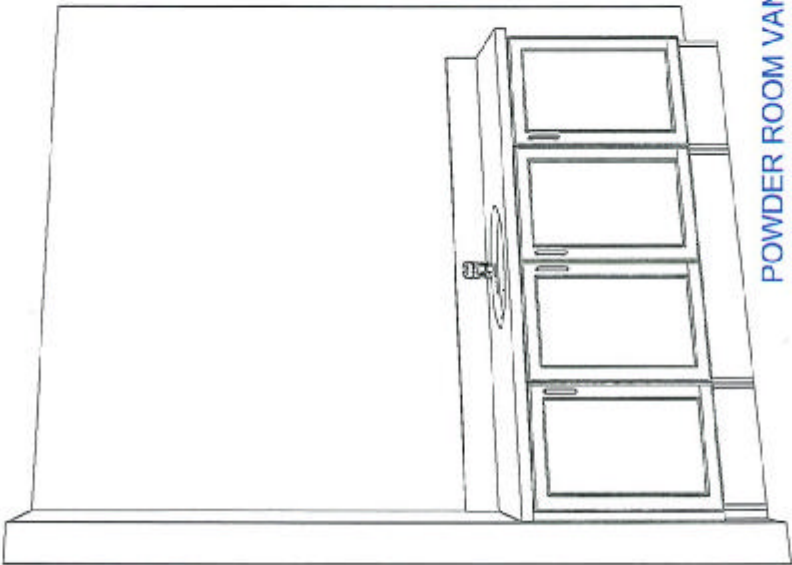

POWDER ROOM VANITY

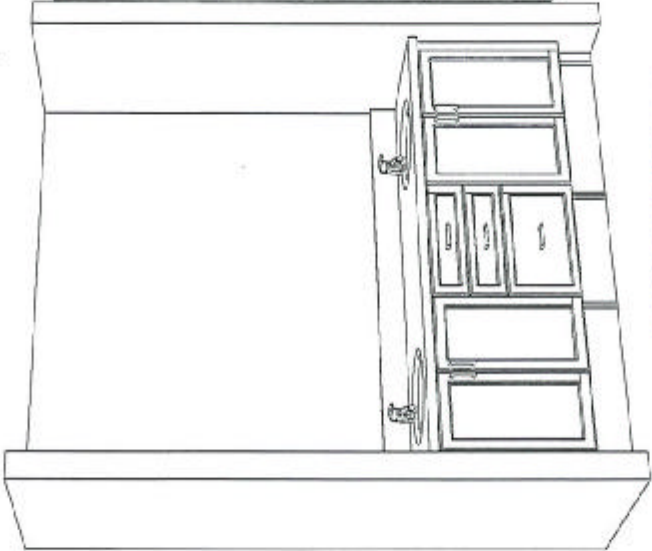

MAIN BATH VANITY

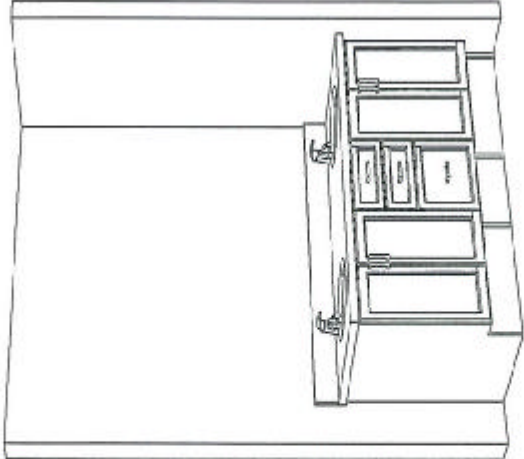

ENSUITE VANITY

CUSTOMER APPROVAL

I have reviewed these drawings and understand the details of the design and the CARTIER KITCHENS specifications.

Signature _____

Date _____

Note: This drawing is an artistic interpretation of the general appearance of the design. It is not meant to be an exact rendition.



SPECTRUM KITCHEN and BATH
DESIGN

DCR #1116 Pathways - 43-4 Winchester - RIGHT .kit

All

Drawing #: 1

Designed: 2020-11-15
Printed: 2020-11-15