

DCR PHOENIX HOMES

LOT #32

WHITE TAIL RIDGE

MODEL - RUTHERFORD (517)

ALTERNATE KITCHEN - MODIFIED

MOUNTING HEIGHT - 96

- CABINETS-
HARDWARE -
STANDARD WHITE INTERIOR
METAL DRAWER BOX
4 PCS - 5/8" KICK - FIN. BOTH ENDS
1 PCS - 90 DEG. CORNER MOULD
1 PCS - T-MOULD
5 PCS - FLAT MOULD

42"H UPPERS @ 18" ABOVE COUNTER
PLUS FILLER TO BULKHEAD & CEILING CROWN
BULKHEAD = 14"D @ 101" A.F.F.
LIGHT VALANCE - 2"H PLAIN RECESSED

CUSTOMER APPROVAL


I have reviewed these drawings and understand the details of the design and the CARTIER KITCHENS specifications.

Signature

Date

REVISED: DEC 9-20




1.5" SPACE BESIDE HOODFAN (IF POSSIBLE)

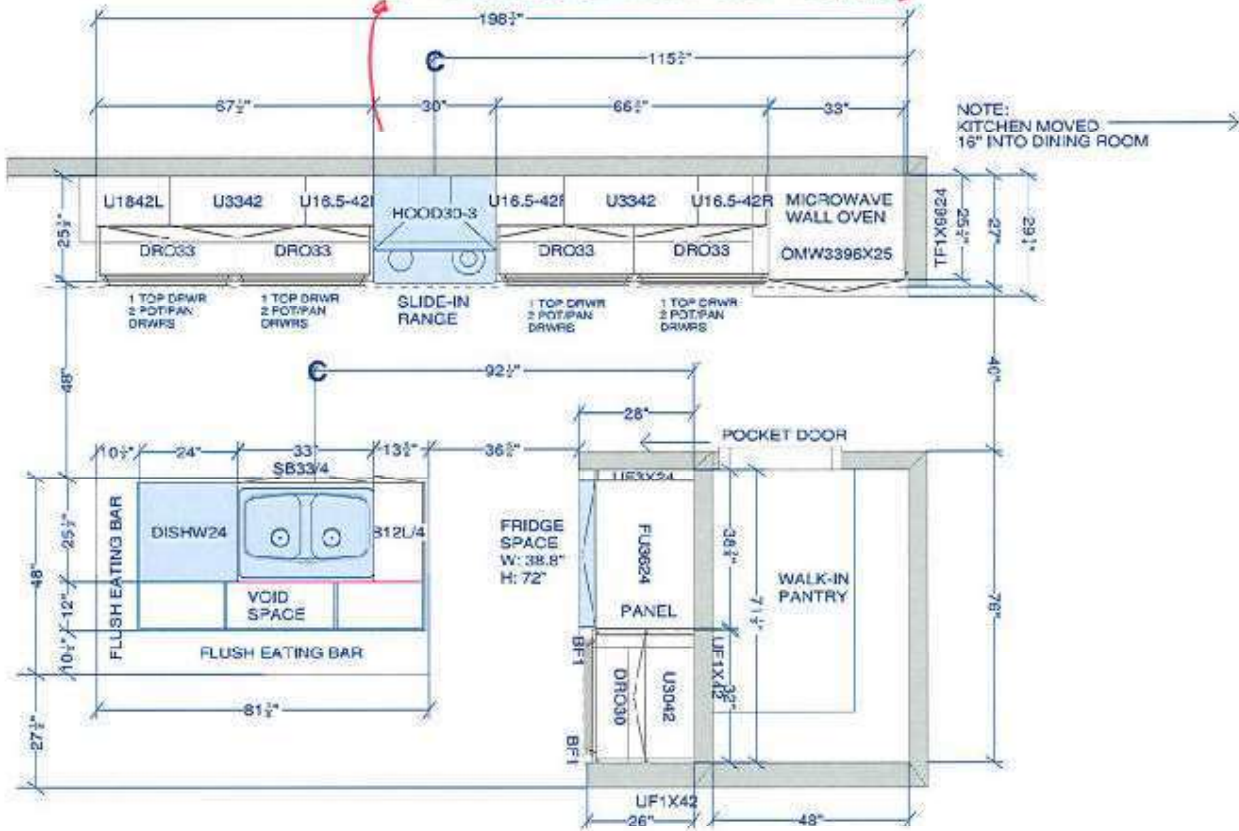

All dimensions, size designations given are subject to verification on job site and adjustment to fit job conditions.		This is an original design and must not be released or copied unless applicable fee has been paid or job order placed.	Designed: 2020-12-07 Printed: 2020-12-09
SPECTRUM KITCHEN and BATH DESIGN		DRAWN BY: LORI DISAVERIO, B.I.D.	DS al
DCR #32 WTR - R1 - 517 Rutherford ALT Kitchen.kit		All	DS RL
		Drawing # 1	No Scale

DS
al

DS
KL

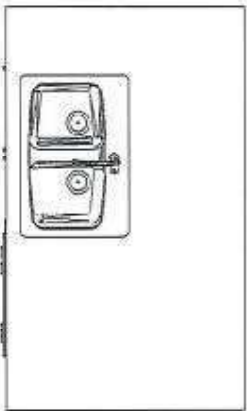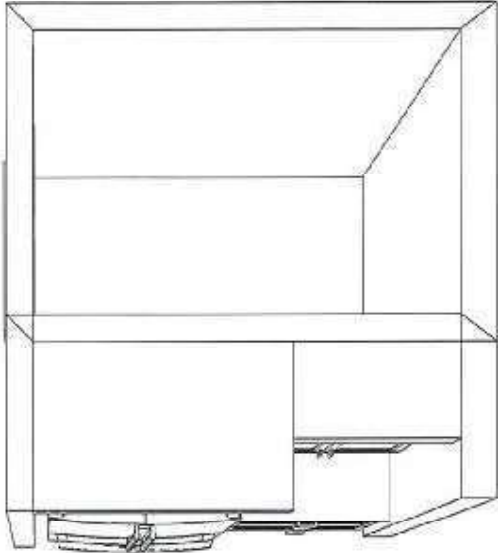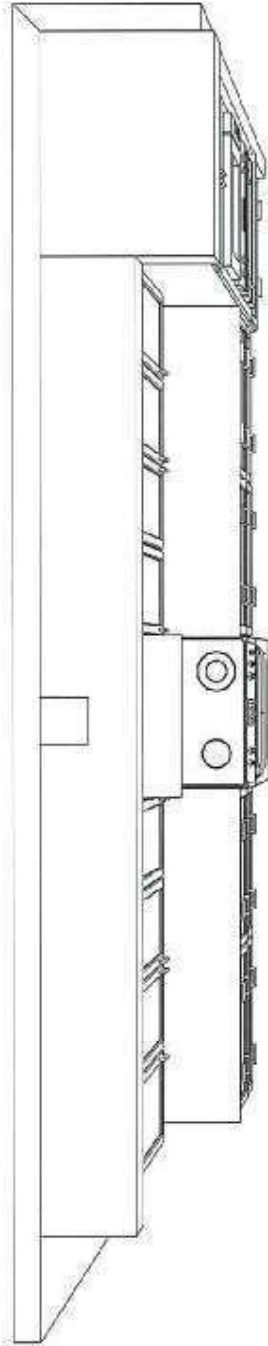

KITCHEN - TOP VIEW

REVISED: DEC 9-20

CUSTOMER APPROVAL

I have reviewed these drawings and understand the details of the design and the CARTIER KITCHENS specifications.

Signature _____

Date _____

Note: This drawing is an artistic interpretation of the general appearance of the design. It is not meant to be an exact rendition.

SPECTRUM
DESIGN

SPECTRUM KITCHEN and BATH
DCR #32 WTR - R! - 517 Rutherford ALT Kitchen.kit

Designed: 2020-12-07
Printed: 2020-12-09


Drawing # 1

DS

AL

DS

RL

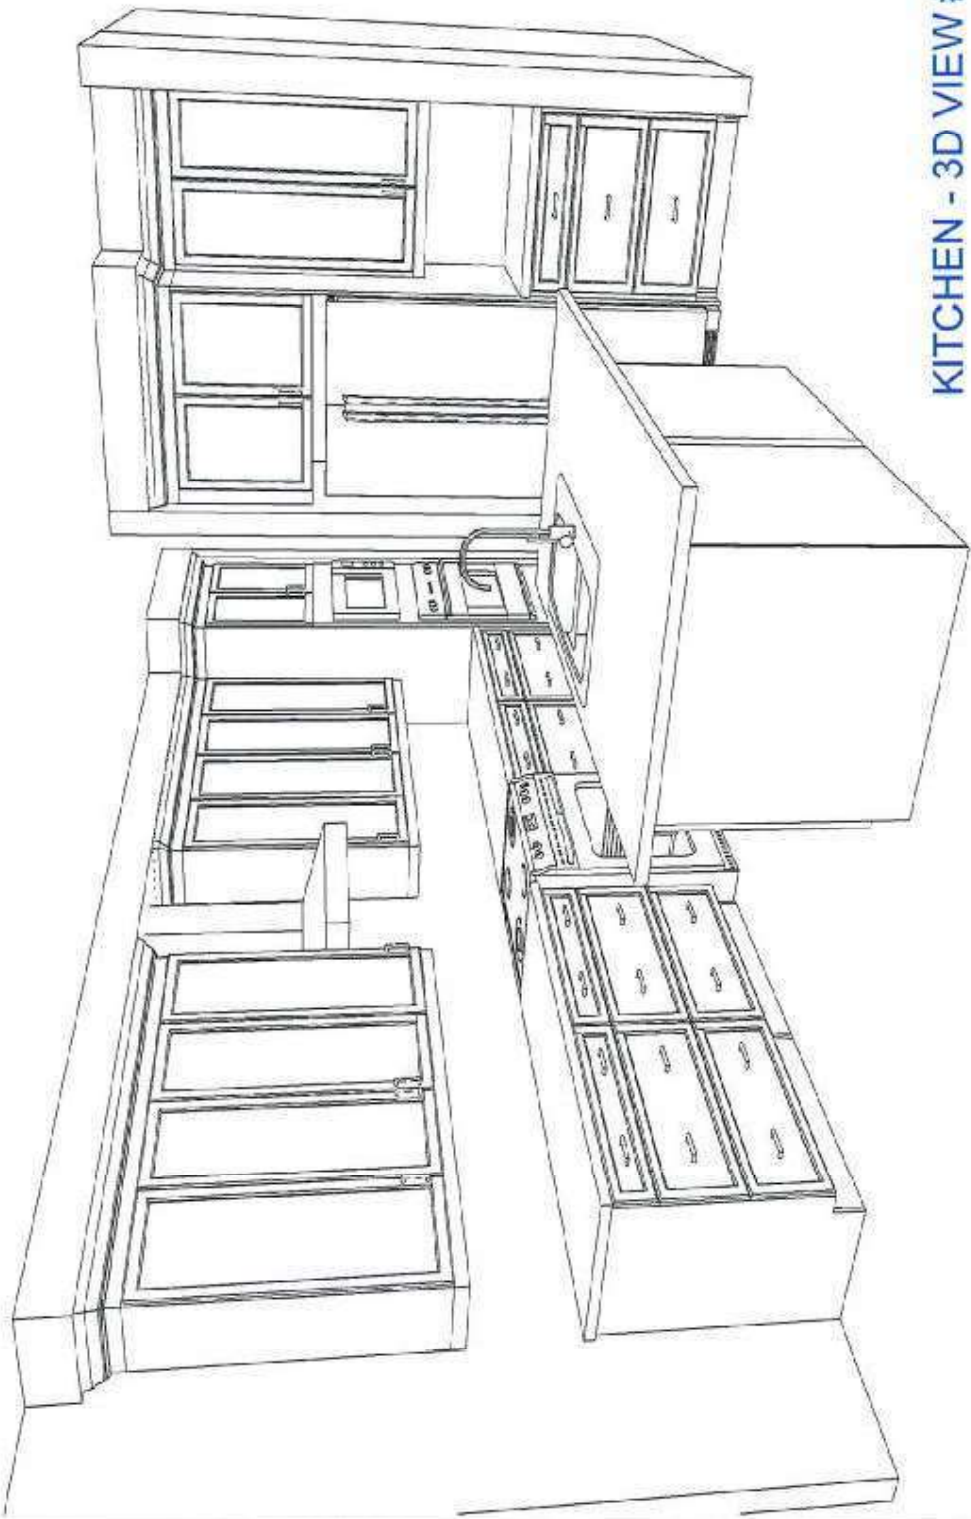

KITCHEN - 3D VIEW #1

REVISED: DEC 9-20

CUSTOMER APPROVAL

I have reviewed these drawings and understand the details of the design and the CARTIER KITCHENS specifications.

Signature _____

Date _____

Note: This drawing is an artistic interpretation of the general appearance of the design. It is not meant to be an exact rendition.

SPECTRUM KITCHEN and BATH DESIGN

DCR #32 WTR - R! - 517 Rutherford ALT Kitchen.kit

DESIGNED: 2020-12-07
PRINTED: 2020-12-07

All

Drawing #: 1

DS
al

DS
KL



KITCHEN - 3D VIEW #2

REVISED: DEC 9-20


CUSTOMER APPROVAL

I have reviewed these drawings and understand the details of the design and the CARTIER KITCHENS specifications.

Signature _____

Date _____

Note: This drawing is an artistic interpretation of the general appearance of the design. It is not meant to be an exact rendition.			Designed: 2020-12-07 Printed: 2020-12-09	
SPECTRUM KITCHEN and BATH DESIGN			All	
DCR #32 WTR - R! - 517 Rutherford ALT Kitchen.kit		All	Drawing #: 1	

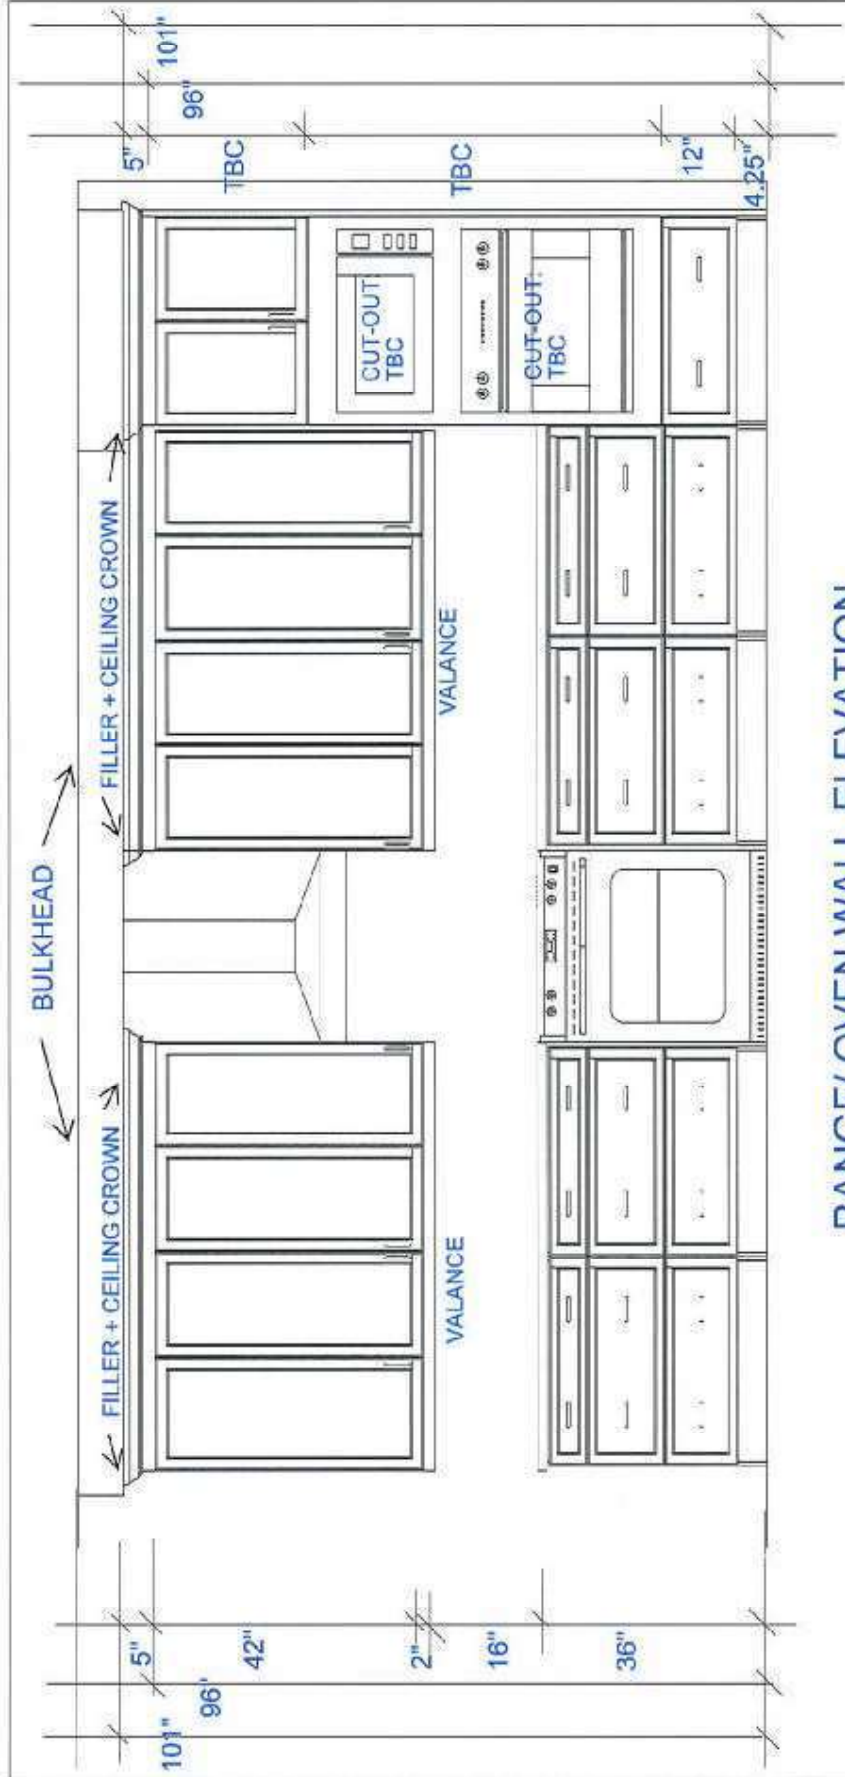

RANGE/ OVEN WALL ELEVATION

REVISED: DEC 9-20

CUSTOMER APPROVAL

I have reviewed these drawings and understand the details of the design and the CARTIER KITCHENS specifications.

Signature

Date

Note: This drawing is an artistic interpretation of the general appearance of the design. It is not meant to be an exact rendition.

SPECTRUM KITCHEN and BATH DESIGN

DCR #32 WTR - R! - 517 Rutherford ALT Kitchen.kit

All

Drawing #: 1




Designed: 2020-12-07
Printed: 2020-12-09

DS
AC

DS
RC

DS
AC

DS
KL

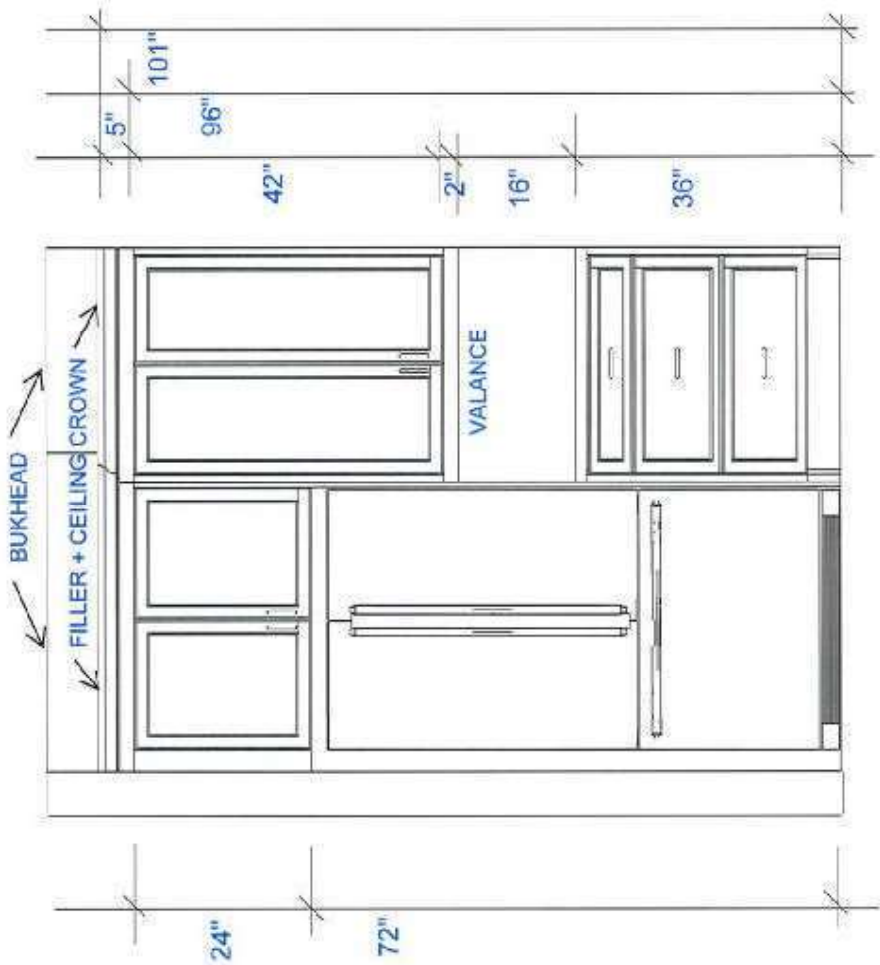

FRIDGE WALL ELEVATION

REVISED: DEC 9-20

CUSTOMER APPROVAL

I have reviewed these drawings and understand the details of the design and the CARTIER KITCHENS specifications

Signature: _____


Date: _____

Note: This drawing is an artistic interpretation of the general appearance of the design. It is not meant to be an exact rendition. SPECTRUM KITCHEN and BATH DESIGN DCR #32 WTR - R1 - 517 Rutherford ALT Kitchen.kit		Designed: 2020-12-07 Printed: 2020-12-09	Drawing #: 1


DCR PHOENIX HOMES

LOT #32
WHITE TAIL RIDGE
MODEL - RUTHERFORD (517)
VANITIES / LAUNDRY
MOUNTING HEIGHT - 84


CABINETS -
HARDWARE -
STANDARD WHITE INTERIOR
METAL DRAWER BOX
4 PCS - 5/8" KICK - FIN, BOTH ENDS
5 PCS - FLAT SHOE MOULD

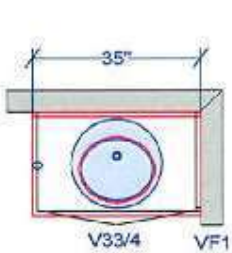


POWDER ROOM

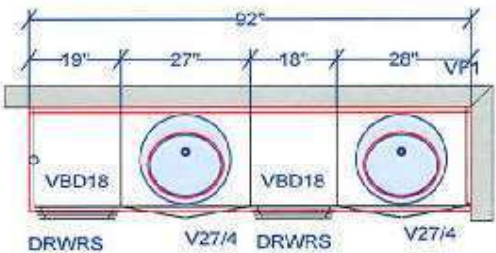


ENSUITE 1

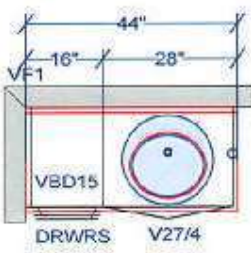

ENSUITE 2

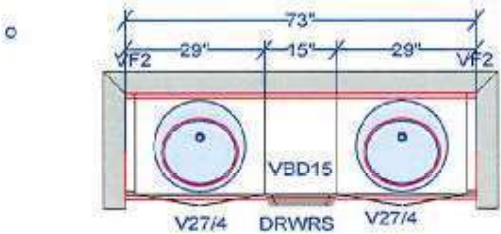

ENSUITE 3

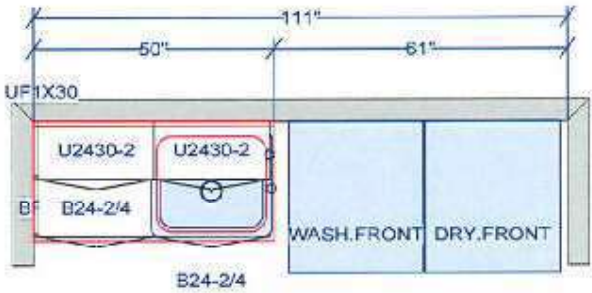

LAUNDRY ROOM

CUSTOMER APPROVAL

I have read and understand the drawings and the details of the design and the Client's specifications.

Signature _____
Date _____

All dimensions and size designations given are subject to verification on job site and adjustment to fit job conditions.



This is an original design and must not be released or copied unless applicable fee has been paid or job order placed.

Designed: 11/25/2020
Printed: 11/25/2020

DS DS
AC RC

DCR #32 WTR - Rutherford Vanities + Laundry


All

Drawing #: 1


No Scale

DS
al


DS
RL

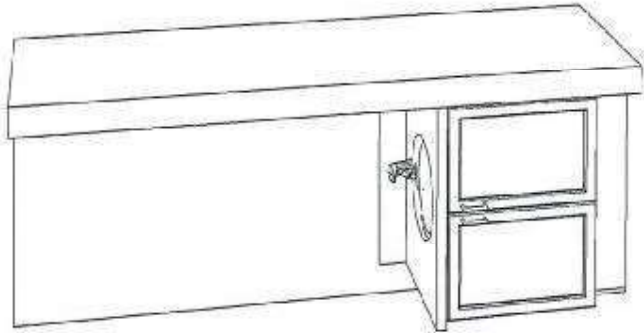

POWDER ROOM

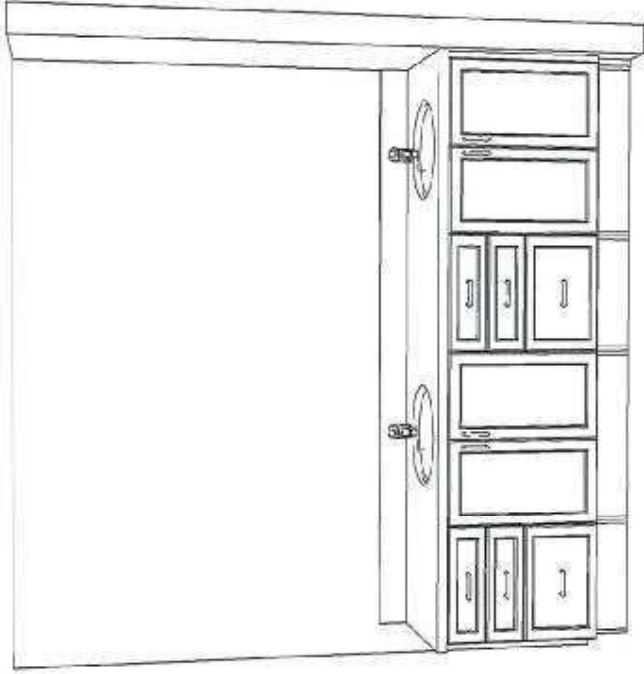

ENSUITE 1

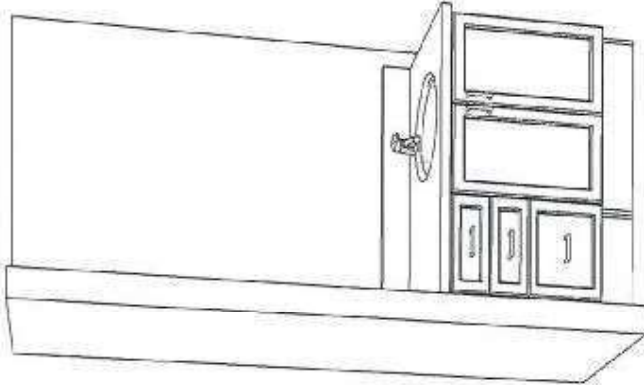

ENSUITE 2

CUSTOMER APPROVAL

I have reviewed these drawings and understand the details of the design and the Contractor's specifications.

Signature _____

Date _____

Note: This drawing is an artistic interpretation of the general appearance of the design. It is not meant to be an exact rendition.

DCR #32 WTR - Rutherford Vanities + Laundry



Designed: 11/25/2020
Printed: 11/25/2020


Drawing #: 1

DS


al

DS

RL

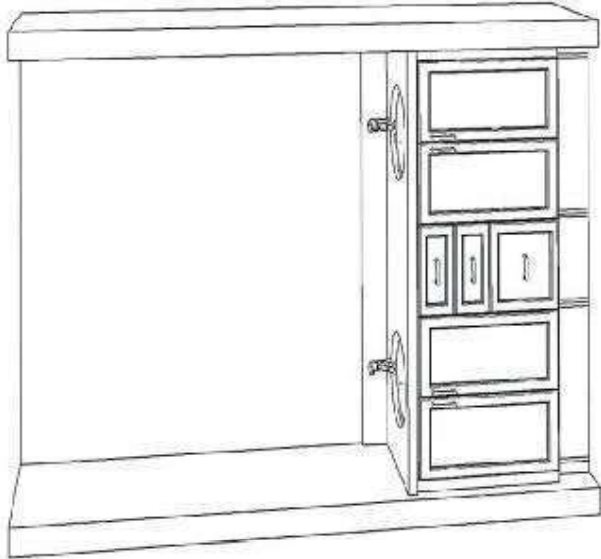

ENSUITE 3

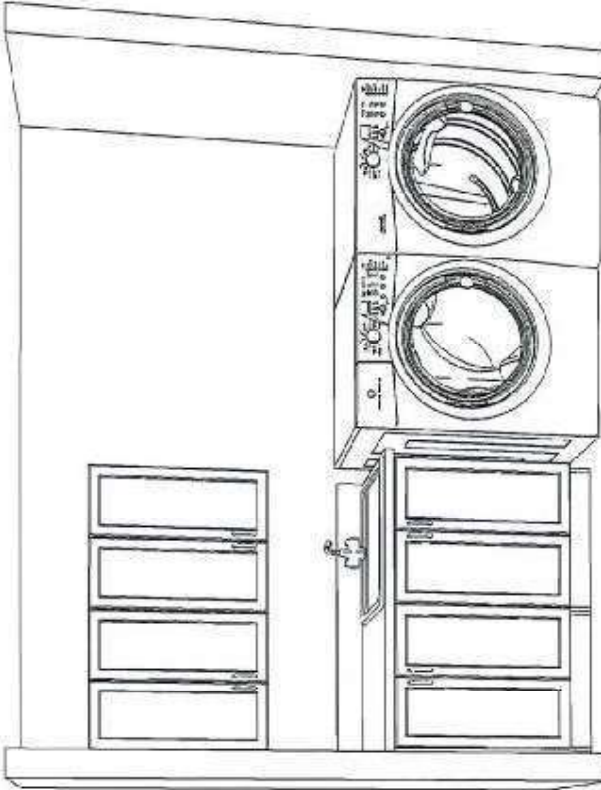

LAUNDRY ROOM

CUSTOMER APPROVAL

Have reviewed these drawings and understand the details of the design and the Contractor's specification.

Signature _____

Date _____

Note: This drawing is an artistic interpretation of the general appearance of the design. It is not meant to be an exact rendition.		Designed: 11/25/2020 Printed: 11/25/2020	
		DCR #32 WTR - Rutherford Vanities Laundry	All
		Drawing #: 1	