


Drawing #: 1	No Scale.
--------------	-----------

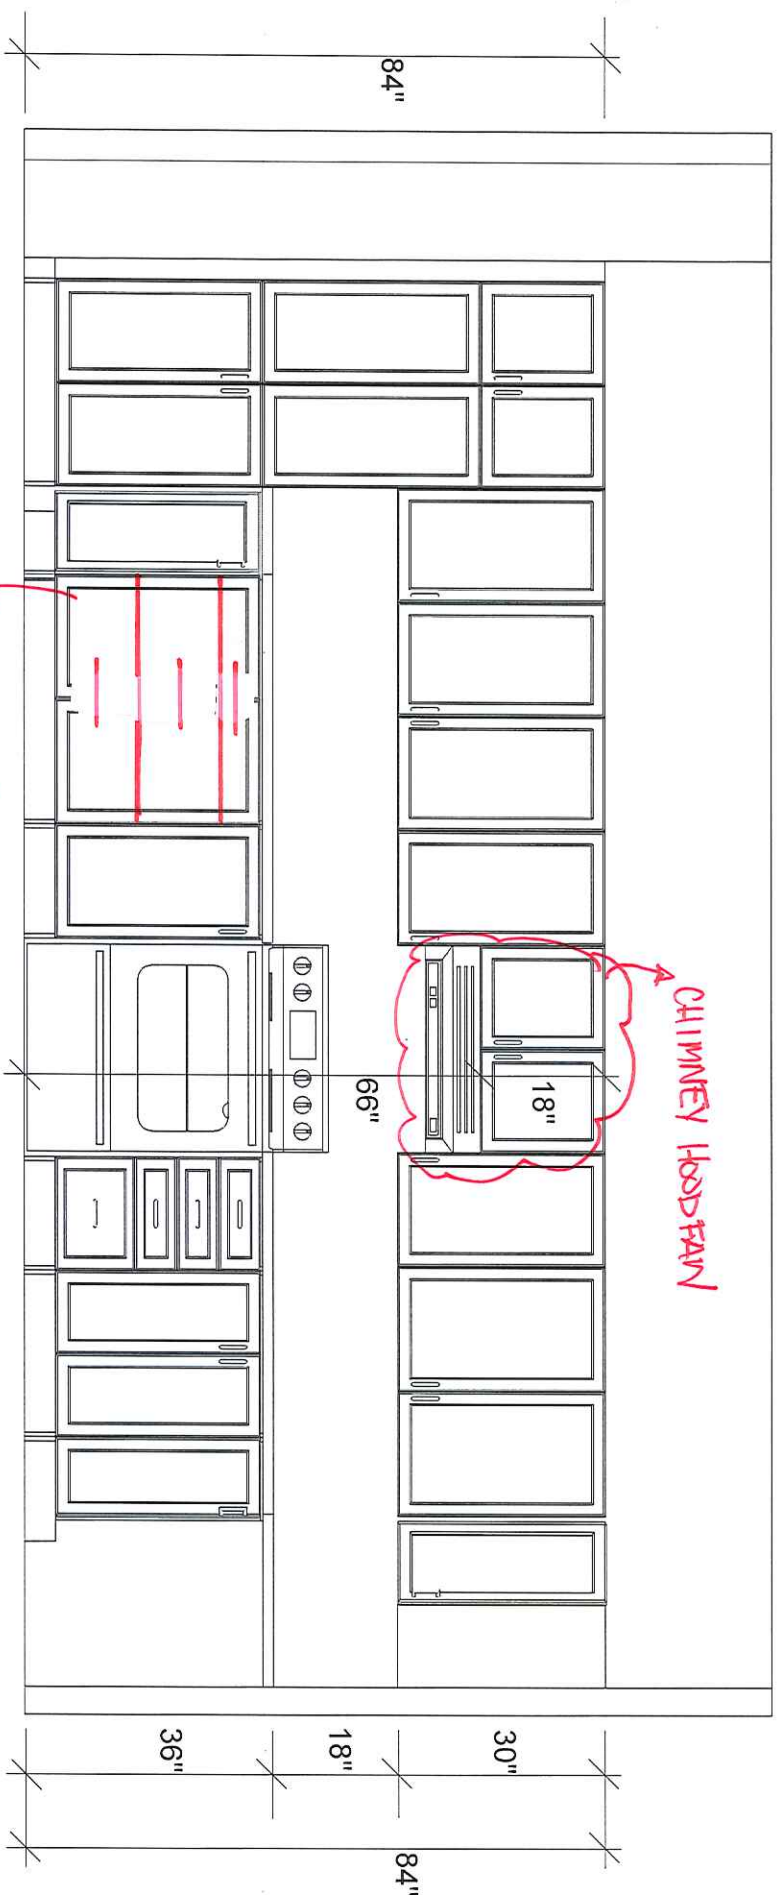

RANGE WALL ELEVATION

Note: This drawing is an artistic interpretation of the general appearance of the design. It is not meant to be an exact rendition.




Designed: 10/7/2020
Printed: 10/7/2020

DCR - ROSEMERE - CHEF'S KITCHEN

All

Drawing #: 1

PW-PA 2-LOT 315

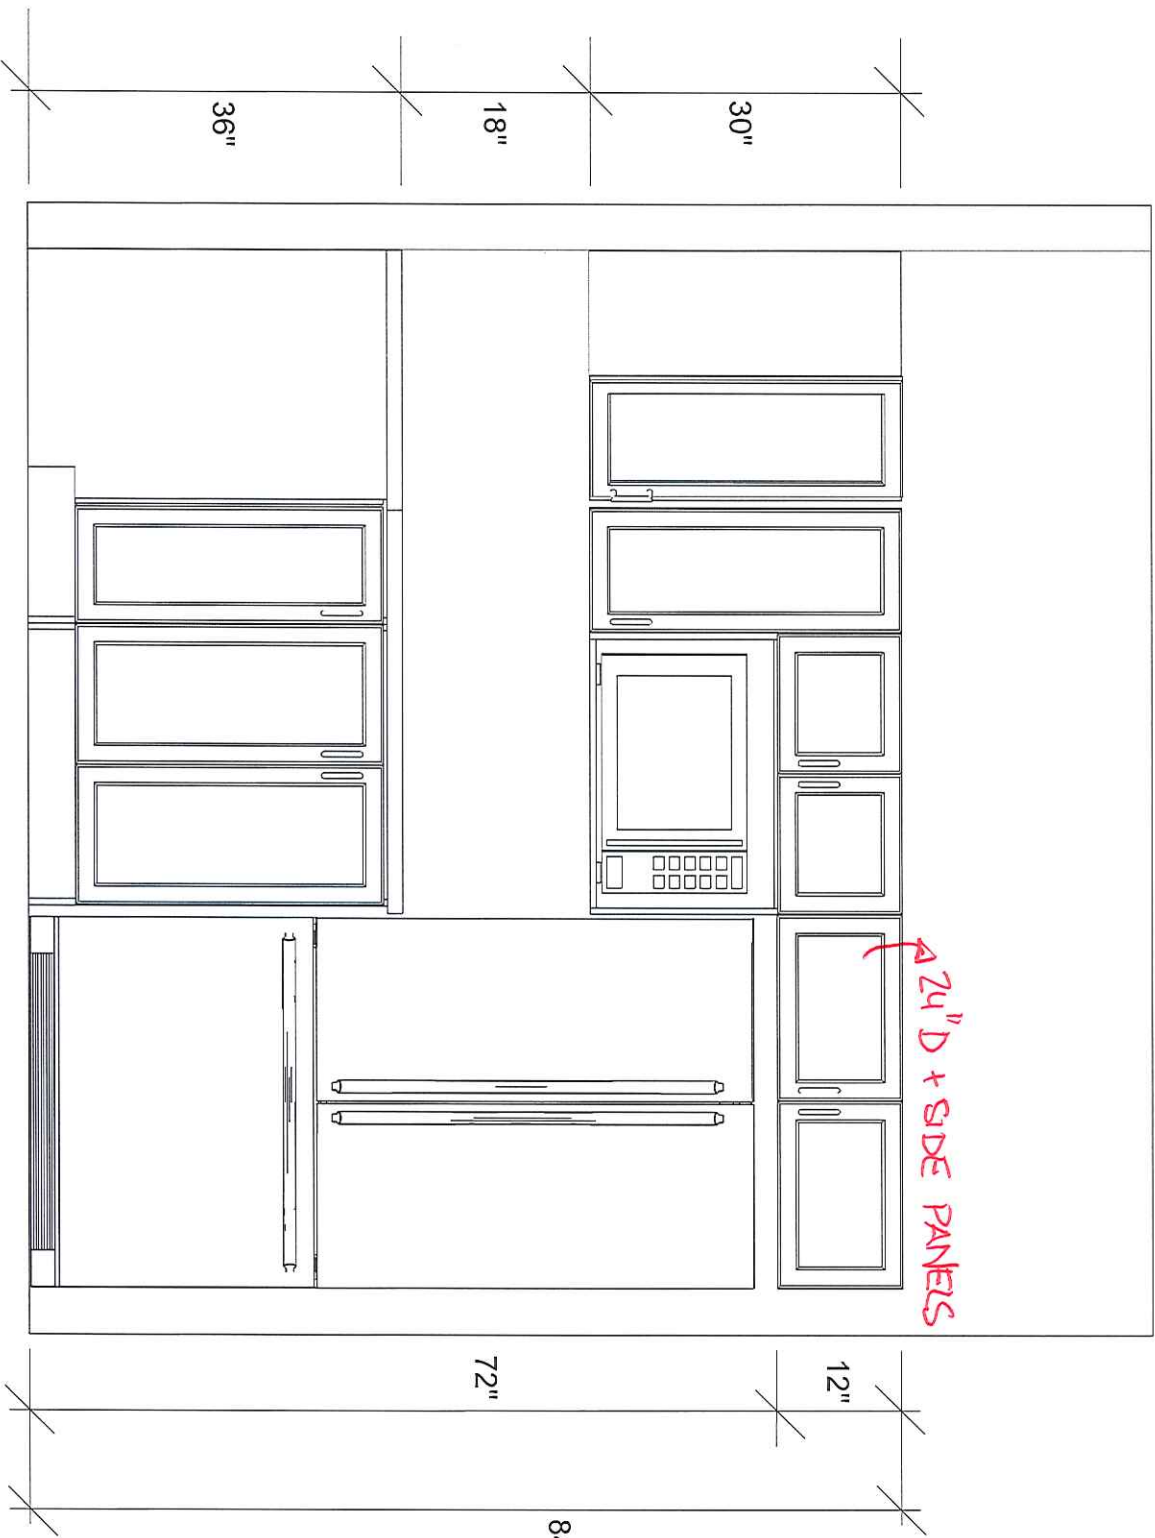

FRIDGE WALL ELEVATION

Note: This drawing is an artistic interpretation of the general appearance of the design. It is not meant to be an exact rendition.




Designed: 10/7/2020
Printed: 10/7/2020

DCR -ROSEMERE - CHEF'S KITCHEN

All

Drawing #: 1

PM-PH 2-LOT 315

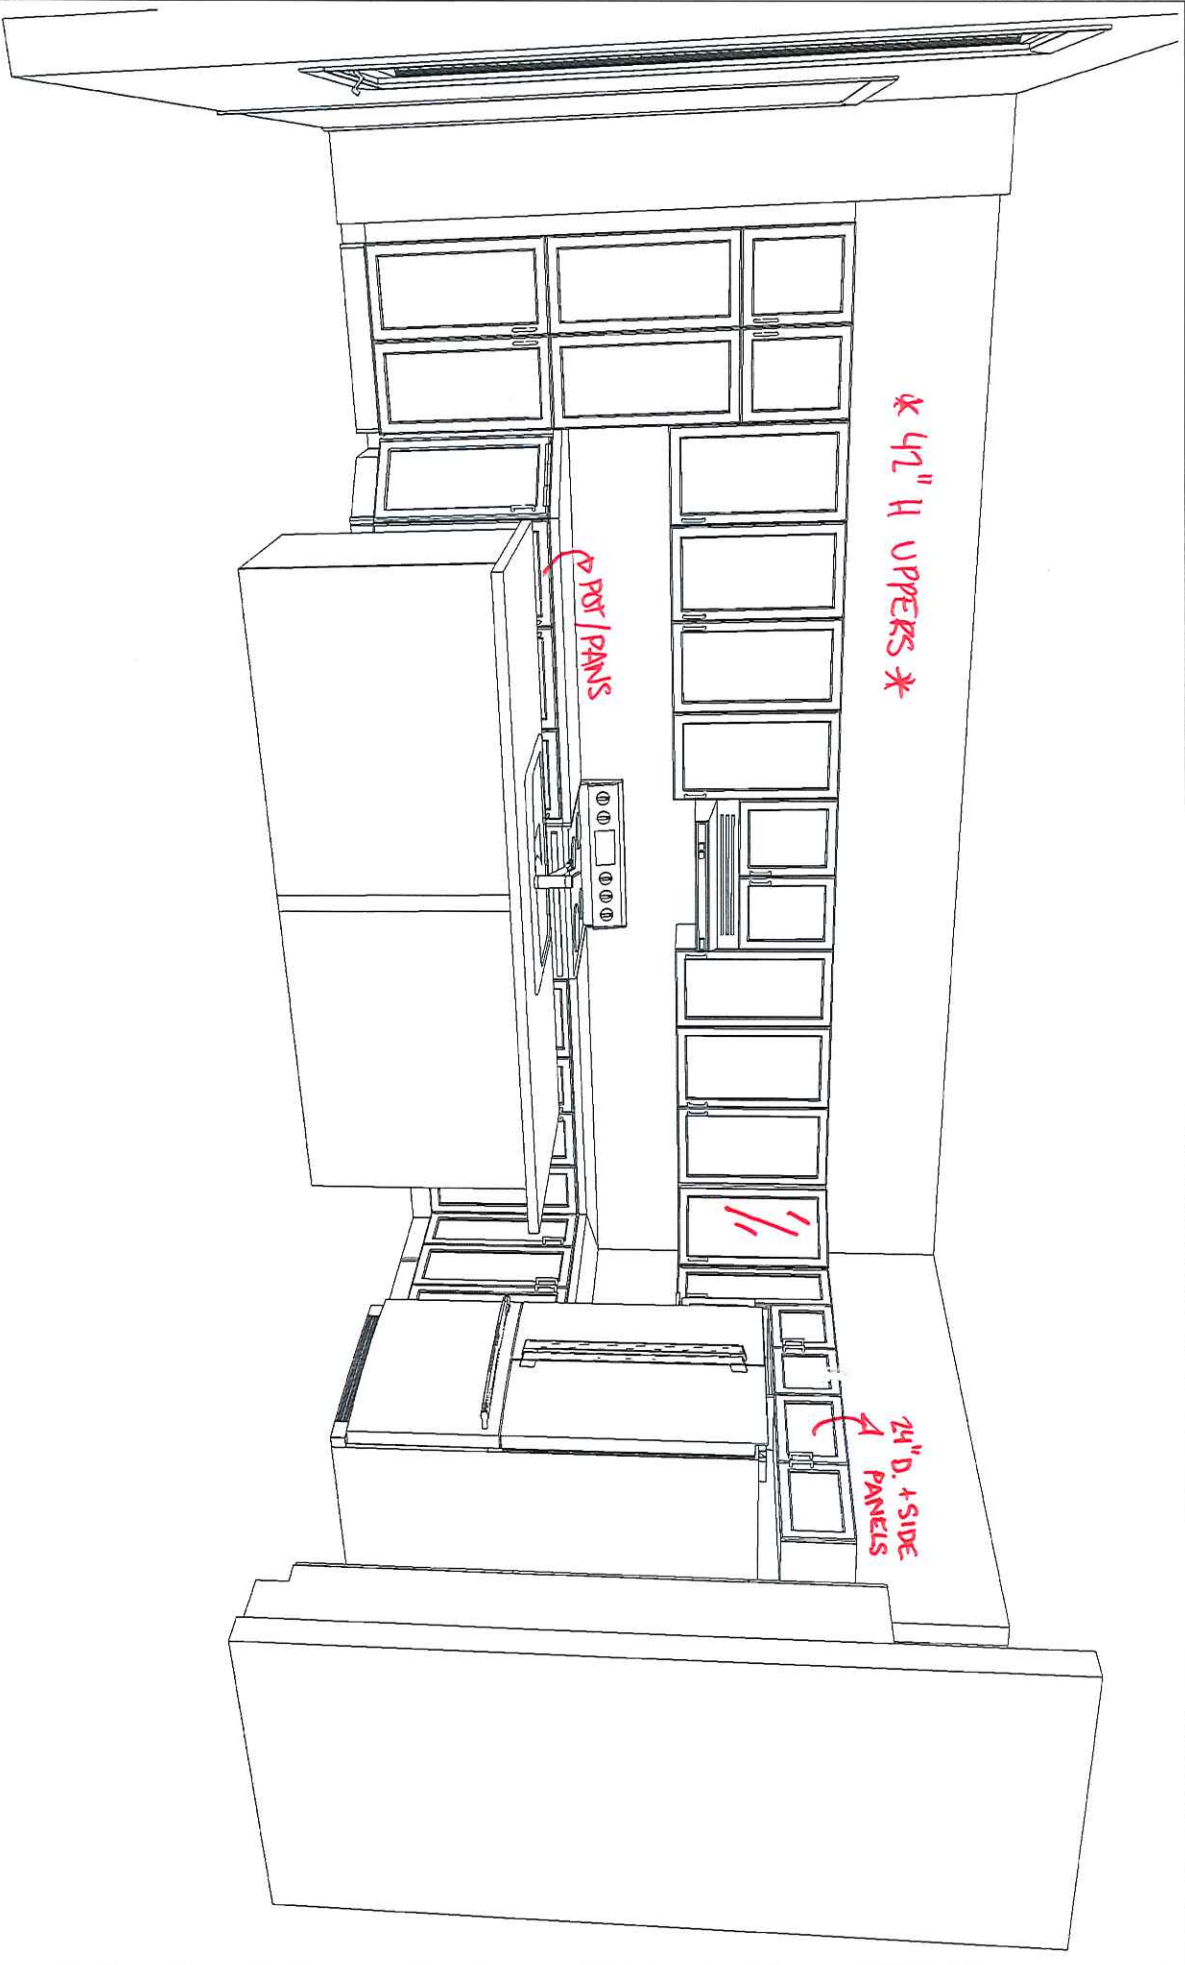


KITCHEN - 3D VIEW #1

Note: This drawing is an artistic interpretation of the general appearance of the design. It is not meant to be an exact rendition.



Designed: 10/7/2020
Printed: 10/7/2020

PM-P42-Lot 315

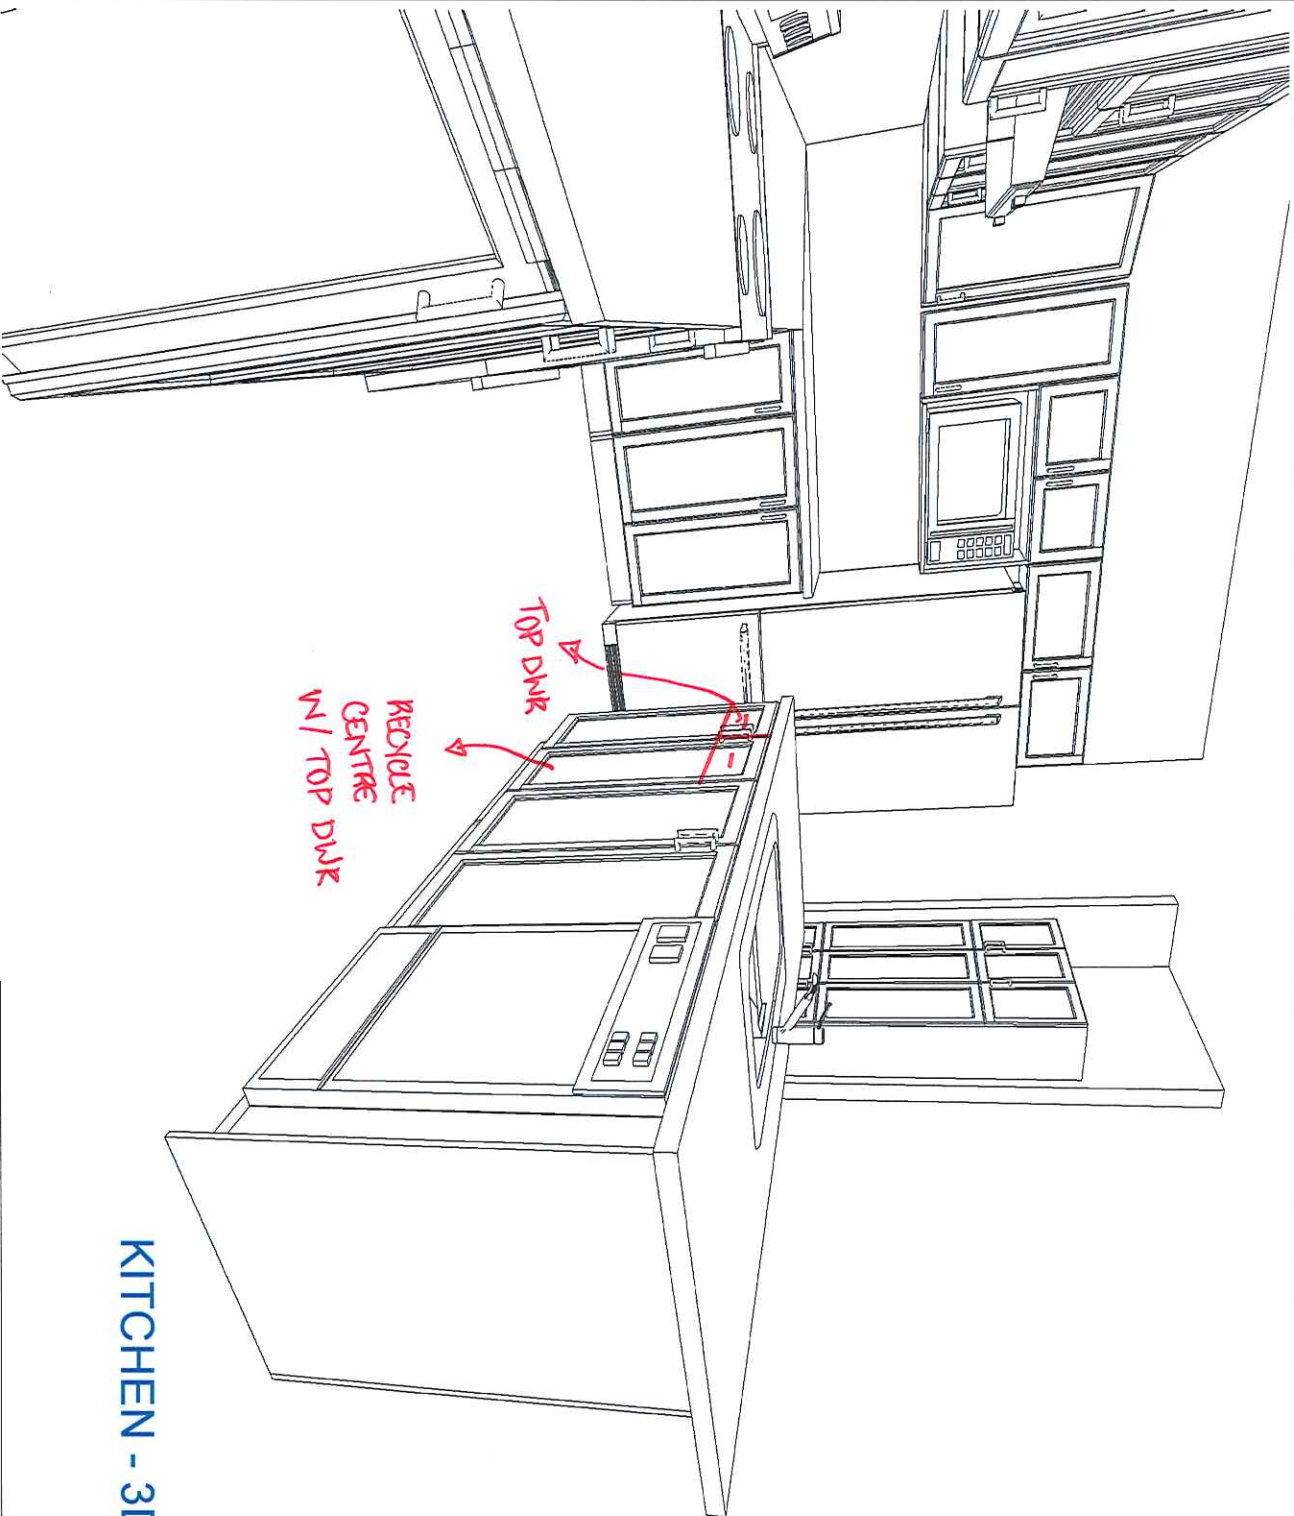

KITCHEN - 3D VIEW #2

Note: This drawing is an artistic interpretation of the general appearance of the design. It is not meant to be an exact rendition.



Designed: 2020-10-06
Printed: 2020-10-09

SPECTRUM KITCHEN and BATH


DESIGN

DCR - ROSEMERIE - CHEF'S KITCHEN.kit

All

Drawing #: 1

PN-PA 2 - LOT 315

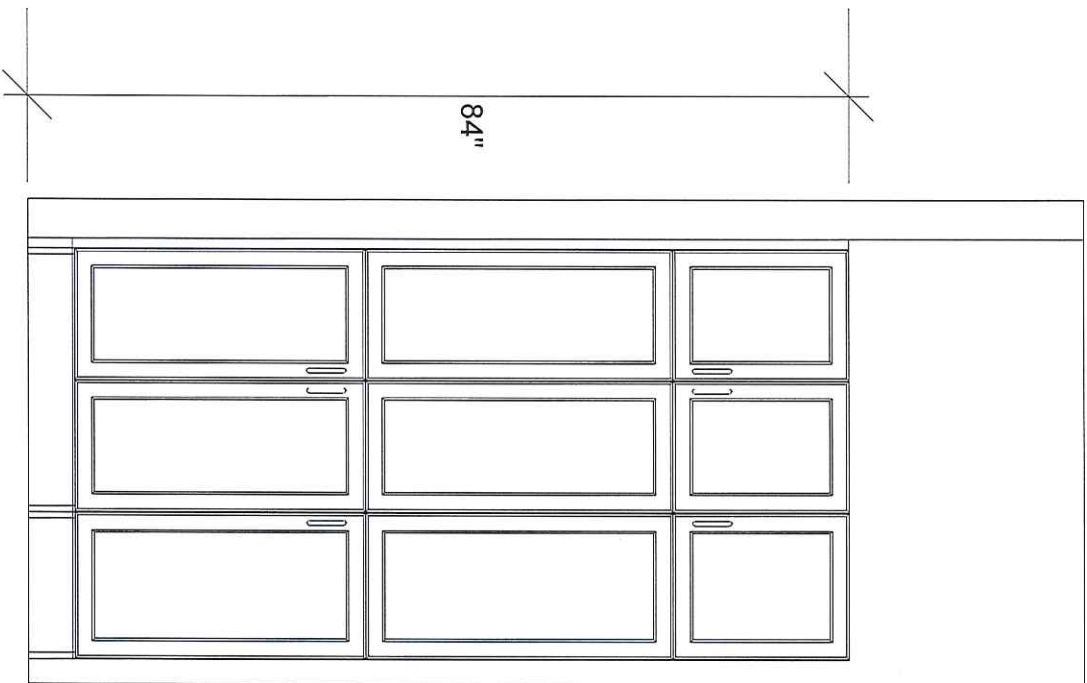

PANTRY WALL ELEVATION

Note: This drawing is an artistic interpretation of the general appearance of the design. It is not meant to be an exact rendition.



Designed: 10/7/2020
Printed: 10/7/2020

DCR -ROSEMERE - CHEF'S KITCHEN

All

Drawing #: 1

PM-PH2-LST 315

* PATHWAYS - PHASE 2 - LOT 315 *

DCR PHOENIX HOMES

C10 - ROSEMERE (LEFT)

VANITIES

LINE -
DOOR STYLE -
SPECIES -
COLOUR -


HARDWARE -

KICK: 1-PCS.


STANDARD WHITE INTERIOR

METAL DRWR BOXES


* ALL DIMENSIONS & LAYOUTS ARE
SUBJECT TO CHANGE WITHOUT NOTICE *

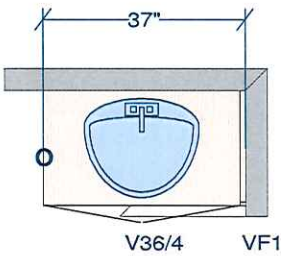

POWDER

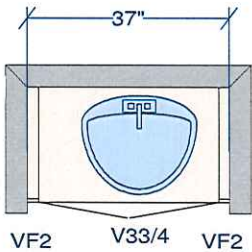

MAIN

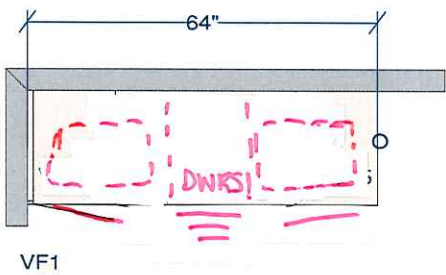

ENSUITE

* DOUBLE SINKS - B.O.D MOVE TO CENTRE *

All dimensions & size designations given are subject to verification on job site and adjustment to fit job conditions.

Cartier Kitchens Ottawa



This is an original design and must not be released or copied unless applicable fee has been paid or job order placed.

Drawn by: Lori Di Saverio, B.I.D.
Cartier Kitchens Ottawa

Designed: 17/07/2013
Printed: 24/08/2014

DCR - C10 - ROSEMERE - VANIITES- LEFT.kit

All

Drawing #: 1 | No Scale.