


DCR PHOENIX HOMES

LOT #6
DIAMONDVIEW ESTATES 2
CHESAPEAKE (508) Left
KITCHEN
MOUNTING HT: 96

42"H. UPPERS @ 18" ABOVE COUNTER
CROWN MOUDLING
LIGHT VALANCE

- CABINETS -
HARDWARE -
STD WHITE INTERIORS
METAL DRWR BOX
5 PCS - 5/8" KICK
6 PCS - FLAT MOULDING
2 PCS - C MOULD
1 PC - T MOULD

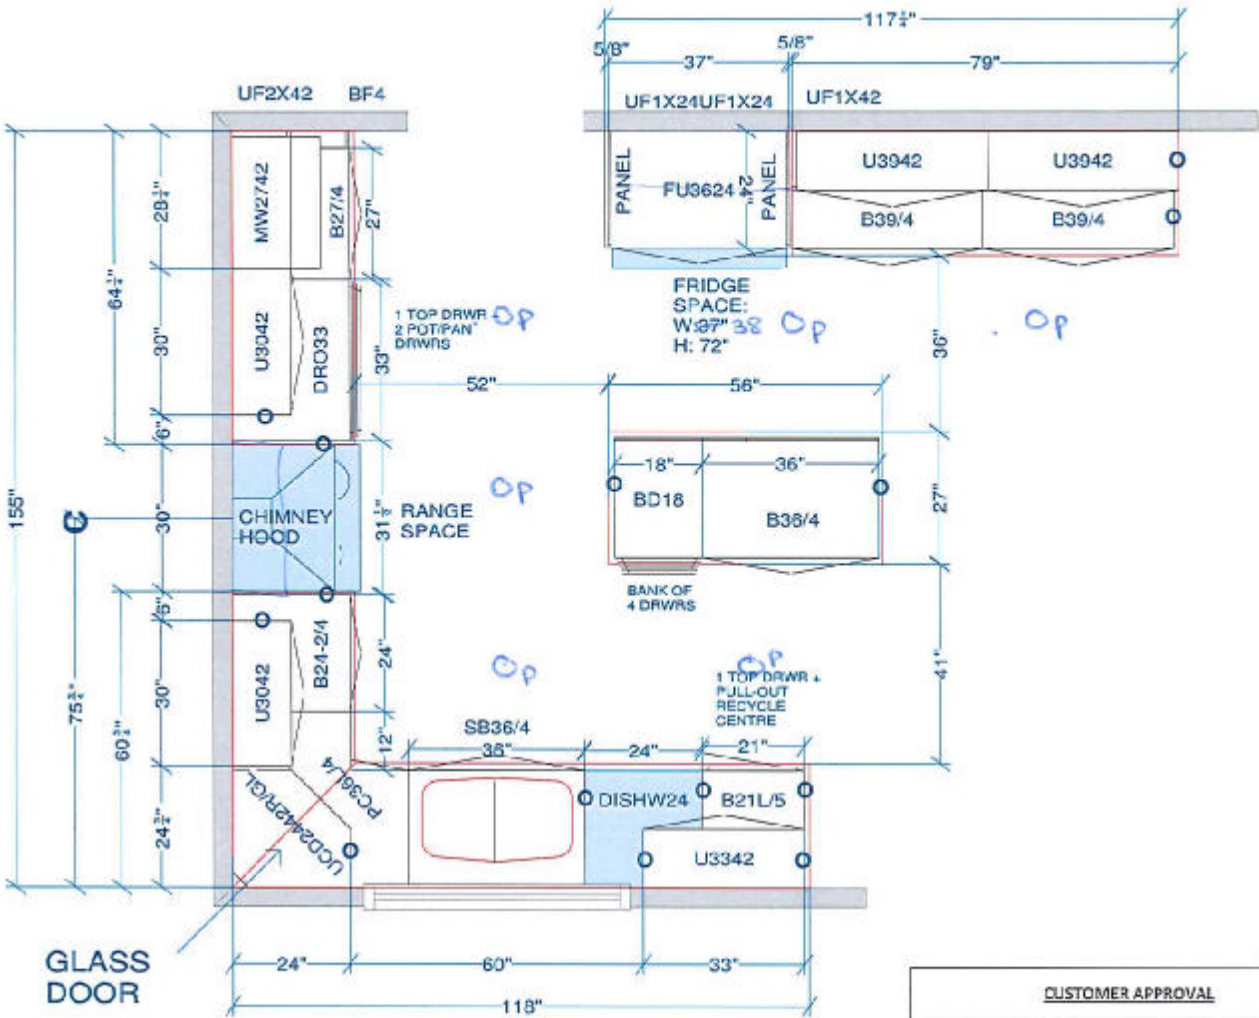


CUSTOMER APPROVAL

I have reviewed these drawings and understand the details of the design and the CARTIER KITCHENS specifications.


Signature _____

Date _____

All dimensions, size designations given are subject to verification on job site and adjustment to fit job conditions.		This is an original design and must not be released or copied unless applicable fee has been paid or job order placed.	Designed: 2021-05-19 Printed: 2021-05-19
		DRAWN BY: LORI DISAVERIO, B.I.D.	
SPECTRUM KITCHEN and BATH DESIGN			
DCR #6 Diamondview Estates 2 - 508 CHESAPEAKE - KITCHEN (Left).kit		All	Drawing #: 1 No Scale.

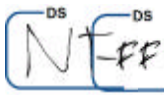

DS
N+FF
DS

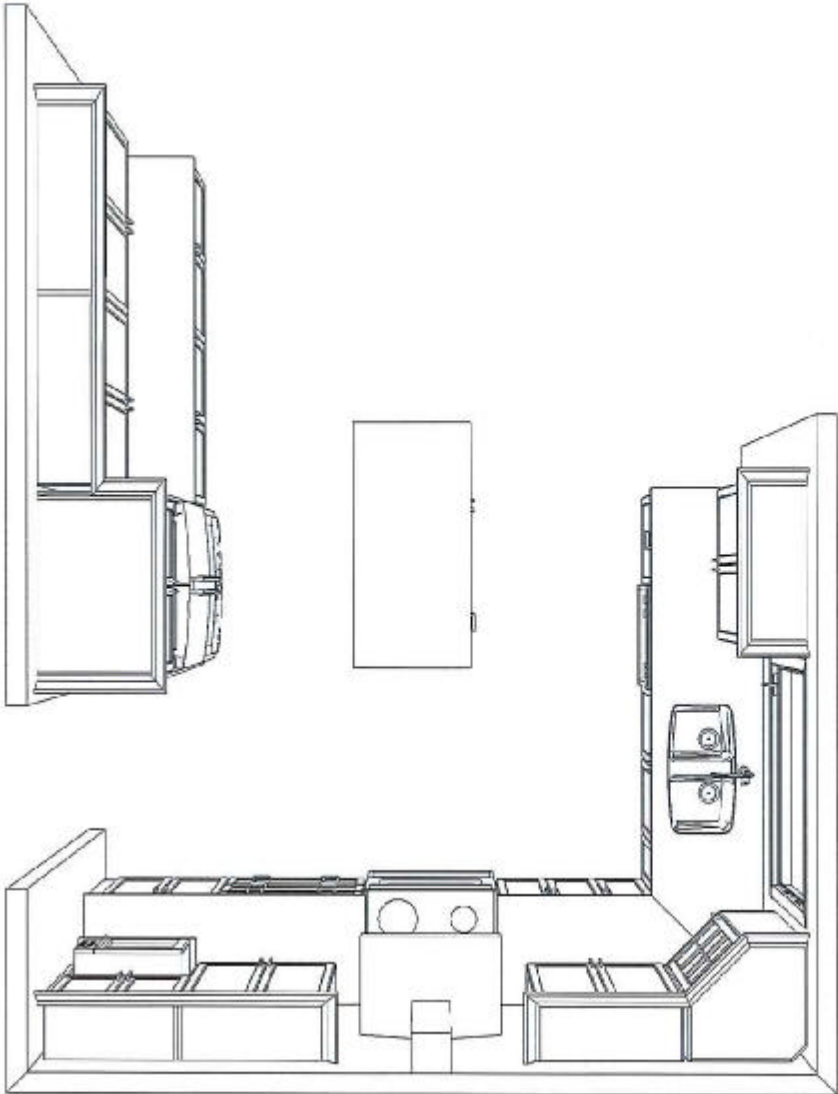

KITCHEN - TOP VIEW

CUSTOMER APPROVAL

I have reviewed these drawings and understand the details of the design and the CARTIER KITCHENS specifications.

Signature _____

Date _____

Note: This drawing is an artistic interpretation of the general appearance of the design. It is not meant to be an exact rendition.		Designed: 2021-05-19 Printed: 2021-05-19	
SPECTRUM KITCHEN and BATH DESIGN		All	Drawing #: 1
DCR #6 Diamondview Estates 2 - 508			



KITCHEN - 3D VIEW #1

CUSTOMER APPROVAL


I have reviewed these drawings and understand the details of the design and the CARTIER KITCHENS specifications.

Signature _____

Date _____

Note: This drawing is an artistic interpretation of the general appearance of the design. It is not meant to be an exact rendition.		Designed: 2021-05-19 Printed: 2021-05-19	
SPECTRUM KITCHEN and BATH DESIGN		All	Drawing #: 1
DCR #6 Diamondview Estates 2 - 508			

DS
N+FF
DS

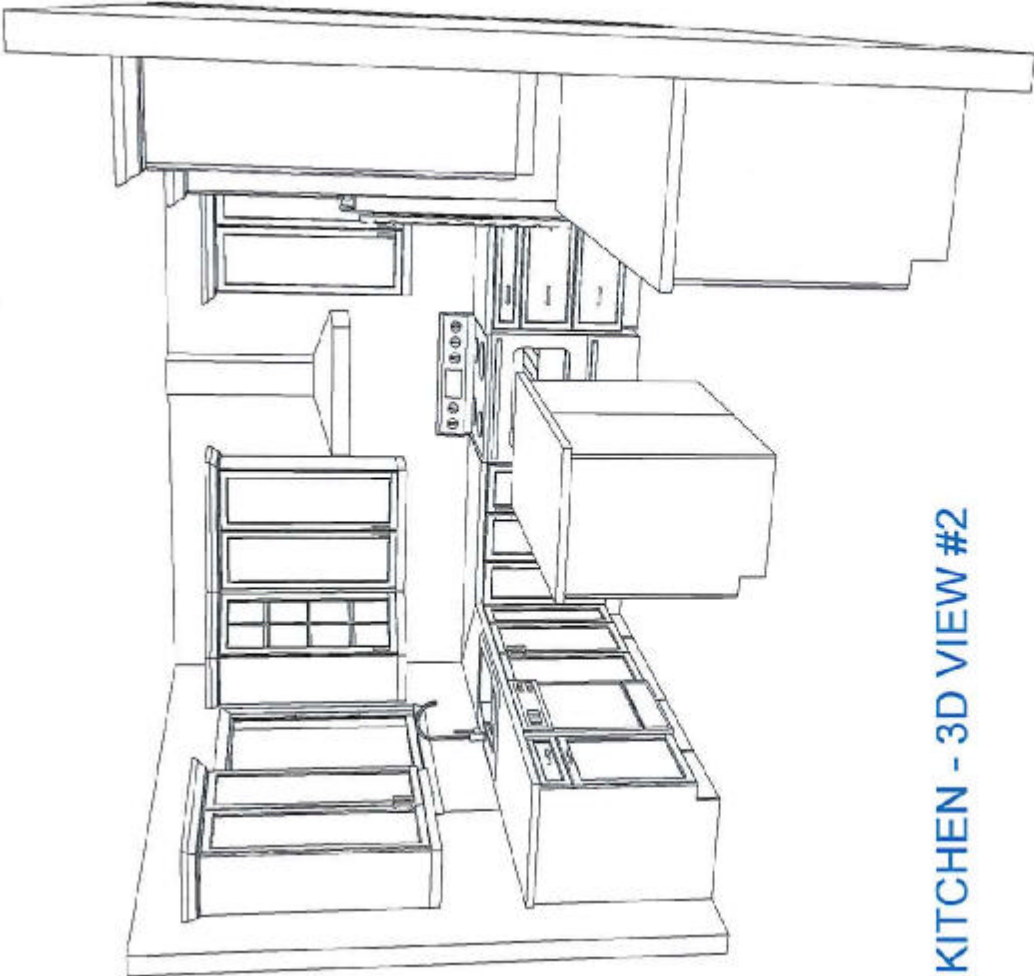

KITCHEN - 3D VIEW #2

CUSTOMER APPROVAL

I have reviewed these drawings and understand the details of the design and the CARTIER KITCHENS specifications.

Signature: _____

Date: _____

Note: This drawing is an artistic interpretation of the general appearance of the design. It is not meant to be an exact rendition.

SPECTRUM KITCHEN and BATH DESIGN


DCR #6 Diamondveiw Estates 2 - 508



Designed: 2021-05-19
Printed: 2021-05-19

All

Drawing #: 1

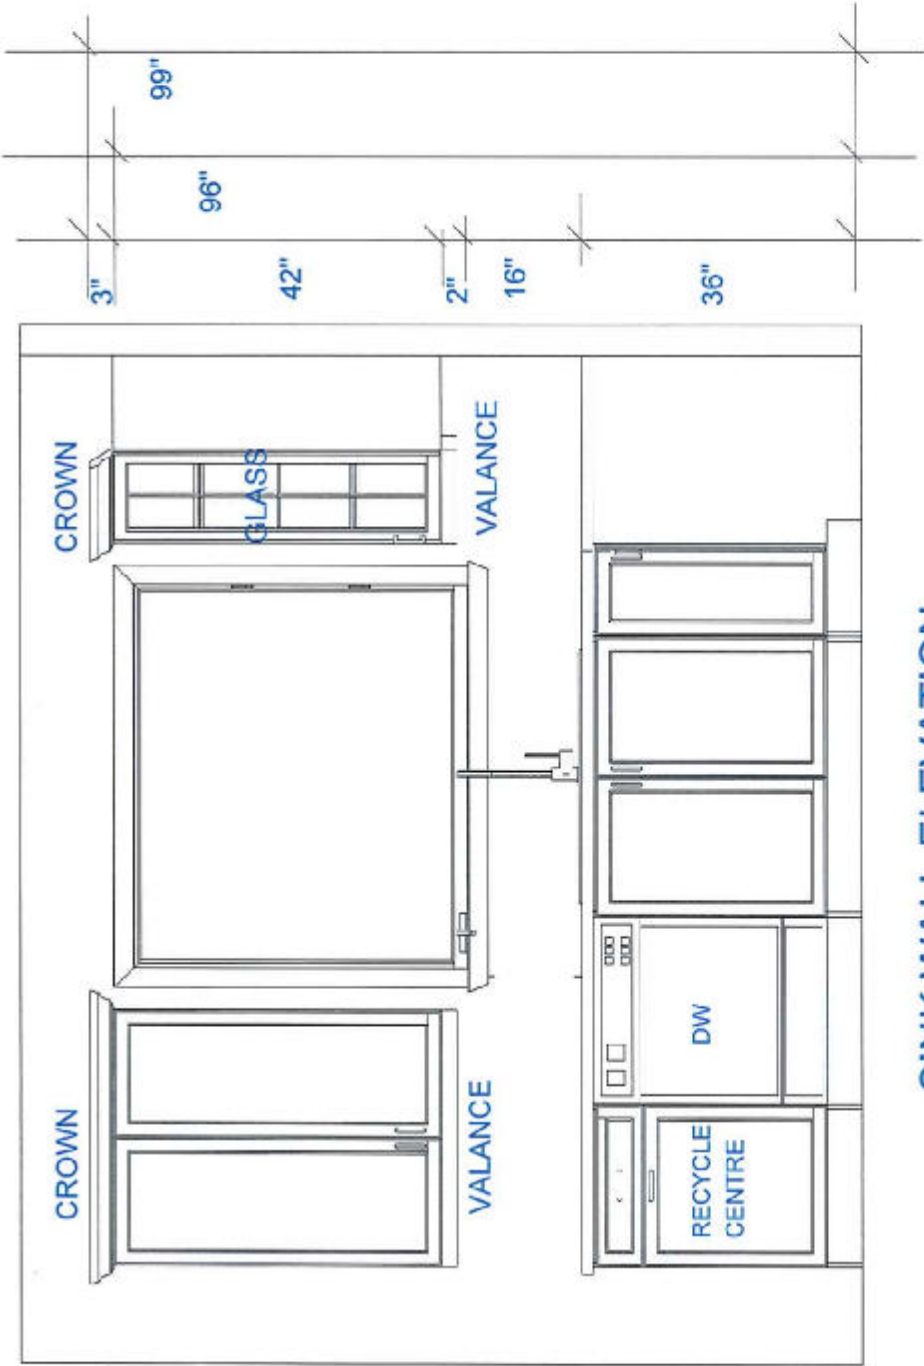

SINK WALL ELEVATION

CUSTOMER APPROVAL

I have reviewed these drawings and understand the details of the design and the CARTIER KITCHENS specifications.

Signature

Date

Note: This drawing is an artistic interpretation of the general appearance of the design. It is not meant to be an exact rendition.

SPECTRUM KITCHEN and BATH DESIGN



DCR #6 Diamondview Estates 2 - 508



Designed: 2021-05-19
Printed: 2021-05-19

All

Drawing #: 1

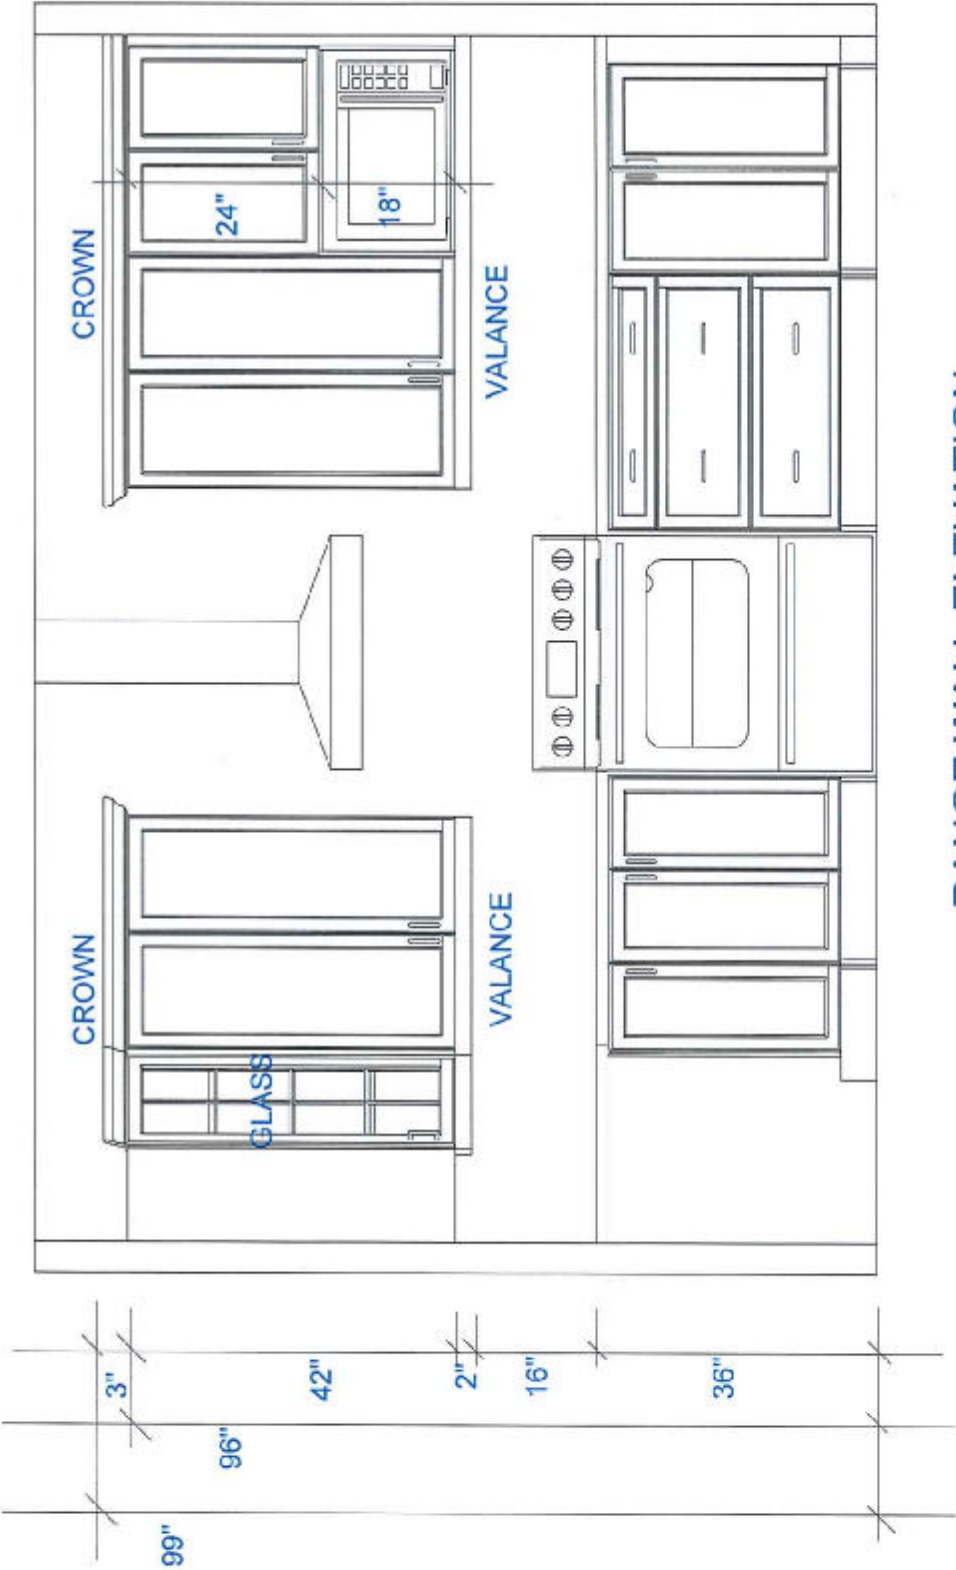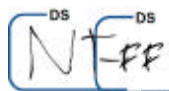

RANGE WALL ELEVATION

CUSTOMER APPROVAL

I have reviewed these drawings and understand the details of the design and the CARTIER KITCHENS specifications.

Signature _____

Date _____

Note: This drawing is an artistic interpretation of the general appearance of the design. It is not meant to be an exact rendition.

SPECTRUM KITCHEN and BATH
DESIGN


DCR #6 Diamondveiw Estates 2 - 508

III

Drawing #: 1

Designed: 2021-05-19
Printed: 2021-05-19

DS
N+FF
DS

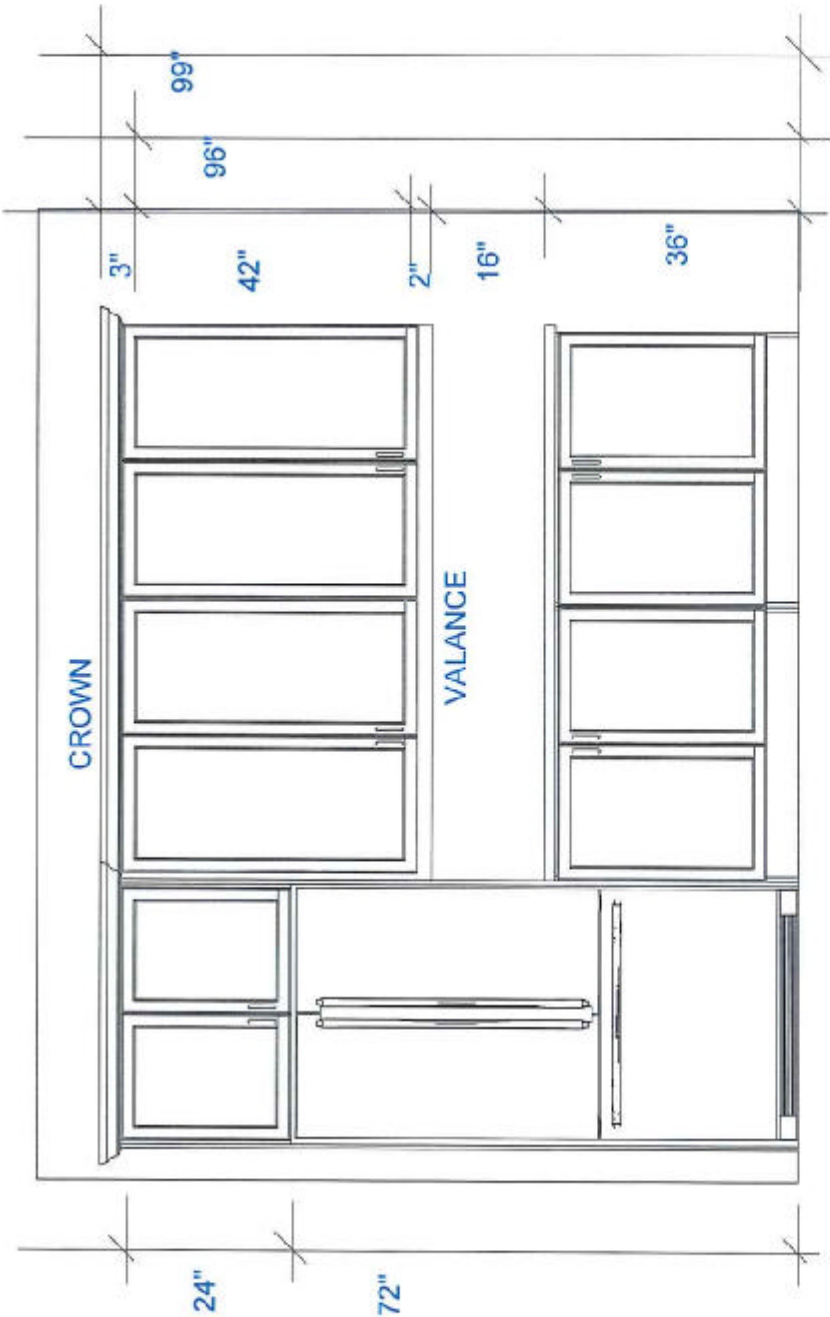

FRIDGE WALL ELEVATION

CUSTOMER APPROVAL

I have reviewed these drawings and understand the details of the design and the CARTIER KITCHENS specifications.

Signature _____

Date _____

Note: This drawing is an artistic interpretation of the general appearance of the design. It is not meant to be an exact rendition.		Designed: 2021-05-19 Printed: 2021-05-19	
		SPECTRUM KITCHEN and BATH DESIGN	DCR #6 Diamondview Estates 2 - 508
All		Drawing #: 1	